


**APPENDIX A**  
**SUBMERSIBLE WELL PUMP CURVES AND DATA**

# 6. Curve charts and technical data


## 5S (5 gpm)

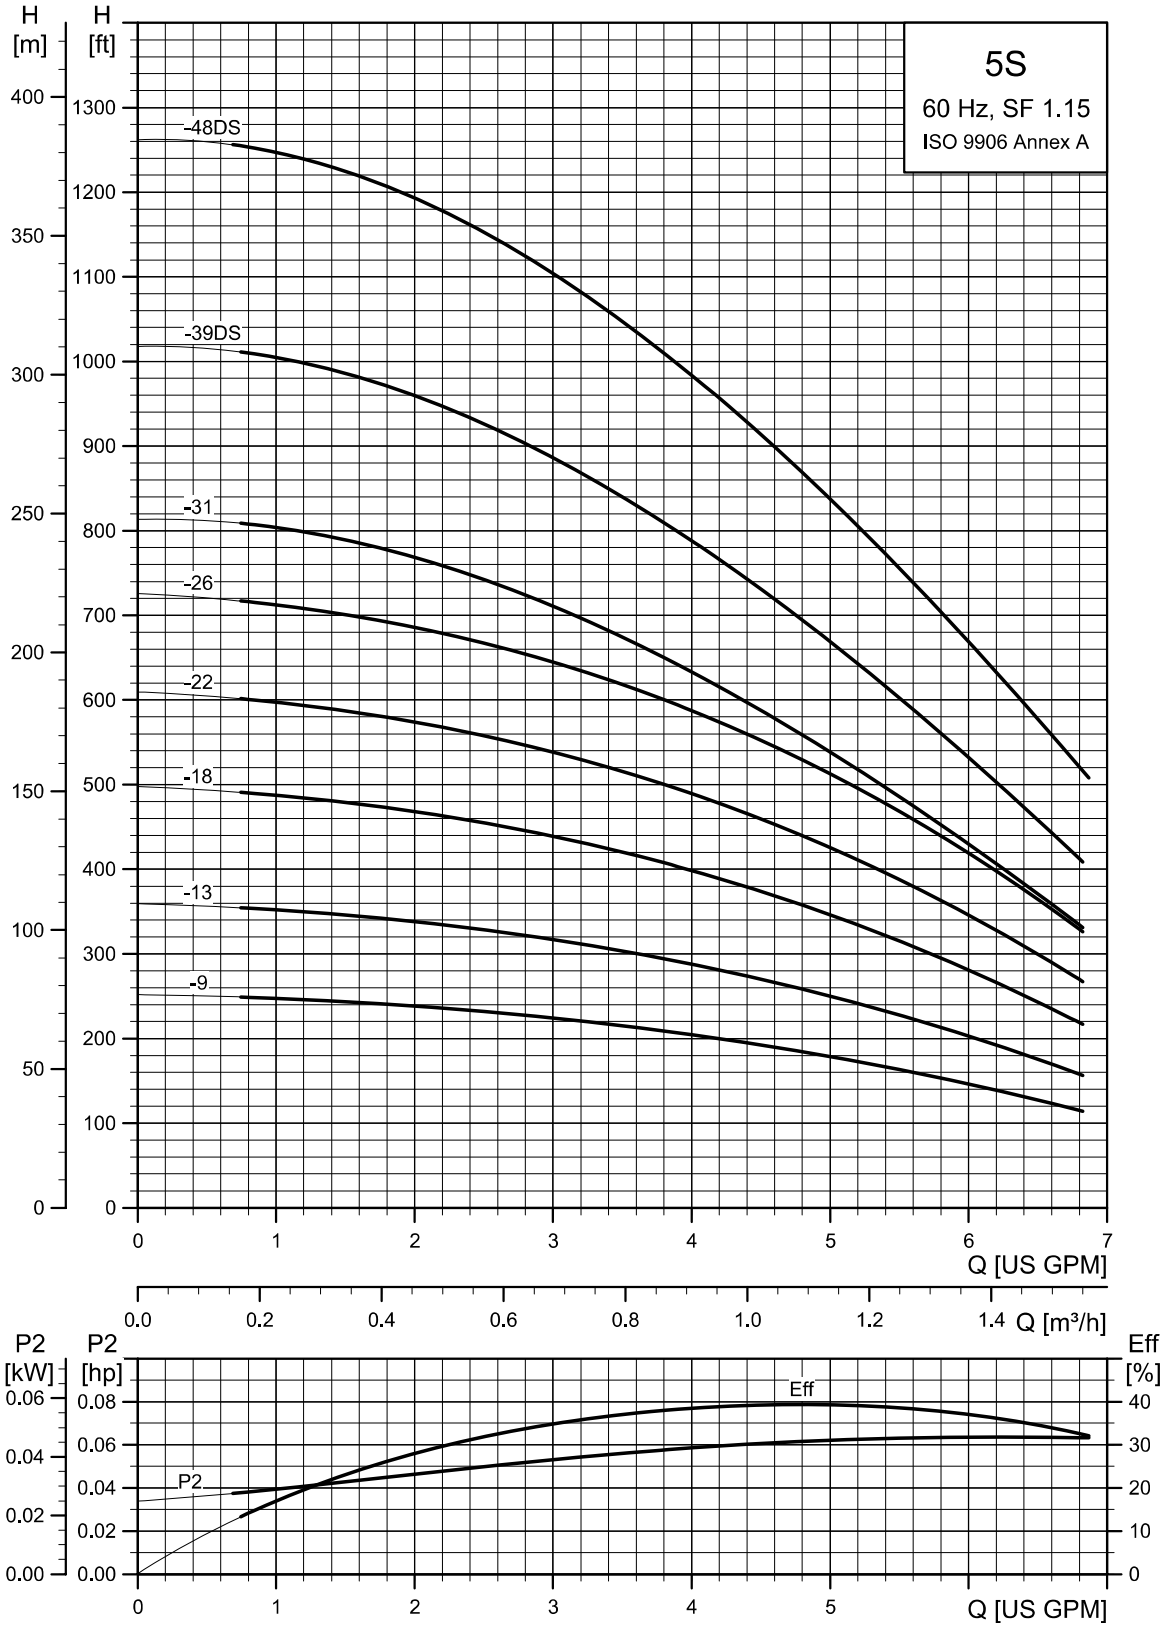

TM05 0229 0112

5S (5 gpm)

Pump model	Nom. head [ft]	Ph	Volts [V]	Motor [Hp]	Dimensions					Net weight (complete) [lb]	
					A [in (mm)]	B [in (mm)]	C [in (mm)]	D [in (mm)]	E [in (mm)]		
<b>5S, motor dia. 4 inch, 2 wire motor, 60 Hz - rated flow 5 gpm (1" NPT)</b>											
5S05-9	171	1	230	0.5	■ 24.57 (624)	11.03 (280)	13.55 (344)	3.74 (95)	3.97 (101)	21.6	
5S05-13	247	1	115	0.5	■ 27.88 (708)	11.03 (280)	16.86 (428)	3.74 (95)	3.97 (101)	26.9	
			230	0.5	■ 27.88 (708)	11.03 (280)	16.86 (428)	3.74 (95)	3.97 (101)	26.1	
5S07-18	343	1	230	0.75	■ 32.60 (828)	11.62 (295)	20.99 (533)	3.74 (95)	3.97 (101)	29.7	
5S10-22	419	1	230	1	■ 36.50 (927)	12.21 (310)	24.30 (617)	3.74 (95)	3.97 (101)	32.4	
5S15-26	495	1	230	1.5	■ 41.30 (1049)	13.71 (348)	27.60 (701)	3.74 (95)	3.97 (101)	41.4	
5S15-31	527	1	230	1.5	■ 47.21 (1199)	13.71 (348)	33.51 (851)	3.74 (95)	3.97 (101)	47.7	
<b>5S, motor dia. 4 inch, 3 wire motor, 60 Hz - rated flow 5 gpm (1" NPT)</b>											
5S05-9	171	1	230	0.5	■ 24.57 (624)	11.03 (280)	13.55 (344)	3.74 (95)	3.97 (101)	22.5	
5S05-13	247	1	115	0.5	■ 27.88 (708)	11.03 (280)	16.86 (428)	3.74 (95)	3.97 (101)	26.9	
			230	0.5	■ 27.88 (708)	11.03 (280)	16.86 (428)	3.74 (95)	3.97 (101)	25.2	
5S07-18	343	1	230	0.75	■ 32.60 (828)	11.62 (295)	20.99 (533)	3.74 (95)	3.97 (101)	28.8	
5S10-22	419	1	230	1	■ 36.50 (927)	12.21 (310)	24.30 (617)	3.74 (95)	3.97 (101)	32.4	
5S15-26	495	3	1	230	1.5	■ 41.30 (1049)	13.71 (348)	27.60 (701)	3.74 (95)	3.97 (101)	37.8
			230	1.5	■ 39.81 (1011)	12.21 (310)	27.60 (701)	3.74 (95)	3.97 (101)	38.7	
			460	1.5	■ 39.81 (1011)	12.21 (310)	27.60 (701)	3.74 (95)	3.97 (101)	38.7	
5S15-31	527	3	1	230	1.5	■ 47.21 (1199)	13.71 (348)	33.51 (851)	3.74 (95)	3.97 (101)	47.7
			230	1.5	■ 45.71 (1161)	12.21 (310)	33.51 (851)	3.74 (95)	3.97 (101)	45.0	
			460	1.5	■ 45.71 (1161)	12.21 (310)	33.51 (851)	3.74 (95)	3.97 (101)	45.0	
5S20-39DS	663	3	1	230	2	● 59.61 (1514)	19.49 (495)	40.12 (1019)	3.74 (95)	3.97 (101)	57.6
			230	2	■ 53.82 (1367)	13.71 (348)	40.12 (1019)	3.74 (95)	3.97 (101)	54.0	
			460	2	■ 53.82 (1367)	13.71 (348)	40.12 (1019)	3.74 (95)	3.97 (101)	54.0	
5S30-48DS	816	3	1	230	3	● 70.16 (1782)	22.60 (574)	47.56 (1208)	3.74 (95)	3.97 (101)	77.4
			230	3	● 65.56 (1665)	18.00 (457)	47.56 (1208)	3.74 (95)	3.97 (101)	77.4	
			460	3	● 65.56 (1665)	18.00 (457)	47.56 (1208)	3.74 (95)	3.97 (101)	77.4	

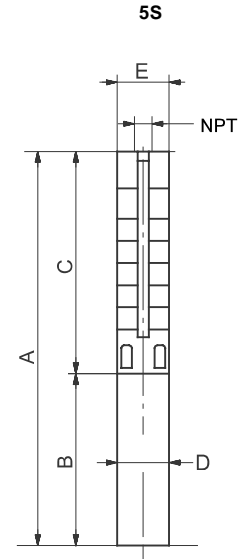


TMD05 02/04 07/11

E = Maximum diameter of pump including cable guard and motor.

- Notes:  
 Control box is required for 3-wire, single-phase applications. Data does not include control box.  
 DS designation = Built into sleeve, 1-1/4" NPT, 6" minimum well diameter.
- MS402 motor.
  - MS4000 motor.
  - ▲ MS6 motor.
  - △ MMS6000 motor.
  - ★ MMS8000 motor.
  - ◆ Takes MS6 motor; not available as complete.
  - ☆ Takes MMS6000 motor; not available as complete.
  - \* Takes MMS8000 motor; not available as complete.
  - † Takes MMS10000 motor; not available as complete.


7S (7 gpm)

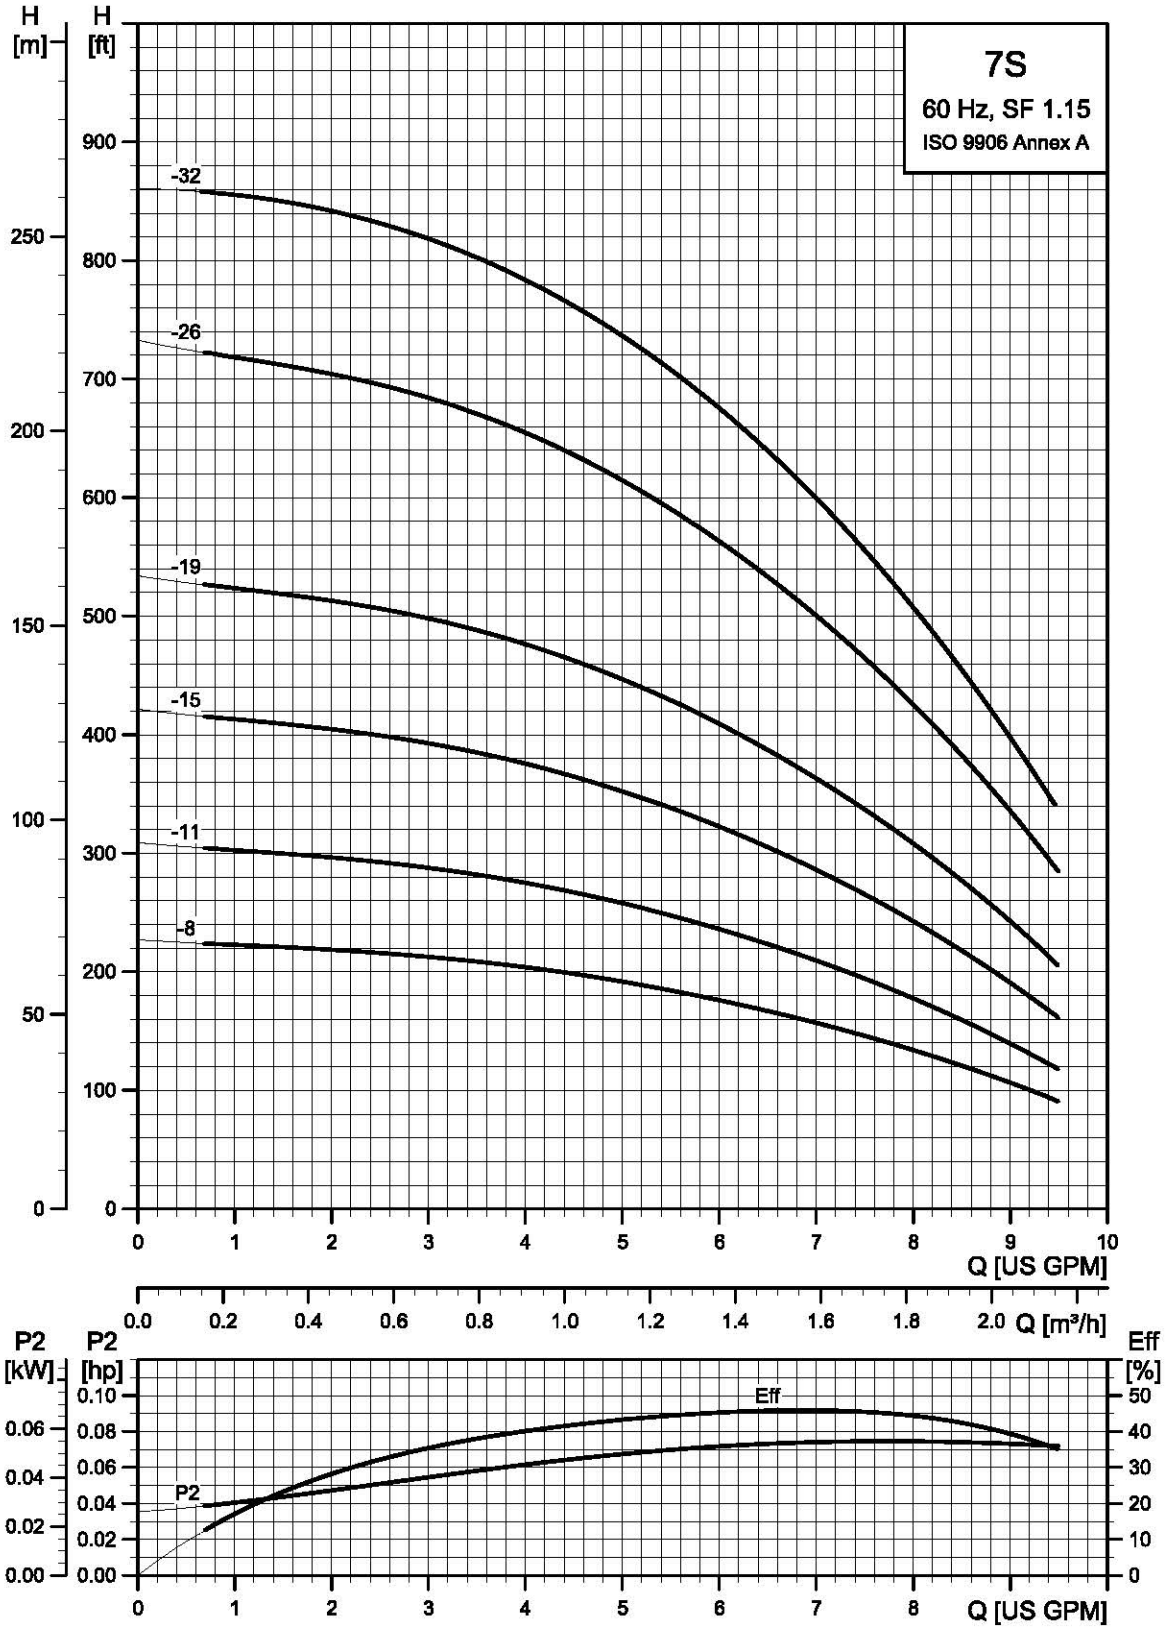

TM05 0982 0112

### 7S (7 gpm)

Pump model	Nom. head [ft]	Ph	Volts [V]	Motor [Hp]	Dimensions					Net weight (complete) [lb]
					A [in (mm)]	B [in (mm)]	C [in (mm)]	D [in (mm)]	E [in (mm)]	
<b>7S, motor dia. 4 inch, 2 wire motor, 60 Hz - rated flow 7 gpm (1" NPT)</b>										
7S05-8	151	1	230	.5 ■	23.75 (603)	11.03 (280)	12.72 (323)	3.74 (95)	3.97 (101)	21.6
7S05-11	208	1	115	.5 ■	26.23 (666)	11.03 (280)	15.20 (386)	3.74 (95)	3.97 (101)	29.7
			230	.5 ■	26.23 (666)	11.03 (280)	15.20 (386)	3.74 (95)	3.97 (101)	24.3
7S07-15	283	1	230	.75 ■	30.12 (765)	11.62 (295)	18.51 (470)	3.74 (95)	3.97 (101)	29.7
7S10-19	358	1	230	1 ■	34.02 (864)	12.21 (310)	21.82 (554)	3.74 (95)	3.97 (101)	32.4
7S15-26	491	1	230	1.5 ■	41.3 (1049)	13.71 (348)	27.60 (701)	3.74 (95)	3.97 (101)	41.4
<b>7S, motor dia. 4 inch, 3 wire motor, 60 Hz - rated flow 7 gpm (1" NPT)</b>										
7S05-8	151	1	230	.5 ■	23.75 (603)	11.03 (280)	12.72 (323)	3.74 (95)	3.97 (101)	21.6
7S05-11	208	1	115	.5 ■	26.23 (666)	11.03 (280)	15.20 (386)	3.74 (95)	3.97 (101)	21.6
			230	.5 ■	26.23 (666)	11.03 (280)	15.20 (386)	3.74 (95)	3.97 (101)	30.6
7S07-15	283	1	230	.75 ■	30.12 (765)	11.62 (295)	18.51 (470)	3.74 (95)	3.97 (101)	27.9
7S10-19	358	1	230	1 ■	34.02 (864)	12.21 (310)	21.82 (554)	3.74 (95)	3.97 (101)	39.6
7S15-26	491	3	230	1.5 ■	41.30 (1049)	13.71 (348)	27.60 (701)	3.74 (95)	3.97 (101)	38.7
			460	1.5 ■	39.81 (1011)	12.21 (310)	27.60 (701)	3.74 (95)	3.97 (101)	38.7
7S20-32	604	3	230	2 ●	52.05 (1322)	19.49 (495)	32.56 (827)	3.74 (95)	3.97 (101)	48.5
			460	2 ■	46.26 (1175)	13.71 (348)	32.56 (827)	3.74 (95)	3.97 (101)	48.5

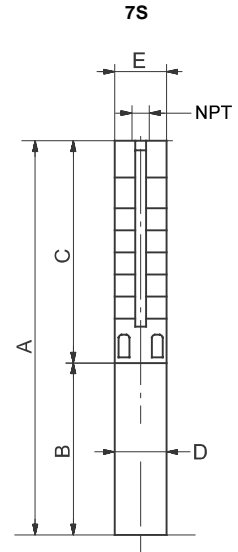

TM05 0204 0711



E = Maximum diameter of pump including cable guard and motor.

**Notes:**

Control box is required for 3-wire, single-phase applications. Data does not include control box.

- MS402 motor.
- MS4000 motor.
- ▲ MS6 motor.
- △ MMS6000 motor.
- ★ MMS8000 motor.
- ◆ Takes MS6 motor; not available as complete.
- ⊛ Takes MMS6000 motor; not available as complete.
- \* Takes MMS8000 motor; not available as complete.
- † Takes MMS10000 motor; not available as complete.


### 10S (10 gpm)

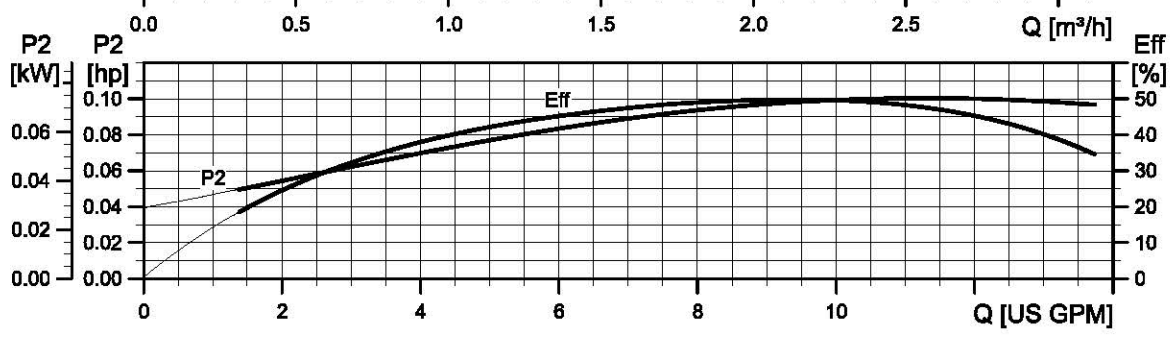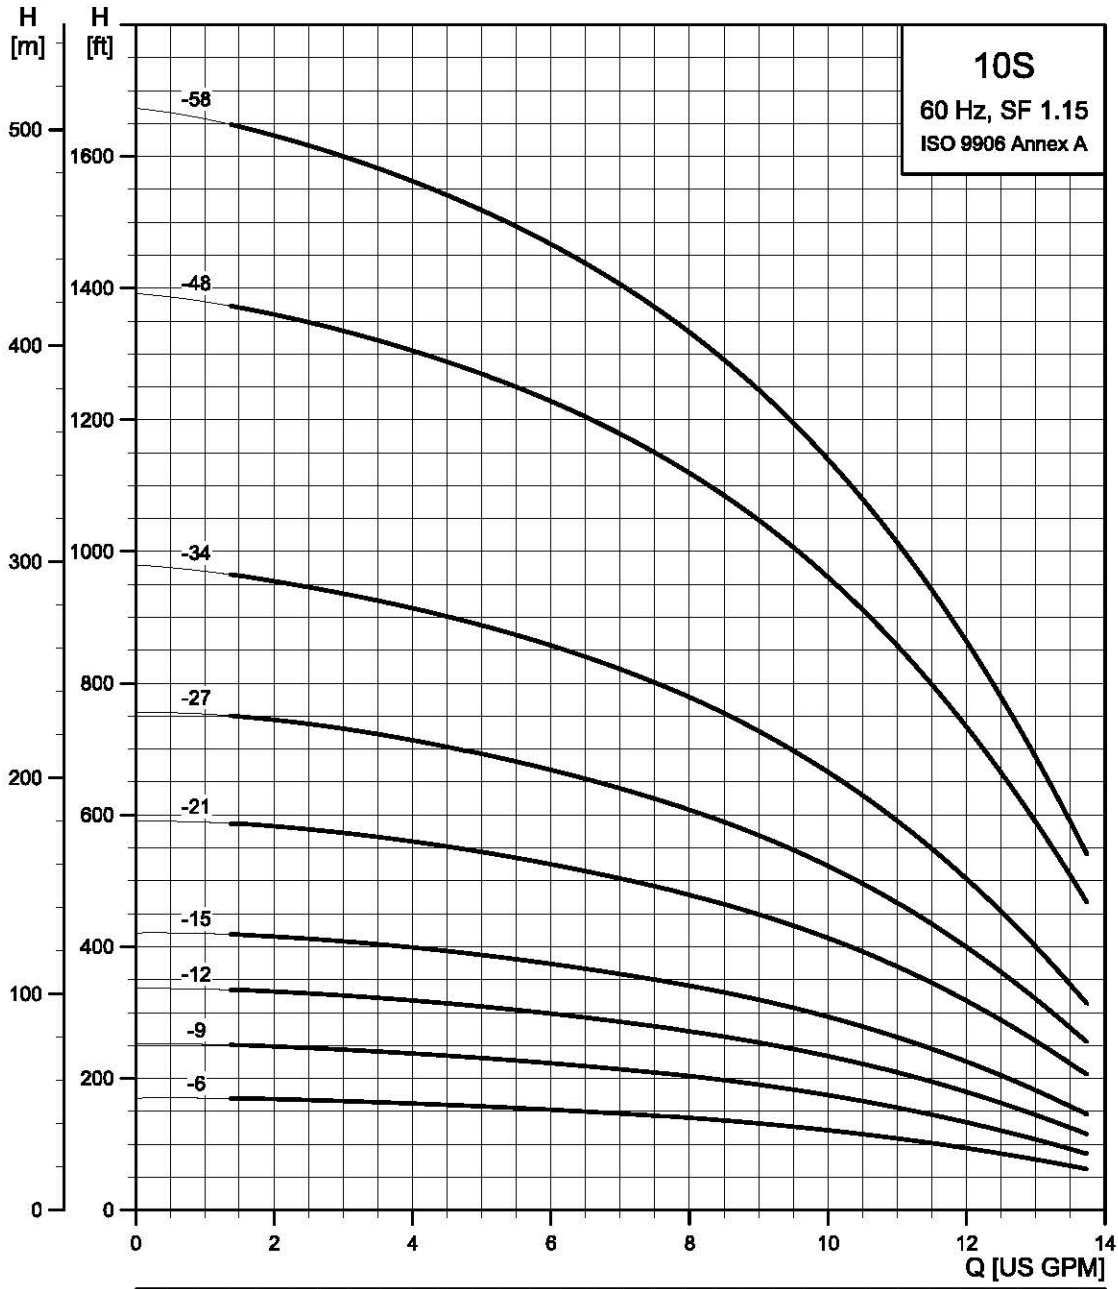

TM05 0230 0112

### 10S (10 gpm)

Pump model	Nom. head [ft]	Ph	Volts [V]	Motor [Hp]	Dimensions					Net weight (complete) [lb]
					A [in (mm)]	B [in (mm)]	C [in (mm)]	D [in (mm)]	E [in (mm)]	
<b>10S, motor dia. 4 inch, 2 wire motor, 60 Hz - rated flow 10 gpm (1.25" NPT)</b>										
10S05-6	116	1	230	.5 ■	22.05 (560)	10.99 (279)	11.07 (281)	3.74 (95)	3.97 (101)	20.7
10S05-9	174	1	115	.5 ■	24.53 (623)	10.99 (279)	13.55 (344)	3.74 (95)	3.97 (101)	24.3
			230	.5 ■	24.53 (623)	10.99 (279)	13.55 (344)	3.74 (95)	3.97 (101)	23.4
10S07-12	233	1	230	.75 ■	27.60 (701)	11.58 (294)	16.03 (407)	3.74 (95)	3.97 (101)	24.3
10S10-15	291	1	230	1 ■	30.67 (779)	12.17 (309)	18.51 (470)	3.74 (95)	3.97 (101)	29.7
10S15-21	407	1	230	1.5 ■	37.17 (944)	13.71 (348)	23.47 (596)	3.74 (95)	3.97 (101)	35.1
<b>10S, motor dia. 4 inch, 3 wire motor, 60 Hz - rated flow 10 gpm (1.25" NPT)</b>										
10S05-6	116	1	230	.5 ■	24.77 (629)	13.71 (348)	11.07 (281)	3.74 (95)	3.97 (101)	21.6
10S05-9	174	1	115	.5 ■	24.53 (623)	10.99 (279)	13.55 (344)	3.74 (95)	3.97 (101)	25.4
			230	.5 ■	24.53 (623)	10.99 (279)	13.55 (344)	3.74 (95)	3.97 (101)	24.3
10S07-12	233	1	230	.75 ■	27.60 (701)	11.58 (294)	16.03 (407)	3.74 (95)	3.97 (101)	28.8
10S10-15	291	1	230	1 ■	30.67 (779)	12.17 (309)	18.51 (470)	3.74 (95)	3.97 (101)	29.7
			1	230	1.5 ■	37.17 (944)	13.71 (348)	23.47 (596)	3.74 (95)	3.97 (101)
10S15-21	407	3	230	1.5 ■	35.63 (905)	12.17 (309)	23.47 (596)	3.74 (95)	3.97 (101)	32.4
			460	1.5 ■	35.63 (905)	12.17 (309)	23.47 (596)	3.74 (95)	3.97 (101)	36.0
10S20-27	524	3	230	2 ■	42.13 (1070)	13.71 (348)	28.43 (722)	3.74 (95)	3.97 (101)	44.1
			460	2 ■	42.13 (1070)	13.71 (348)	28.43 (722)	3.74 (95)	3.97 (101)	44.1
10S30-34	659	3	230	3 ●	58.59 (1488)	22.6 (574)	35.99 (914)	3.74 (95)	3.97 (101)	81.9
			460	3 ●	53.98 (1371)	18.00 (457)	35.99 (914)	3.74 (95)	3.97 (101)	74.7
10S50-48DS	931	3	230	5 ●	74.18 (1884)	26.62 (676)	47.56 (1208)	3.74 (95)	3.97 (101)	103.5
			460	5 ●	70.16 (1782)	22.60 (574)	47.56 (1208)	3.74 (95)	3.97 (101)	103.5
10S50-58DS	1124	3	230	5 ●	89.49 (2272)	26.62 (676)	62.88 (1597)	3.74 (95)	4.25 (108)	132.3
			460	5 ●	85.48 (2171)	22.60 (574)	62.88 (1597)	3.74 (95)	4.25 (108)	132.3


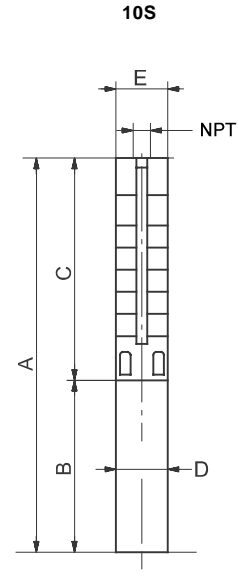


TM05 0204 0711

E = Maximum diameter of pump including cable guard and motor.

- Notes:  
 Control box is required for 3-wire, single-phase applications. Data does not include control box.  
 DS designation = Built into sleeve, 1-1/4" NPT, 6" minimum well diameter.
- MS402 motor.
  - MS4000 motor.
  - ▲ MS6 motor.
  - △ MMS6000 motor.
  - ★ MMS8000 motor.
  - ◆ Takes MS6 motor; not available as complete.
  - ☆ Takes MMS6000 motor; not available as complete.
  - \* Takes MMS8000 motor; not available as complete.
  - † Takes MMS10000 motor; not available as complete.

# 16S (16 gpm)

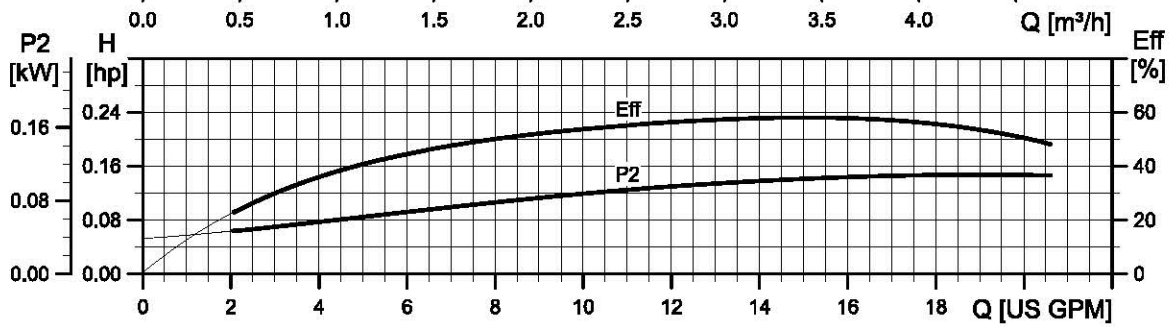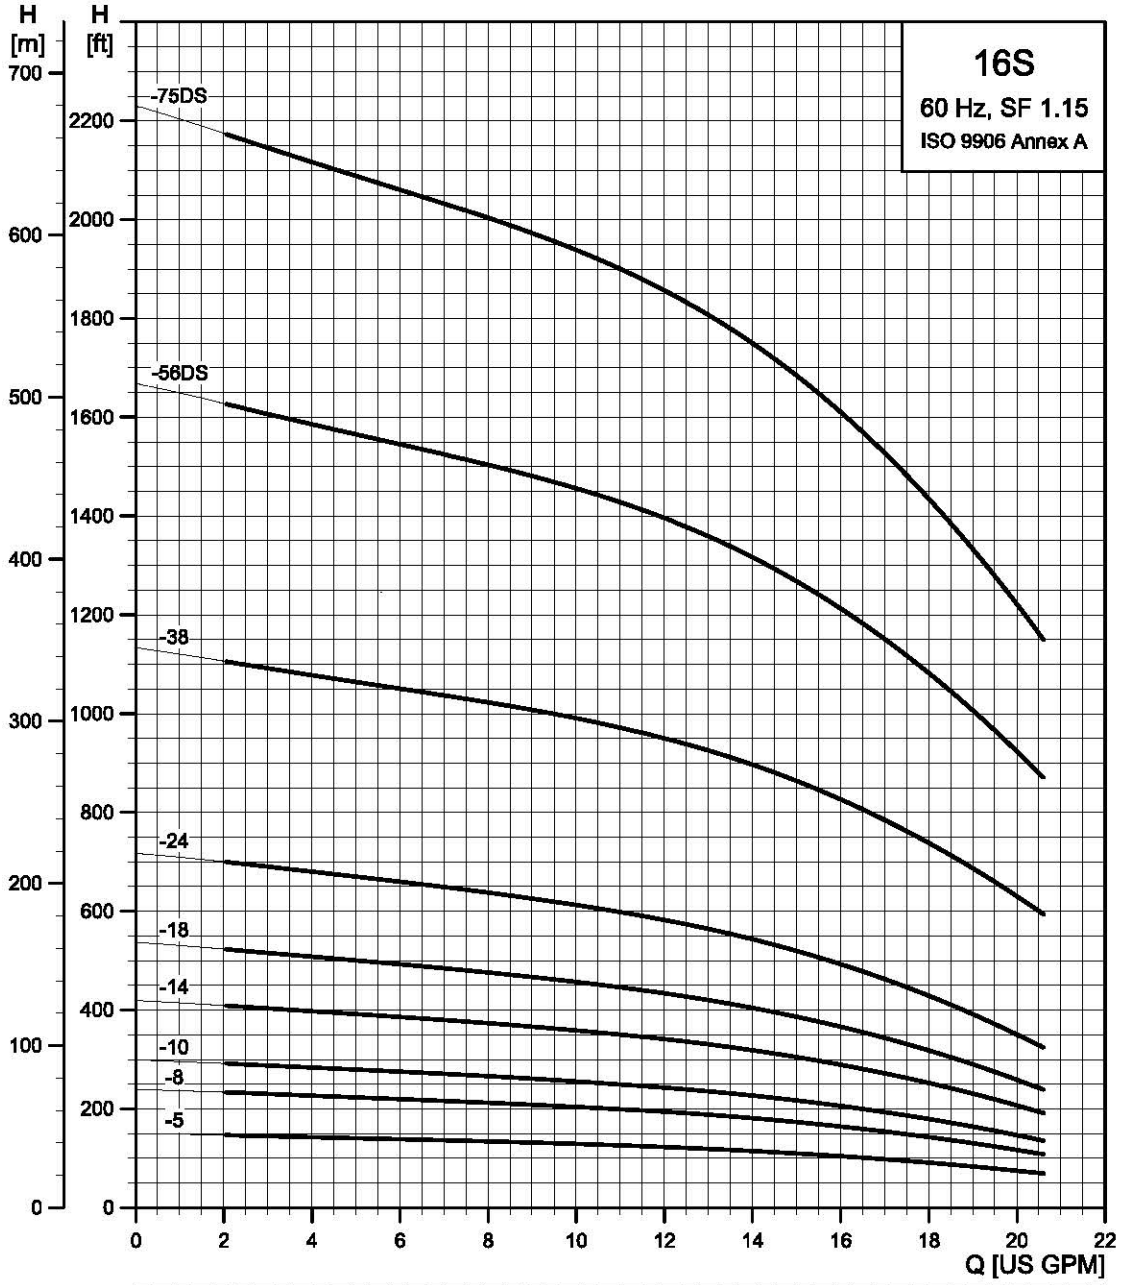


TM05 0231 0112



### 16S (16 gpm)

Pump model	Nom. head [ft]	Ph	Volts [V]	Motor [Hp]	Dimensions					Net weight (complete) [lb]	
					A [in (mm)]	B [in (mm)]	C [in (mm)]	D [in (mm)]	E [in (mm)]		
<b>16S, motor dia. 4 inch, 2 wire motor, 60 Hz - rated flow 16 gpm (1.25" NPT)</b>											
16S05-5	102	1	115	.5	■	21.26 (540)	11.03 (280)	10.24 (260)	3.74 (95)	3.97 (101)	21.6
			230	.5	■	21.26 (540)	11.03 (280)	10.24 (260)	3.74 (95)	3.97 (101)	23.4
16S07-8	162	1	230	.75	■	24.34 (618)	11.62 (295)	12.72 (323)	3.74 (95)	3.97 (101)	24.3
16S10-10	203	1	230	1	■	26.58 (675)	12.21 (310)	14.38 (365)	3.74 (95)	3.97 (101)	27.9
16S15-14	284	1	230	1.5	■	31.38 (797)	13.71 (348)	17.68 (449)	3.74 (95)	3.97 (101)	36.0
<b>16S, motor dia. 4 inch, 3 wire motor, 60 Hz - rated flow 16 gpm (1.25" NPT)</b>											
16S05-5	102	1	115	.5	■	21.26 (540)	11.03 (280)	10.24 (260)	3.74 (95)	3.97 (101)	21.6
			230	.5	■	21.26 (540)	11.03 (280)	10.24 (260)	3.74 (95)	3.97 (101)	21.6
16S07-8	162	1	230	.75	■	24.34 (618)	11.62 (295)	12.72 (323)	3.74 (95)	3.97 (101)	27.0
16S10-10	203	1	230	1	■	26.58 (675)	12.21 (310)	14.38 (365)	3.74 (95)	3.97 (101)	27.9
			230	1.5	●	31.38 (797)	13.71 (348)	17.68 (449)	3.74 (95)	3.97 (101)	32.4
16S15-14	284	3	230	1.5	■	29.89 (759)	12.21 (310)	17.68 (449)	3.74 (95)	3.97 (101)	28.8
			460	1.5	■	29.89 (759)	12.21 (310)	17.68 (449)	3.74 (95)	3.97 (101)	28.8
16S20-18	366	3	230	2	●	40.48 (1028)	19.49 (495)	20.99 (533)	3.74 (95)	3.97 (101)	36.0
			460	2	■	34.69 (881)	13.71 (348)	20.99 (533)	3.74 (95)	3.97 (101)	36.0
16S30-24	487	3	230	3	●	48.55 (1233)	22.60 (574)	25.95 (659)	3.74 (95)	3.97 (101)	62.1
			460	3	●	43.94 (1116)	18.00 (457)	25.95 (659)	3.74 (95)	3.97 (101)	57.6
16S50-38	814	3	230	5	●	65.91 (1674)	26.62 (676)	39.30 (998)	3.74 (95)	3.97 (101)	97.2
			460	5	●	62.01 (1575)	22.72 (577)	39.30 (998)	3.74 (95)	3.97 (101)	90.0
<b>SP 16S, motor dia. 6 inch, 3 wire motor, 60 Hz - rated flow 16 gpm (1.25" NPT)</b>											
16S75-56DS	1200	3	230	7.5	▲	95.40 (2423)	26.62 (676)	68.78 (1747)	5.63 (143)	5.51 (140)	165.1
			460	7.5	▲	95.40 (2423)	26.62 (676)	68.78 (1747)	5.63 (143)	5.51 (140)	165.1
16S100-75DS	1607	3	460	10	▲	115.08 (2923)	30.60 (777)	84.49 (2146)	5.63 (143)	5.51 (140)	190.0

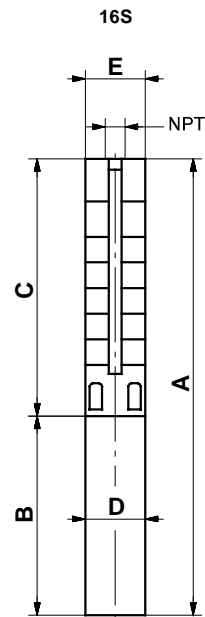

TM00 8521 3196

E = Maximum diameter of pump including cable guard and motor.


**Notes:**

Control box is required for 3-wire, single-phase applications. Data does not include control box.

DS designation = Built into sleeve, 1-1/4" NPT, 6" minimum well diameter.

- MS402 motor.
- MS4000 motor.
- ▲ MS6 motor.
- △ MMS6000 motor.
- ★ MMS8000 motor.
- ◆ Takes MS6 motor; not available as complete.
- ⊛ Takes MMS6000 motor; not available as complete.
- \* Takes MMS8000 motor; not available as complete.
- † Takes MMS10000 motor; not available as complete.


### 25S (25 gpm)

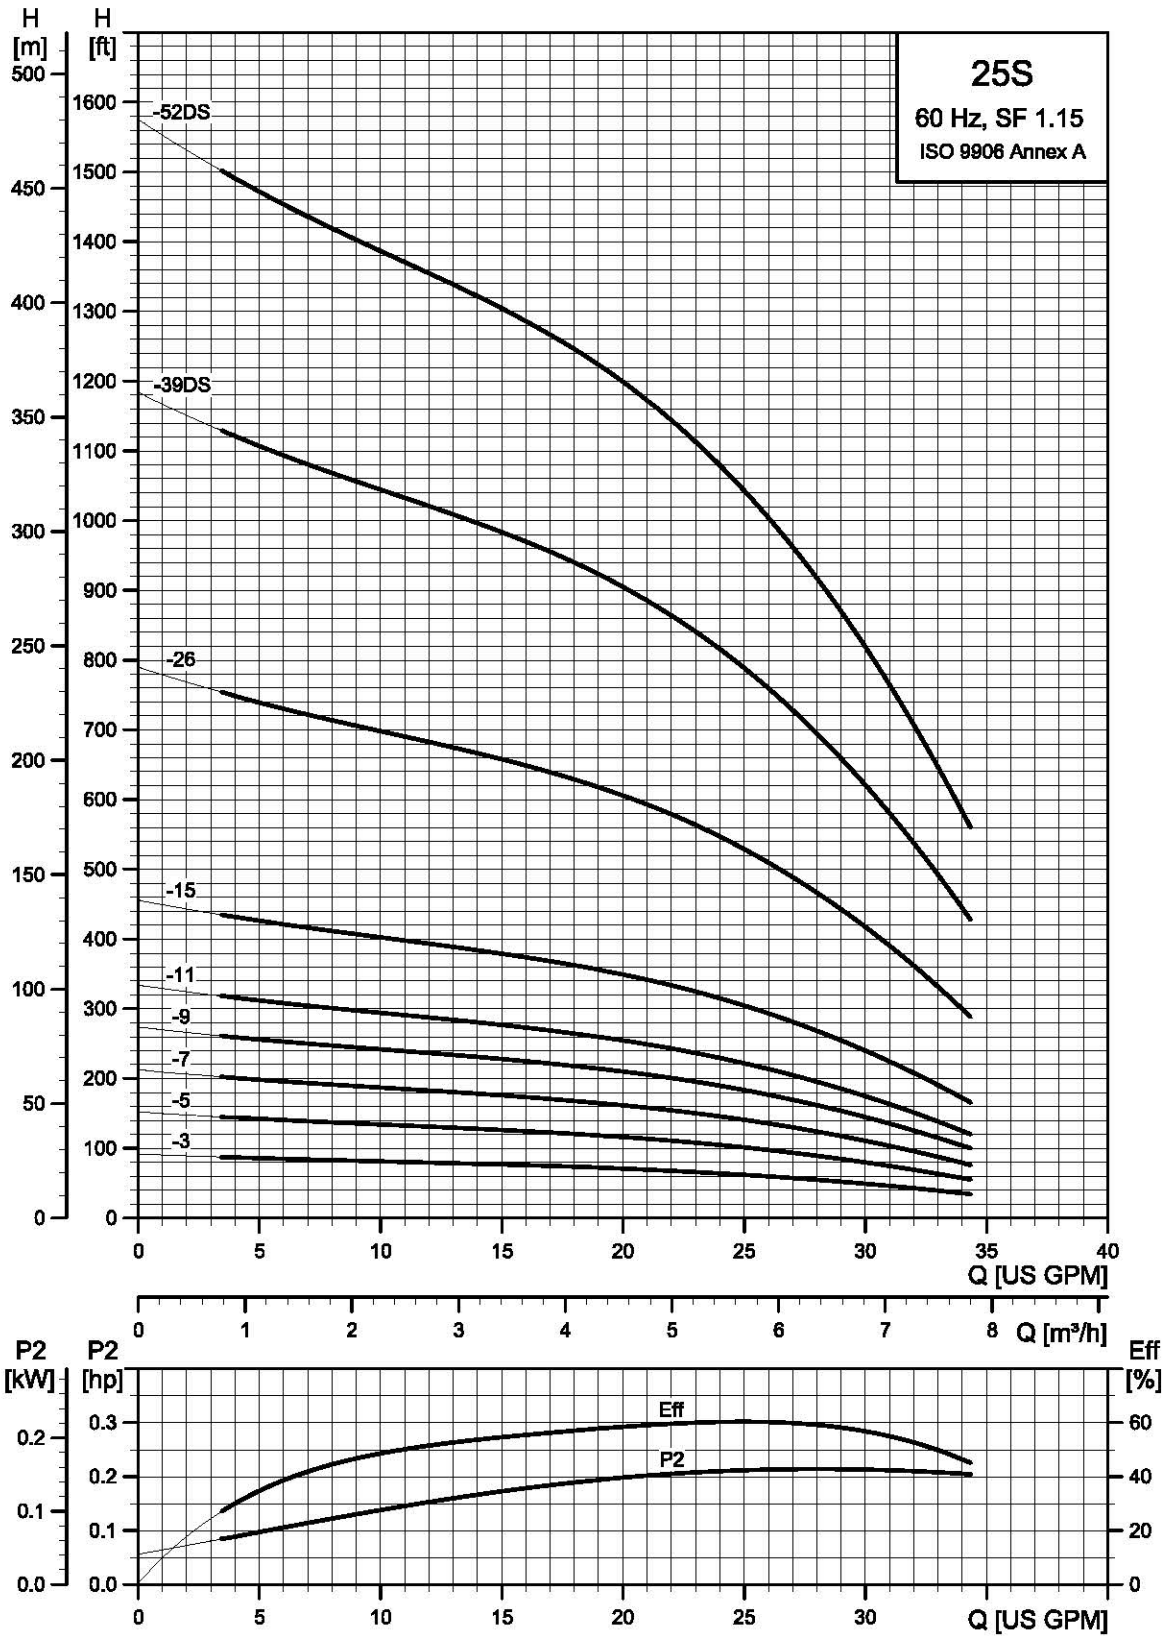

TM05 0232 0112

### 25S (25 gpm)

Pump model	Nom. head [ft]	Ph	Volts [V]	Motor [Hp]	Dimensions					Net weight (complete) [lb]	
					A [in (mm)]	B [in (mm)]	C [in (mm)]	D [in (mm)]	E [in (mm)]		
<b>25S, motor dia. 4 inch, 2 wire motor, 60 Hz - rated flow 25 gpm (1.5" NPT)</b>											
25S05-3	60	1	115	.5	■	19.61 (498)	11.03 (280)	8.59 (218)	3.74 (95)	3.97 (101)	21.6
			230	.5	■	19.61 (498)	11.03 (280)	8.59 (218)	3.74 (95)	3.97 (101)	21.6
25S07-5	99	1	230	.75	■	21.86 (555)	11.62 (295)	10.24 (260)	3.74 (95)	3.97 (101)	23.4
25S10-7	139	1	230	1	■	24.10 (612)	12.21 (310)	11.89 (302)	3.74 (95)	3.97 (101)	25.2
25S15-9	179	1	230	1.5	■	27.25 (692)	13.71 (348)	13.55 (344)	3.74 (95)	3.97 (101)	28.8
<b>25S, motor dia. 4 inch, 3 wire motor, 60 Hz - rated flow 25 gpm (1.5" NPT)</b>											
25S05-3	60	1	115	.5	■	19.61 (498)	11.03 (280)	8.59 (218)	3.74 (95)	3.97 (101)	21.6
			230	.5	■	19.61 (498)	11.03 (280)	8.59 (218)	3.74 (95)	3.97 (101)	21.6
25S07-5	99	1	230	.75	■	21.86 (555)	11.62 (295)	10.24 (260)	3.74 (95)	3.97 (101)	23.4
25S10-7	139	1	230	1	■	24.10 (612)	12.21 (310)	11.89 (302)	3.74 (95)	3.97 (101)	25.2
			230	1.5	■	27.25 (692)	13.71 (348)	13.55 (344)	3.74 (95)	3.97 (101)	29.7
25S15-9	179	3	230	1.5	■	25.75 (654)	12.21 (310)	13.55 (344)	3.74 (95)	3.97 (101)	27.0
			460	1.5	■	25.75 (654)	12.21 (310)	13.55 (344)	3.74 (95)	3.97 (101)	28.8
25S20-11	219	3	230	2	■	28.90 (734)	13.71 (348)	15.20 (386)	3.74 (95)	3.97 (101)	37.0
			460	2	■	28.90 (734)	13.71 (348)	15.20 (386)	3.74 (95)	3.97 (101)	33.3
25S30-15	298	3	230	3	●	41.11 (1044)	22.60 (574)	18.51 (470)	3.74 (95)	3.97 (101)	61.2
			460	3	●	36.50 (927)	18.00 (457)	18.51 (470)	3.74 (95)	3.97 (101)	53.1
25S50-26	517	3	230	5	●	54.22 (1377)	26.62 (676)	27.60 (701)	3.74 (95)	3.97 (101)	72.9
			460	5	●	50.32 (1278)	22.72 (577)	27.60 (701)	3.74 (95)	3.97 (101)	72.9
<b>SP 25S, motor dia. 6 inch, 3 wire motor, 60 Hz - rated flow 25 gpm (1.5" NPT)</b>											
25S75-39DS	775	3	230	7.5	▲	64.81 (1646)	22.25 (565)	42.56 (1081)	5.63 (143)	5.43 (138)	122.1
			460	7.5	▲	64.81 (1646)	22.25 (565)	42.56 (1081)	5.63 (143)	5.43 (138)	122.1
25S100-52DS	1034	3	460	10	▲	88.71 (2253)	23.23 (590)	65.48 (1663)	5.63 (143)	5.51 (140)	163.1


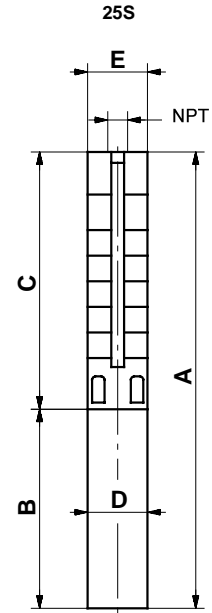


TM00 8521 3196

E = Maximum diameter of pump including cable guard and motor.

- Notes:  
 Control box is required for 3-wire, single-phase applications. Data does not include control box.  
 DS designation = Built into sleeve, 1-1/2" NPT, 6" minimum well diameter.
- MS402 motor.
  - MS4000 motor.
  - ▲ MS6 motor.
  - △ MMS6000 motor.
  - ★ MMS8000 motor.
  - ◆ Takes MS6 motor; not available as complete.
  - ☆ Takes MMS6000 motor; not available as complete.
  - \* Takes MMS8000 motor; not available as complete.
  - † Takes MMS10000 motor; not available as complete.


### 40S (40 gpm)

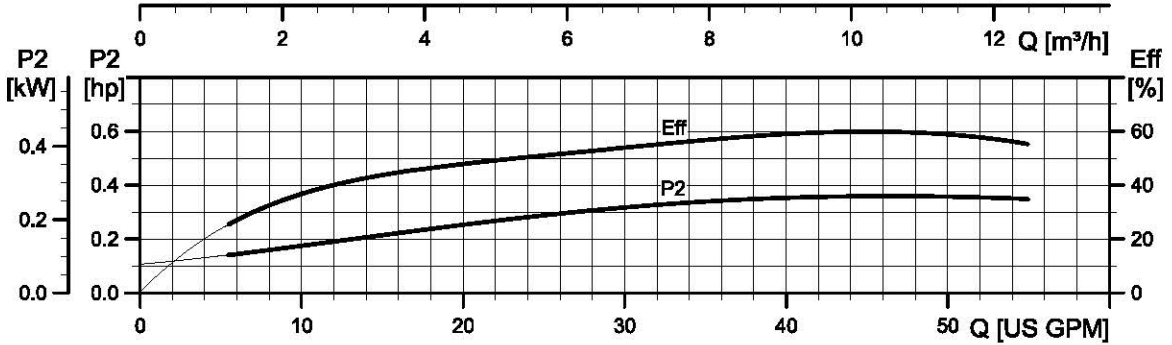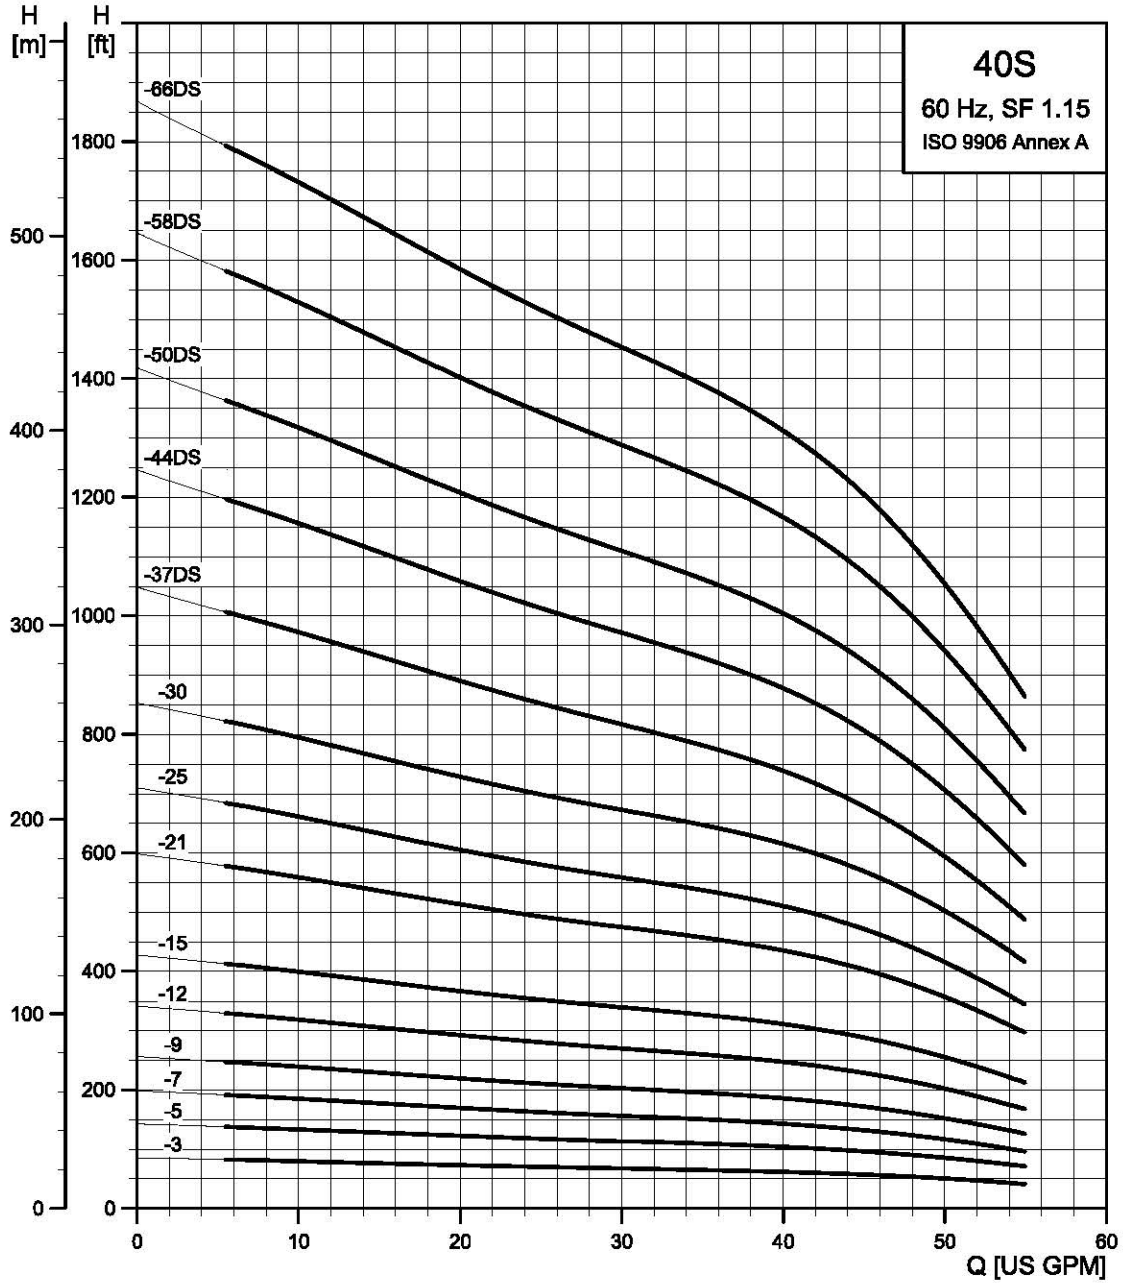

TM05 0233 0112

### 40S (40 gpm)


Pump model	Nom. head [ft]	Ph	Volts [V]	Motor [Hp]	Dimensions					Net weight (complete) [lb]	
					A [in (mm)]	B [in (mm)]	C [in (mm)]	D [in (mm)]	E [in (mm)]		
<b>40S - Motor dia. 4 inch, 2 wire motor, 60 Hz, rated flow 40 gpm (2" NPT)</b>											
40S10-3	60	1	230	1	■	25.00 (635)	12.21 (310)	12.80 (325)	3.74 (95)	3.97 (101)	26.1
40S10-5	102	1	230	1.5	■	29.81 (757)	13.71 (348)	16.11 (409)	3.74 (95)	3.97 (101)	30.6
<b>40S - Motor dia. 4 inch, 3 wire motor, 60 Hz, rated flow 40 gpm (2" NPT)</b>											
40S10-3	61	1	230	1	■	25.00 (635)	12.21 (310)	12.8 (325)	3.74 (95)	3.97 (101)	26.1
		1	230	1.5	■	29.81 (757)	13.71 (348)	16.11 (409)	3.74 (95)	3.97 (101)	30.6
40S15-5	102	3	230	1.5	■	28.31 (719)	12.21 (310)	16.11 (409)	3.74 (95)	3.97 (101)	30.6
		3	460	1.5	■	28.31 (719)	12.21 (310)	16.11 (409)	3.74 (95)	3.97 (101)	30.6
40S20-7	143	1	230	2	●	38.90 (988)	19.49 (495)	19.41 (493)	3.74 (95)	3.97 (101)	36.9
		3	230	2	■	33.12 (841)	13.71 (348)	19.41 (493)	3.74 (95)	3.97 (101)	36.9
		3	460	2	■	33.12 (841)	13.71 (348)	19.41 (493)	3.74 (95)	3.97 (101)	36.9
40S30-9	184	1	230	3	●	45.32 (1151)	22.60 (574)	22.72 (577)	3.74 (95)	3.97 (101)	74.1
		3	230	3	●	40.71 (1034)	18.00 (457)	22.72 (577)	3.74 (95)	3.97 (101)	81.0
		3	460	3	●	40.71 (1034)	18.00 (457)	22.72 (577)	3.74 (95)	3.97 (101)	74.7
40S50-12	245	1	230	5	●	54.30 (1379)	26.62 (676)	27.68 (703)	3.74 (95)	3.97 (101)	81.0
		3	230	5	●	50.40 (1280)	22.72 (577)	27.68 (703)	3.74 (95)	3.97 (101)	74.7
		3	460	5	●	50.40 (1280)	22.72 (577)	27.68 (703)	3.74 (95)	3.97 (101)	74.7
40S50-15	307	1	230	5	●	59.26 (1505)	26.62 (676)	32.64 (829)	3.74 (95)	3.97 (101)	80.1
		3	230	5	●	55.36 (1406)	22.72 (577)	32.64 (829)	3.74 (95)	3.97 (101)	80.1
		3	460	5	●	55.36 (1406)	22.72 (577)	32.64 (829)	3.74 (95)	3.97 (101)	80.1
<b>40S - Motor dia. 6 inch, 3 wire motor, 60 Hz, rated flow 40 gpm (2" NPT)</b>											
40S75-21	429	3	230	7.5	●	69.22 (1758)	26.66 (677)	42.56 (1081)	3.74 (95)	3.97 (101)	113.3
		3	460	7.5	●	69.22 (1758)	26.66 (677)	42.56 (1081)	3.74 (95)	3.97 (101)	113.3
40S75-25	511	3	230	7.5	●	75.83 (1926)	26.66 (677)	49.18 (1249)	3.74 (95)	3.97 (101)	92.4
		3	460	7.5	●	75.83 (1926)	26.66 (677)	49.18 (1249)	3.74 (95)	3.97 (101)	92.4
40S100-30	613	3	460	10	●	88.04 (2236)	30.60 (777)	57.45 (1459)	3.74 (95)	3.97 (101)	166.0
40S150-37DS	756	3	230	15	▲	99.34 (2523)	27.88 (708)	71.46 (1815)	5.63 (143)	5.43 (138)	151.9
		3	460	15	▲	99.34 (2523)	27.88 (708)	71.46 (1815)	5.63 (143)	5.43 (138)	151.9
40S150-44DS	899	3	230	15	▲	110.91 (2817)	27.88 (708)	83.04 (2109)	5.63 (143)	5.43 (138)	165.1
		3	460	15	▲	110.91 (2817)	27.88 (708)	83.04 (2109)	5.63 (143)	5.43 (138)	151.9
40S200-50DS	1022	3	230	20	▲	136.23 (3460)	30.83 (783)	105.4 (2677)	5.63 (143)	5.51 (140)	226.9
		3	460	20	▲	136.23 (3460)	30.83 (783)	105.4 (2677)	5.63 (143)	5.51 (140)	226.9
40S200-58DS	1186	3	230	20	▲	149.45 (3796)	30.83 (783)	118.63 (3013)	5.63 (143)	5.51 (140)	251.1
		3	460	20	▲	149.45 (3796)	30.83 (783)	118.63 (3013)	5.63 (143)	5.51 (140)	251.1
40S200-66DS	1349	3	230	20	▲	162.68 (4132)	30.83 (783)	131.86 (3349)	5.63 (143)	5.51 (140)	266.5
		3	460	20	▲	162.68 (4132)	30.83 (783)	131.86 (3349)	5.63 (143)	5.51 (140)	266.5

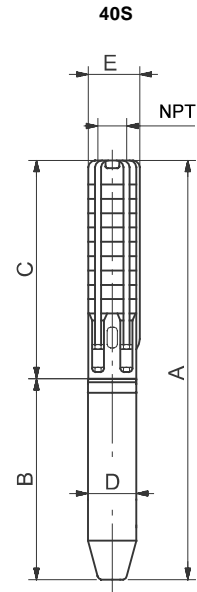

E = Maximum diameter of pump including cable guard and motor.

Notes:  
 Control box is required for 3-wire, single-phase applications. Data does not include control box.  
 DS designation = Built into sleeve, 2" NPT, 6" minimum well diameter.  
 ■ MS402 motor.  
 ● MS4000 motor.  
 ▲ MS6 motor.  
 ▲ MMS6000 motor.  
 ★ MMS8000 motor.  
 ◆ Takes MS6 motor; not available as complete.  
 ☆ Takes MMS6000 motor; not available as complete.  
 \* Takes MMS8000 motor; not available as complete.  
 † Takes MMS10000 motor; not available as complete.


### 60S (60 gpm)

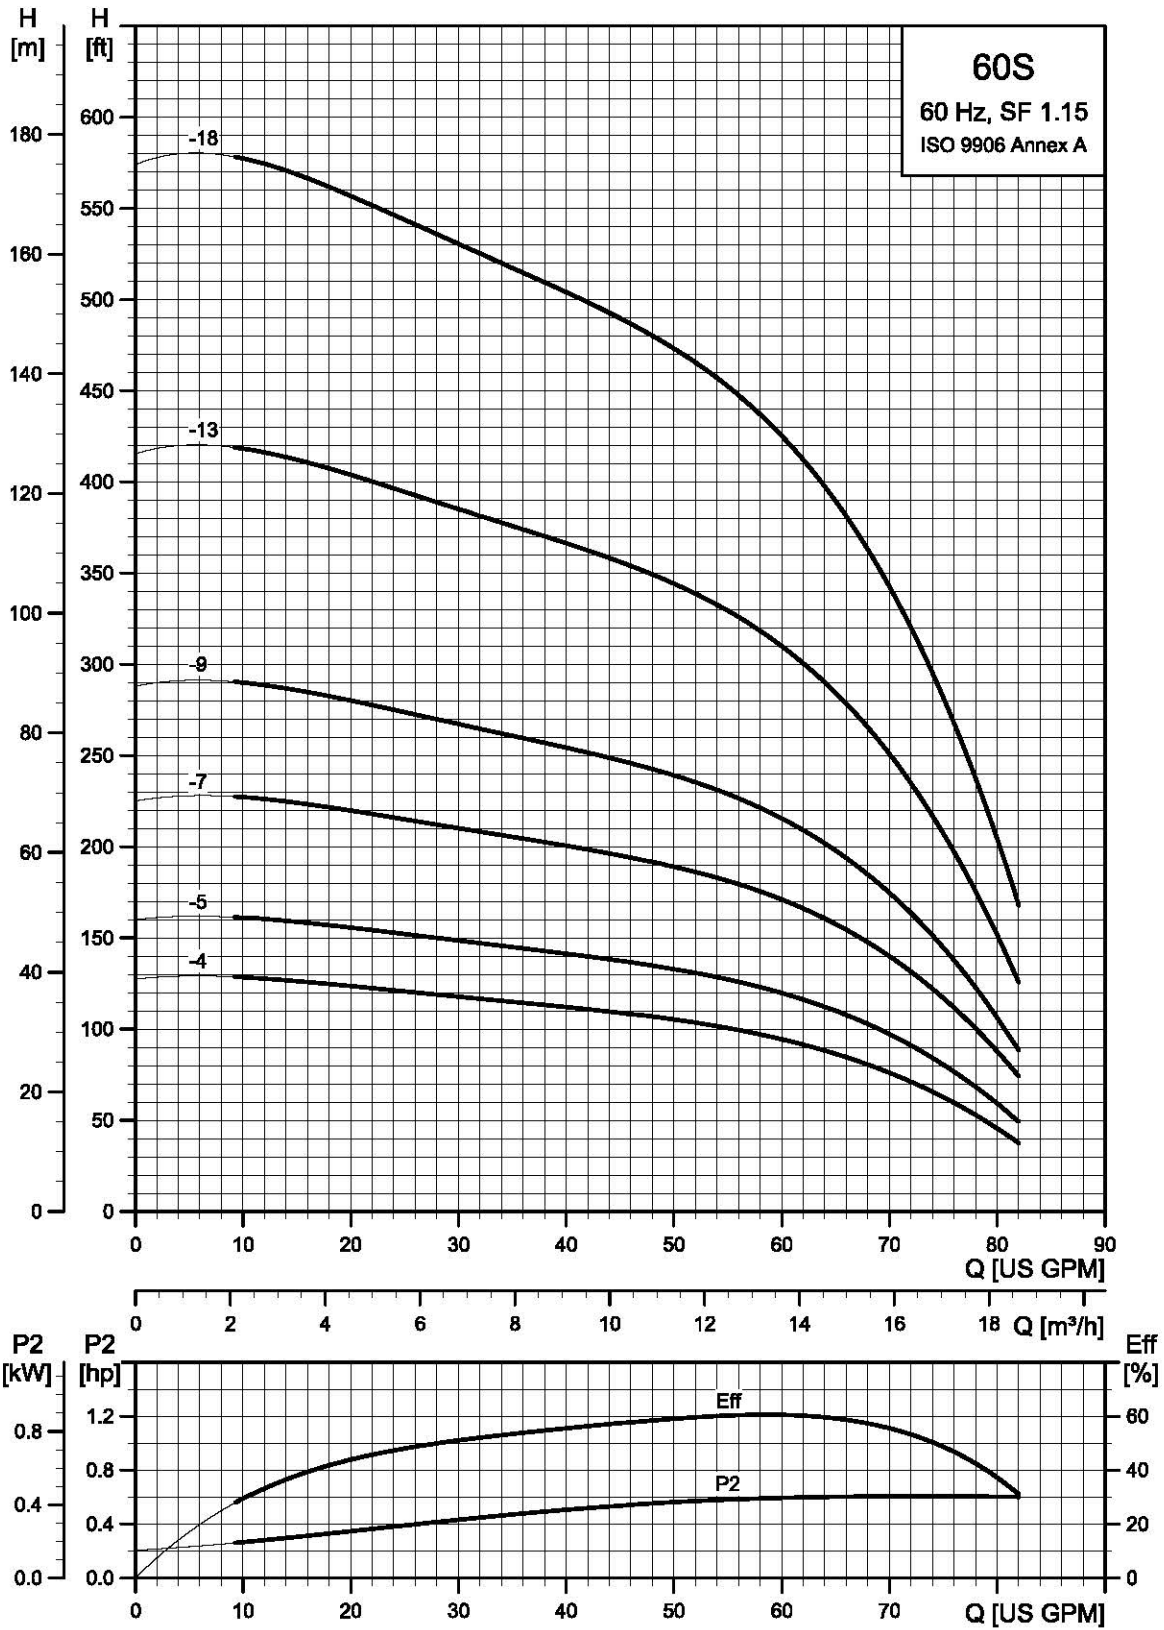

TM05 1736 0112

60S (60 gpm)

Pump model	Nom. head [ft]	Ph	Volts [V]	Motor [Hp]	Dimensions					Net weight (complete) [lb]	
					A	B	C	D	E		
					[in (mm)]	[in (mm)]	[in (mm)]	[in (mm)]	[in (mm)]		
<b>60S - Motor dia. 4 inch, 3 wire motor, 60 Hz, rated flow 60 gpm (2" NPT)</b>											
60S20-4	93	1	230	2	●	37.01 (940)	19.49 (495)	17.52 (445)	3.74 (95)	3.97 (101)	36.0
		3	230	2	■	31.23 (793)	13.71 (348)	17.52 (445)	3.74 (95)	3.97 (101)	36.0
		3	460	2	■	31.23 (793)	13.71 (348)	17.52 (445)	3.74 (95)	3.97 (101)	36.0
60S30-5	117	1	230	3	●	42.68 (1084)	22.60 (574)	20.08 (510)	3.74 (95)	3.97 (101)	61.2
		3	230	3	●	38.08 (967)	18.00 (457)	20.08 (510)	3.74 (95)	3.97 (101)	49.5
		3	460	3	●	38.08 (967)	18.00 (457)	20.08 (510)	3.74 (95)	3.97 (101)	58.5
60S50-7	164	1	230	5	●	51.82 (1316)	26.62 (676)	25.20 (640)	3.74 (95)	3.97 (101)	81.0
		3	230	5	●	47.92 (1217)	22.72 (577)	25.20 (640)	3.74 (95)	3.97 (101)	49.5
		3	460	5	●	47.92 (1217)	22.72 (577)	25.20 (640)	3.74 (95)	3.97 (101)	72.0
60S50-9	210	1	230	5	●	56.93 (1446)	26.62 (676)	30.32 (770)	3.74 (95)	3.97 (101)	85.5
		3	230	5	●	53.04 (1347)	22.72 (577)	30.32 (770)	3.74 (95)	3.97 (101)	76.5
		3	460	5	●	53.04 (1347)	22.72 (577)	30.32 (770)	3.74 (95)	3.97 (101)	76.5
60S75-13	304	3	230	7.5	●	67.21 (1707)	26.66 (677)	40.56 (1030)	3.74 (95)	3.97 (101)	83.3
		3	460	7.5	●	67.21 (1707)	26.66 (677)	40.56 (1030)	3.74 (95)	3.97 (101)	136.8
60S100-18	420	3	460	10	●	83.94 (2132)	30.60 (777)	53.35 (1355)	3.74 (95)	3.97 (101)	175.5
<b>60S - Motor dia. 6 inch, 3 wire motor, 60 Hz, rated flow 60 gpm (2" NPT)</b>											
60S75-13	304	3	230	7.5	▲	65.24 (1657)	22.25 (565)	43.00 (1092)	5.63 (143)	5.43 (138)	136.8
		3	460	7.5	▲	65.24 (1657)	22.25 (565)	43.00 (1092)	5.63 (143)	5.43 (138)	136.8
60S100-18	420	3	230	10	▲	79.02 (2007)	23.23 (590)	55.79 (1417)	5.63 (143)	5.43 (138)	207.0
		3	460	10	▲	79.02 (2007)	23.23 (590)	55.79 (1417)	5.63 (143)	5.43 (138)	207.0

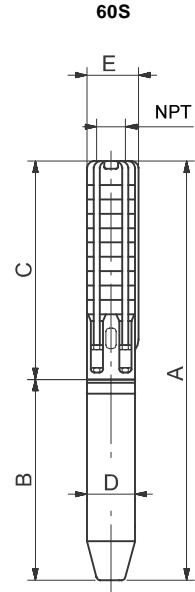

TM05 2399 5011


E = Maximum diameter of pump including cable guard and motor.

Notes:

Control box is required for 3-wire, single-phase applications. Data does not include control box diameter.

- MS402 motor.
- MS4000 motor.
- ▲ MS6 motor.
- △ MMS6000 motor.
- ★ MMS8000 motor.
- ◆ Takes MS6 motor; not available as complete.
- ⊙ Takes MMS6000 motor; not available as complete.
- \* Takes MMS8000 motor; not available as complete.
- † Takes MMS10000 motor; not available as complete.

### 75S (75 gpm)

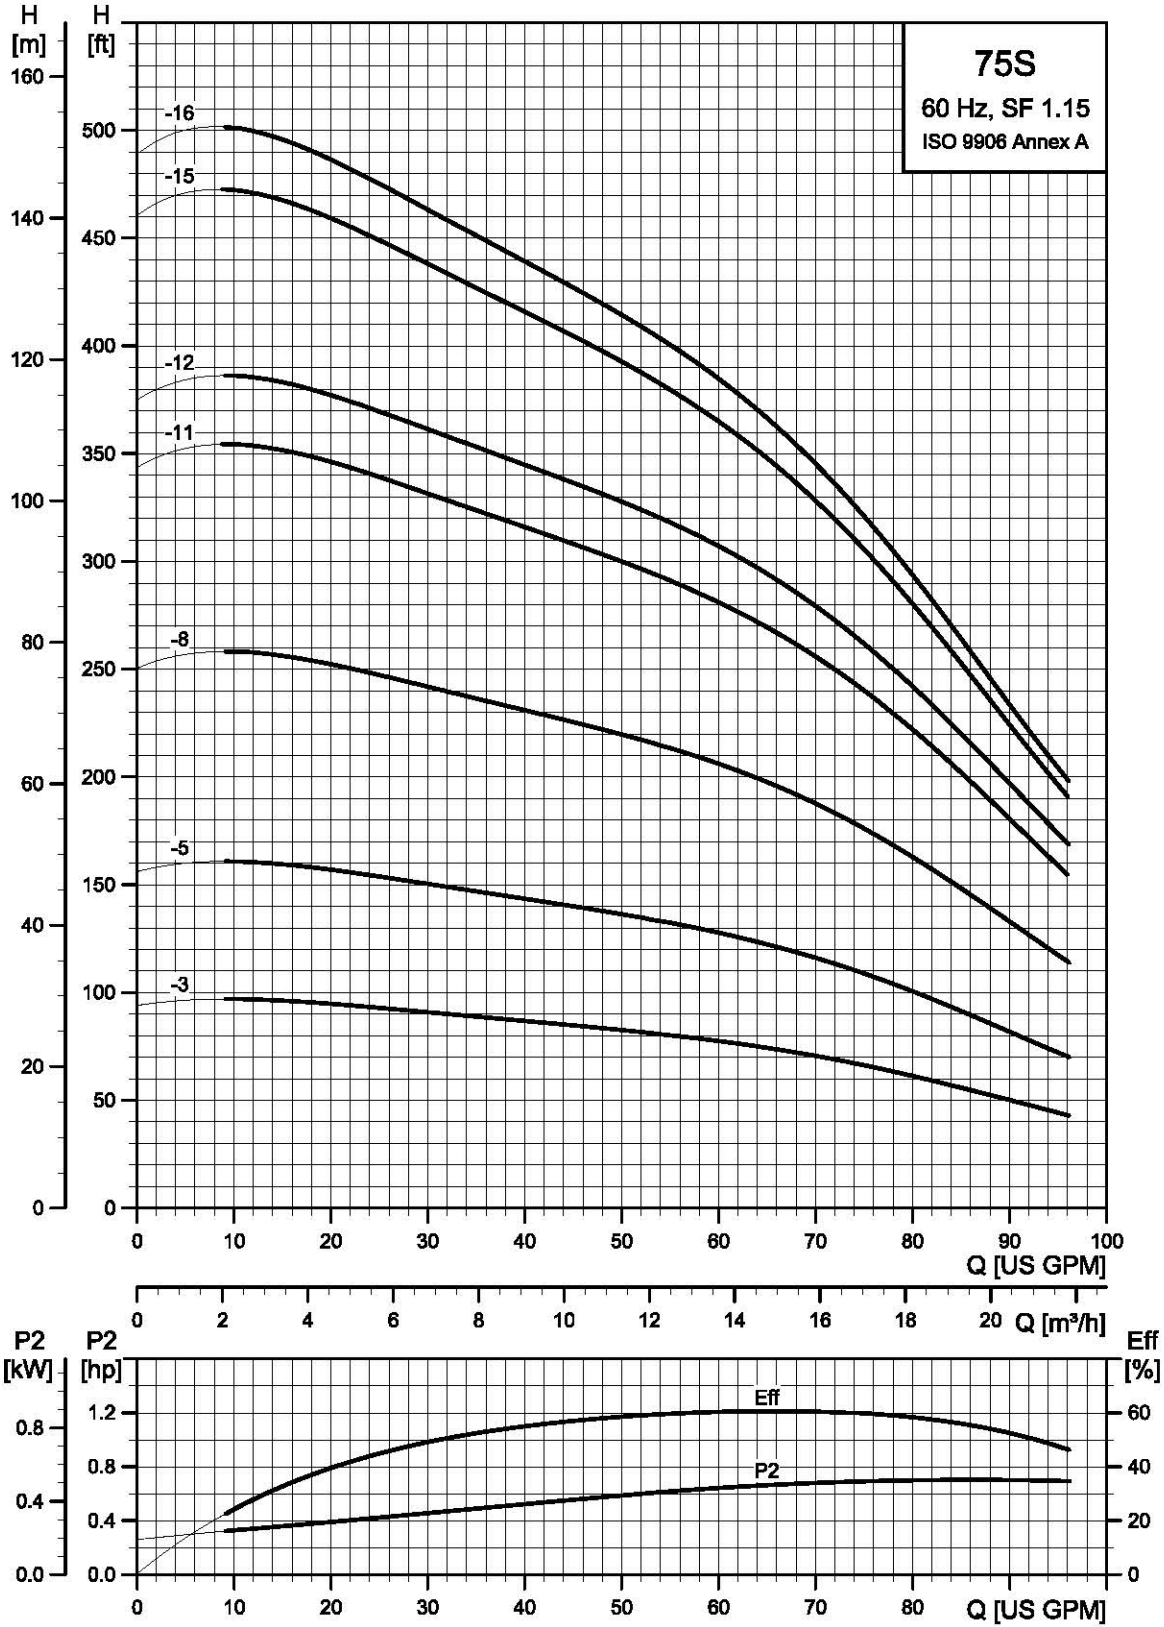


TM05 0234 0112



### 75S (75 gpm)

Pump model	Nom. head [ft]	Ph	Volts [V]	Motor [Hp]	Dimensions					Net weight (complete) [lb]	
					A [in (mm)]	B [in (mm)]	C [in (mm)]	D [in (mm)]	E [in (mm)]		
<b>75S - Motor dia. 4 inch, 3 wire motor, 60 Hz, rated flow 75 gpm (2" NPT)</b>											
75S20-3	68	3	230	2	●	34.45 (875)	19.49 (495)	14.97 (380)	3.74 (95)	3.97 (101)	36.9
			230	2	■	28.67 (728)	13.71 (348)	14.97 (380)	3.74 (95)	3.97 (101)	34.2
			460	2	■	28.67 (728)	13.71 (348)	14.97 (380)	3.74 (95)	3.97 (101)	34.2
75S30-5	114	3	230	3	●	42.68 (1084)	22.60 (574)	20.08 (510)	3.74 (95)	3.97 (101)	69.3
			230	3	●	38.08 (967)	18.00 (457)	20.08 (510)	3.74 (95)	3.97 (101)	57.6
			460	3	●	38.08 (967)	18.00 (457)	20.08 (510)	3.74 (95)	3.97 (101)	57.6
75S50-8	182	3	230	5	●	54.38 (1381)	26.62 (676)	27.76 (705)	3.74 (95)	3.97 (101)	87.3
			230	5	●	50.48 (1282)	22.72 (577)	27.76 (705)	3.74 (95)	3.97 (101)	74.7
			460	5	●	50.48 (1282)	22.72 (577)	27.76 (705)	3.74 (95)	3.97 (101)	74.7
75S75-12	273	3	230	7.5	●	64.65 (1642)	26.66 (677)	38.00 (965)	3.74 (95)	3.97 (101)	81.4
			460	7.5	●	64.65 (1642)	26.66 (677)	38.00 (965)	3.74 (95)	3.97 (101)	81.4
75S100-16	364	3	460	10	●	78.82 (2002)	30.60 (777)	48.23 (1225)	3.74 (95)	3.97 (101)	138.0
<b>75S - Motor dia. 6 inch, 3 wire motor, 60 Hz, rated flow 75 gpm (2" NPT)</b>											
75S75-11	250	3	230	7.5	▲	60.12 (1527)	22.25 (565)	37.88 (962)	5.63 (143)	5.43 (138)	130.5
			460	7.5	▲	60.12 (1527)	22.25 (565)	37.88 (962)	5.63 (143)	5.43 (138)	130.5
75S100-15	341	3	230	10	▲	70.16 (1782)	23.23 (590)	46.93 (1192)	5.63 (143)	5.43 (138)	175.5
			460	10	▲	70.16 (1782)	23.23 (590)	46.93 (1192)	5.63 (143)	5.43 (138)	175.5


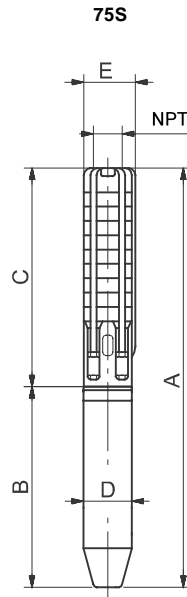


TM05 2399 5011

E = Maximum diameter of pump including cable guard and motor.



- Notes:  
 Control box is required for 3-wire, single-phase applications. Data does not include control box.
- MS402 motor.
  - MS4000 motor.
  - ▲ MS6 motor.
  - △ MMS6000 motor.
  - ★ MMS8000 motor.
  - ◆ Takes MS6 motor; not available as complete.
  - ☆ Takes MMS6000 motor; not available as complete.
  - \* Takes MMS8000 motor; not available as complete.
  - † Takes MMS10000 motor; not available as complete.

### 85S (85 gpm)

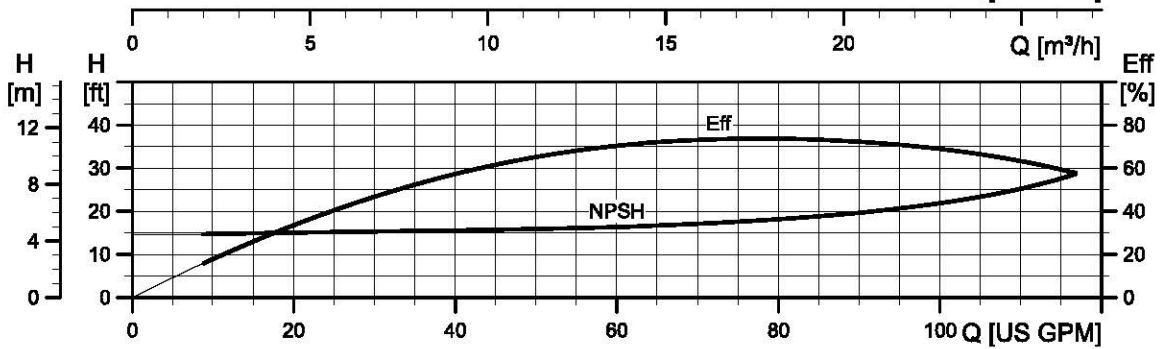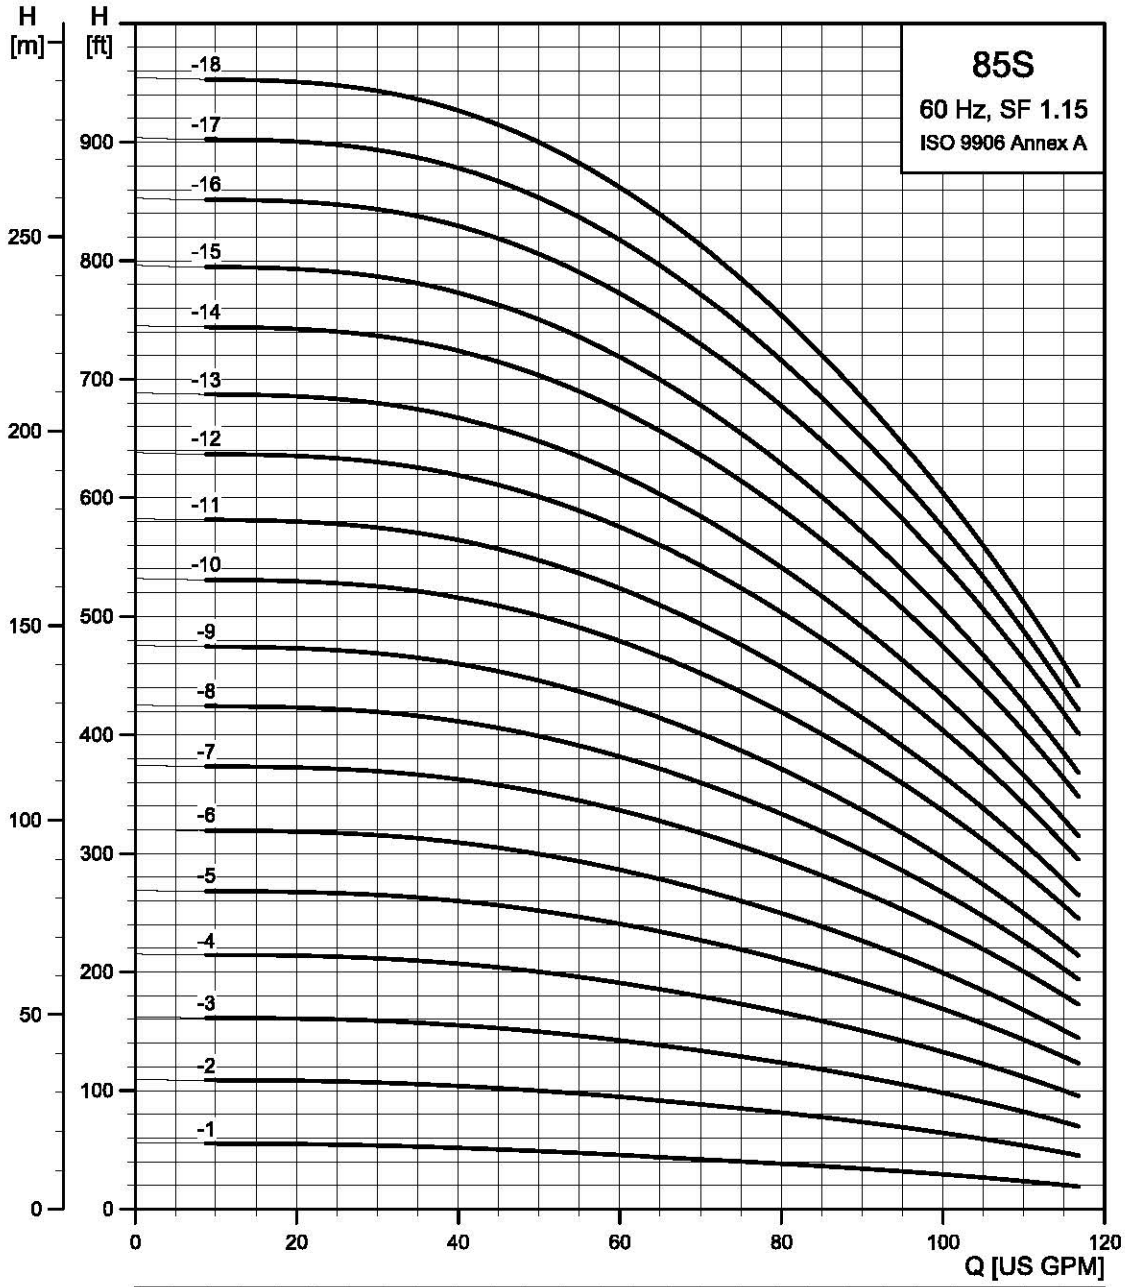


TM05 0235 0112

85S (85 gpm)

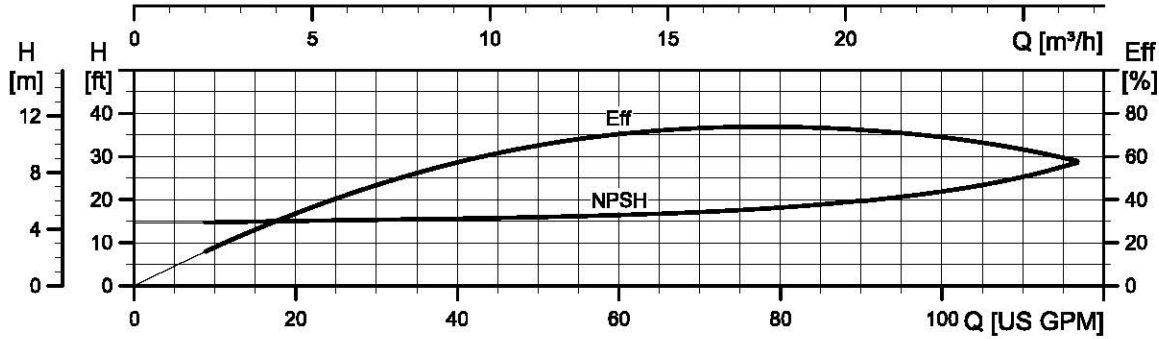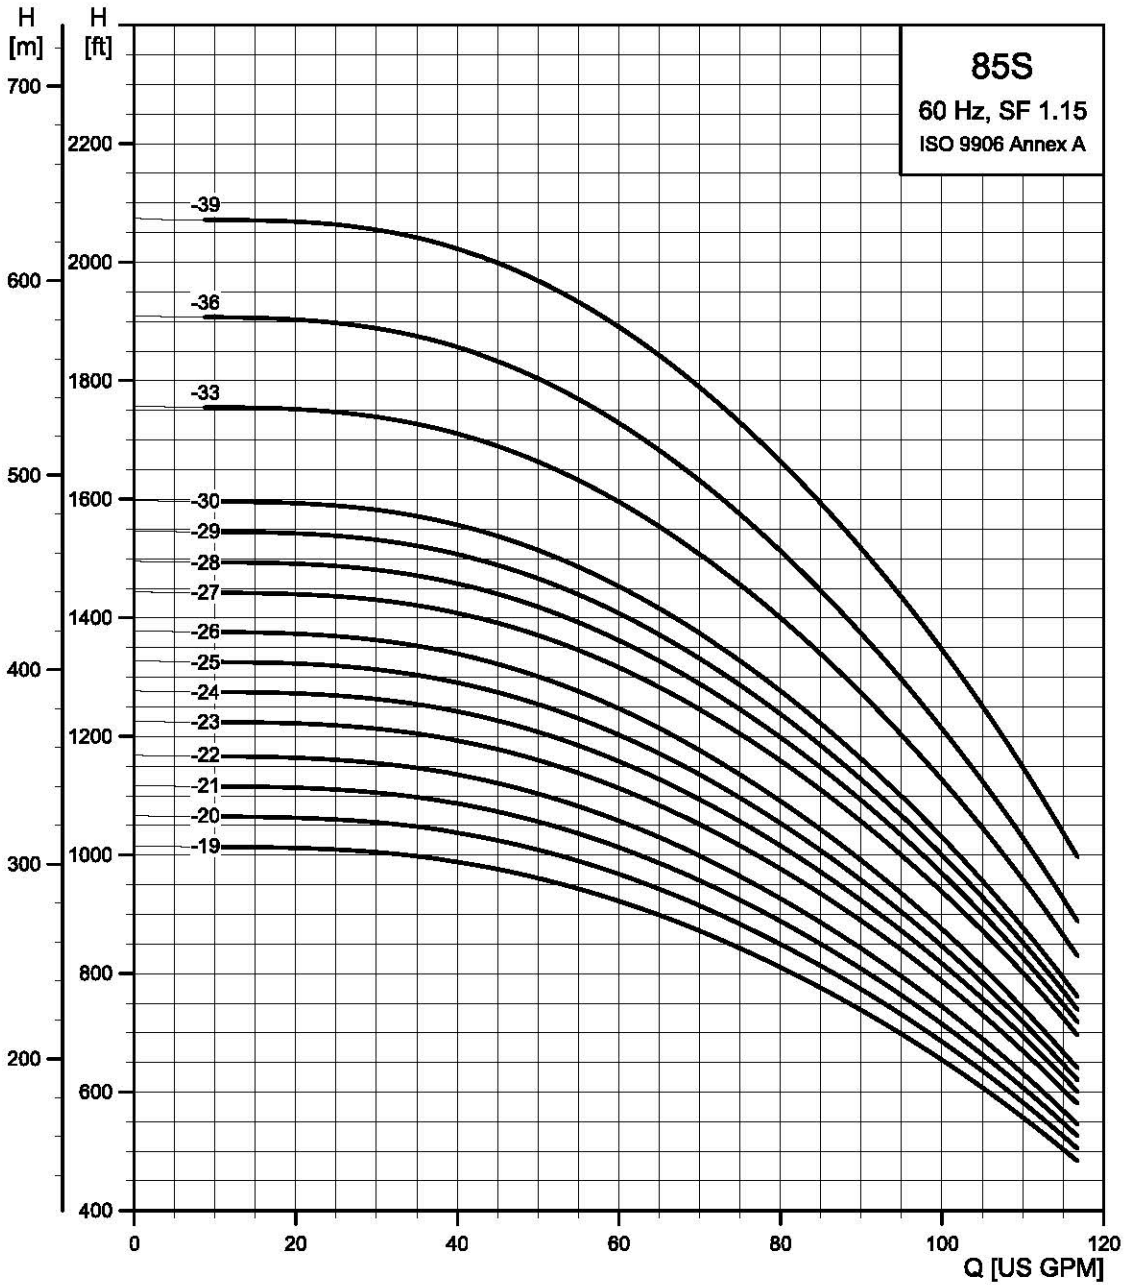


TMG05 0236 0112

85S (85 gpm) pump power requirement (P2)

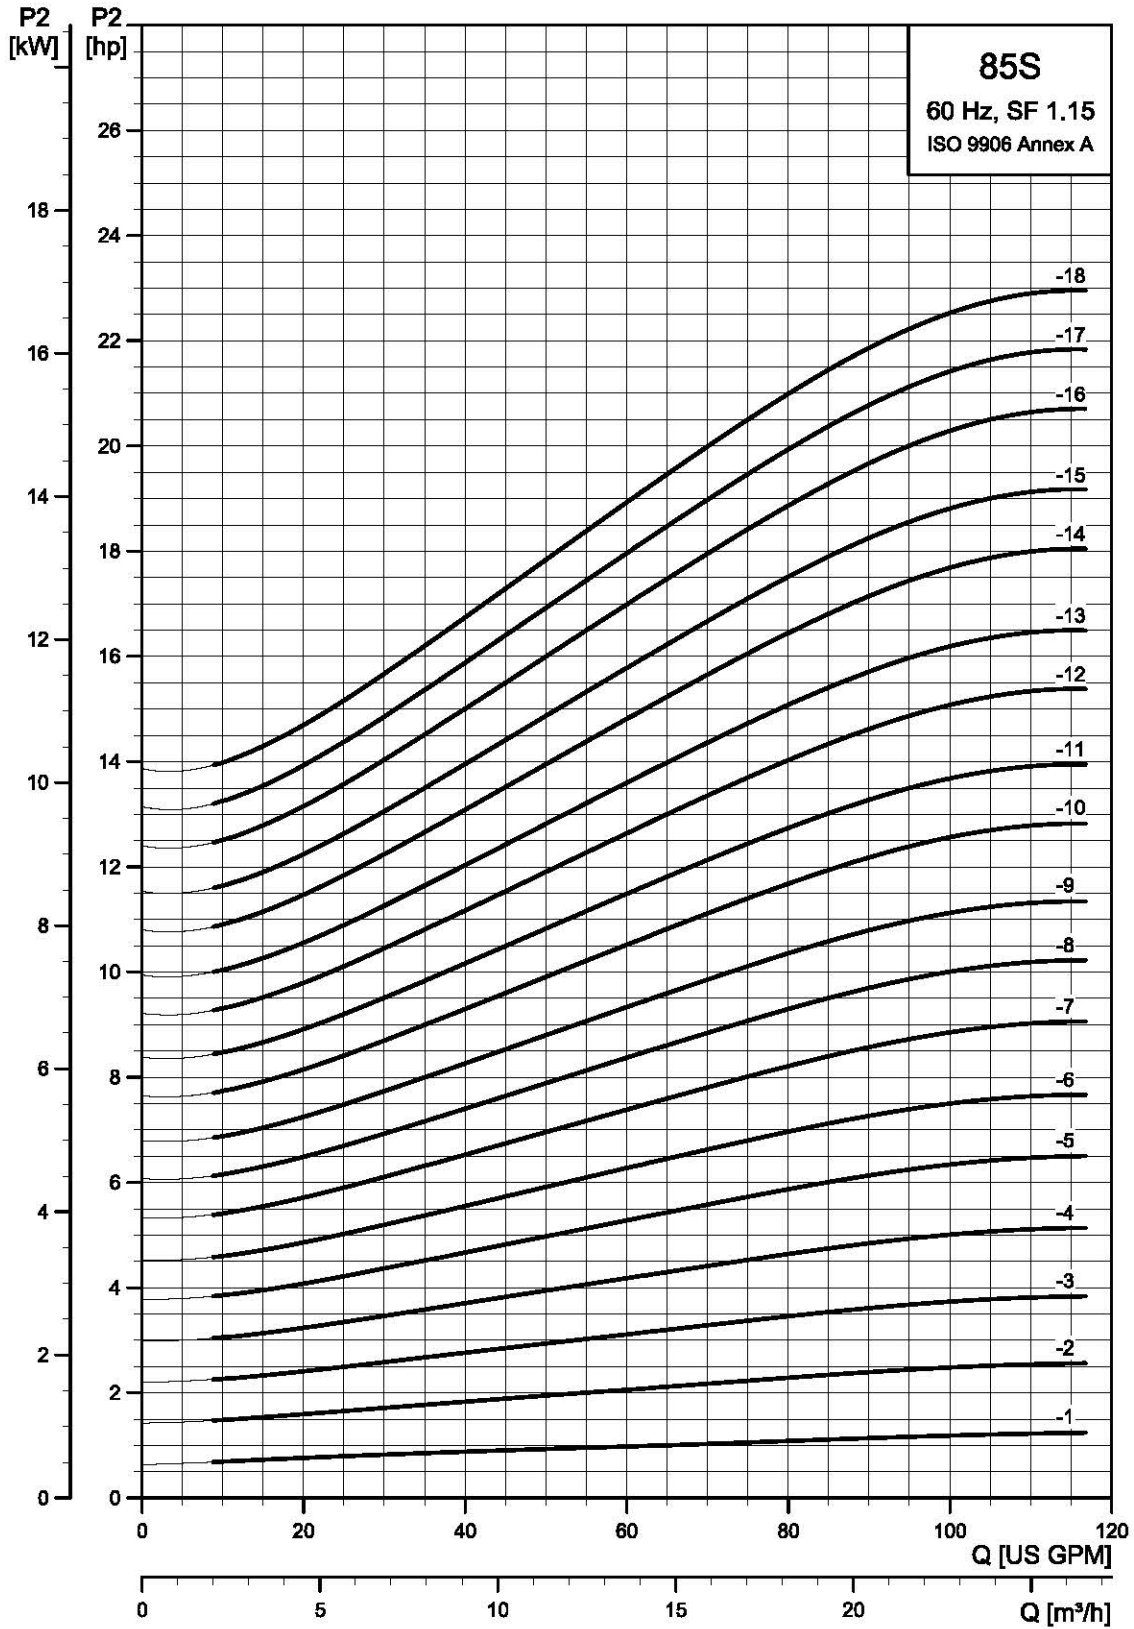

TM05 0237 0112

85S (85 gpm) pump power requirement (P2)

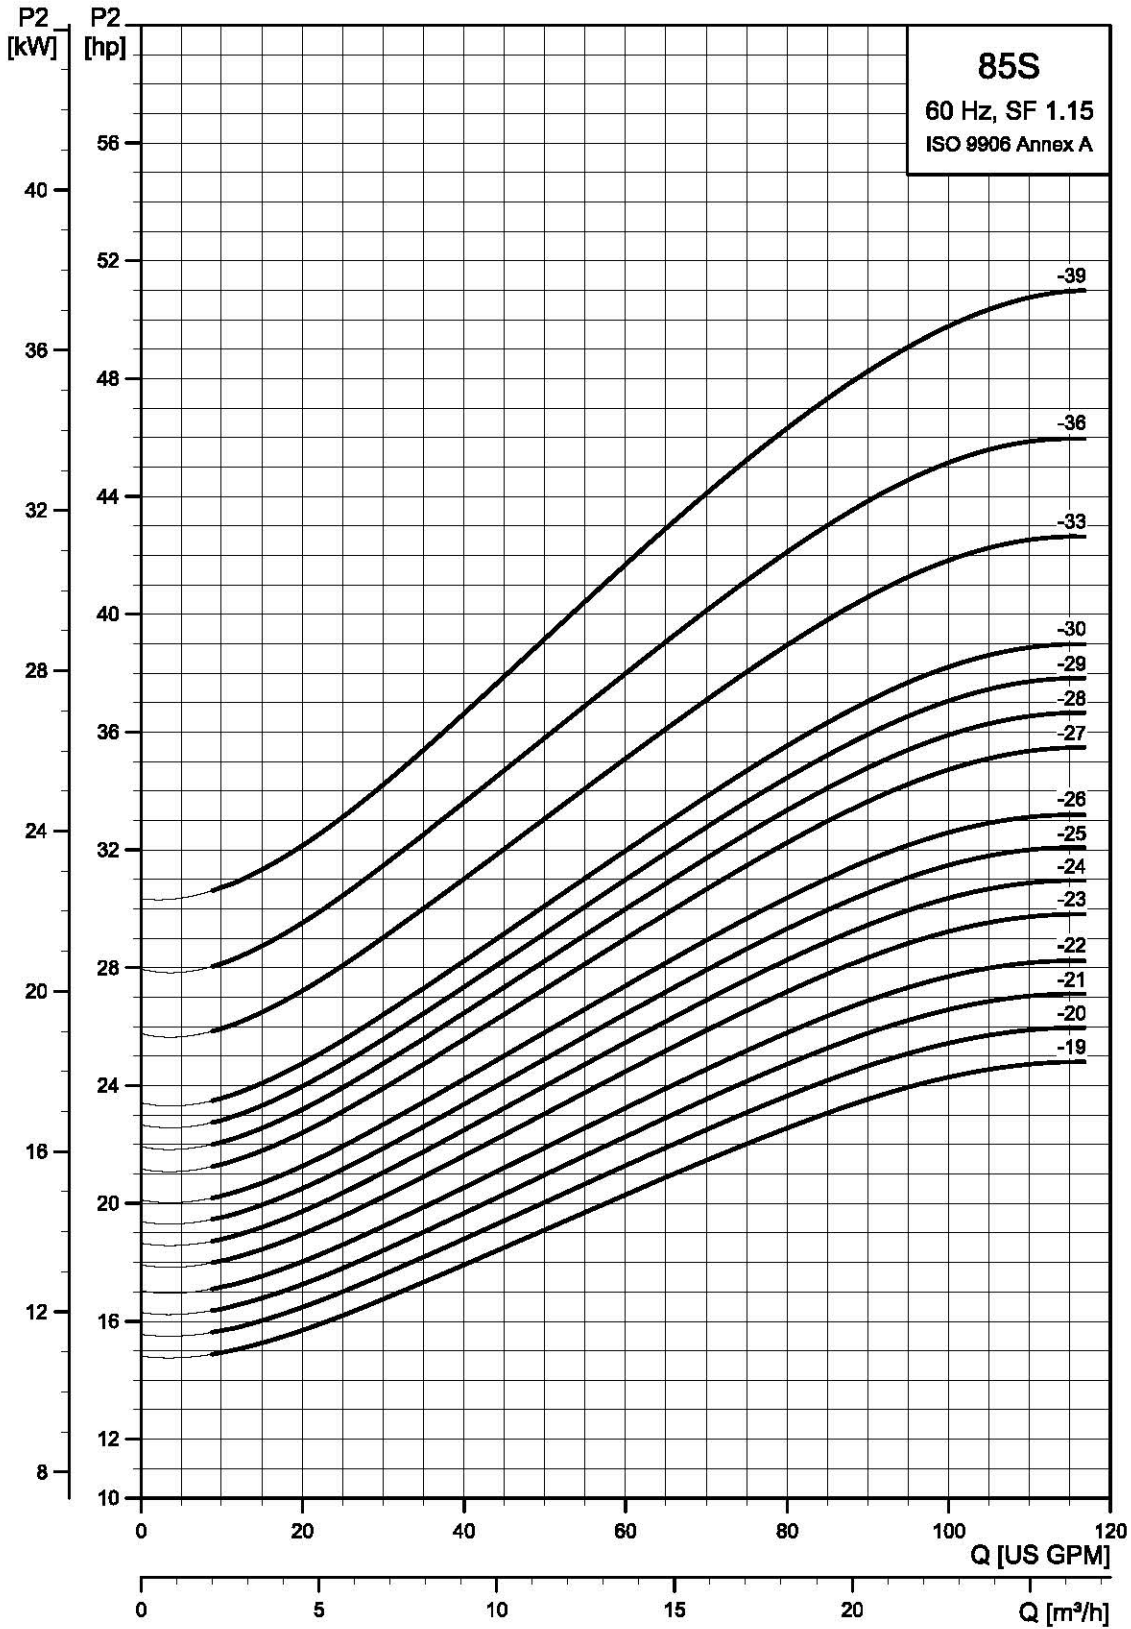

TM05 0238 0112

## 85S (85 gpm)


Pump model	Nom. head [ft]	Ph	Volts [V]	Motor [Hp]	Dimensions					Net weight (complete) [lb]	
					A [in (mm)]	B [in (mm)]	C [in (mm)]	D [in (mm)]	E [in (mm)]		
<b>85S - Motor dia. 4 inch, 3 wire motor, 60 Hz, rated flow 85 gpm (3" NPT)</b>											
85S15-1	35	1	230	1.5	■	27.60 (701)	15.24 (387)	12.36 (314)	3.74 (95)	5.16 (131)	29.7
		3	230	1.5	■	26.02 (661)	13.66 (347)	12.36 (314)	3.74 (95)	5.16 (131)	29.7
		3	460	1.5	■	26.02 (661)	13.66 (347)	12.36 (314)	3.74 (95)	5.16 (131)	29.7
85S30-2	74	1	230	3	●	32.69 (830)	22.72 (577)	14.72 (374)	3.74 (95)	5.16 (131)	55.8
		3	230	3	●	32.69 (830)	17.96 (456)	14.72 (374)	3.74 (95)	5.16 (131)	47.7
		3	460	3	●	32.69 (830)	17.96 (456)	14.72 (374)	3.74 (95)	5.16 (131)	47.7
85S50-3	114	1	230	5	●	43.78 (1112)	26.65 (677)	17.13 (435)	3.74 (95)	5.16 (131)	67.5
		3	230	5	●	39.80 (1011)	22.69 (576)	17.13 (435)	3.74 (95)	5.16 (131)	51.3
		3	460	5	●	39.80 (1011)	22.69 (576)	17.13 (435)	3.74 (95)	5.16 (131)	51.3
85S50-4	154	1	230	5	●	43.78 (1112)	26.65 (677)	17.13 (435)	3.74 (95)	5.16 (131)	69.3
		3	230	5	●	39.80 (1011)	22.69 (576)	17.13 (435)	3.74 (95)	5.16 (131)	61.2
		3	460	5	●	39.80 (1011)	22.69 (576)	17.13 (435)	3.74 (95)	5.16 (131)	61.2
85S75-5	194	3	230	7.5	●	48.50 (1232)	26.62 (676)	21.89 (556)	3.74 (95)	5.16 (131)	73.8
		3	460	7.5	●	48.50 (1232)	26.62 (676)	21.89 (556)	3.74 (95)	5.16 (131)	73.8
85S75-6	234	3	230	7.5	●	50.87 (1292)	26.62 (676)	24.25 (616)	3.74 (95)	5.16 (131)	85.5
		3	460	7.5	●	50.87 (1292)	26.62 (676)	24.25 (616)	3.74 (95)	5.16 (131)	76.5
85S100-7	274	3	460	10	●	57.21 (1453)	30.56 (776)	26.65 (677)	3.74 (95)	5.16 (131)	136.8
85S100-8	314	3	460	10	●	59.57 (1513)	30.56 (776)	29.02 (737)	3.74 (95)	5.16 (131)	138.6
85S100-9	353	3	460	10	●	61.98 (1574)	30.56 (776)	31.42 (798)	3.74 (95)	5.16 (131)	140.4

<b>85S - Motor dia. 6 inch, 3 wire motor, 60 Hz, rated flow 85 gpm (3" NPT)</b>											
85S75-5	194	3	230	7.5	▲	44.76 (1137)	22.52 (565)	22.52 (572)	5.63 (143)	5.59 (142)	98.1
		3	460	7.5	▲	44.76 (1137)	22.52 (565)	22.52 (572)	5.63 (143)	5.59 (142)	98.1
85S75-6	234	3	230	7.5	▲	47.12 (1197)	22.24 (565)	24.88 (632)	5.63 (143)	5.59 (142)	99.9
		3	460	7.5	▲	47.12 (1197)	22.24 (565)	24.88 (632)	5.63 (143)	5.59 (142)	99.9
85S100-7	274	3	230	10	▲	50.51 (1283)	23.23 (590)	27.28 (693)	5.63 (143)	5.59 (142)	103.5
		3	460	10	▲	50.51 (1283)	23.23 (590)	27.28 (693)	5.63 (143)	5.59 (142)	103.5
85S100-8	314	3	230	10	▲	52.87 (1343)	23.23 (590)	29.65 (753)	5.63 (143)	5.59 (142)	105.3
		3	460	10	▲	52.87 (1343)	23.23 (590)	29.65 (753)	5.63 (143)	5.59 (142)	105.3
85S100-9	353	3	230	10	▲	55.28 (1404)	23.23 (590)	32.05 (814)	5.63 (143)	5.60 (142)	108.0
		3	460	10	▲	55.28 (1404)	23.23 (590)	32.05 (814)	5.63 (143)	5.60 (142)	108.0
85S150-10	393	3	230	15	▲	62.29 (1582)	27.88 (708)	34.41 (874)	5.63 (143)	5.60 (142)	122.4
		3	460	15	▲	62.29 (1582)	27.88 (708)	34.41 (874)	5.63 (143)	5.60 (142)	122.4
85S150-11	433	3	230	15	▲	64.69 (1643)	27.88 (708)	36.82 (935)	5.63 (143)	5.60 (142)	126.0
		3	460	15	▲	64.69 (1643)	27.88 (708)	36.82 (935)	5.63 (143)	5.60 (142)	126.0
85S150-12	473	3	230	15	▲	67.05 (1703)	27.88 (708)	39.18 (995)	5.63 (143)	5.60 (142)	133.2
		3	460	15	▲	67.05 (1703)	27.88 (708)	39.18 (995)	5.63 (143)	5.60 (142)	133.2
85S150-13	513	3	230	15	▲	69.45 (1764)	27.88 (708)	41.58 (1056)	5.63 (143)	5.60 (142)	135.0
		3	460	15	▲	69.45 (1764)	27.88 (708)	41.58 (1056)	5.63 (143)	5.60 (142)	135.0

## Notes:

Control box is required for 3-wire, single-phase applications. Data does not include control box.

- MS402 motor.
- MS4000 motor.
- ▲ MS6 motor.
- △ MMS6000 motor.
- ★ MMS8000 motor.
- ◆ Takes MS6 motor; not available as complete.
- ☆ Takes MMS6000 motor; not available as complete.
- \* Takes MMS8000 motor; not available as complete.
- † Takes MMS10000 motor; not available as complete.

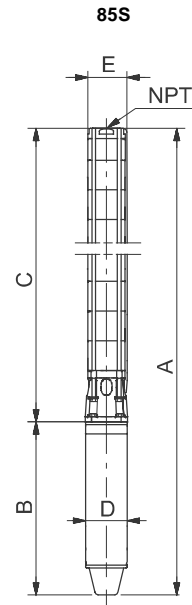


TM05 2400 5011

E = Maximum diameter of pump including cable guard and motor.

### 85S (85 gpm)

Pump model	Nom. head [ft]	Ph	Volts [V]	Motor [Hp]	Dimensions					Net weight (complete) [lb]
					A [in (mm)]	B [in (mm)]	C [in (mm)]	D [in (mm)]	E [in (mm)]	
<b>85S - Motor dia. 6 inch, 3 wire motor, 60 Hz, rated flow 85 gpm (3" NPT)</b>										
85S200-14	533	3	230	20	▲ 74.77 (1899)	30.83 (783)	43.94 (1116)	5.63 (143)	5.60 (142)	143.1
		3	460	20	▲ 74.77 (1899)	30.83 (783)	43.94 (1116)	5.63 (143)	5.60 (142)	143.1
85S200-15	593	3	230	20	▲ 77.17 (1960)	30.83 (783)	46.34 (1177)	5.63 (143)	5.60 (142)	147.6
		3	460	20	▲ 77.17 (1960)	30.83 (783)	46.34 (1177)	5.63 (143)	5.60 (142)	147.6
85S200-16	633	3	230	20	▲ 79.53 (2020)	30.83 (783)	48.71 (1237)	5.63 (143)	5.60 (142)	157.5
		3	460	20	▲ 79.53 (2020)	30.83 (783)	48.71 (1237)	5.63 (143)	5.60 (142)	157.5
85S200-17	672	3	230	20	▲ 81.93 (2081)	30.83 (783)	51.11 (1298)	5.63 (143)	5.60 (142)	160.2
		3	460	20	▲ 81.93 (2081)	30.83 (783)	51.11 (1298)	5.63 (143)	5.60 (142)	160.2
85S200-18	712	3	230	20	▲ 84.30 (2141)	30.83 (783)	53.47 (1358)	5.63 (143)	5.60 (142)	161.1
		3	460	20	▲ 84.30 (2141)	30.83 (783)	53.47 (1358)	5.63 (143)	5.60 (142)	179.0
85S250-19	752	3	230	25	▲ 88.86 (2257)	33.00 (838)	55.87 (1419)	5.63 (143)	5.60 (142)	191.7
		3	460	25	▲ 88.86 (2257)	33.00 (838)	55.87 (1419)	5.63 (143)	5.60 (142)	191.7
85S250-20	792	3	230	25	▲ 91.86 (2333)	33.00 (838)	58.86 (1495)	5.63 (143)	5.60 (142)	195.3
		3	460	25	▲ 91.86 (2333)	33.00 (838)	58.86 (1495)	5.63 (143)	5.60 (142)	195.3
85S250-21	832	3	230	25	▲ 94.26 (2394)	33.00 (838)	61.26 (1556)	5.63 (143)	5.60 (142)	198.0
		3	460	25	▲ 94.26 (2394)	33.00 (838)	61.26 (1556)	5.63 (143)	5.60 (142)	198.0
85S250-22	872	3	230	25	▲ 96.62 (2454)	33.00 (838)	63.63 (1616)	5.63 (143)	5.60 (142)	199.8
		3	460	25	▲ 96.62 (2454)	33.00 (838)	63.63 (1616)	5.63 (143)	5.60 (142)	199.8
85S300-23	912	3	230	30	▲ 101.54 (2579)	35.56 (903)	65.99 (1676)	5.63 (143)	5.60 (142)	199.8
		3	460	30	▲ 101.54 (2579)	35.56 (903)	65.99 (1676)	5.63 (143)	5.60 (142)	199.8
85S300-24	952	3	230	30	▲ 103.94 (2640)	35.56 (903)	68.39 (1737)	5.63 (143)	5.60 (142)	216.0
		3	460	30	▲ 103.94 (2640)	35.56 (903)	68.39 (1737)	5.63 (143)	5.60 (142)	216.0
85S300-25	991	3	230	30	▲ 106.34 (2701)	35.56 (903)	70.79 (1798)	5.63 (143)	5.60 (142)	219.6
		3	460	30	▲ 106.34 (2701)	35.56 (903)	70.79 (1798)	5.63 (143)	5.60 (142)	219.6
85S300-26	1031	3	230	30	▲ 108.71 (2761)	35.56 (903)	73.15 (1858)	5.63 (143)	5.60 (142)	221.4
		3	460	30	▲ 108.71 (2761)	35.56 (903)	73.15 (1858)	5.63 (143)	5.60 (142)	221.4
85S300-27	1071	3	230	30	▲ 111.11 (2822)	35.56 (903)	75.56 (1919)	5.63 (143)	5.60 (142)	234.9
		3	460	30	▲ 111.11 (2822)	35.56 (903)	75.56 (1919)	5.63 (143)	5.60 (142)	234.9
85S400-28	1111	3	460	40	▲ 118.19 (3002)	40.28 (1023)	77.92 (1979)	5.63 (143)	5.60 (142)	246.6
85S400-29	1151	3	460	40	▲ 120.6 (3063)	40.28 (1023)	80.32 (2040)	5.63 (143)	5.60 (142)	248.4
85S400-30	1191	3	460	40	▲ 122.96 (3123)	40.28 (1023)	82.68 (2100)	5.63 (143)	5.60 (142)	270.0
85S400-33DS	1310	3	460	40	▲ 139.22 (3536)	40.28 (1023)	98.94 (2513)	5.63 (143)	6.90 (176)	515.5
85S400-36DS	1430	3	460	40	▲ 146.34 (3717)	40.28 (1023)	106.07 (2694)	5.63 (143)	6.90 (176)	454.8
85S500-39DS	1510	3	460	50	▲ 169.26 (4299)	56.03 (1423)	113.23 (2876)	5.63 (143)	6.90 (176)	469.0
<b>85S - Motor dia. 8 inch, 3 wire motor, 60 Hz, rated flow 85 gpm (3" NPT)</b>										
85S400-33DS	1310	3	460	40	★ 140.87 (3578)	43.71 (1110)	97.17 (2468)	7.56 (192)	7.56 (192)	652.7
85S400-36DS	1310	3	460	40	★ 147.96 (3758)	43.71 (1110)	104.26 (2648)	7.56 (192)	7.56 (192)	592.0
85S400-39DS	1510	3	460	50	★ 155.04 (3938)	43.71 (1110)	111.34 (2828)	7.56 (192)	7.56 (192)	537.2

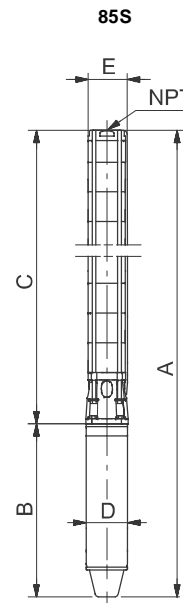

TM05 2400 5011

E = Maximum diameter of pump including cable guard and motor.



**Notes:**

Control box is required for 3-wire, single-phase applications. Data does not include control box.

DS designation = Built into sleeve, 3" NPT, 8" minimum well diameter.

- MS402 motor.
- MS4000 motor.
- ▲ MS6 motor.
- △ MMS6000 motor.
- ★ MMS8000 motor.
- ◆ Takes MS6 motor; not available as complete.
- ⊛ Takes MMS6000 motor; not available as complete.
- \* Takes MMS8000 motor; not available as complete.
- † Takes MMS10000 motor; not available as complete.



### 150S (150 gpm)

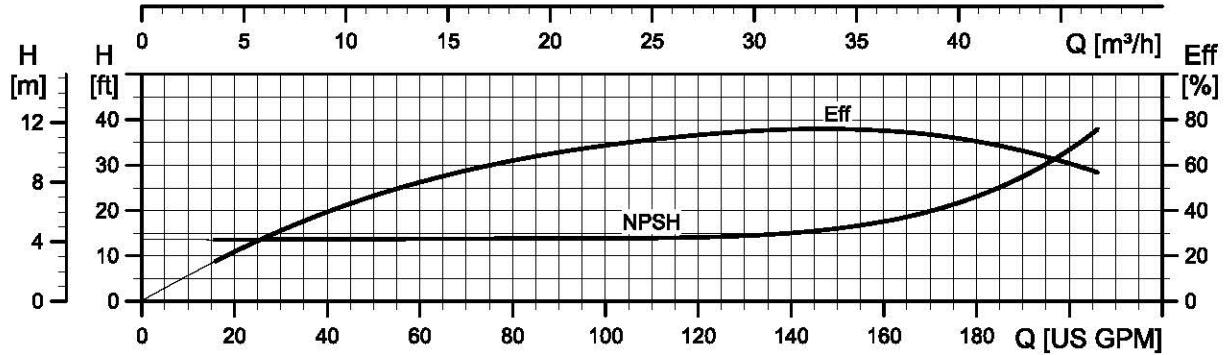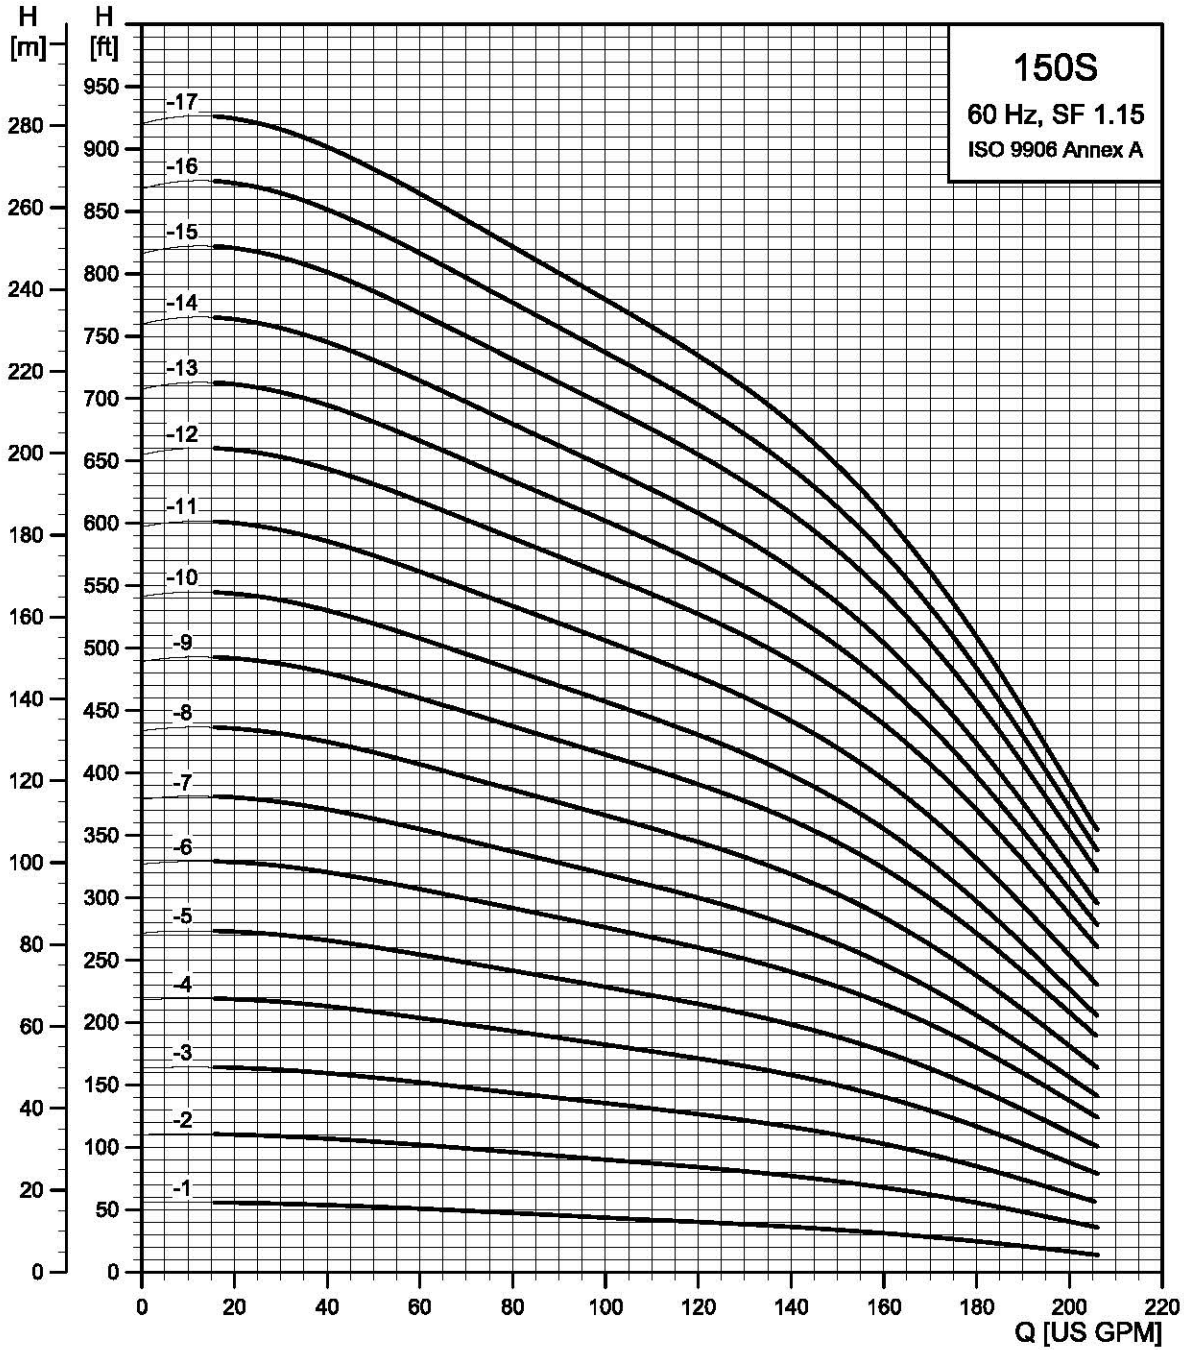

TM05 0238 0112




150S (150 gpm)

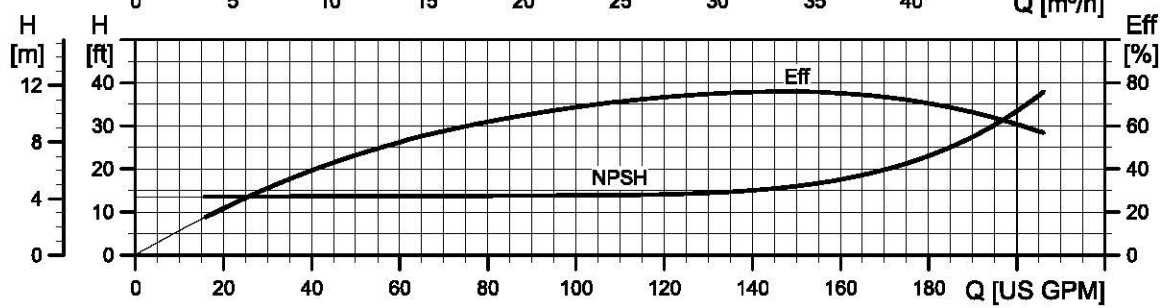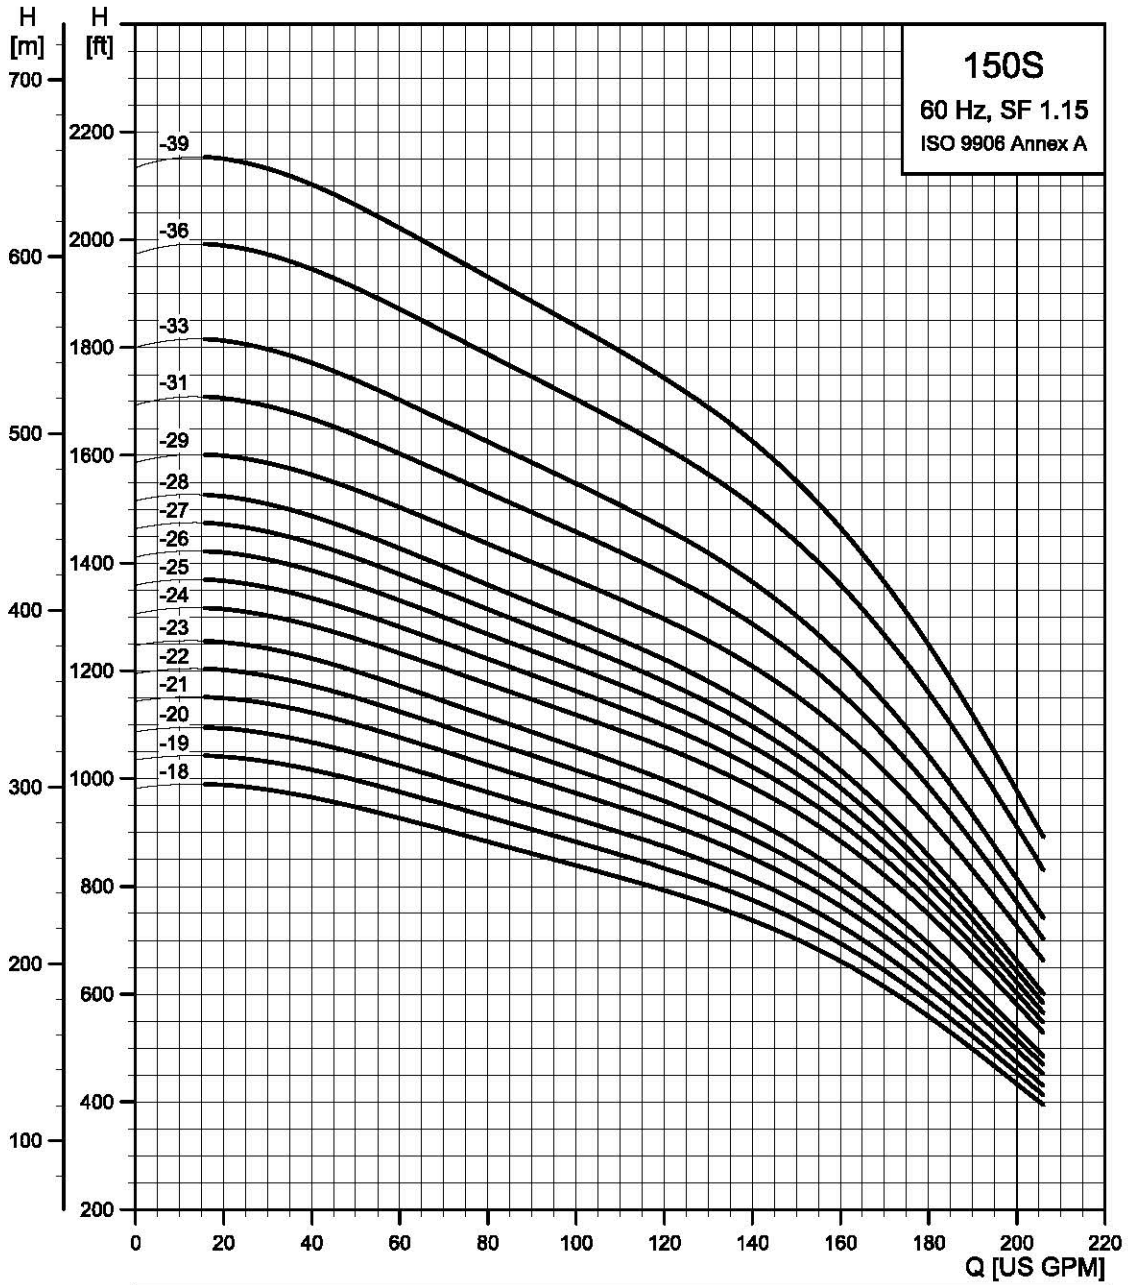


TM05 0240 0112

150S (150 gpm) pump power requirement (P2)

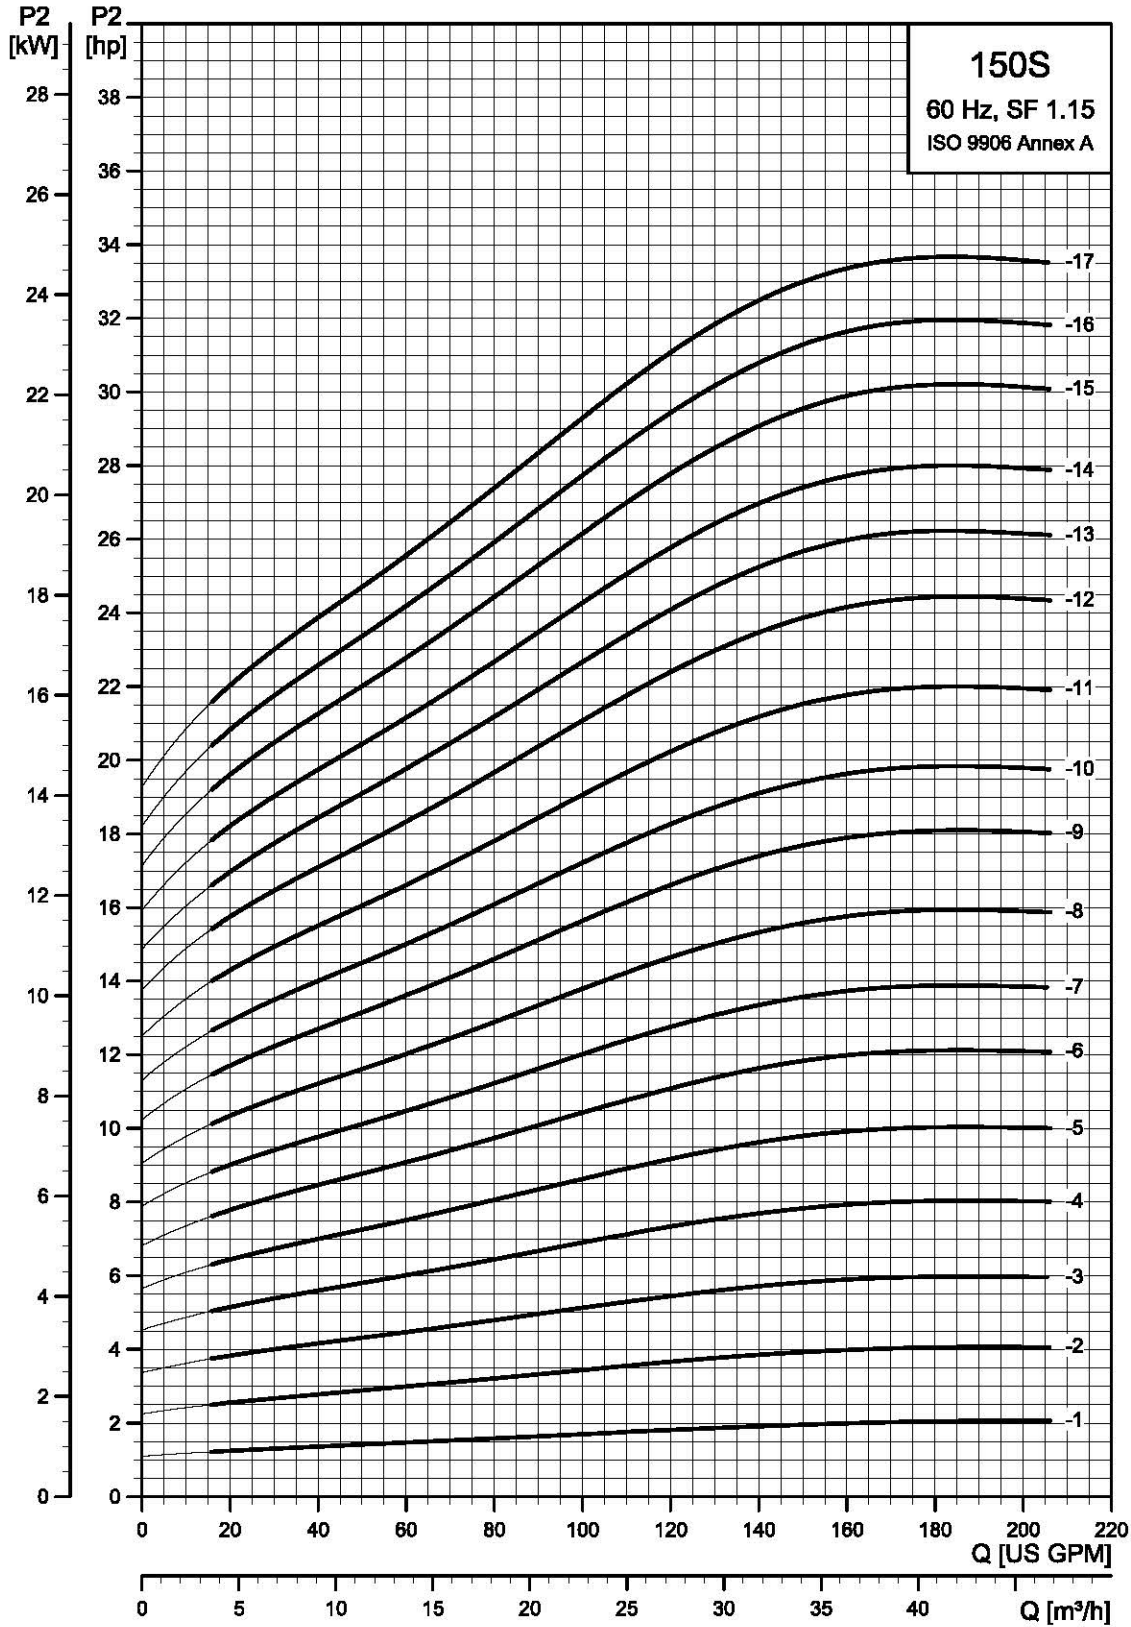

TMC05 0241 0112


150S (150 gpm) pump power requirement (P2)

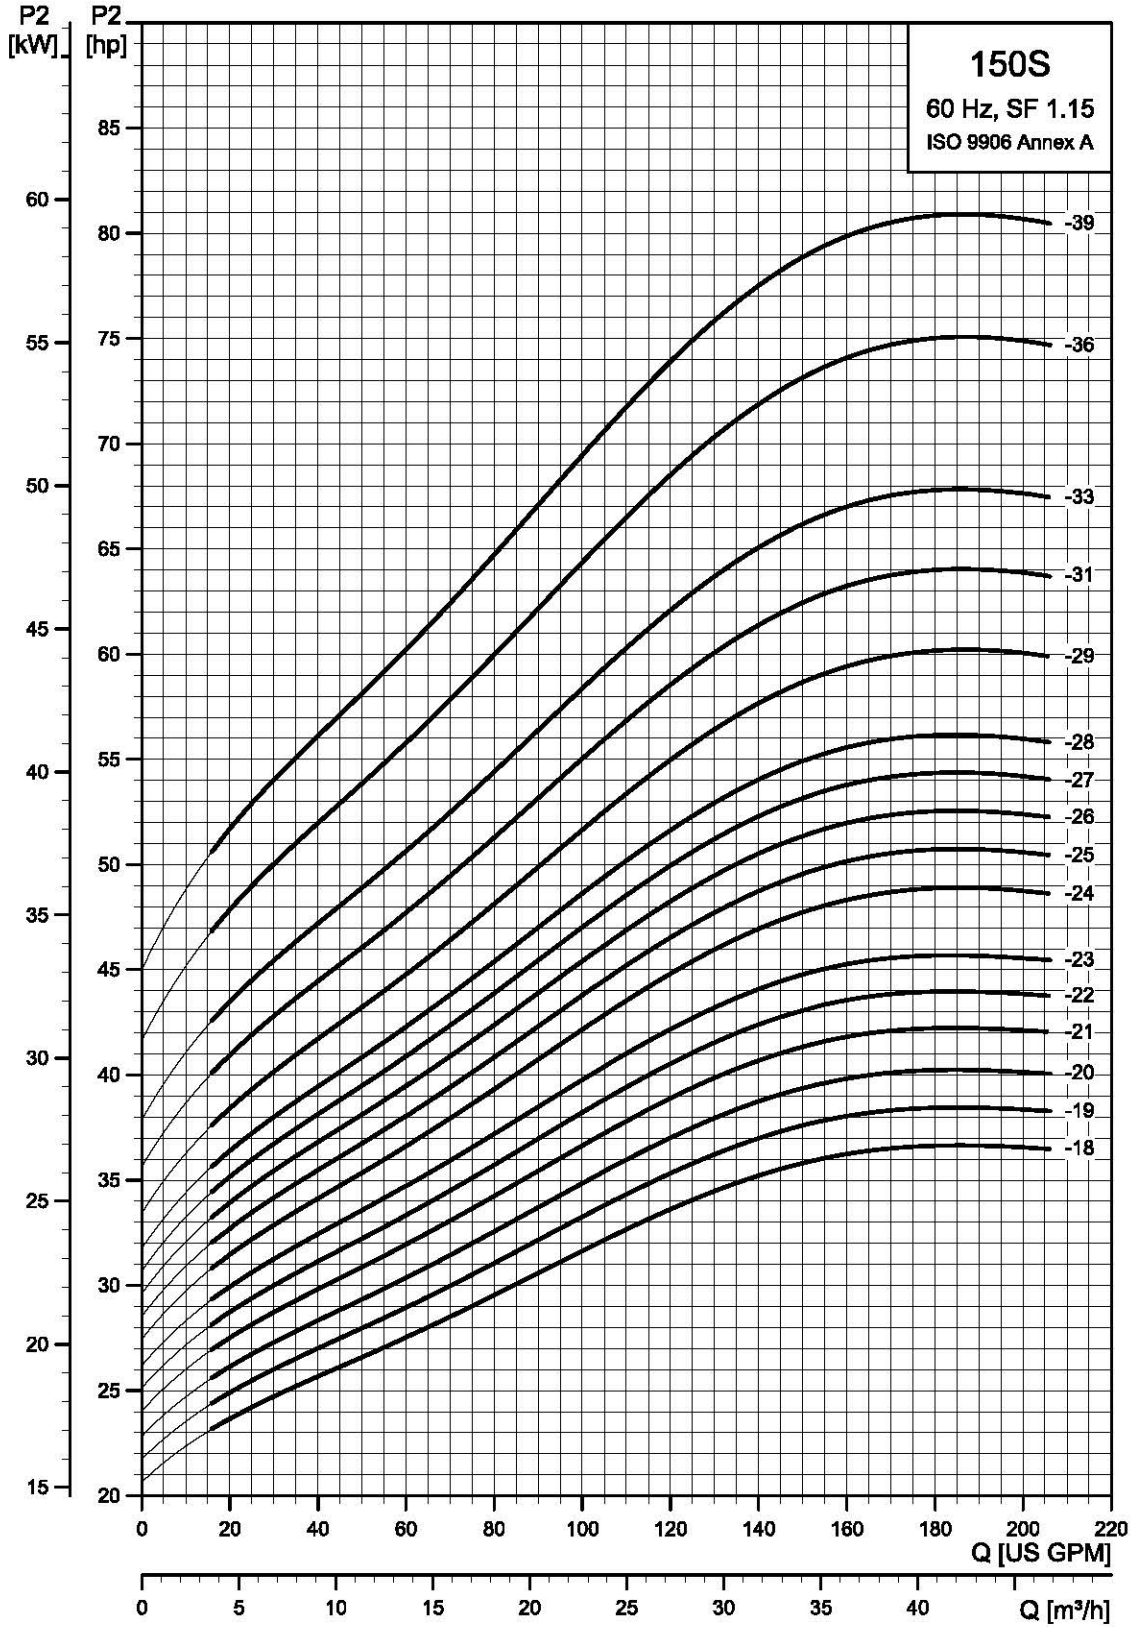

TMC05 0242 0112

## 150S (150 gpm)

Pump model	Nom. head [ft]	Ph	Volts [V]	Motor [Hp]	Dimensions					Net weight (complete) [lb]	
					A [in (mm)]	B [in (mm)]	C [in (mm)]	D [in (mm)]	E [in (mm)]		
<b>150S - Motor dia. 4 inch, 3 wire motor, 60 Hz, rated flow 150 gpm (3" NPT)</b>											
150S20-1	33	1	230	2	●	33.30 (846)	19.57 (497)	13.75 (349)	3.75 (95)	5.16 (131)	49.5
		3	230	2	■	28.98 (736)	15.23 (387)	13.75 (349)	3.75 (95)	5.16 (131)	45.0
		3	460	2	■	28.98 (736)	15.23 (387)	13.75 (349)	3.75 (95)	5.16 (131)	45.0
150S50-2	71	1	230	5	●	44.17 (1122)	26.65 (677)	17.52 (445)	3.75 (95)	5.16 (131)	67.5
		3	230	5	●	40.20 (1021)	22.69 (576)	17.52 (445)	3.75 (95)	5.16 (131)	42.3
		3	460	5	●	40.20 (1021)	22.69 (576)	17.52 (445)	3.75 (95)	5.16 (131)	42.3
150S75-3	108	3	230	7.5	●	47.91 (1217)	26.63 (676)	21.3 (541)	3.75 (95)	5.16 (131)	51.3
		3	460	7.5	●	47.91 (1217)	26.63 (676)	21.3 (541)	3.75 (95)	5.16 (131)	82.8
150S75-4	146	3	230	7.5	●	51.71 (1313)	26.63 (676)	25.08 (637)	3.75 (95)	5.16 (131)	85.5
		3	460	7.5	●	51.71 (1313)	26.63 (676)	25.08 (637)	3.75 (95)	5.16 (131)	85.5
150S100-5	184	3	460	10	●	59.42 (1509)	30.56 (776)	28.86 (733)	3.75 (95)	5.16 (131)	135.9
<b>150S - Motor dia. 6 inch, 3 wire motor, 60 Hz, rated flow 150 gpm (3" NPT)</b>											
150S75-4	146	3	230	7.5	▲	47.96 (1218)	22.25 (565)	25.71 (653)	5.63 (143)	5.60 (142)	99.9
		3	460	7.5	▲	47.96 (1218)	22.25 (565)	25.71 (653)	5.63 (143)	5.60 (142)	99.9
150S100-5	184	3	230	10	▲	52.72 (1339)	23.23 (590)	29.49 (749)	5.63 (143)	5.60 (142)	73.8
		3	460	10	▲	52.72 (1339)	23.23 (590)	29.49 (749)	5.63 (143)	5.60 (142)	73.8
150S150-6	222	3	230	15	▲	61.15 (1553)	27.88 (708)	33.27 (845)	5.63 (143)	5.60 (142)	119.7
		3	460	15	▲	61.15 (1553)	27.88 (708)	33.27 (845)	5.63 (143)	5.60 (142)	119.7
150S150-7	260	3	230	15	▲	64.93 (1649)	27.88 (708)	37.05 (941)	5.63 (143)	5.60 (142)	127.8
		3	460	15	▲	64.93 (1649)	27.88 (708)	37.05 (941)	5.63 (143)	5.60 (142)	127.8
150S150-8	297	3	230	15	▲	68.71 (1745)	27.88 (708)	40.83 (1037)	5.63 (143)	5.60 (142)	137.7
		3	460	15	▲	68.71 (1745)	27.88 (708)	40.83 (1037)	5.63 (143)	5.60 (142)	137.7
150S200-9	335	3	230	20	▲	75.44 (1916)	30.83 (783)	44.61 (1133)	5.63 (143)	5.60 (142)	141.3
		3	460	20	▲	75.44 (1916)	30.83 (783)	44.61 (1133)	5.63 (143)	5.60 (142)	141.3
150S200-10	373	3	230	20	▲	79.22 (2012)	30.83 (783)	48.39 (1229)	5.63 (143)	5.60 (142)	151.2
		3	460	20	▲	79.22 (2012)	30.83 (783)	48.39 (1229)	5.63 (143)	5.60 (142)	151.2
150S200-11	411	3	230	20	▲	83.00 (2108)	30.83 (783)	52.17 (1325)	5.63 (143)	5.60 (142)	166.5
		3	460	20	▲	83.00 (2108)	30.83 (783)	52.17 (1325)	5.63 (143)	5.60 (142)	166.5
150S250-12	448	3	230	25	▲	88.86 (2257)	32.92 (836)	55.95 (1421)	5.63 (143)	5.60 (142)	188.1
		3	460	25	▲	88.86 (2257)	32.92 (836)	55.95 (1421)	5.63 (143)	5.60 (142)	188.1
150S250-13	486	3	230	25	▲	92.64 (2353)	32.92 (836)	59.73 (1517)	5.63 (143)	5.60 (142)	201.6
		3	460	25	▲	92.64 (2353)	32.92 (836)	59.73 (1517)	5.63 (143)	5.60 (142)	201.6
150S250-14	524	3	230	25	▲	96.42 (2449)	32.92 (836)	63.51 (1613)	5.63 (143)	5.60 (142)	206.1
		3	460	25	▲	96.42 (2449)	32.92 (836)	63.51 (1613)	5.63 (143)	5.60 (142)	206.1

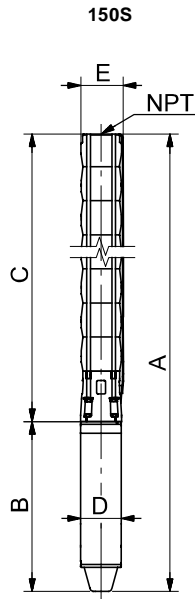

TM05 1112 2/11

E = Maximum diameter of pump including cable guard and motor.


## Notes:

Control box is required for 3-wire, single-phase applications. Data does not include control box.

- MS402 motor.
- MS4000 motor.
- ▲ MS6 motor.
- △ MMS6000 motor.
- ★ MMS8000 motor.
- ◆ Takes MS6 motor; not available as complete.
- ⊛ Takes MMS6000 motor; not available as complete.
- \* Takes MMS8000 motor; not available as complete.
- † Takes MMS10000 motor; not available as complete.

### 150S (150 gpm)

Pump model	Nom. head [ft]	Ph	Volts [V]	Motor [Hp]	Dimensions					Net weight (complete) [lb]
					A [in (mm)]	B [in (mm)]	C [in (mm)]	D [in (mm)]	E [in (mm)]	
<b>150S - Motor dia. 6 inch, 3 wire motor, 60 Hz, rated flow 150 gpm (3" NPT)</b>										
150S300-15	562	3	230	30	▲ 102.84 (2612)	35.56 (903)	67.29 (1709)	5.63 (143)	5.60 (142)	209.7
		3	460	30	▲ 102.84 (2612)	35.56 (903)	67.29 (1709)	5.63 (143)	5.60 (142)	209.7
150S300-16	600	3	230	30	▲ 106.62 (2708)	35.56 (903)	71.07 (1805)	5.63 (143)	5.60 (142)	211.5
		3	460	30	▲ 106.62 (2708)	35.56 (903)	71.07 (1805)	5.63 (143)	5.60 (142)	211.5
150S300-17	637	3	230	30	▲ 110.4 (2804)	35.56 (903)	74.85 (1901)	5.63 (143)	5.60 (142)	216.0
		3	460	30	▲ 110.4 (2804)	35.56 (903)	74.85 (1901)	5.63 (143)	5.60 (142)	246.6
150S400-18	675	3	460	40	▲ 118.9 (3020)	40.28 (1023)	78.63 (1997)	5.63 (143)	5.60 (142)	246.6
150S400-19	713	3	460	40	▲ 122.68 (3116)	40.28 (1023)	82.41 (2093)	5.63 (143)	5.60 (142)	248.4
150S400-20	751	3	460	40	▲ 126.46 (3212)	40.28 (1023)	86.19 (2189)	5.63 (143)	5.60 (142)	291.0
150S400-21	789	3	460	40	▲ 130.24 (3308)	40.28 (1023)	89.97 (2285)	5.63 (143)	5.67 (144)	271.8
150S400-22	826	3	460	40	▲ 134.02 (3404)	40.28 (1023)	93.75 (2381)	5.63 (143)	5.67 (144)	305.9
150S400-23	864	3	460	40	▲ 137.8 (3500)	40.28 (1023)	97.52 (2477)	5.63 (143)	5.67 (144)	277.2
150S500-24	902	3	460	50	☼ 157.41 (3998)	56.11 (1425)	101.3 (2573)	5.67 (144)	5.60 (142)	411.8
150S500-25	940	3	460	50	☼ 161.19 (4094)	56.11 (1425)	105.08 (2669)	5.67 (144)	5.60 (142)	419.0
150S500-26	977	3	460	50	☼ 164.97 (4190)	56.11 (1425)	108.86 (2765)	5.67 (144)	5.60 (142)	426.2
150S500-27	1015	3	460	50	☼ 168.75 (4286)	56.11 (1425)	112.64 (2861)	5.67 (144)	5.60 (142)	433.4
150S500-28	1053	3	460	50	☼ 172.52 (4382)	56.11 (1425)	116.42 (2957)	5.67 (144)	5.60 (142)	440.6
150S600-29DS	1091	3	460	60	—	—	129.05 (3278)	—	7.10 (181)	—
150S600-31DS	1166	3	460	60	—	—	136.61 (3470)	—	7.10 (181)	—
150S600-33DS	1242	3	460	60	—	—	144.17 (3662)	—	7.10 (181)	—

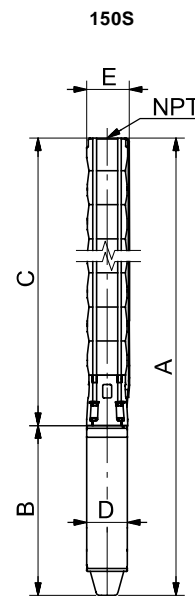

TM05 1112 2111

E = Maximum diameter of pump including cable guard and motor.

<b>150S - Motor dia. 8 inch, 3 wire motor, 60 Hz, rated flow 150 gpm (3" NPT)</b>										
150S500-24	902	3	460	50	* 148.12 (3762)	45.67 (1160)	102.45 (2602)	7.56 (192)	7.56 (192)	484.5
150S500-25	940	3	460	50	* 151.89 (3858)	45.67 (1160)	106.23 (2698)	7.56 (192)	7.56 (192)	491.7
150S500-26	977	3	460	50	* 155.67 (3954)	45.67 (1160)	110.00 (2794)	7.56 (192)	7.56 (192)	498.9
150S500-27	1015	3	460	50	* 159.45 (4050)	45.67 (1160)	113.78 (2890)	7.56 (192)	7.56 (192)	506.1
150S500-28	1053	3	460	50	* 163.23 (4146)	45.67 (1160)	117.56 (2986)	7.56 (192)	7.56 (192)	513.3
150S600-29DS	1091	3	460	60	* 177.92 (4519)	50.00 (1270)	127.92 (3249)	7.56 (192)	7.56 (192)	612.7
150S600-31DS	1166	3	460	60	* 185.48 (4711)	50.00 (1270)	135.48 (3441)	7.56 (192)	7.56 (192)	623.7
150S600-33DS	1242	3	460	60	* 193.04 (4903)	50.00 (1270)	143.04 (3633)	7.56 (192)	7.56 (192)	639.1
150S750-36DS	1355	3	460	75	* 207.52 (5271)	53.15 (1350)	154.38 (3921)	7.56 (192)	7.56 (192)	689.2
150S750-39DS	1469	3	460	75	* 218.86 (5559)	53.15 (1350)	165.71 (4209)	7.56 (192)	7.56 (192)	704.6

Notes:

Control box is required for 3-wire, single-phase applications. Data does not include control box.

DS designation = Built into sleeve, 3" NPT, 8" minimum well diameter.

- MS402 motor.
- MS4000 motor.
- ▲ MS6 motor.
- ∧ MMS6000 motor.
- ★ MMS8000 motor.
- ◆ Takes MS6 motor; not available as complete.
- ☼ Takes MMS6000 motor; not available as complete.
- \* Takes MMS8000 motor; not available as complete.
- † Takes MMS10000 motor; not available as complete.

**APPENDIX B**  
**INFLUENT AND EFFLUENT PIPING RECORD**  
**DRAWINGS**

# 3  
7  
13  
14  
15  
18  
19  
20  
21

"APPROVAL OF THESE PLANS BY THE CITY OF HENDERSON IS LIMITED TO THOSE IMPROVEMENTS CONSTRUCTED IN THE DEDICATED RIGHT-OF-WAY AND/OR DEDICATED EASEMENTS. THIS APPROVAL DOES NOT AUTHORIZE THE CONSTRUCTION OF ANY IMPROVEMENTS THAT DEVIATE FROM ADOPTED STANDARDS AND/OR SPECIFICATIONS EXCEPT THOSE SPECIFICALLY IDENTIFIED AS "DEVIATIONS FROM STANDARDS". THE ENGINEER SHALL RESOLVE ANY DEVIATION OTHER THAN THOSE LISTED IN "DEVIATIONS FROM STANDARDS" IN FAVOR OF THE UNIFORM STANDARDS DRAWINGS AND SPECIFICATIONS CLARK COUNTY AREA NEVADA"

**SHEET INDEX**

- G1 COVER SHEET
- G2 LEGEND, ABBREVIATIONS & GENERAL NOTES
- G3 CITY OF HENDERSON GENERAL NOTES
- G4 OVERALL DRAWING INDEX
- C1 PLAN & PROFILE STA 9+61.16 TO STA 16+00
- C2 PLAN & PROFILE STA 16+00 TO STA 24+00
- C3 PLAN & PROFILE STA 24+00 TO STA 35+00
- C4 PLAN & PROFILE STA 35+00 TO STA 46+00
- C5 PLAN & PROFILE STA 46+00 TO STA 56+00
- C6 PLAN & PROFILE STA 56+00 TO STA 66+00
- C7 PLAN & PROFILE STA 66+00 TO STA 76+00
- C8 PLAN & PROFILE STA 76+00 TO STA 86+00
- C9 PLAN & PROFILE STA 86+00 TO STA 96+00
- C10 PLAN & PROFILE STA 96+00 TO STA 106+00
- C11 PLAN & PROFILE STA 106+00 TO STA 116+00
- C12 PLAN & PROFILE STA 116+00 TO STA 124+00
- C13 PLAN & PROFILE STA 124+00 TO STA 134+00
- C14 PLAN & PROFILE STA 134+00 TO STA 144+00
- C15 PLAN & PROFILE STA 144+00 TO STA 154+00
- C16 PLAN & PROFILE STA 154+00 TO STA 164+00
- C17 PLAN & PROFILE STA 164+00 TO STA 174+00
- C18 PLAN & PROFILE STA 174+00 TO STA 184+00
- C19 PLAN & PROFILE STA 184+00 TO STA 192+00
- C20 PLAN & PROFILE STA 192+00 TO STA 196+80.22
- C21 PLAN & PROFILE STA 10+00 TO STA 13+09.88
- D1 DETAILS
- D2 DETAILS
- D3 DETAILS

**MONUMENTATION**

OWNER IS RESPONSIBLE TO PROVIDE SURVEY MONUMENTATION AS SHOWN AND TO REPLACE ALL SURVEY MONUMENTATION DAMAGED, DISTURBED, DESTROYED, OR OBSCURED DURING CONSTRUCTION

**BENCHMARK**

CITY OF HENDERSON BENCH MARK NO. 210 DATED 09/15/93  
DESC BRASS CAP IN CONCRETE, LOCATED 50 ± EAST OF THE AC IN THE CENTER OF THE DOUBLE POWER POLE, 8 ± NORTH EAST OF HIGHWAY 41 ON THE EAST SIDE OF HIGHWAY 93, 1000 ± SOUTH OF PABCO ROAD  
ELEVATION IN METERS = 538.356 = 1766.26 FEET  
C.O.M. NAVD 88  
CONVERSION FACTOR METERS = 3937/1200 = U.S. FEET

**BASIS OF BEARING**

SOUTH 88°52'23" WEST BEING THE BEARING OF THE NORTH LINE OF THE NORTHWEST QUARTER (NW 1/4) OF SECTION 31, TOWNSHIP 21 SOUTH, RANGE 63 EAST, W.D.M. CLARK COUNTY NEVADA AS SHOWN ON THAT CERTAIN MAP ON FILE IN THE CLARK COUNTY RECORDER'S OFFICE IN FILE 101 OF SURVEYS, AT PAGE 24

# COLLECTION and TREATMENT FACILITY INLET/OUTLET PIPELINES

## KERR-McGEE CHEMICAL LLC



RECORD DRAWINGS  
10-19-2001

MAY 2001

THIS SET OF IMPROVEMENT PLANS IS CERTIFIED TO CONFORM TO THE REQUIREMENTS OF THE TRAFFIC STUDY ACCEPTANCE LETTER

NAME	P.E. NO.	DATE
N/A		

CITY OF HENDERSON - APPROVAL

Ken Y. Koshro, P.E.  
NEW DEVELOPMENT ENGINEER  
CITY OF HENDERSON


**ENGINEER**

PBS&J INC.  
901 N. GREEN VALLEY PKWY. SUITE 100  
HENDERSON, NEVADA 89014  
CONTACT: JAMES TUCKER, P.E.  
(702) 263-7275

**OWNER/DEVELOPER**

CONTACT: EVERETTE SPORE  
KERR-McGEE CHEMICAL LLC  
8000 WEST LAKE MEAD DRIVE  
HENDERSON, NEVADA 89015  
(702) 651-2200

CONFIDENTIAL  
PROPERTY OF KERR-McGEE CORP.  
MAY NOT BE REPRODUCED, COPIED,  
OR USED FOR ANY PURPOSE.

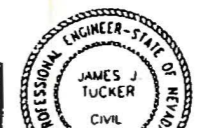


PAPER SIZE: A  
DRAWING NO: C-001  
SHEET: 1 OF 1

Call before you Overhead 1-702-593-6111  
Call before you Dig 1-800-227-2600

**APPROVALS**

Murt Seyler, P.E. UTILITIES SERVICES MANAGER CITY OF HENDERSON	DATE
Michael Bouse DIRECTOR BUILDING AND SAFETY CITY OF HENDERSON	DATE
Ann E. Barlett, P.E. CITY TRAFFIC ENGINEER CITY OF HENDERSON	DATE
James Madden FIRE MARSHAL CITY OF HENDERSON	DATE
Murt Chandler, P.E. FLOOD CONTROL COORDINATOR CITY OF HENDERSON	DATE
NEVADA POWER COMPANY	DATE
SOUTHWEST GAS CORPORATION	DATE
SPRINT	DATE
COX COMMUNICATIONS OF LAS VEGAS, INC.	DATE
SOUTHERN NEVADA WATER SYSTEM	DATE
CLARK COUNTY	DATE

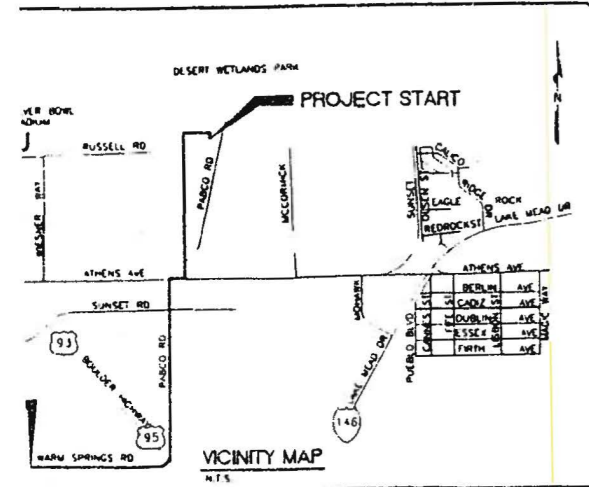

KERR-McGEE CHEMICAL LLC P.O. BOX 55 HENDERSON, NEV. 89009-7000

DESIGN	DATE	APPROVED FOR CONSTRUCTION	BY	DATE
DRAWN BY		PROCESS ENGR		
PROJ ENGR		PROJECT ENGR		
ENGR INVR		ENGR INVR		
		PRODUCTION BUFT		
		CITY CONTROL		

REVISIONS  
RECORD DRAWINGS  
DATE: 5/01/01  
SCALE: 1" = 10' ±


INLET/OUTLET PIPELINES  
COLLECTION and TREATMENT FACILITY  
COVER SHEET



# ABBREVIATIONS

ASPHALTIC CONCRETE	FIG	FIGURE
ALUMINUM OR ALUM	FIN	FINISHED
AMERICAN NATIONAL STANDARDS INSTITUTE	FL	FLOWLINE OR FLOOR
ASSASSINATORS PARCEL NUMBER	FLEX	FLEXIBLE
ASSEMBLY	FLG	FLANGE
VALVE ASSEMBLY	FLR	FLOOR
AMERICAN STANDARDS ASSOCIATION (NOW ANSI)	FO	FIBER OPTIC
AMERICAN SOCIETY FOR TESTING AND MATERIAL	G	GAS
AMERICAN TELEGRAPH & TELEPHONE	GALV	GALVANIZED
VACUUM / AIR RELEASE VALVE ASSEMBLY	GND	GROUND
CURVE OR BACK OF CURB	GRD	GRADE OR GROUND
CURB RETURN	GR BRK	GRADE BREAK OR GRADE CHANGE
GRADING	GRV	GRATING
OR BENCH MARK	HDPE	HIGH DENSITY POLYETHYLENE
VERTICAL CURVE	HP	HIGH PRESSURE
BUTTERFLY VALVE	HPI	HORIZONTAL POINT OF INTERSECTION
CAPACITY	HMWPE	HIGH MOLECULAR WEIGHT POLYETHYLENE
CABLE TELEVISION	HORIZ	HORIZONTAL
WATER BASIN	HWL	HIGH WATER LEVEL
DISTANCE TO CENTER	HV	HORIZONTAL & VERTICAL CONTROL POINT
UNIDIRECTIONALLY CAST FIBERGLASS REINFORCED	HYD	HYDRAULIC OR HYDRANT
PIPE COUNTY NEVADA	ID	INSIDE DIAMETER
COUNTY PUBLIC WORKS	INCH	INCH
COUNTY REGIONAL FLOOD CONTROL DISTRICT	INV	INVERT ELEVATION
COUNTY SANITATION DISTRICT	IRR	IRRIGATION
LINE	KW	KW PIPELINE
PIPE	LB	POUND
CONSTRUCTION JOINT	LC	LENGTH
OF LAS VEGAS	LP	LIGHT POLE
CONTROLLED LOW STRENGTH MATERIAL	LF	LINEAR FEET
PORTLAND MORTAR LINED / COATED	LT	LEFT
PORTLAND MORTAR LINED /	LVWVD	LAS VEGAS VALLEY WATER DISTRICT
PE WRAPPED CEMENT MORTAR COATED	MAX	MAXIMUM
FRUGATED METAL PIPE	MFR	MANUFACTURER
CONCRETE MASONRY UNIT	MH	MANHOLE
SEV PIPELINE COMPANY	MIN	MINIMUM OR MINUTE
OF NORTH LAS VEGAS	MISC	MISCELLANEOUS
MAN	MJ	MECHANICAL JOINT
CONCRETE OR CONCENTRIC	ML	MONUMENT LINE
FINISHED, CONTINUOUS, CONTINUATION	MCLCP	MORTAR LINED/COATED PIPE
TRACTOR	MON	MONUMENT
CONSTRUCTION	MTH	MONTH
POINT OR CATHODIC PROTECTION	N	NORTH
TELEPHONE NEVADA	NDOT	NEVADA DEPARTMENT OF TRANSPORTATION
PROTECTIVE PROTECTION TEST STATION	NIC	NOT IN CONTRACT
WATER UTILITIES	NLVL	NORTH LAS VEGAS LATERAL
HEADER	NO/#	NUMBER
STEEL IRON PIPE	NTS	NOT TO SCALE
METER	NPC	NEVADA POWER COMPANY
CHARGE	OC	ON CENTER
VALVE	OD	OUTSIDE DIAMETER
WING	OH	OVERHEAD
ELECTRIC	ORIG	ORIGINAL
CURVE	P&P	PLAN & PROFILE
METRIC RETURN	P	PIPE OR PETROLEUM
FACE	PC	POINT OF CURVATURE, PRIME CABLE
JUNCTION	PCC	POINT OF COMPOUND CURVATURE
STATION	PCP	PHOTO CONTROL POINT
SECTION	PE	PERMANENT EASEMENT
OF PAVEMENT	PI	POINT OF INTERSECTION
MENT	PL	PLATE, PROPERTY LINE OR PLACE
VERTICAL CURVE	POB	POINT OF BEGINNING
WAY	POT	POINT ON TANGENT
WING	PP	PANEL POINT, POWER POLE OR POLYPROPYLENE
CONSTRUCTION JOINT	PR	PAIR
FLOOR	PRC	POINT OF REVERSE CURVE
ED GRADE	PRESS	PRESSURE
HYDRANT	PSI	POUNDS PER SQUARE INCH
	PT	POINT OF TANGENT
	PVC	POLYVINYL CHLORIDE
	PUE	PATENT UTILITY EASEMENT
	PVMT	PAVEMENT
	QTY	QUANTITY

# DETAIL CALLOUT LEGEND

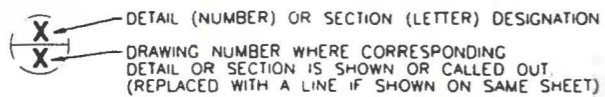

# LEGEND

SECTION CORNER	●
BENCH MARK	⊙
HORIZONTAL AND VERTICAL CONTROL POINT	△
MONITORING WELL	⊕
UTILITY POLE	●
BUTTERFLY VALVE	⌵
AIR VACUUM AND/OR AIR RELEASE ASSEMBLY	⌵ <sup>AV/AR</sup> OR ⌵ <sup>AR</sup>
GATE VALVE	⌵
PLUG VALVE	⌵
DRAIN VALVE OUTLET	⊕
CENTERLINE	— · — · —
SECTION LINE	— · — · —
ROW LINE	— · — · —
PERMANENT EASEMENT	— · — · —
TEMPORARY CONSTRUCTION EASEMENT	— · — · —
PROPERTY LINE	— · — · —
NEW STRUCTURE OR FACILITY	▭
EXISTING / UNDER CONSTRUCTION STRUCTURE OR FACILITY	▭
EXISTING FENCE	▭
RAIL ROAD	▭
EXISTING CULVERT	— FG —
EXISTING FIBER OPTICS LINE	— FG —
EXISTING UNDERGROUND POWER LINE	— UGP —
EXISTING OVERHEAD POWER LINE	— OHP —
EXISTING GAS LINE	— G —
EXISTING TELEPHONE LINE	— TEL —
EXISTING TELEPHONE LINE	— TEL —
EXISTING SANITARY SEWER LINE	— SS —
EXISTING STORM DRAIN	— SD —
EXISTING WATER LINE	— W —
EXISTING CABLE TELEVISION LINE	— CATV —
IRRIGATION WATER LINE OR RECLAIMED WATER LINE	— IRR —
CONTOUR LINE, EXISTING GRADE	—
SPOT ELEVATION	•

# GENERAL NOTES

- UTILITIES SHOWN ON THE DRAWINGS ARE BASED ON THE BEST AVAILABLE INFORMATION AT THE TIME OF DESIGN. CONTRACTOR SHALL VERIFY ALL UTILITY LOCATIONS BY CALLING 1-800-227-2800 AT LEAST TWO WORKING DAYS PRIOR TO COMMENCEMENT OF WORK.
- ALL PROPERTY AND RIGHT-OF-WAY INFORMATION PROVIDED BY PENTACORE, INC.
- AERIAL MAPPING WAS COMPLETED BY TRI-STATE IN 1998.
- PROTECTION OF EXISTING SURVEY MONUMENTS OR PROPERTY STAKES, WHETHER SHOWN ON THE DRAWINGS OR NOT, SHALL BE THE CONTRACTOR'S RESPONSIBILITY.

# PIPELINE NOTES

- ALL 12" PIPE SHALL BE HIGH DENSITY POLYETHYLENE (HDPE). DR11 ALL 8" AND 10" PIPE SHALL BE HDPE, DR9.
- EXCEPT WHERE OTHERWISE SHOWN, BOTH INLET AND OUTLET PIPELINES SHALL BE INSTALLED IN A COMMON TRENCH AT THE SAME INVERT ELEVATION.
- WHERE VERT Δ POINTS ARE SHOWN IN THE PROFILE, THE REQUIRED DEFLECTION SHALL BE ACHIEVED BY BENDING THE PIPE UNLESS A FITTING IS SPECIFICALLY CALLED OUT.
- MINIMUM RADIUS OF BEND SHALL BE 15' FOR 8" PIPE 25' FOR 10" PIPE AND 35' FOR 12" PIPE.
- ANTI FLOTATION ANCHORS SHALL BE INSTALLED ON THE PIPELINES AT XX INTERVALS BETWEEN STATION XX+XX AND STATION XX+XX AND AT ANY OTHER LOCATION WHERE GROUND WATER IS ENCOUNTERED DURING TRENCHING.

**KERR-Mc GEE CHEMICAL LLC**

P.O. BOX 55 HENDERSON, NEV. 89009-7000

COLLECTION and TREATMENT FACILITY  
INLET/OUTLET PIPELINES  
LEGEND, ABBREV., AND GEN. NOTES

SCALE: 1" = 10'

DATE: 5/31/04

DESIGN BY	DATE	APPROVED FOR CONSTRUCTION
J. TUCKER	1/19/04	BY DATE
PROJECT ENGR	SAFETY	PROCESS ENGR
ENGR. MAJOR	ENVIRONMENTAL	PROJECT ENGR
ENGR. MAJOR	OPERATIONS MAJOR	ENGR. MAJOR
ENGR. MAJOR	PRODUCTION SUPT	PLANT MAJOR
ENGR. MAJOR	QUALITY CONTROL	

JOB NO. \_\_\_\_\_

DATE \_\_\_\_\_

RECORD DRAWINGS

**Call before you Dig**


1-800-227-2600

CITY OF HENDERSON - APPROVAL

Ken Y. Koshino, P.E.  
NEW DEVELOPMENT ENGINEER  
CITY OF HENDERSON

DATE \_\_\_\_\_


CONFIDENTIAL  
PROPERTY OF KERR-McGEE CORP.  
MAY NOT BE REPRODUCED, COPIED,  
OR USED FOR ANY PURPOSE WITHOUT  
THE WRITTEN PERMISSION OF

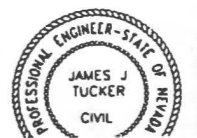



PAPER SIZE	DRAWING NO
A	G002
SHEET	OF
1	1



SEE BELOW RIGHT

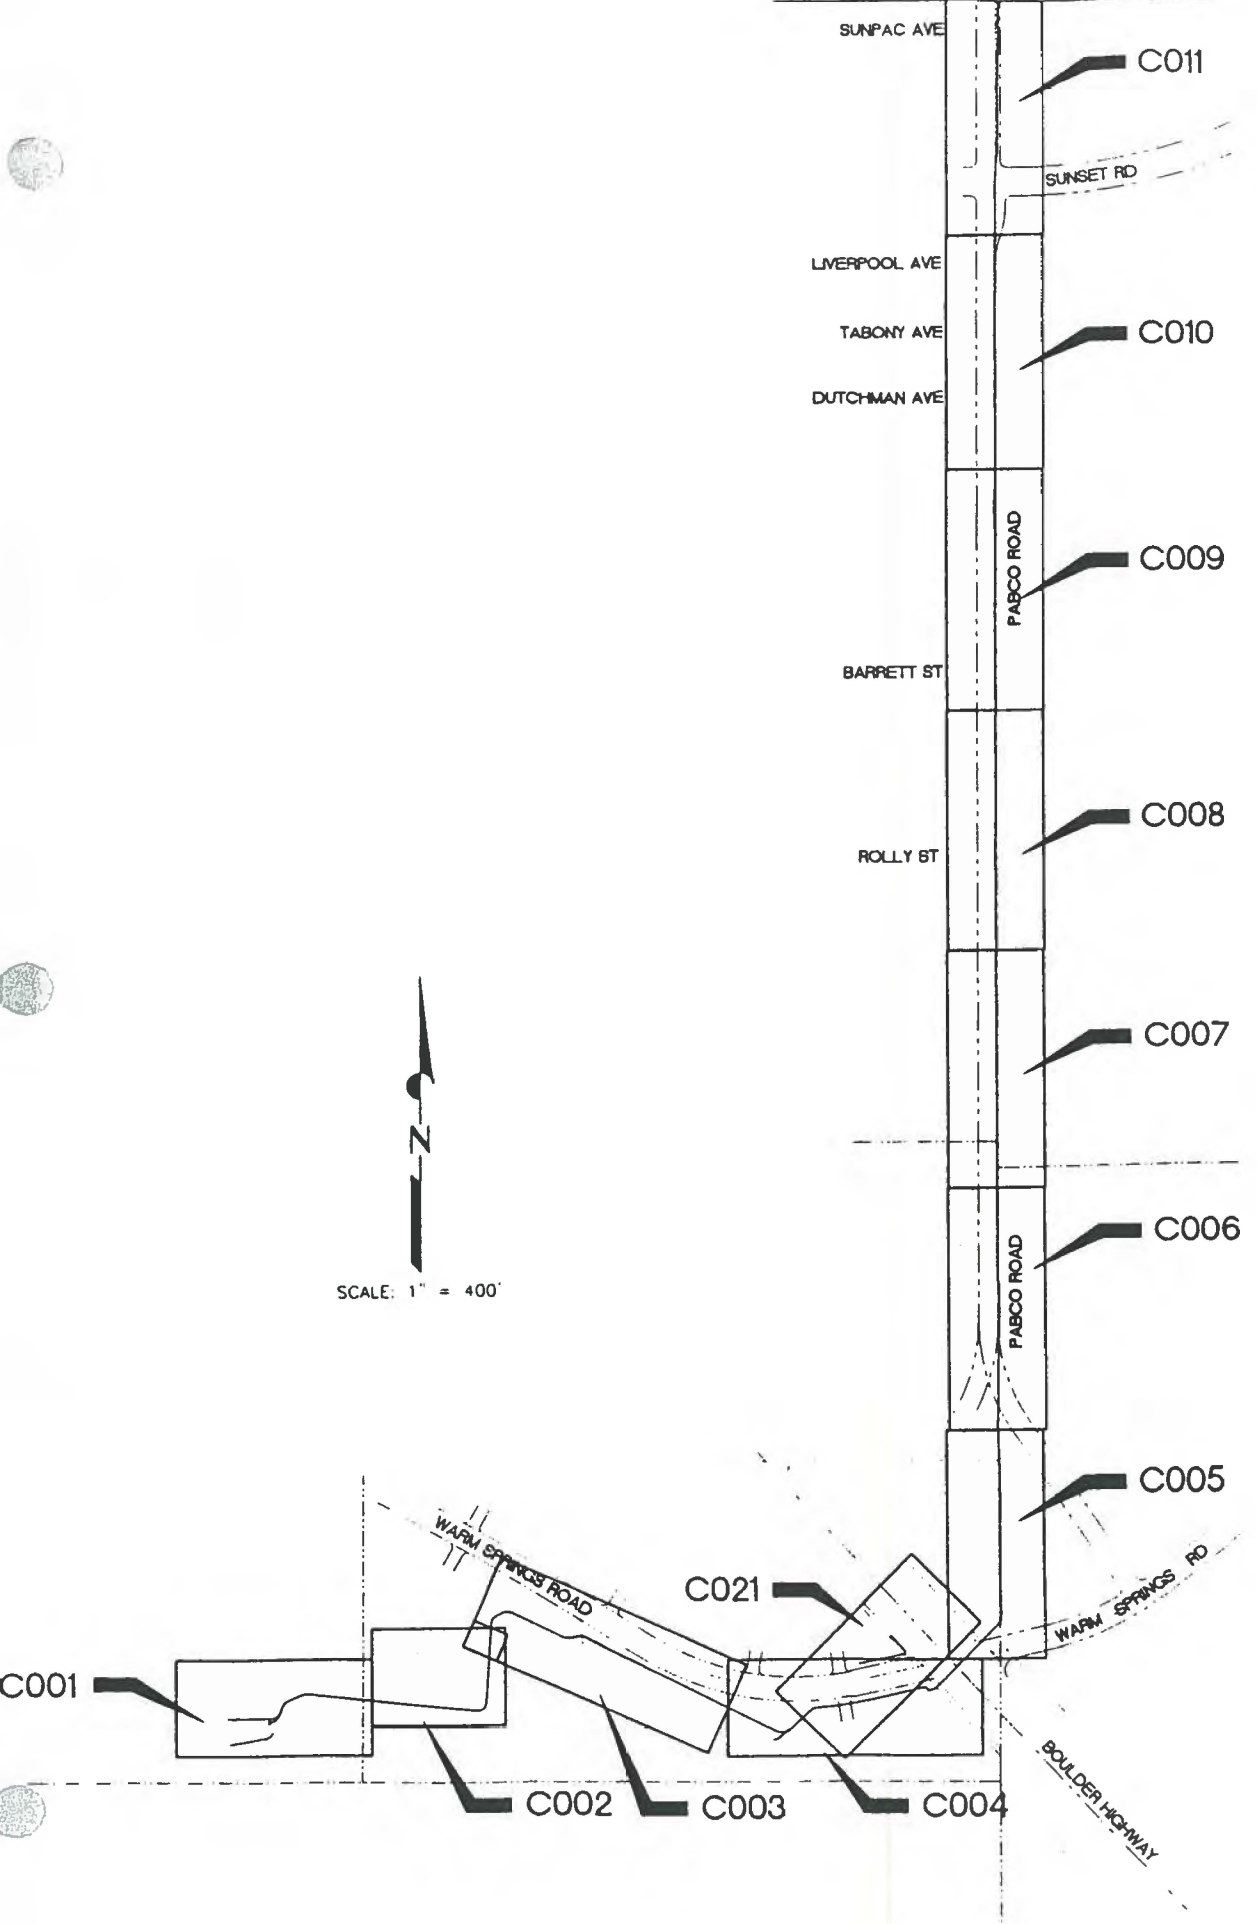

FUTURE PROVIDENCE

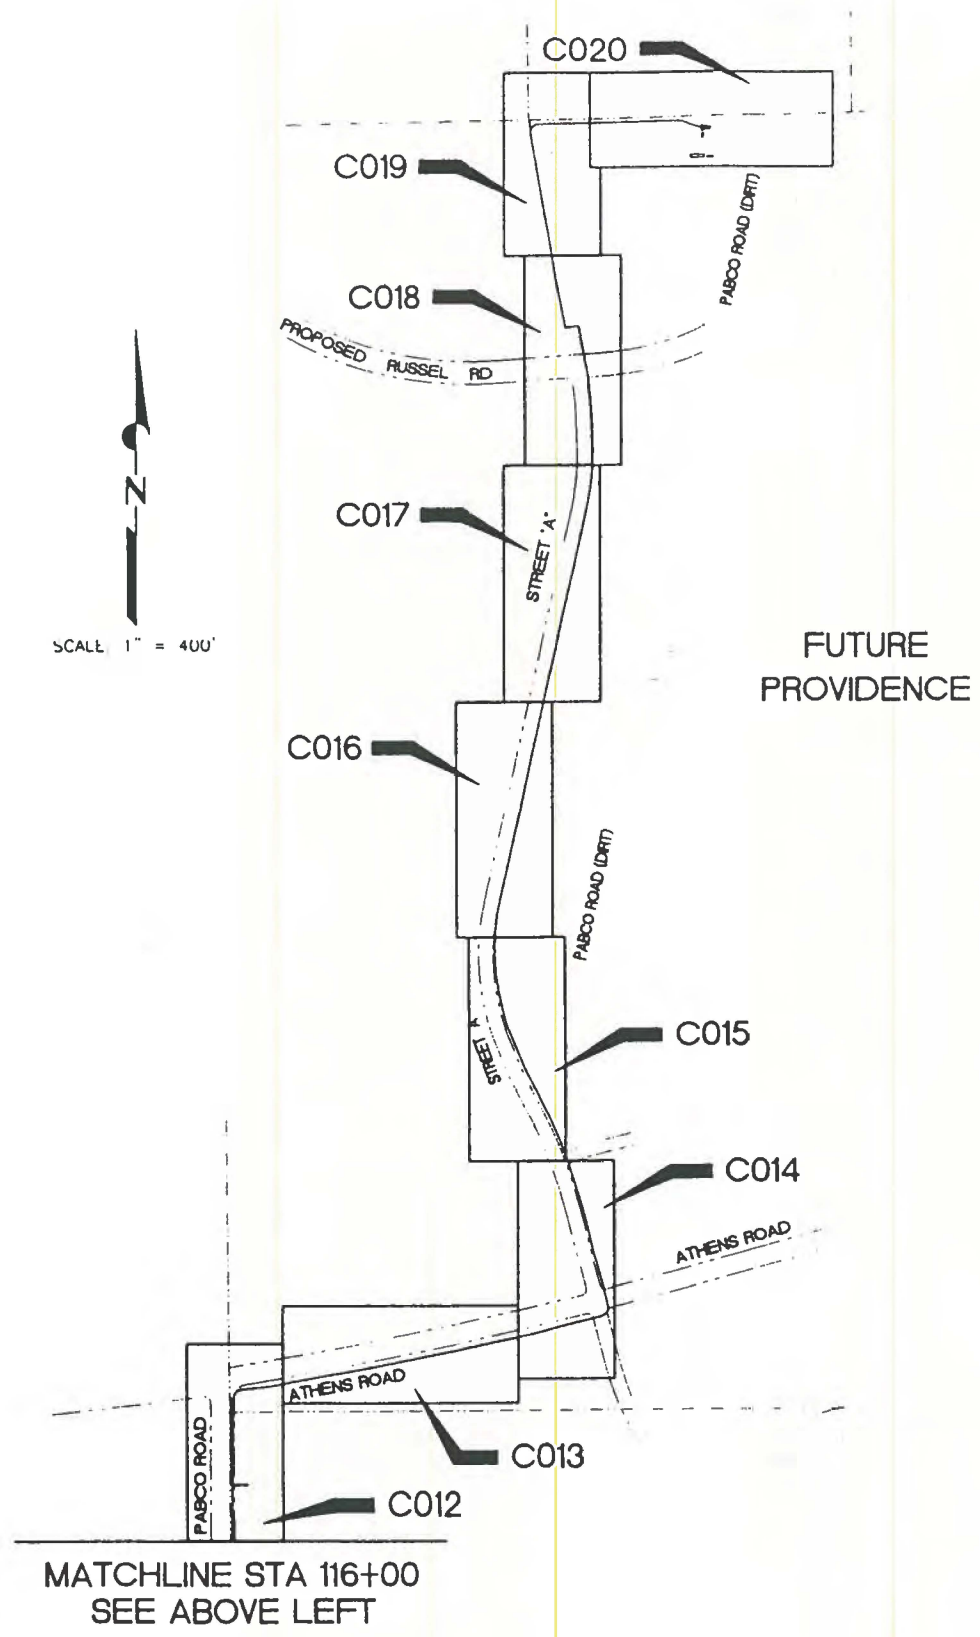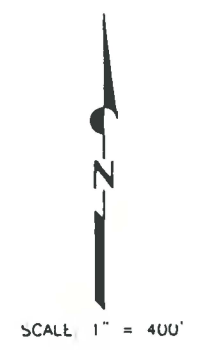

FUTURE PROVIDENCE

MATCHLINE STA 116+00  
SEE ABOVE LEFT

Call before you dig


Call before you dig

CITY OF HENDERSON - APPROVAL

Ken Y. Kashiro, P.E.  
REGISTERED PROFESSIONAL ENGINEER

DATE

CONFIDENTIAL  
PROPERTY OF KERR-MCGEE CORP.  
MAY NOT BE REPRODUCED, COPIED,  
OR USED FOR ANY PURPOSE WITHOUT

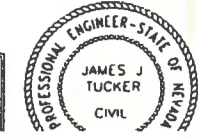

PAPER SIZE  
A

DRAWING NO  
G004

SHEET  
4  
OF  
16

REVISION

KERR-Mc GEE CHEMICAL LLC

P.O. BOX 55 HENDERSON, NEV 89009-7000

PROJECT NO. 116-118  
DATE 10/15

DESIGN	DATE	APPROVED FOR CONSTRUCTION
DRAWN BY	7/11/00	BY
PROJ ENGR		PROCESS ENGR
ENGR MINOR		PROJECT ENGR
		ENGR MINOR
		PLANT MAJOR
		QUALITY CONTROL

COLLECTION and TREATMENT FACILITIES  
INLET/OUTLET PIPELINES  
OVERALL DRAWING INDEX

RECORD DRAWINGS

DATE 10/15





NO.	DATE	DESCRIPTION

NO.	DATE	DESCRIPTION

DESIGN	DATE	APPROVED FOR CONSTRUCTION
DRAWN BY	J. APPROPRIATE	BY
PROJ ENGR	J. J. TUCKER	PROCESS ENGR
ENGR MINOR	E. W. SEITZ	PROJECT ENGR
		ENGR MINOR
		PRODUCTION BLFT.
		Q.L.T.Y. CONTROL

SHEET	5
OF	26
REVISION	


KERR-MC GEE CHEMICAL LLC P.O. BOX 55 HENDERSON, NEV. 89009-7000

INLET/OUTLET PIPELINES  
PLAN + PROFILE  
STA 9+61.16 TO STA 16+00

DATE: 5/11/01



SCALE: 4" = 100'

SCALE  
HORIZ 1" = 40'  
VERT 1" = 4'

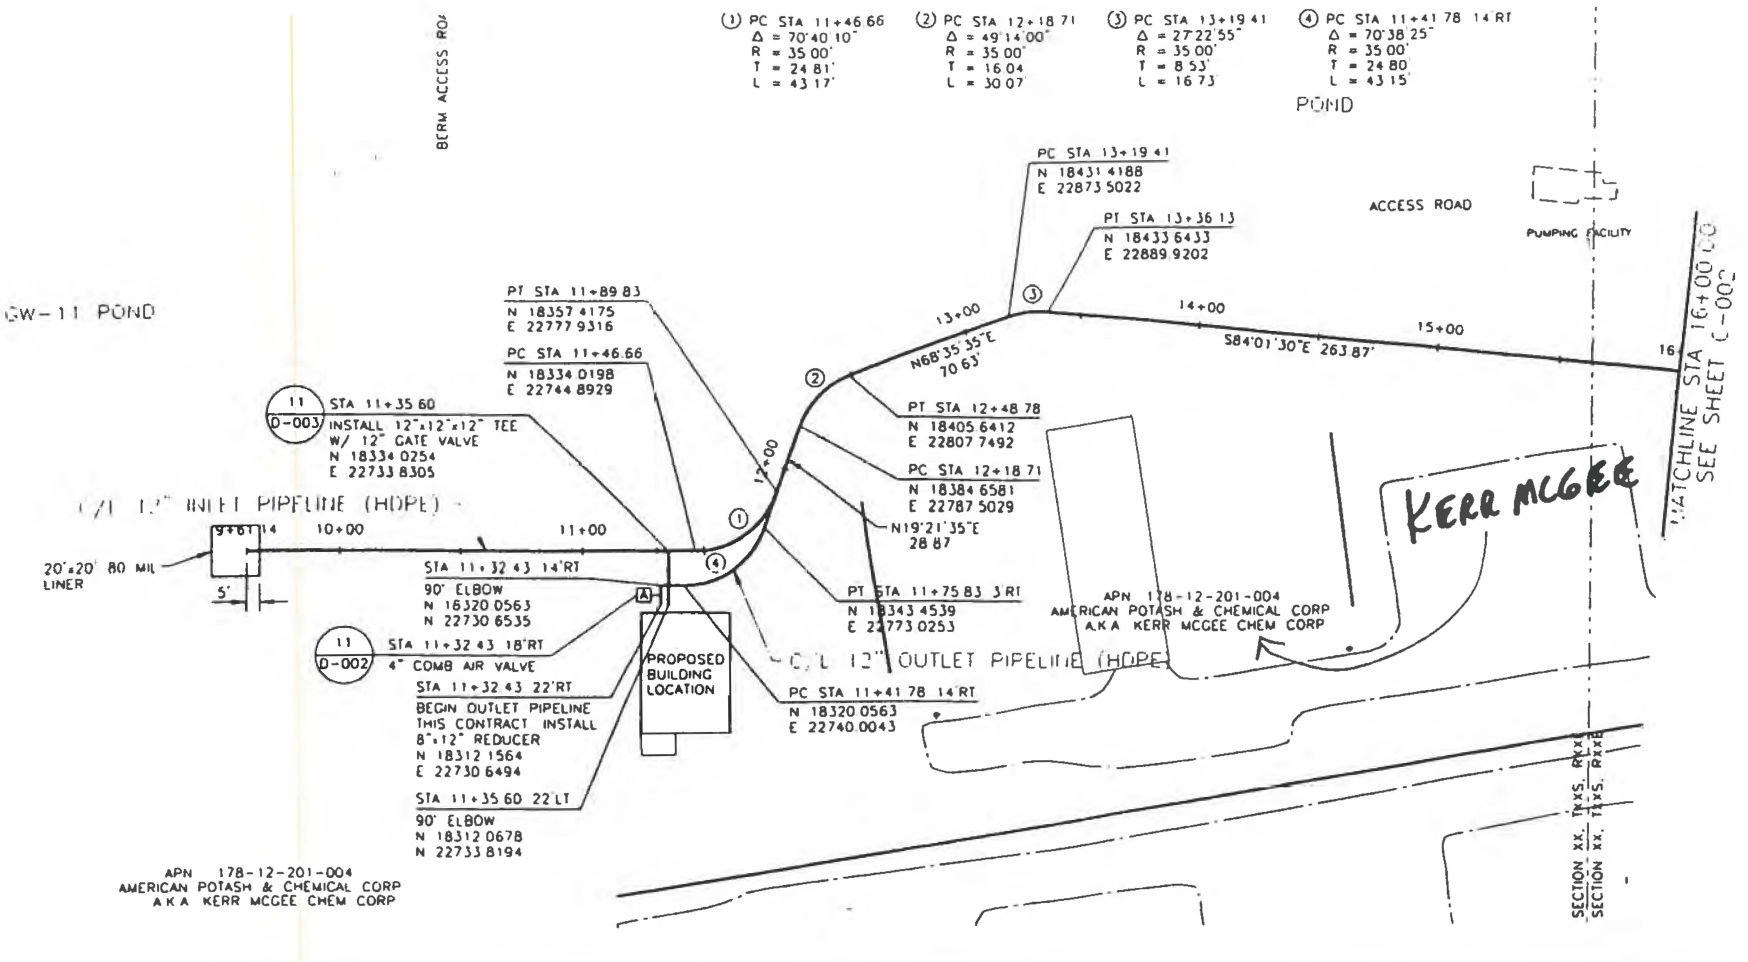


APN 178-12-201-004  
AMERICAN POTASH & CHEMICAL CORP  
AKA KERR MCGEE CHEM CORP


NOTE  
INSTALL 12" OUTLET PIPELINE  
1' NORTH OF ... AND  
INSTALL 12" INLET PIPELINE  
1' SOUTH OF ...

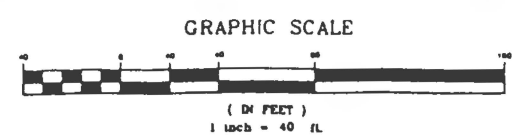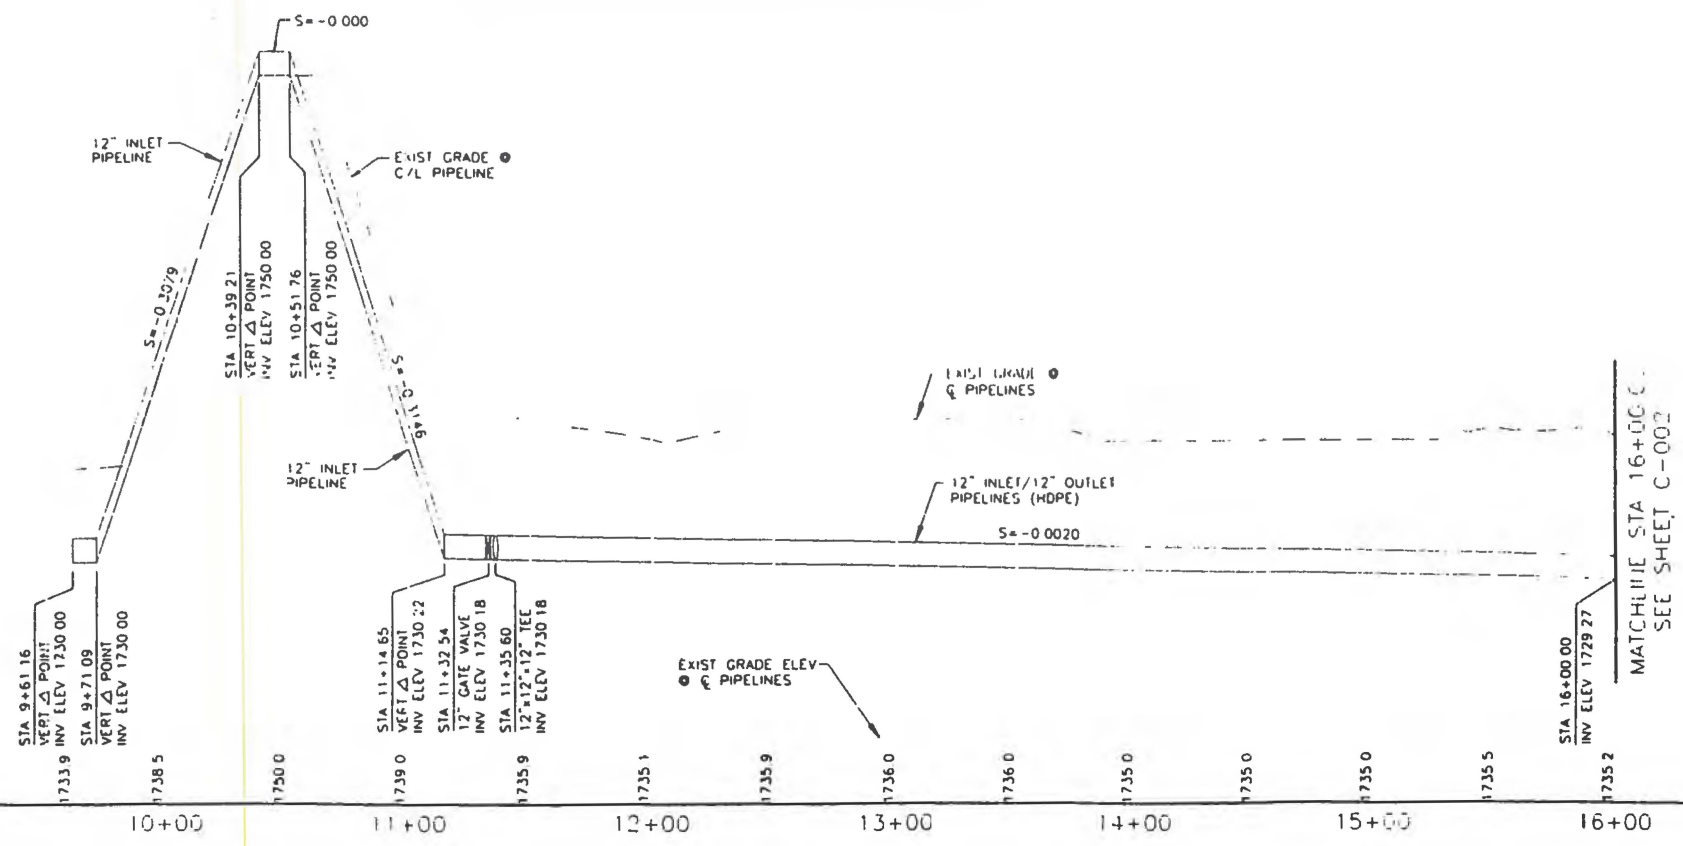

RICHARD J CAPP RESPONSIBILITY FOR THESE PLANS INCLUDES ALL BUBBLED CHANGES AND CHANGES NOTED IN

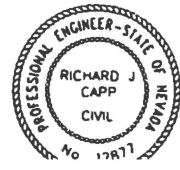



CONFIDENTIAL  
PROPERTY OF KERR-MCGEE CORP.  
MAY NOT BE REPRODUCED, COPIED,  
OR USED FOR ANY PURPOSE WITHOUT  
THE WRITTEN PERMISSION OF  
KERR-MCGEE CORPORATION

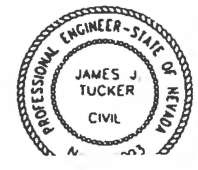

PAPER SIZE  
A

DRAWING NO.  
C-001

Call before you Dig

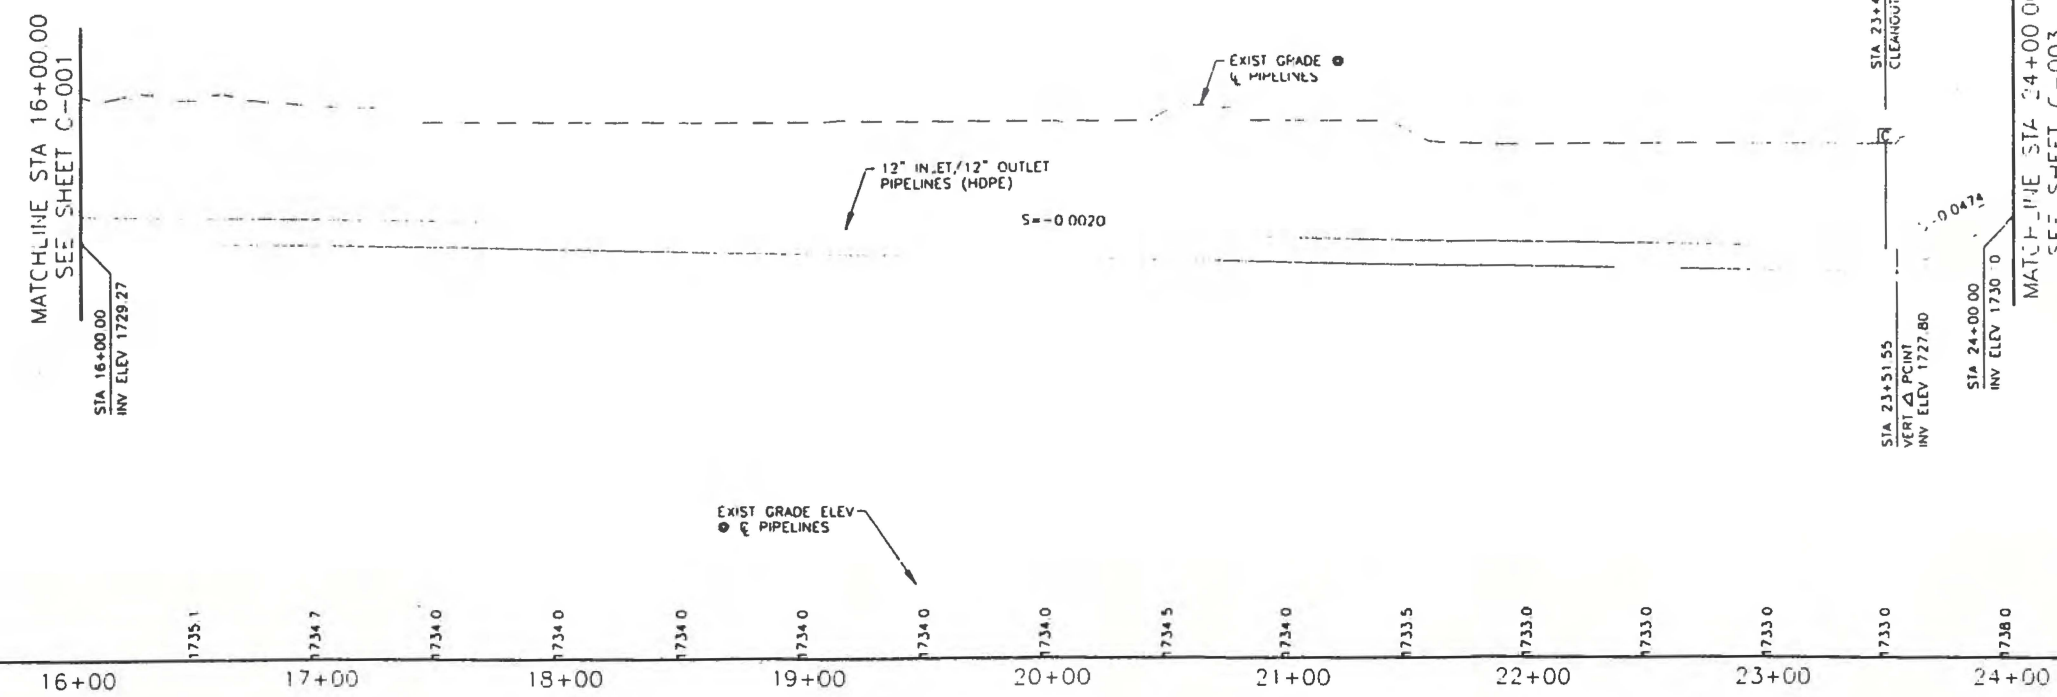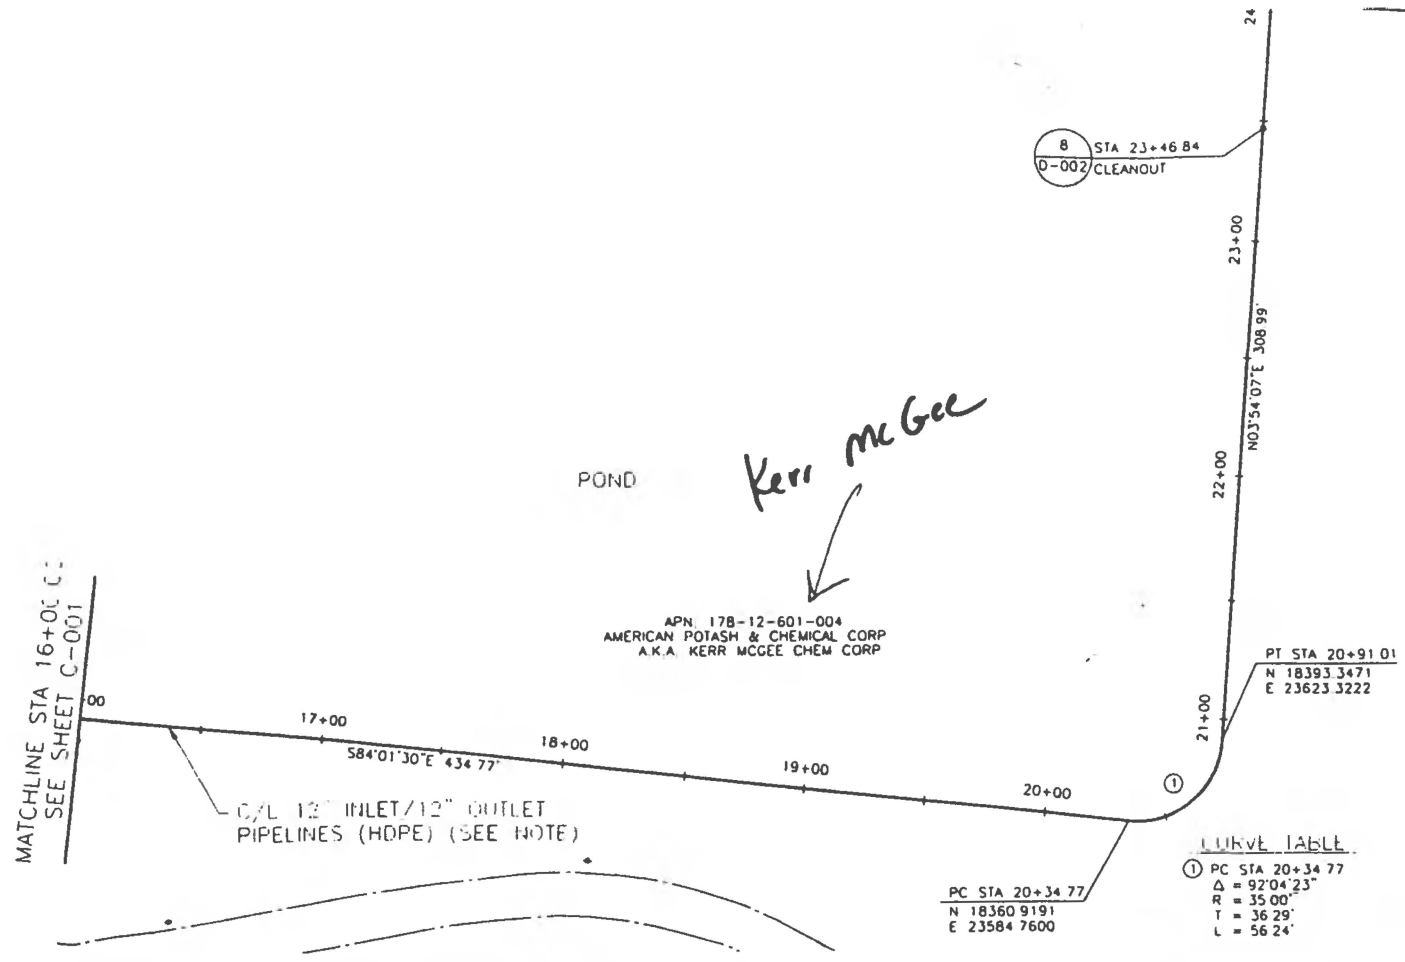

NOTE:  
INSTALL 12" INLET PIPELINE  
1' TO FIELD OF VIEW  
INSTALL 12" INLET PIPELINE  
1' SOUTH OF

**KERR-MC GEE CHEMICAL LLC**  
P.O. BOX 55 HENDERSON, NEV. 89009-7000

**INLET/OUTLET PIPELINES  
PLAN + PROFILE  
STA 16+00 TO STA 24+00**

DATE: 5/01/11 SCALE: AS SHOWN


DESIGN	DATE	APPROVED FOR CONSTRUCTION	BY	DATE
DRAWN BY	J. APPERSON 11/11/11	SAFETY		
PROJ. ENGR.	J.J. TUCKER	ENVIRONMENTAL	PROCESS ENGR.	
ENGR. INCHG.	EV. SPICER	OPERATIONS INCHG.	PROJECT ENGR.	
		PRODUCTION BUILT.	ENGR. INCHG.	
		Q.L.T. CONTROL	PLANT INCHG.	

REVISIONS:

NO.	DESCRIPTION	DATE

JOB No. \_\_\_\_\_


Call before you Dig

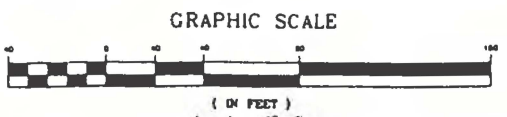

RICHARD J. CAPP RESPONSIBILITY FOR THESE PLANS INCLUDES ALL BUBBLED



CONFIDENTIAL  
PROPERTY OF KERR-MCGEE CORP.  
MAY NOT BE REPRODUCED, COPIED,  
OR USED FOR ANY PURPOSE WITHOUT  
THE WRITTEN PERMISSION OF

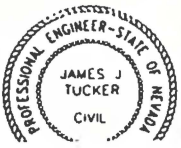


PAPER SIZE: A  
DRAWING NO.: C-002

SHEET 6 OF 6






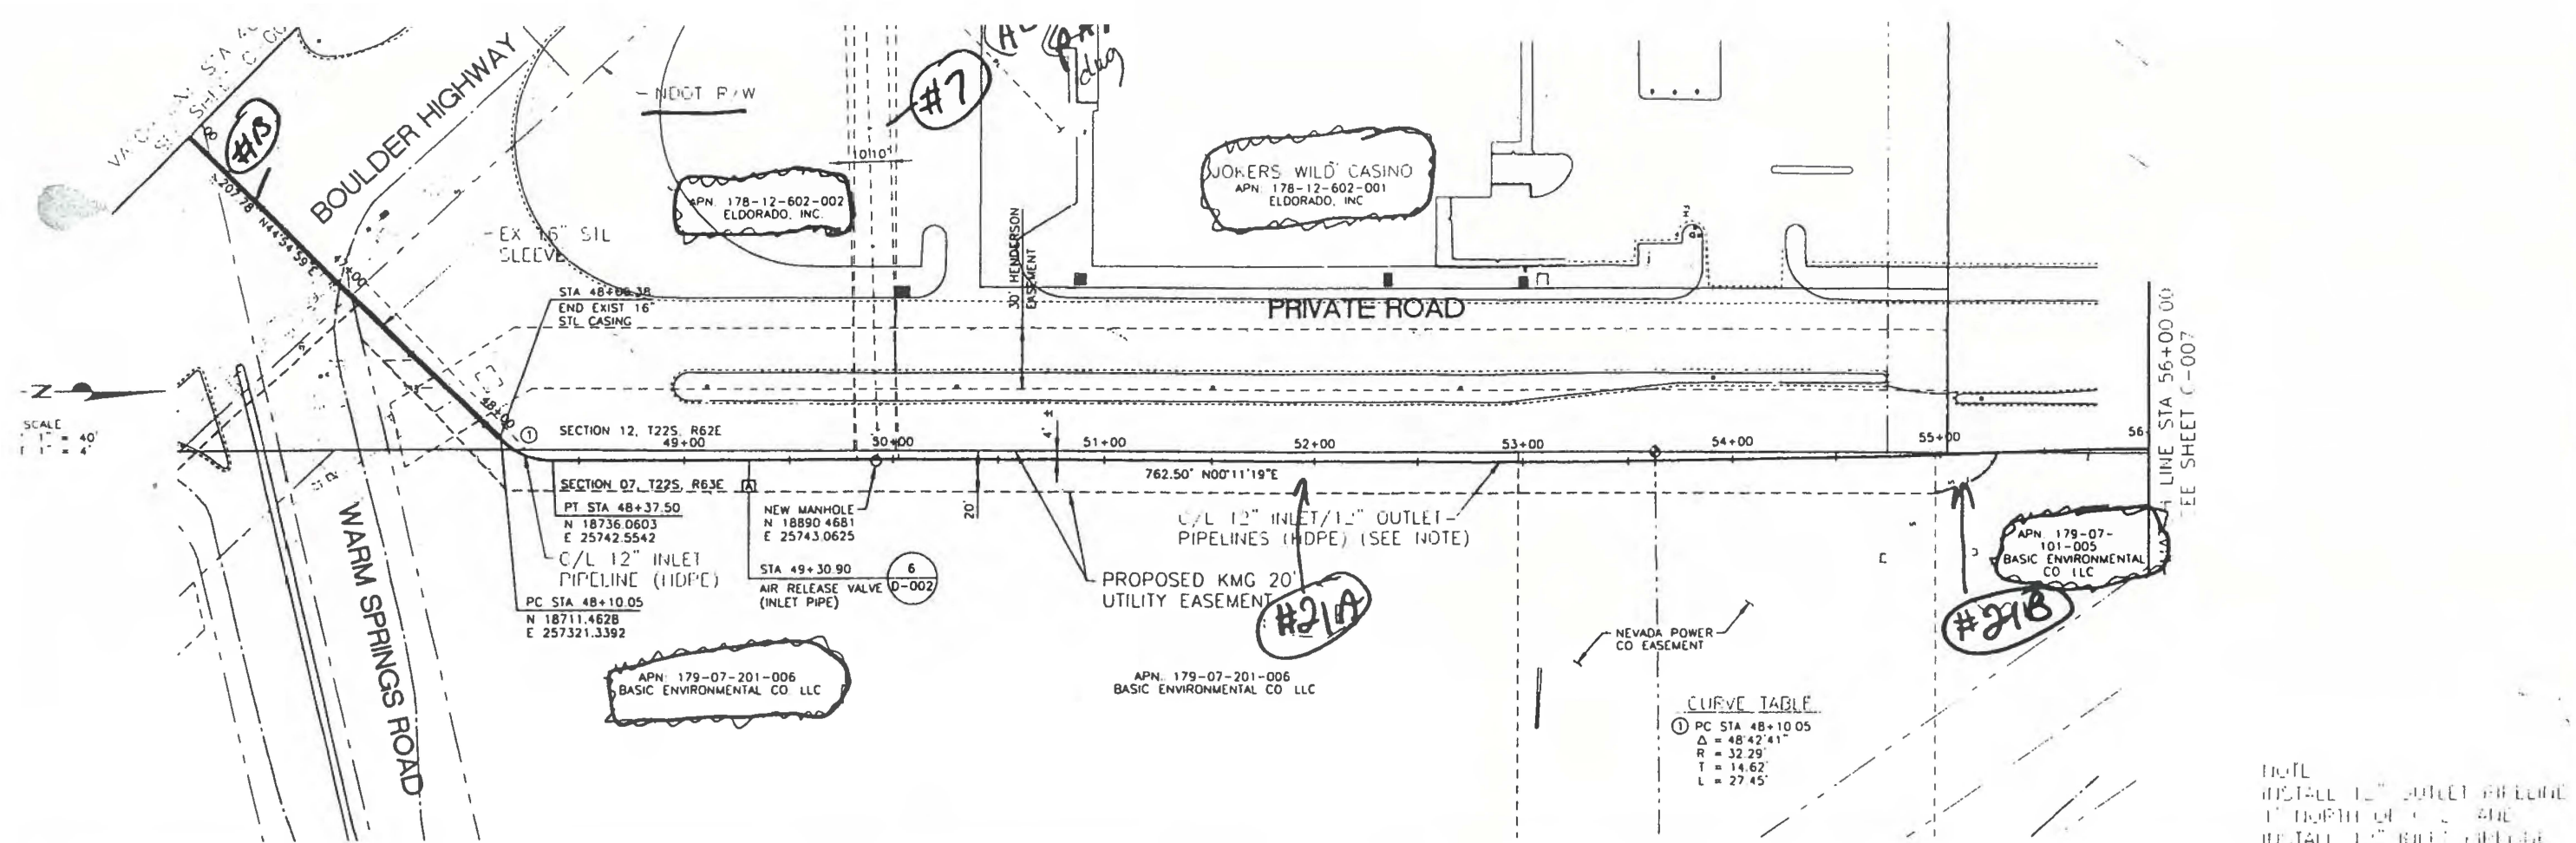

**CURVE TABLE**


① PC STA 48+10.05
Δ = 48°42'41"
R = 32.29'
T = 14.62'
L = 27.45'

NOTE:  
 INSTALL 12" INLET PIPELINE  
 1' NORTH OF C/L AND  
 INSTALL 12" INLET PIPELINE  
 1' SOUTH OF C/L

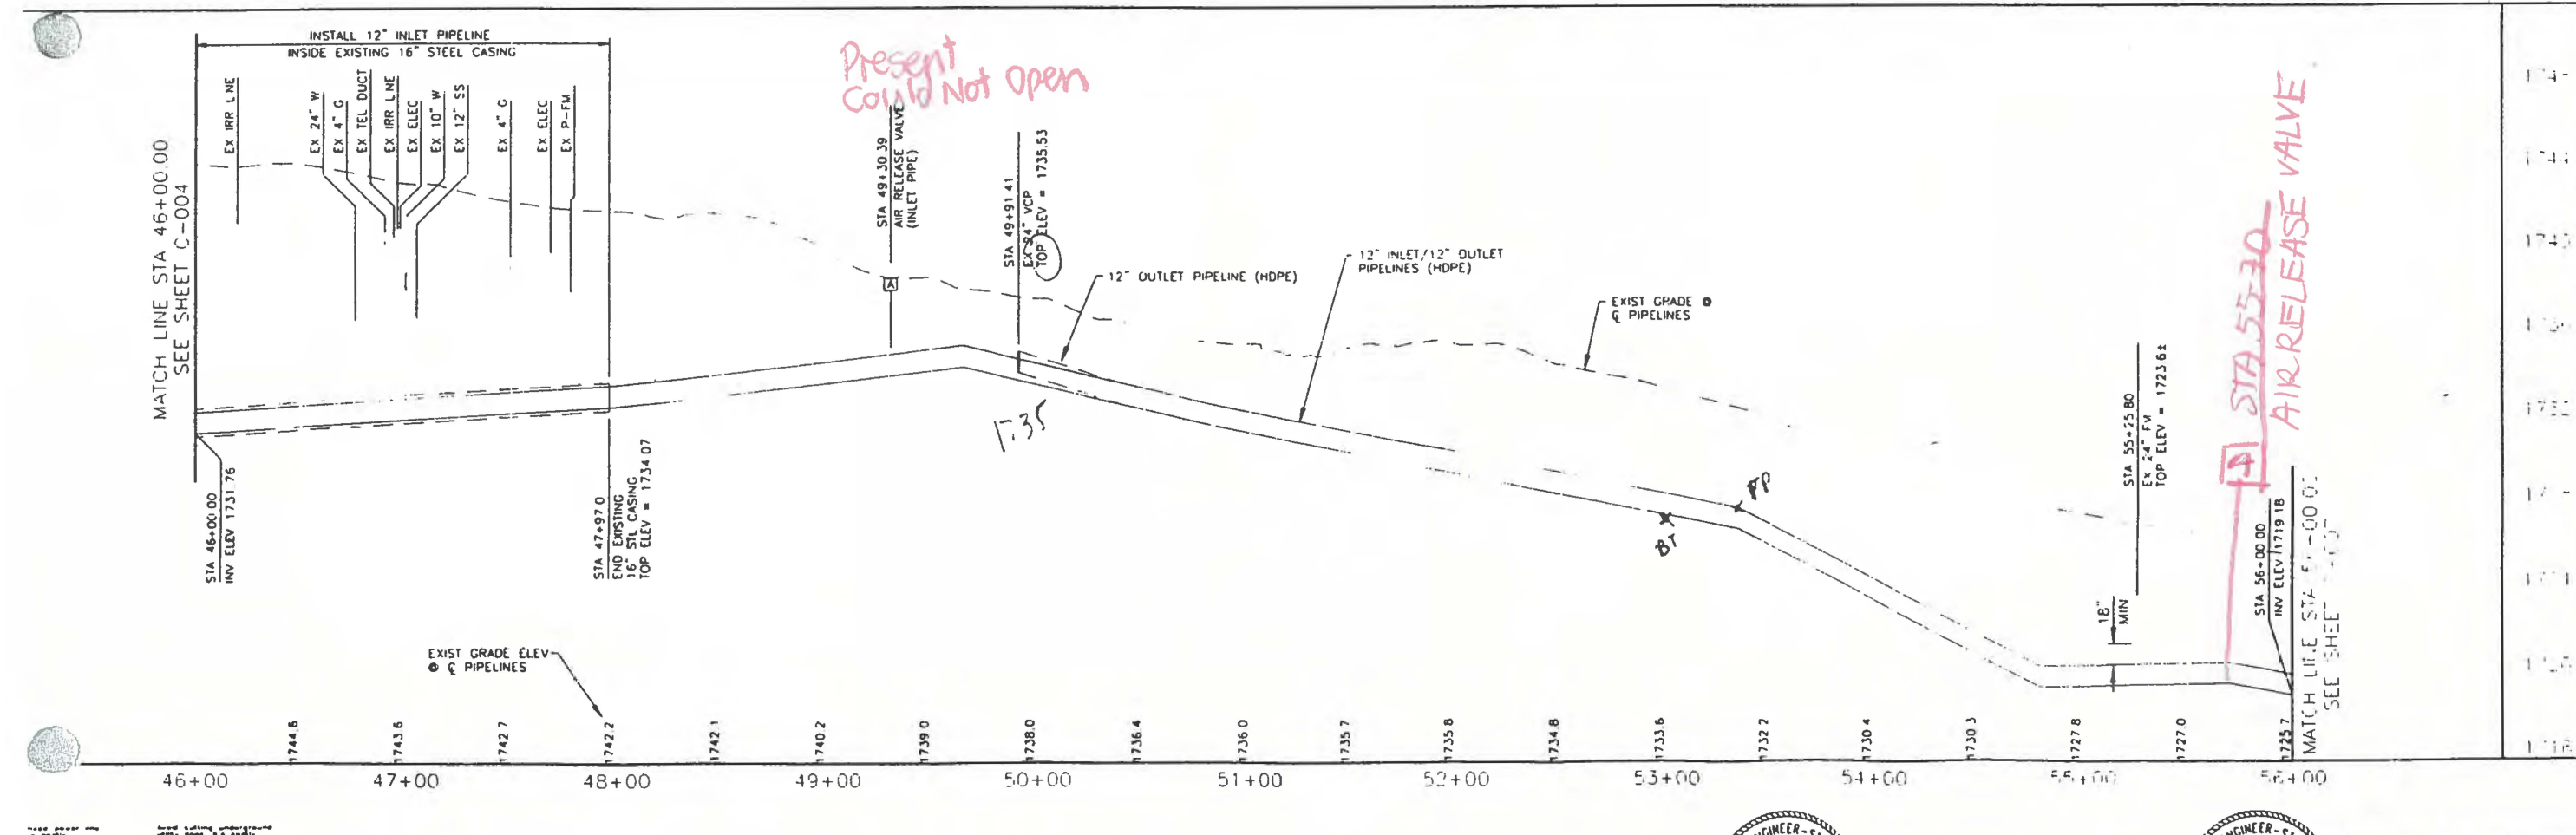

*Present could not open*


*STA 55+30  
 AIR RELEASE VALVE*

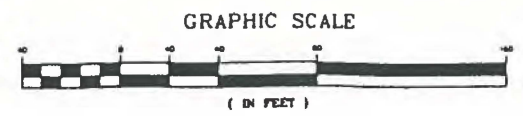

RICHARD J. CAPP RESPONSIBILITY FOR THIS DRAWING INCLUDES ALL DIMENSIONS



**CONFIDENTIAL**  
 PROPERTY OF KERR-MCGEE CORP.  
 MAY NOT BE REPRODUCED, COPIED,  
 OR USED FOR ANY PURPOSE WITHOUT  
 WRITTEN PERMISSION

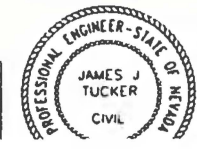

PAPER SIZE	DRAWING NO.
A	C-005

**KERR-MC GEE CHEMICAL LLC**

P.O. BOX 55 HENDERSON, NEV 89009-7000

DESIGN	DATE	APPROVED FOR CONSTRUCTION	BY	DATE
DRAWN BY	J. CAPP	SAFETY		
PROJ ENGR	J. TUCKER	ENVIRONMENTAL		
ENGR INCH	E.M. SPIRKE	OPERATIONS INCH		
		PRODUCTION BUILT		
		QUALITY CONTROL		

INLET/OUTLET PIPELINE  
 PLAN + PROFILE  
 STA 46+00 TO STA 56+00




DATE: 5/17/18

JOB No: \_\_\_\_\_  
 AFE No: C-005

SCALE: AS SHOWN

Call before you Dig  
 LEAD

SHEET 9 OF 16

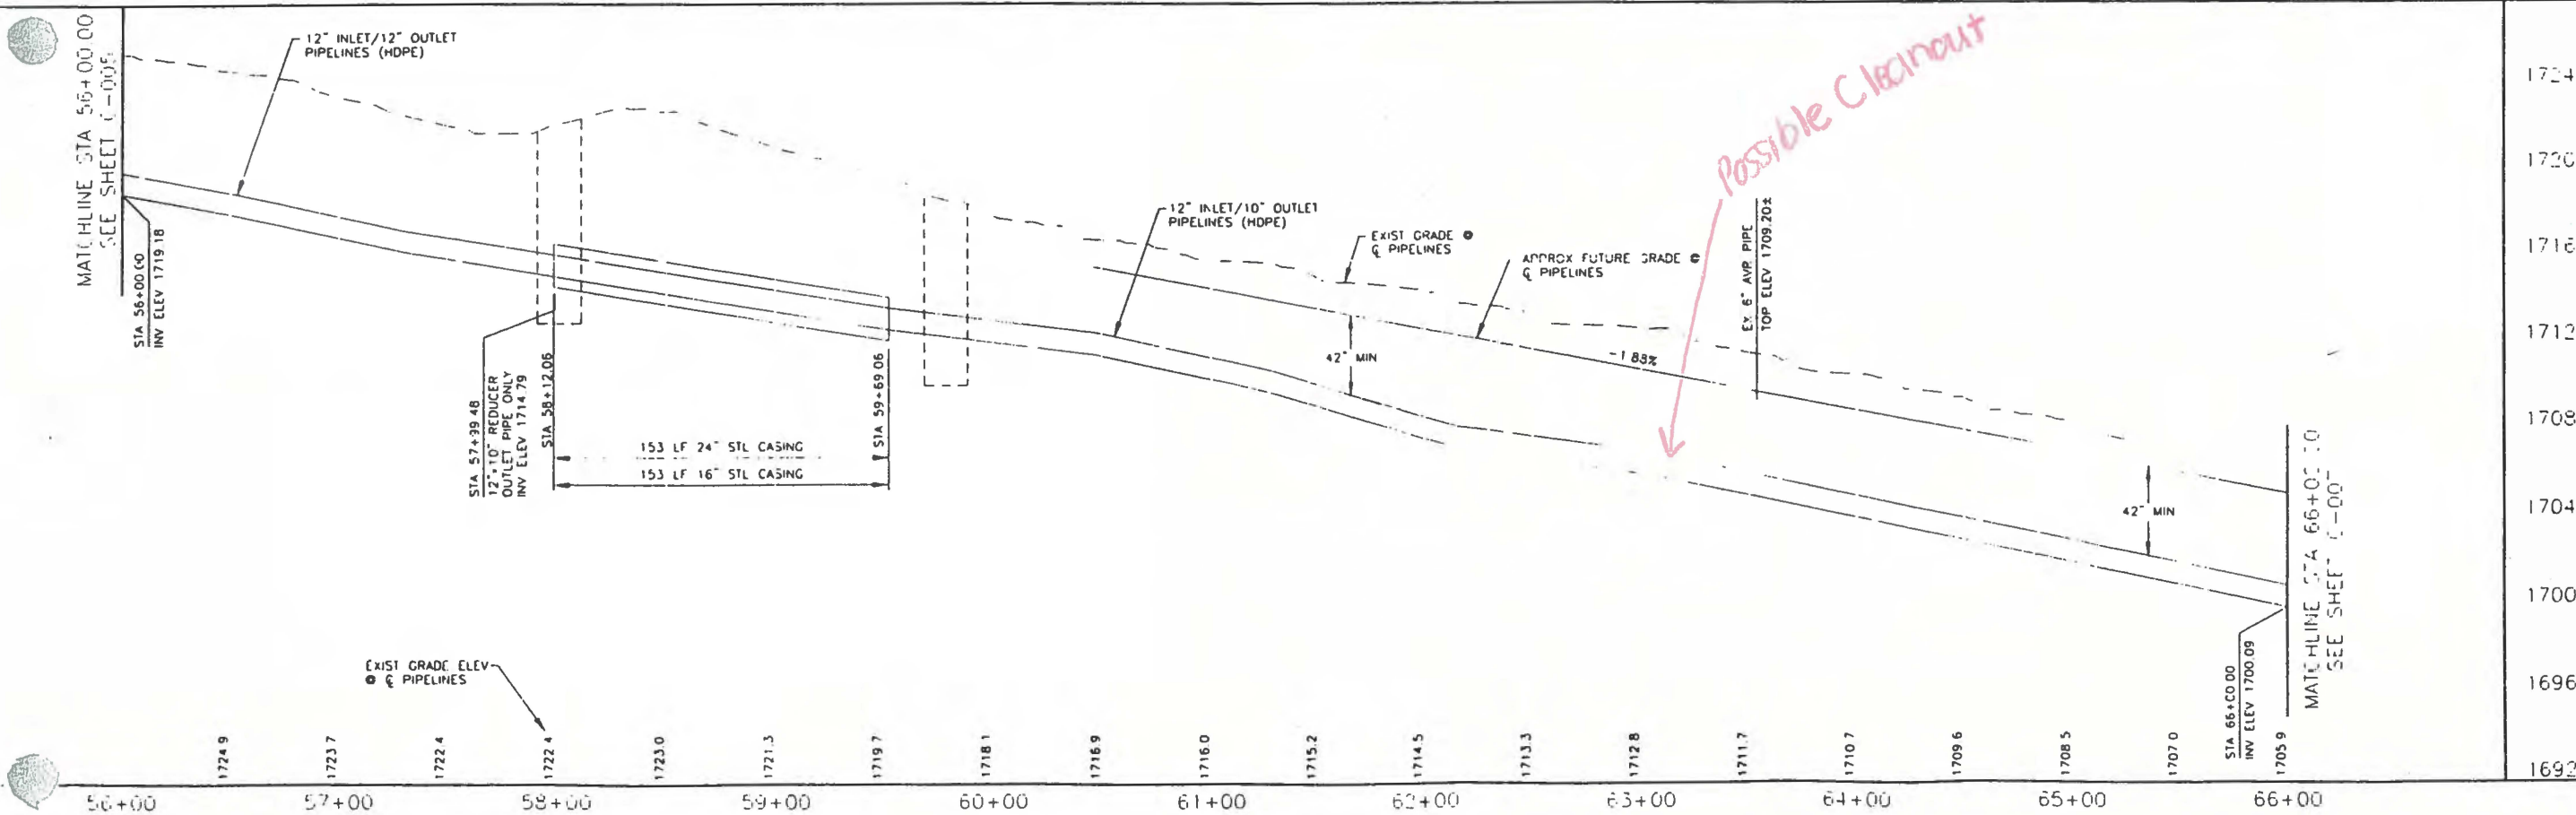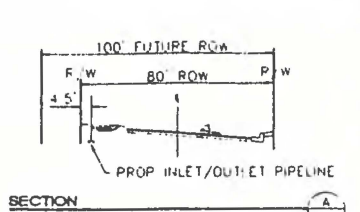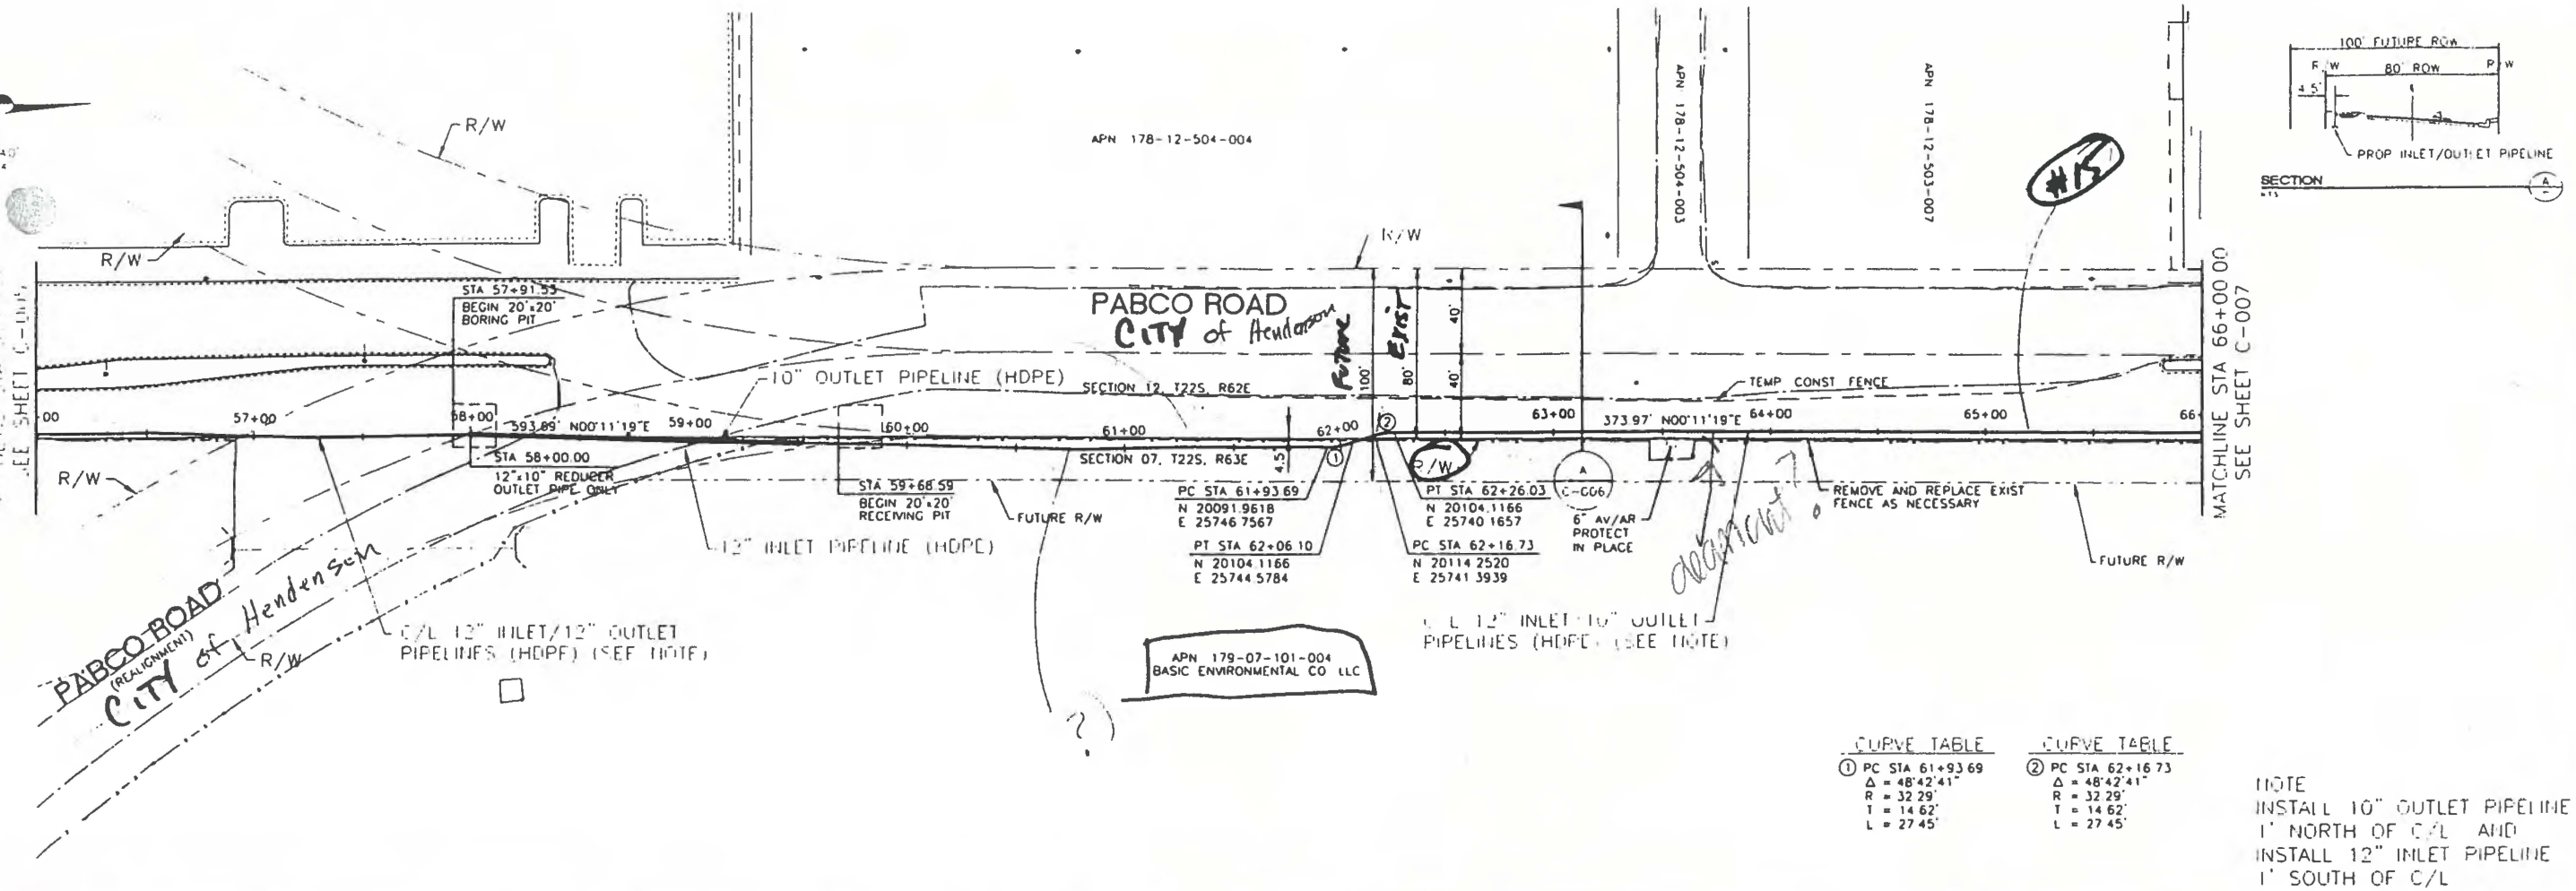

**CURVE TABLE**

① PC STA 61+93.69  
 Δ = 48°42'41"  
 R = 32.29'  
 T = 14.62'  
 L = 27.45'

**CURVE TABLE**


② PC STA 62+16.73  
 Δ = 48°42'41"  
 R = 32.29'  
 T = 14.62'  
 L = 27.45'

NOTE  
 INSTALL 10" OUTLET PIPELINE  
 1' NORTH OF C/L AND  
 INSTALL 12" INLET PIPELINE  
 1' SOUTH OF C/L


Call before you Dig



RICHARD J. CAPP RESPONSIBILITY FOR

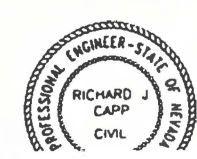

CONFIDENTIAL  
 PROPERTY OF KERR-MCGEE CORP.  
 MAY NOT BE REPRODUCED, COPIED,  
 OR USED FOR ANY PURPOSE WITHOUT

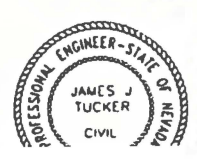

PAPER SIZE  
 A

DRAWING NO.  
 C-006

SHEET  
 OF 10

**KERR-MCGEE CHEMICAL LLC**  
 P.O. BOX 55 HENDERSON, NEV. 89009-7000

**JOB NO.** \_\_\_\_\_  
**DATE** \_\_\_\_\_

**DESIGN**



DATE	BY	DATE	BY
11/17/11	J. APPROV.	11/17/11	BY
	JJ TUCKER		
	EM. SUPPL.		

**APPROVED FOR CONSTRUCTION**

DATE	BY	DATE	BY
	SAFETY		
	ENVIRONMENTAL		
	OPERATIONS MAJOR		
	PRODUCTION SUPT.		
	PLANT MAJOR		
	PLANT CONTROL		

**INLET/OUTLET PIPELINE  
 PLAN + PROFILE  
 STA 56+00 TO STA 66+00**


**PBS&I**

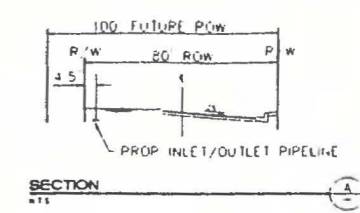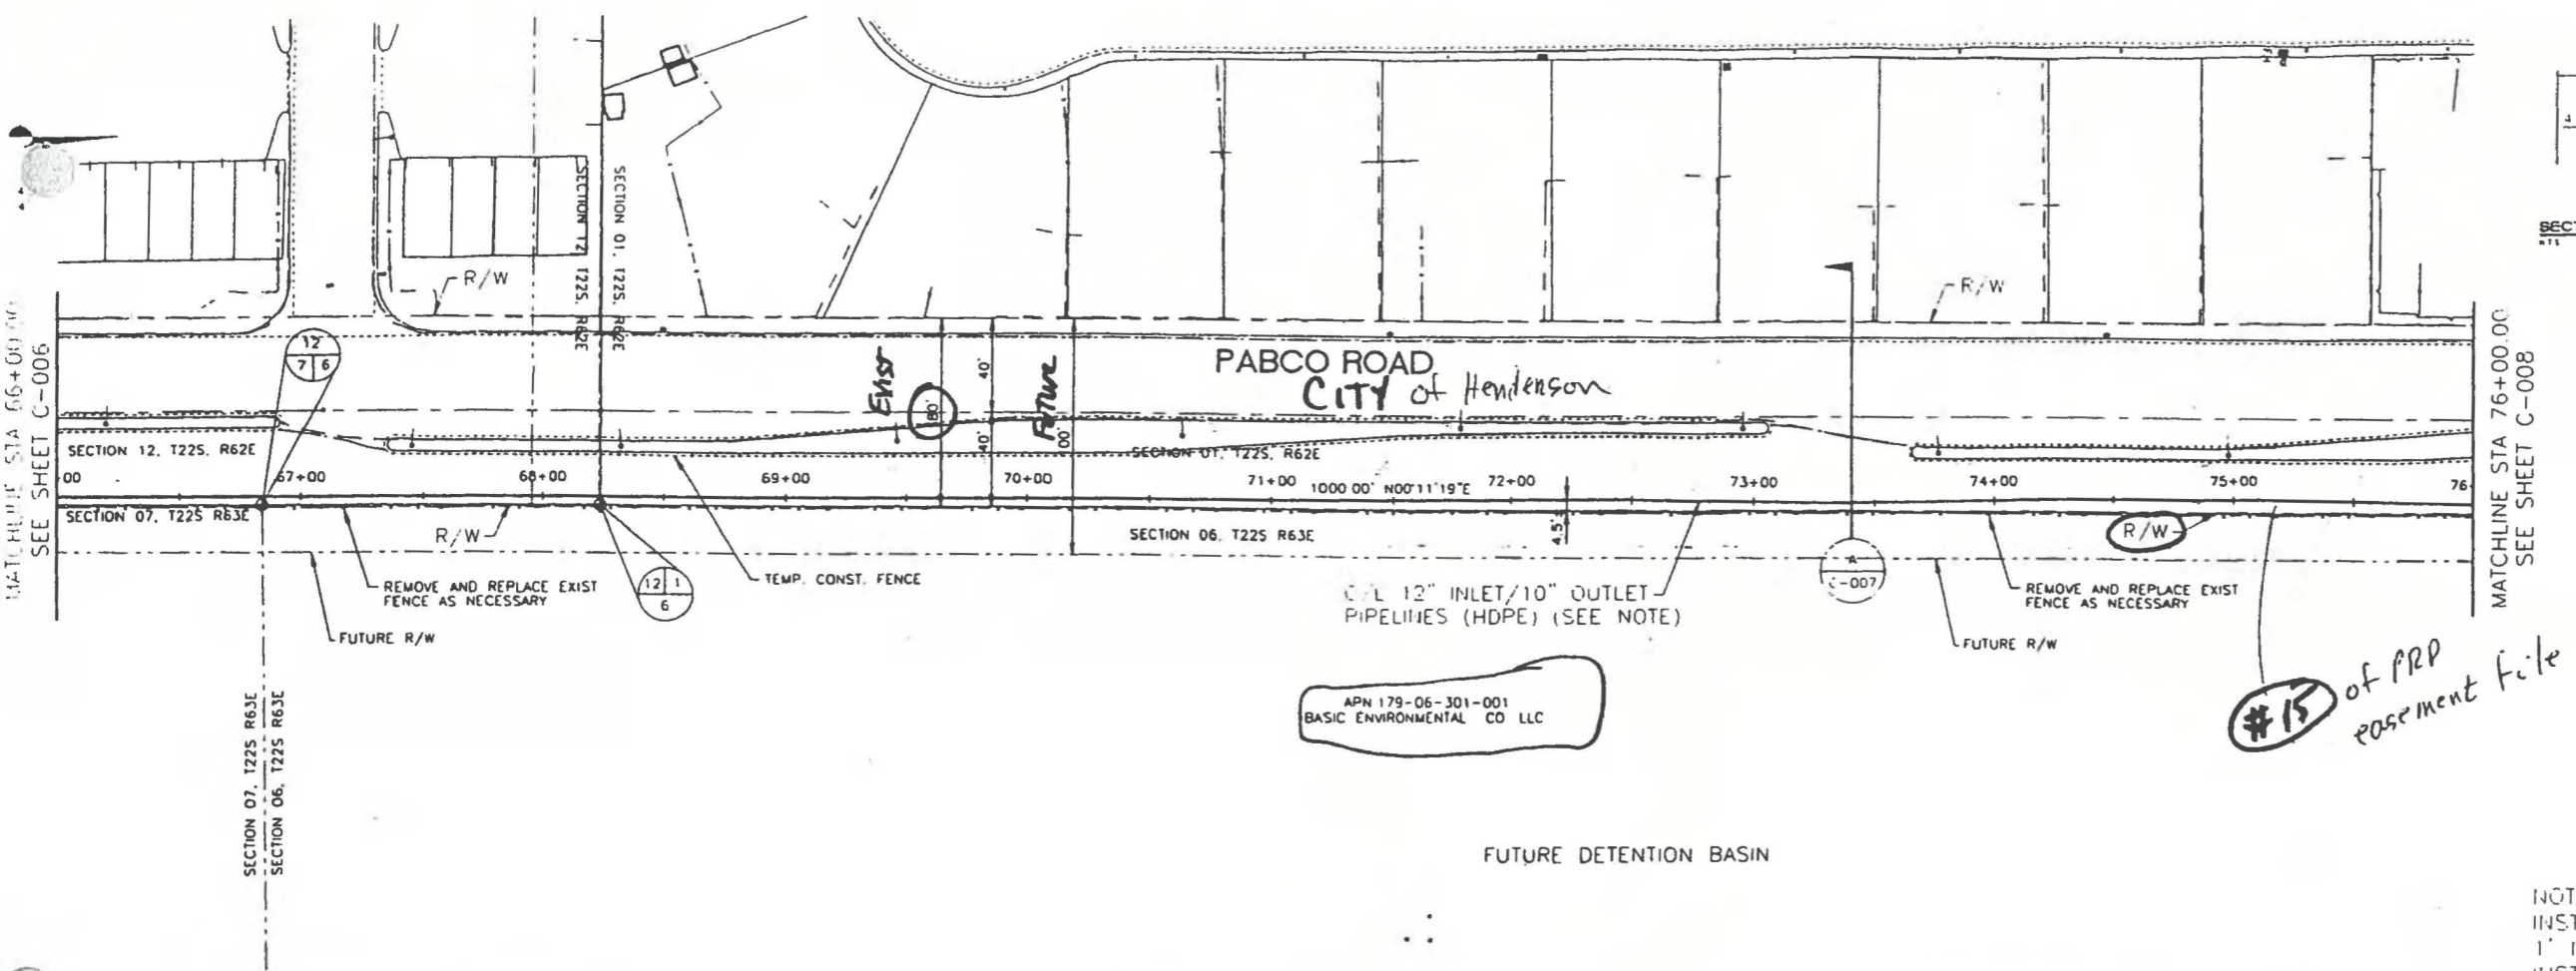


APN 179-06-301-001  
BASIC ENVIRONMENTAL CO LLC

#15 of PRP placement file

NOTE  
INSTALL 10" OUTLET PIPELINE  
1' NORTH OF C/L AND  
INSTALL 12" INLET PIPELINE  
1' SOUTH OF C/L

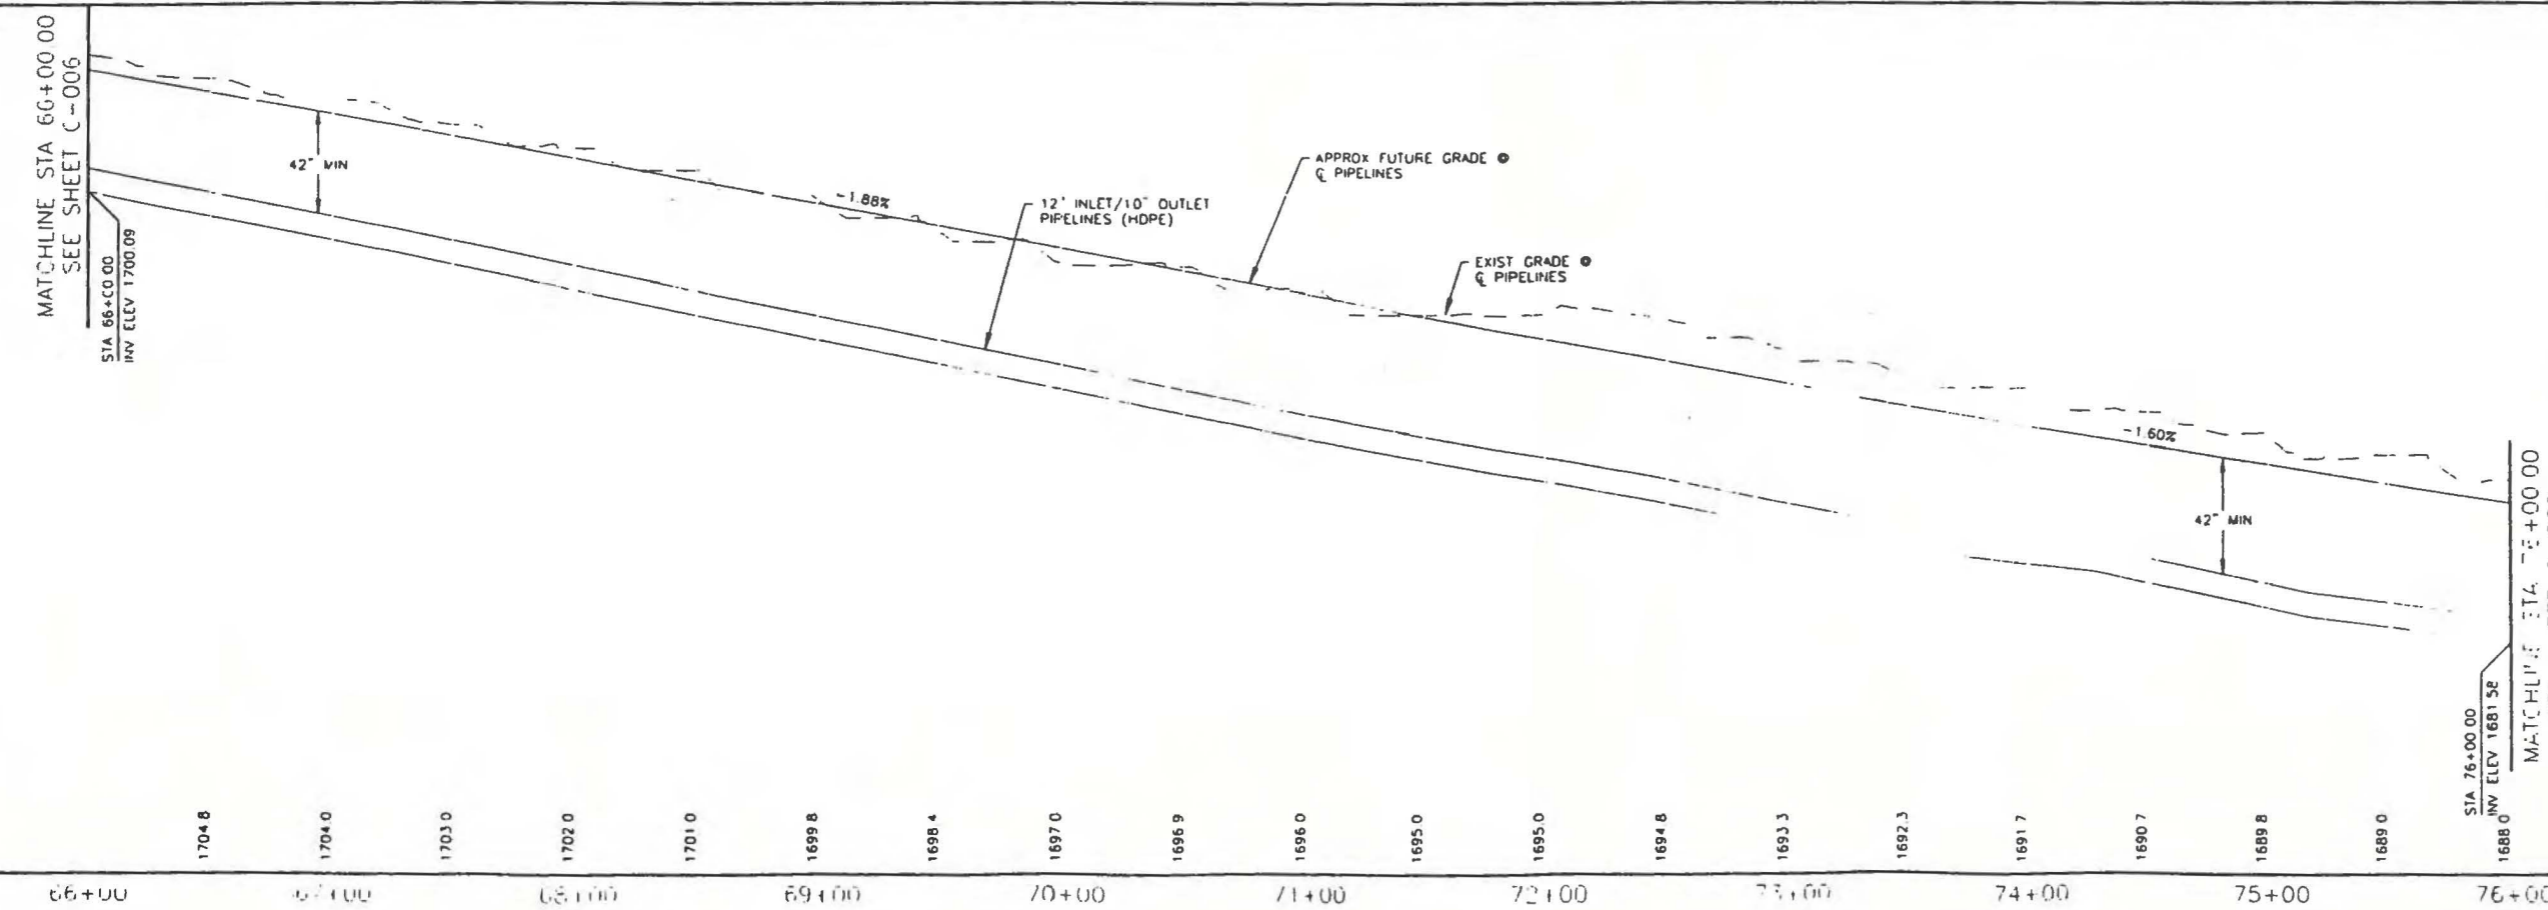

GRAPHIC SCALE

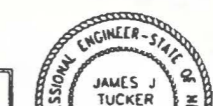

CONFIDENTIAL  
PROPERTY OF KERR-MCGEE CORP

PAPER SIZE  
DRAWING NO

**KERR-MCGEE CHEMICAL LLC**  
P.O. BOX 55 HENDERSON, NEV. 89009-7000

DESIGN	DATE	APPROVED FOR CONSTRUCTION
DRAWN BY	BY	BY
PROJ ENGR	DATE	DATE
ENGR MAJOR	SAFETY	PROCESS ENGR
	ENVIRONMENTAL	PROJECT ENGR
	OPERATIONS MAJOR	ENGR MAJOR
	PRODUCTION SUPT	PLANT MAJOR
	QUALITY CONTROL	

INLET/OUTLET PIPELINE  
PLAN + PROFILE  
STA 66+00 TO STA 76+00



DATE: 11/11/18



REVISIONS	DATE
DESCRIPTION	
BY	


TOLERANCE UNITS:	FEET
FRACTIONS:	0/100
SCALE:	AS SHOWN

JOB NO.	
DATE	
SHEET	

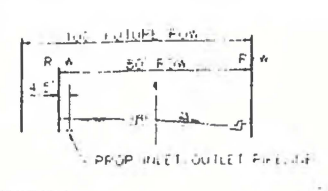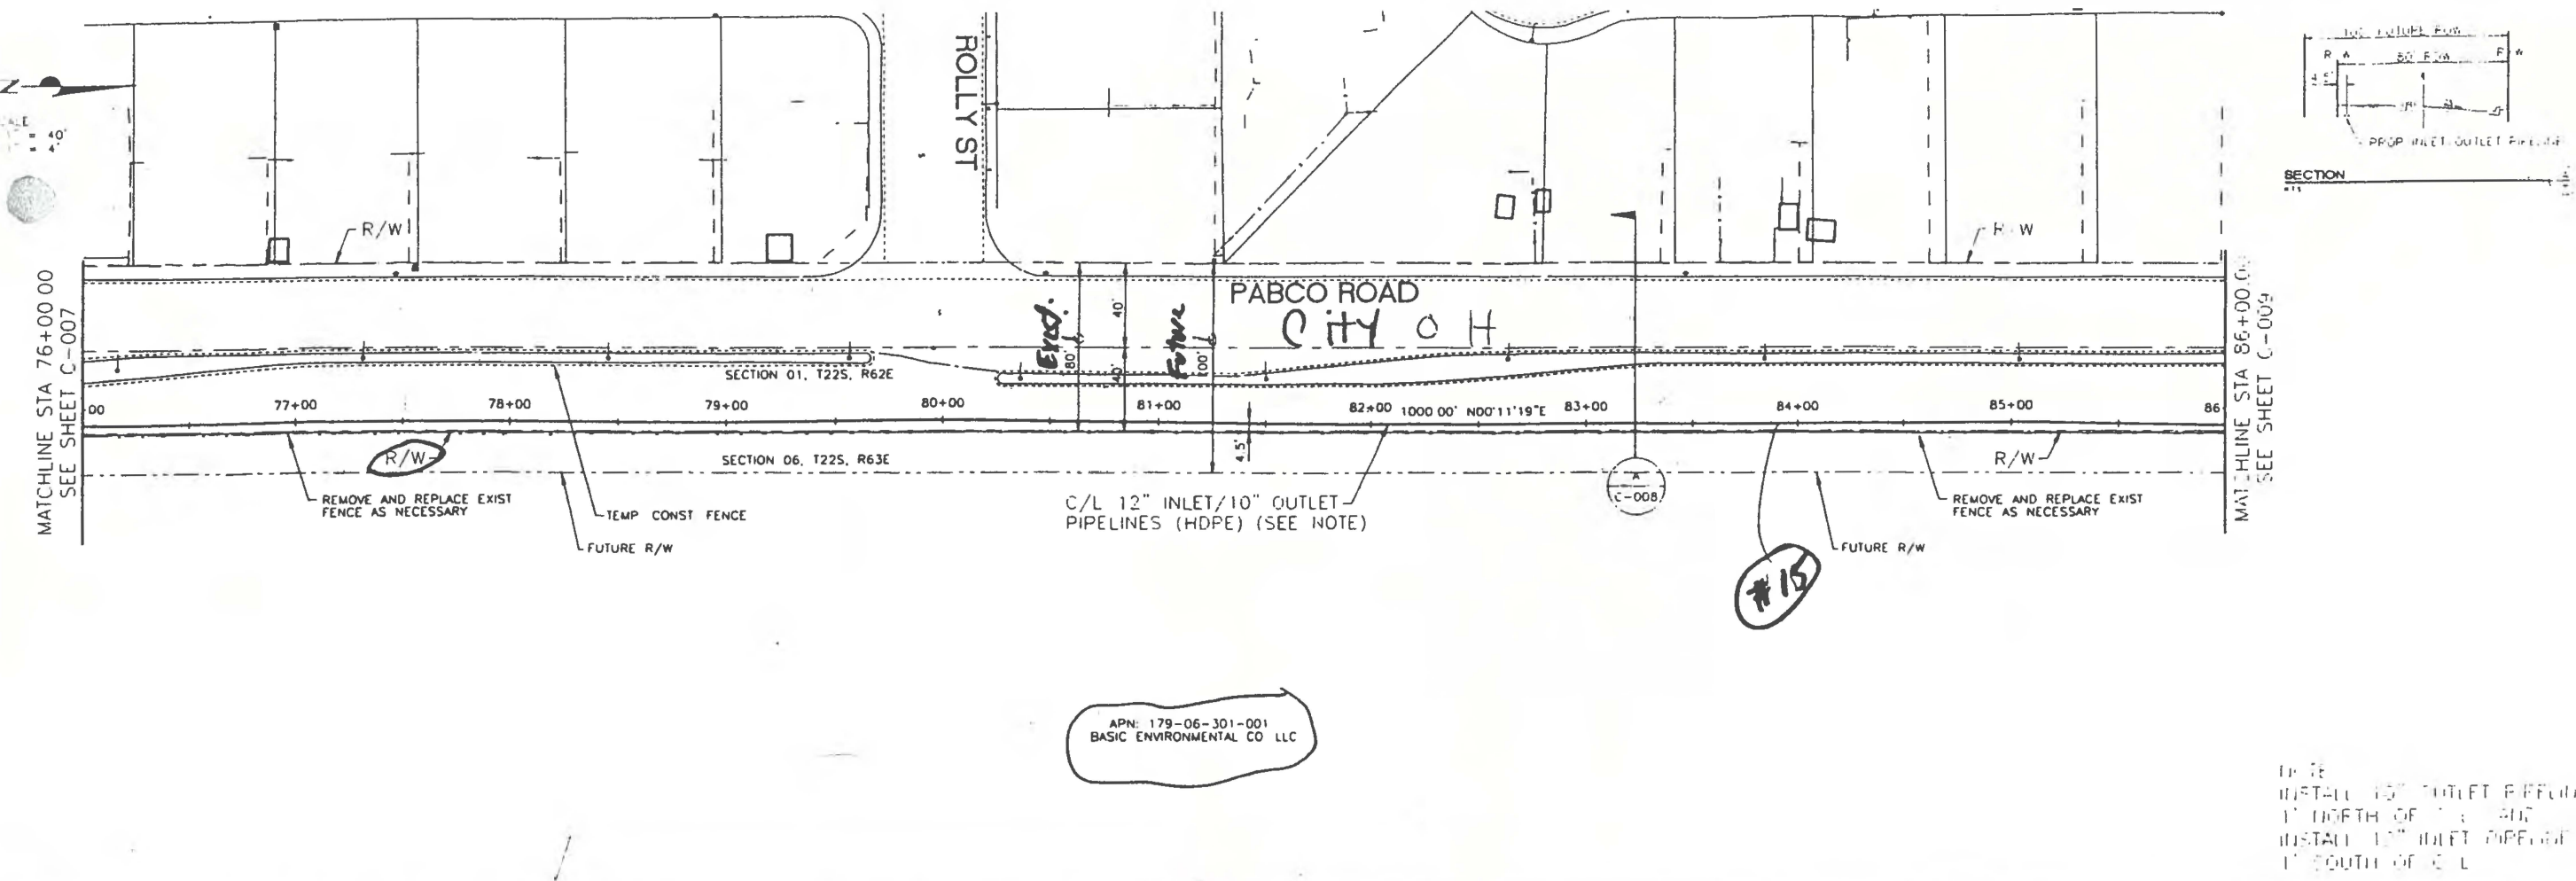

APN: 179-06-301-001  
BASIC ENVIRONMENTAL CO LLC

DATE  
INSTALL 12" INLET PIPELINE  
1' NORTH OF C/L AND  
INSTALL 10" INLET PIPELINE  
1' SOUTH OF C/L


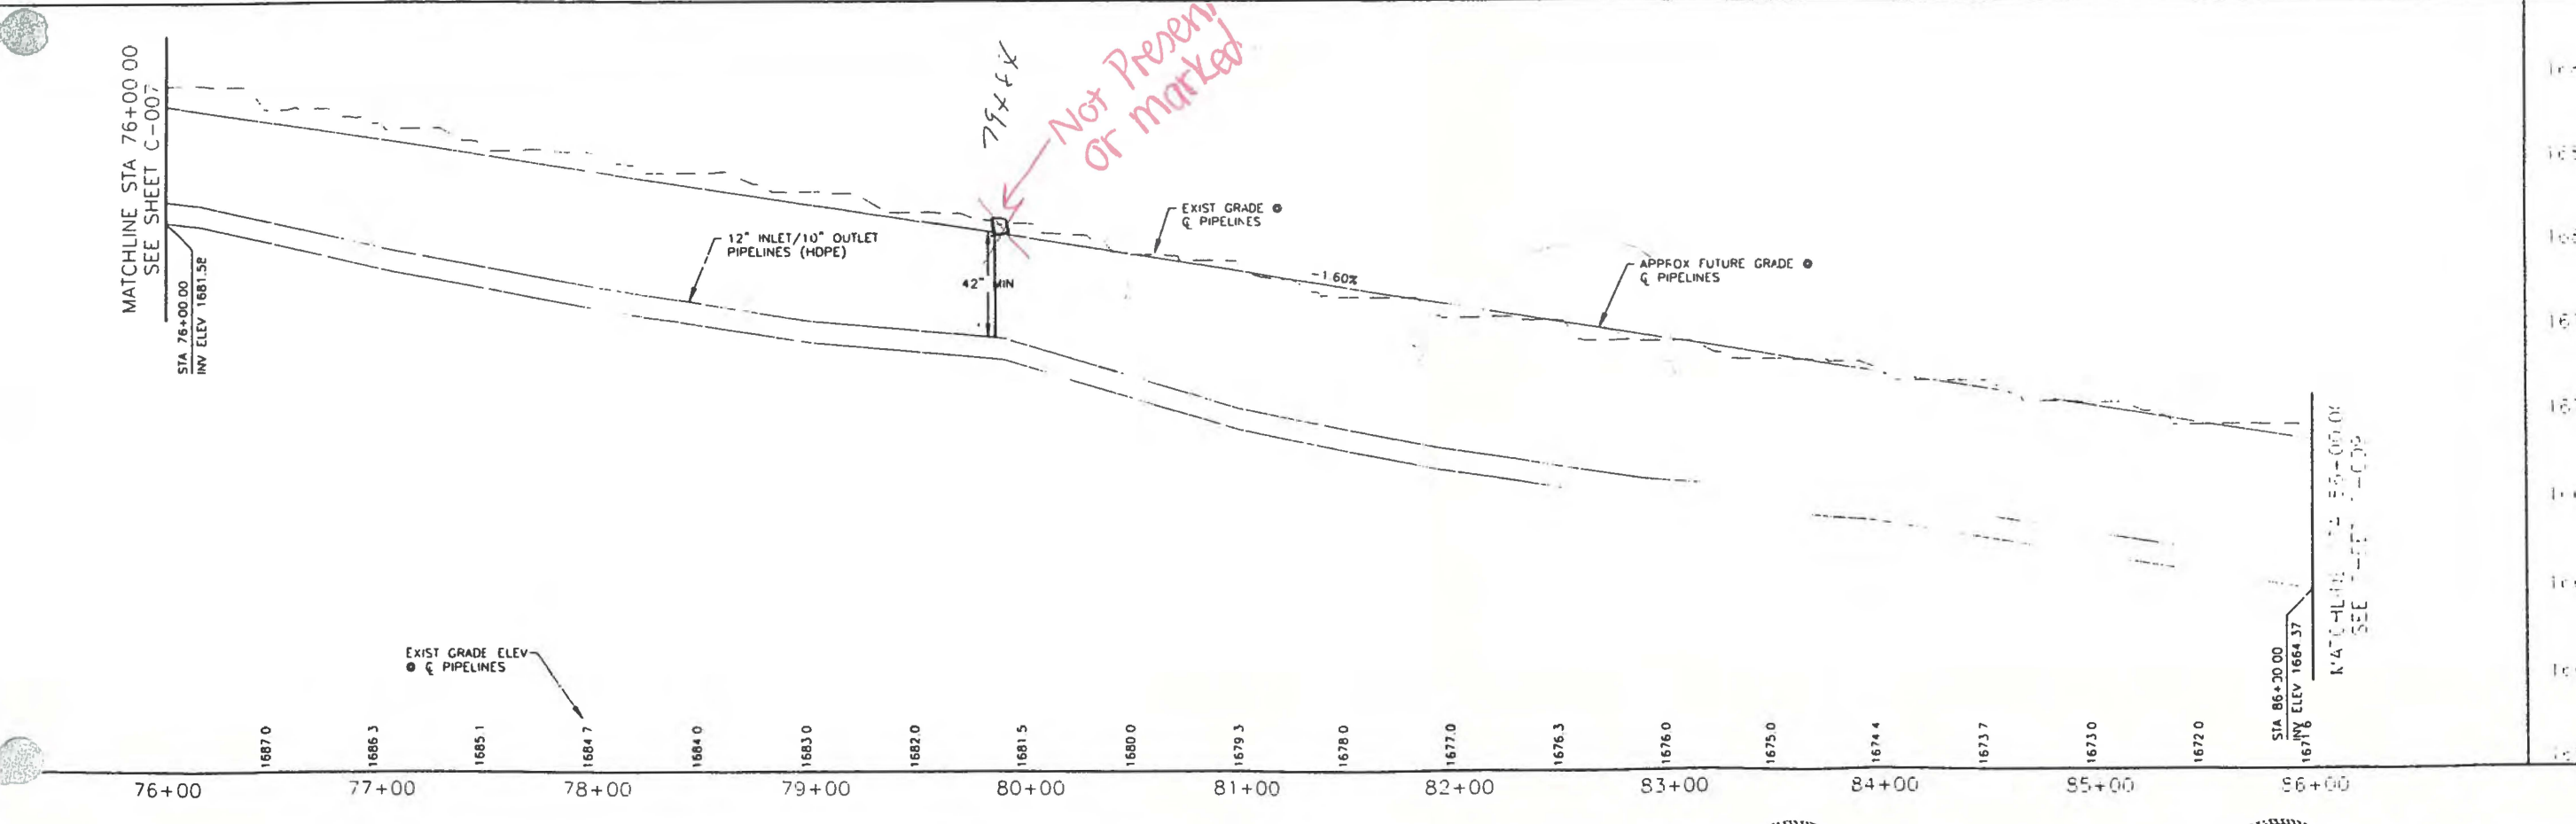


DESIGN		DATE	APPROVED FOR CONSTRUCTION
BY	J. APP. (11/11/19)	BY	DATE
PROJ ENGR	J. TUCKER	PROCESS ENGR	
ENGR INGR	J. TUCKER	PROJECT ENGR	
ENGR INGR	J. TUCKER	OPERATIONS INGR	
ENGR INGR	J. TUCKER	PRODUCTION SUPT	
ENGR INGR	J. TUCKER	QUALITY CONTROL	

PROJECT	KERR-MC GEE CHEMICAL LLC
JOB NO.	P.O. BOX 55 HENDERSON, NEV. 89009-7000
REVISIONS	
DESCRIPTION	
DATE	5/20/20
SCALE	AS SHOWN

SHEET	1
OF	1



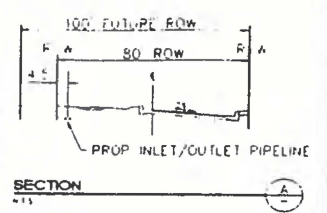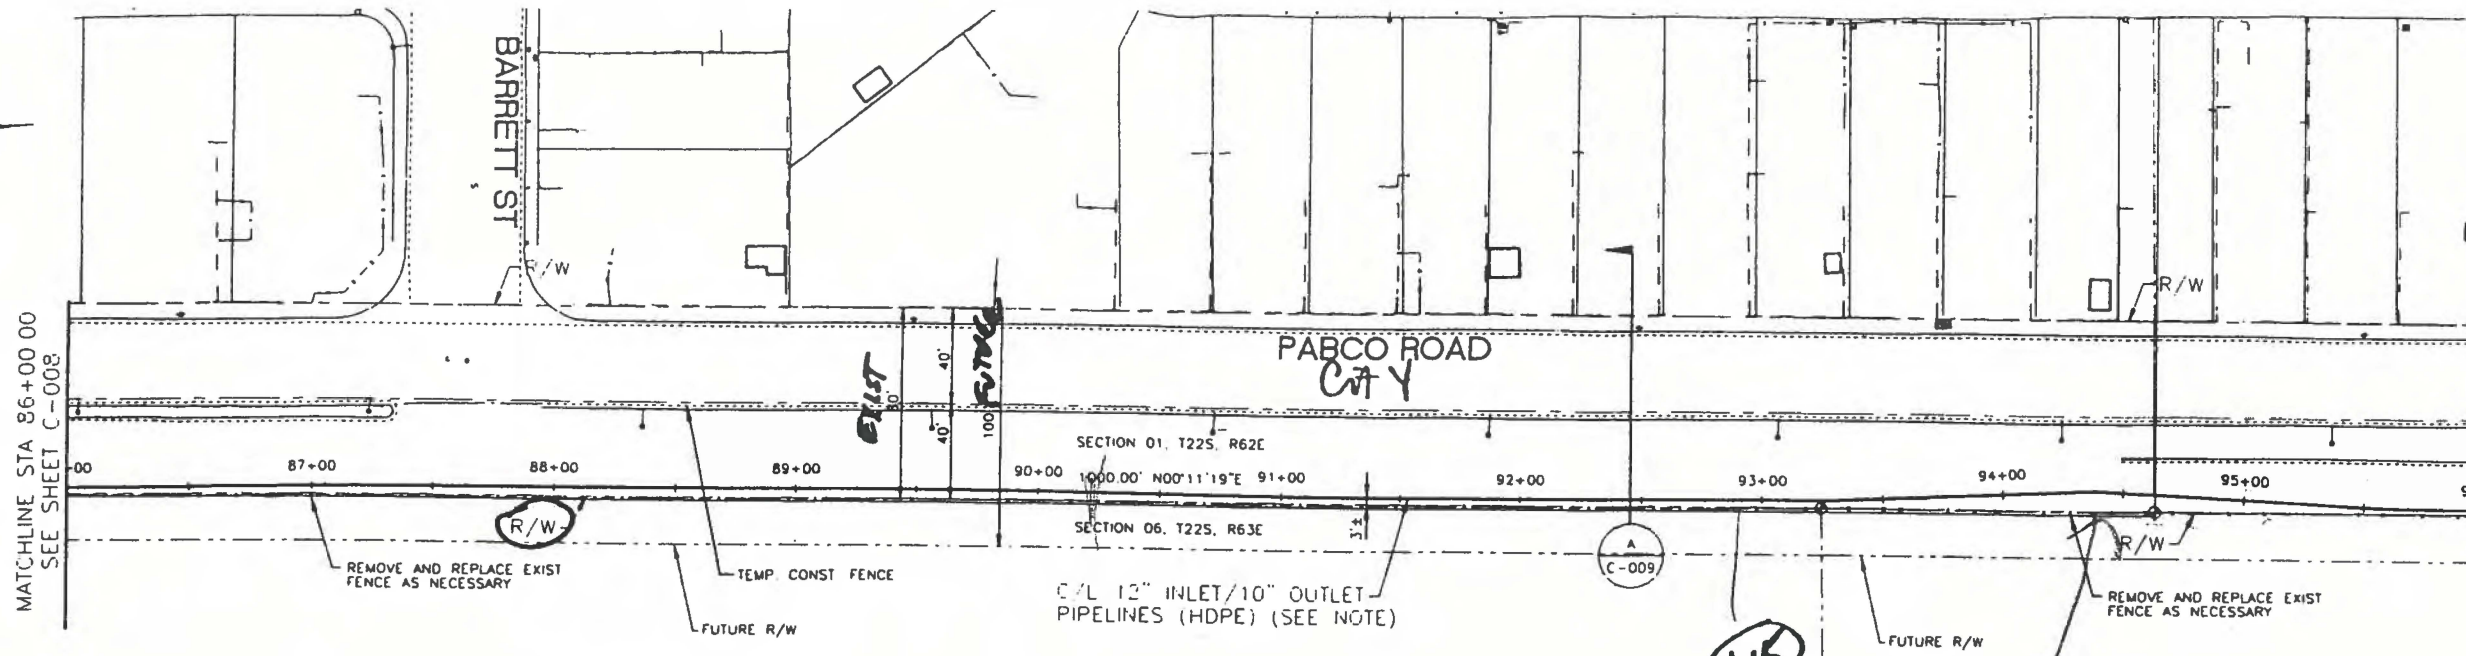


APN 179-06-101-001  
BASIC ENVIRONMENTAL CO LLC

APN 179-06-101-001  
BASIC ENVIRONMENTAL CO LLC



*ASPT*  
*308573*  
*BMAV01*

INSTALL 10" OUTLET PIPELINE  
1' NORTH OF C/L AND  
INSTALL 12" INLET PIPELINE  
1' SOUTH OF C/L

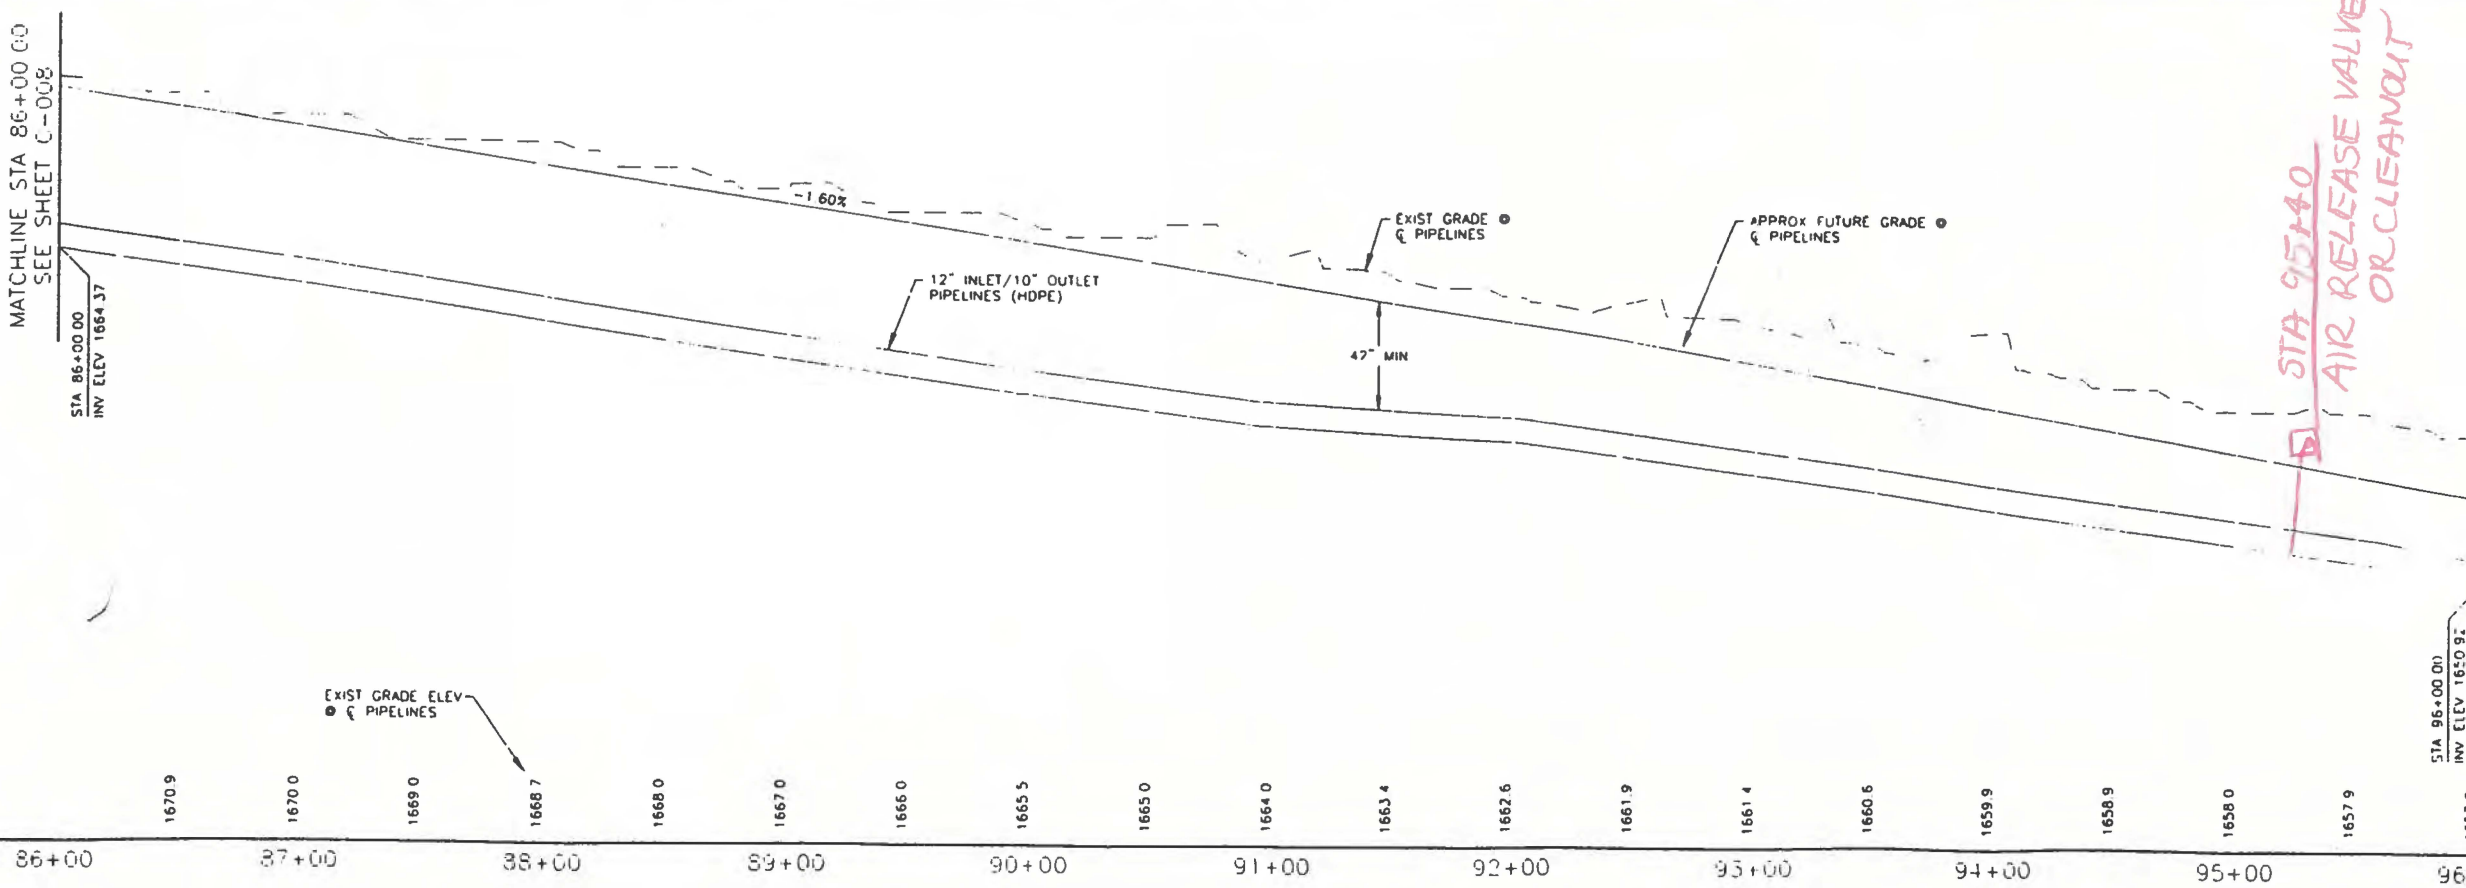

*STA 95+40*  
*AIR RELEASE VALVE*  
*OR CLEANOUT*

GRAPHIC SCALE

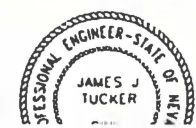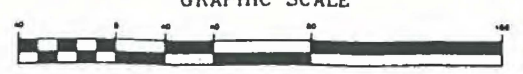

CONFIDENTIAL  
PROPERTY OF KERR-McGEE CORP.

PAPER SIZE

DRAWING NO.

**KERR-Mc GEE CHEMICAL LLC**

P.O. BOX 55 HENDERSON, NEV. 89009-7000

TOLERANCE UNITS:  
DIMENSIONS: 1/16" ±  
DIMENSIONS: 0.000 ±

**INLET/OUTLET PIPELINES  
PLAN + PROFILE  
STA 86+00 TO STA 96+00**

DESIGN	DATE	APPROVED FOR CONSTRUCTION
DRAWN BY	DATE	BY DATE
PROJ ENGR	ENVIRONMENTAL	PROCESS ENGR
ENGR MAJOR	OPERATIONS MAJOR	ENGR MAJOR
	PRODUCTION BUFT	PLANT MAJOR
		Q.L.T. CONTROL

DATE: 5/11/07

SCALE: AS SHOWN

JOB NO.

REVISIONS

DATE

BY

DESCRIPTION

APPROVED BY

DATE




DATE

DATE



SHEET  
13  
OF  
26

Call before you dig

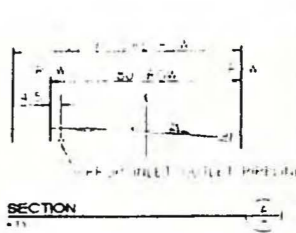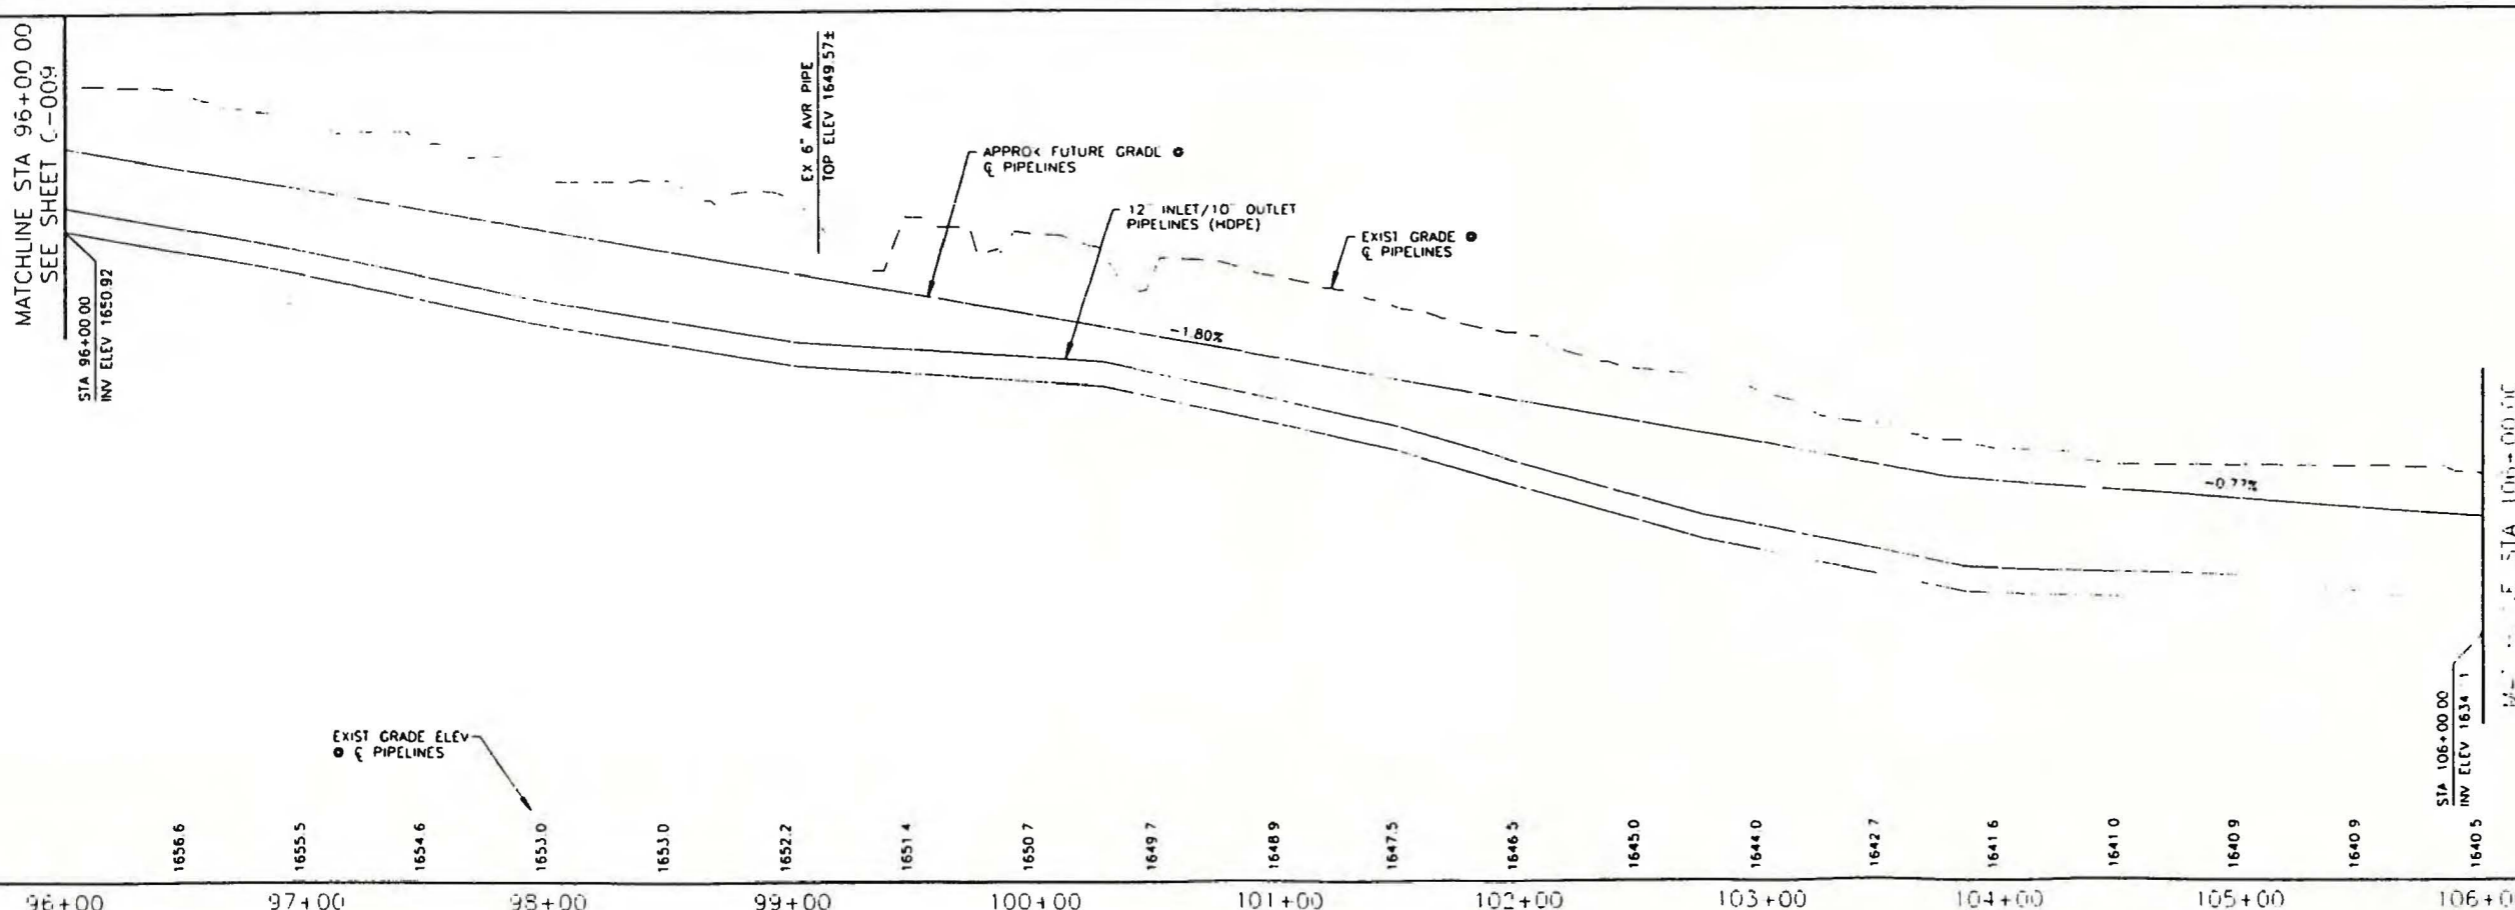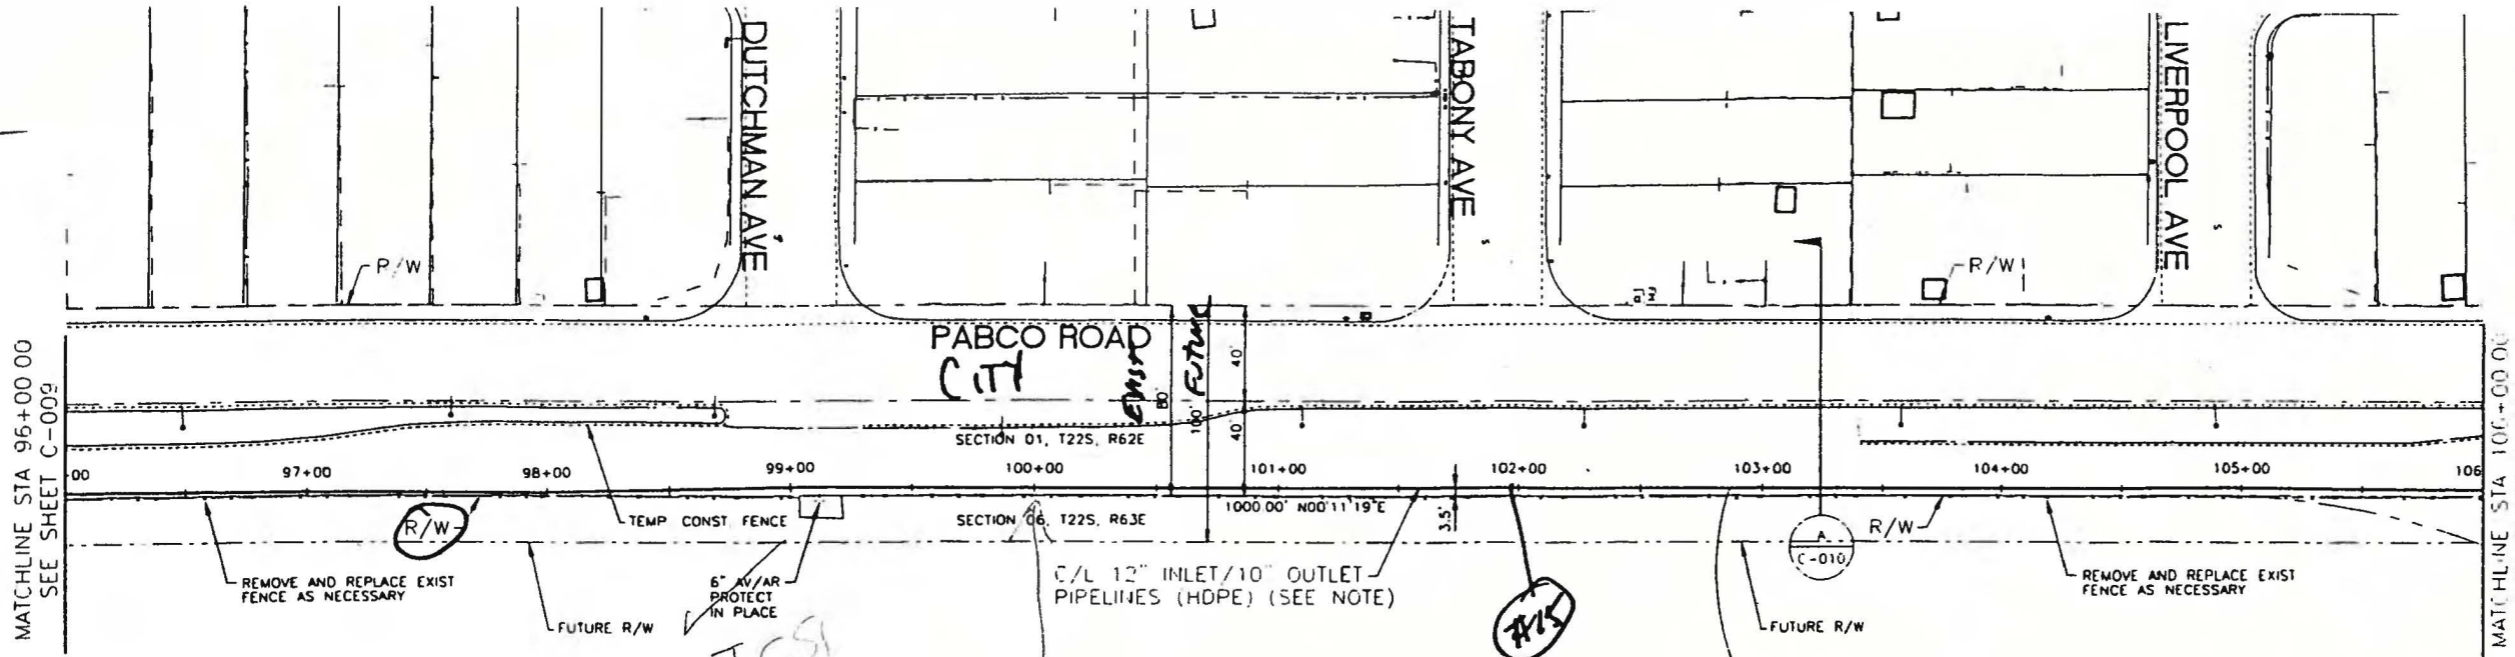

KERR-MC GEE CHEMICAL LLC  
 P.O. BOX 55 HENDERSON, NEV. 89009-7000  
 TOLERANCE UNITS: 1/8\"/>

DESIGN		DATE		APPROVED FOR CONSTRUCTION	
DRAWN BY	J. TUCKER	DATE	11/11/10	BY	DATE
PROJ ENGR	J. TUCKER	SAFETY		PROCESS ENGR	
ENGR MAJOR	E.M. SPOFFE	OPERATIONS MAJOR		PROJECT ENGR	
		PRODUCTION SUPT.		ENGR MAJOR	
		QUALITY CONTROL		PLANT MAJOR	

**PBS**

INLET/OUTLET PIPELINES  
 PLAN + PROFILE  
 STA 96+00 TO STA 106+00


SCALE: AS SHOWN

DATE: 11/11/10

Call before you dig






CONFIDENTIAL  
 PROPERTY OF KERR-MCGEE CORP.  
 MAY NOT BE REPRODUCED, COPIED,  
 OR USED FOR ANY PURPOSE WITHOUT

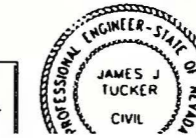

PAPER SIZE  
 A

DRAWING NO  
 C-010

SHEET  
 1 OF 2

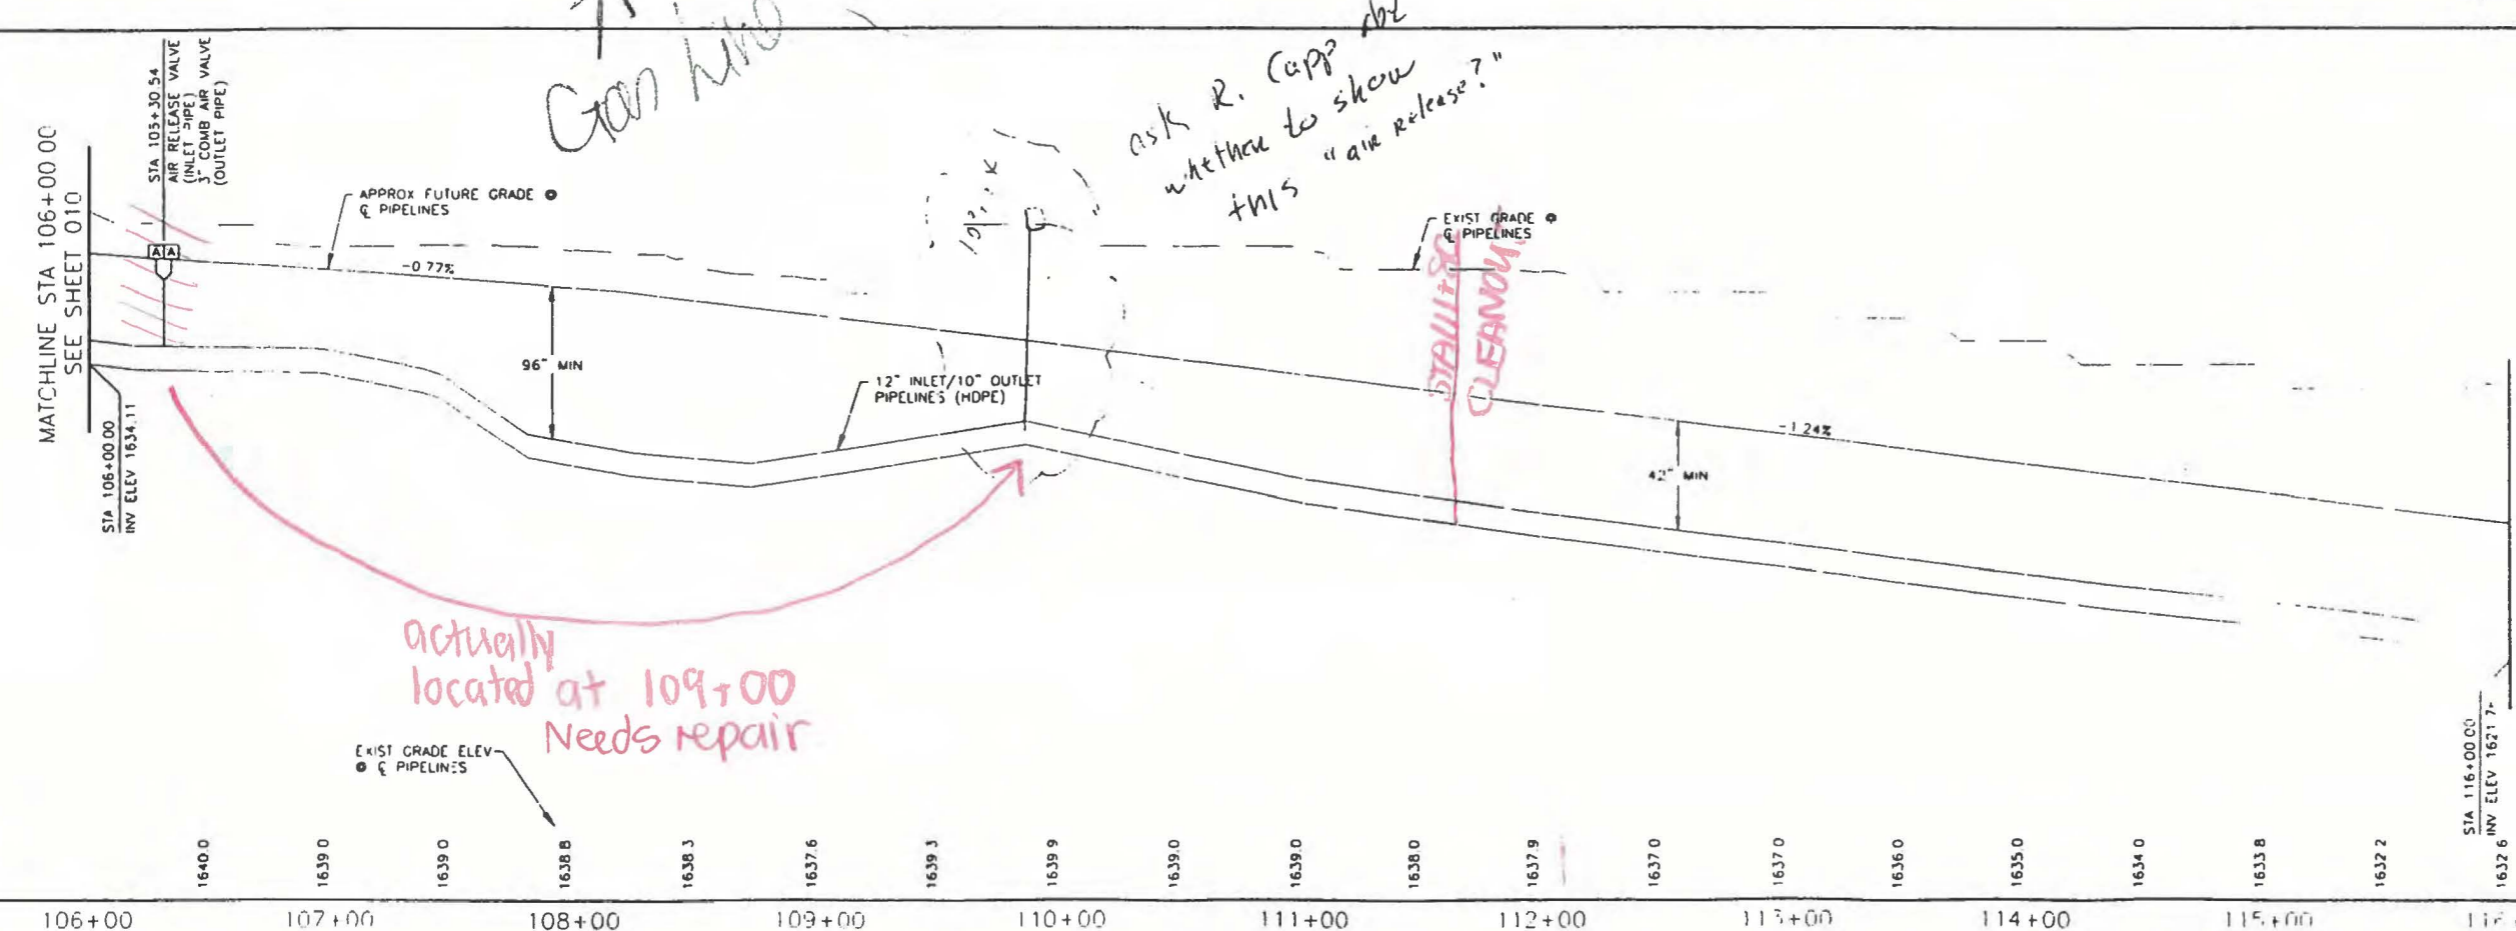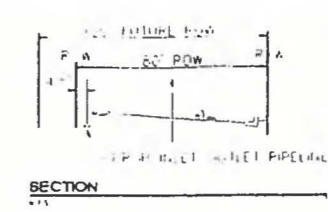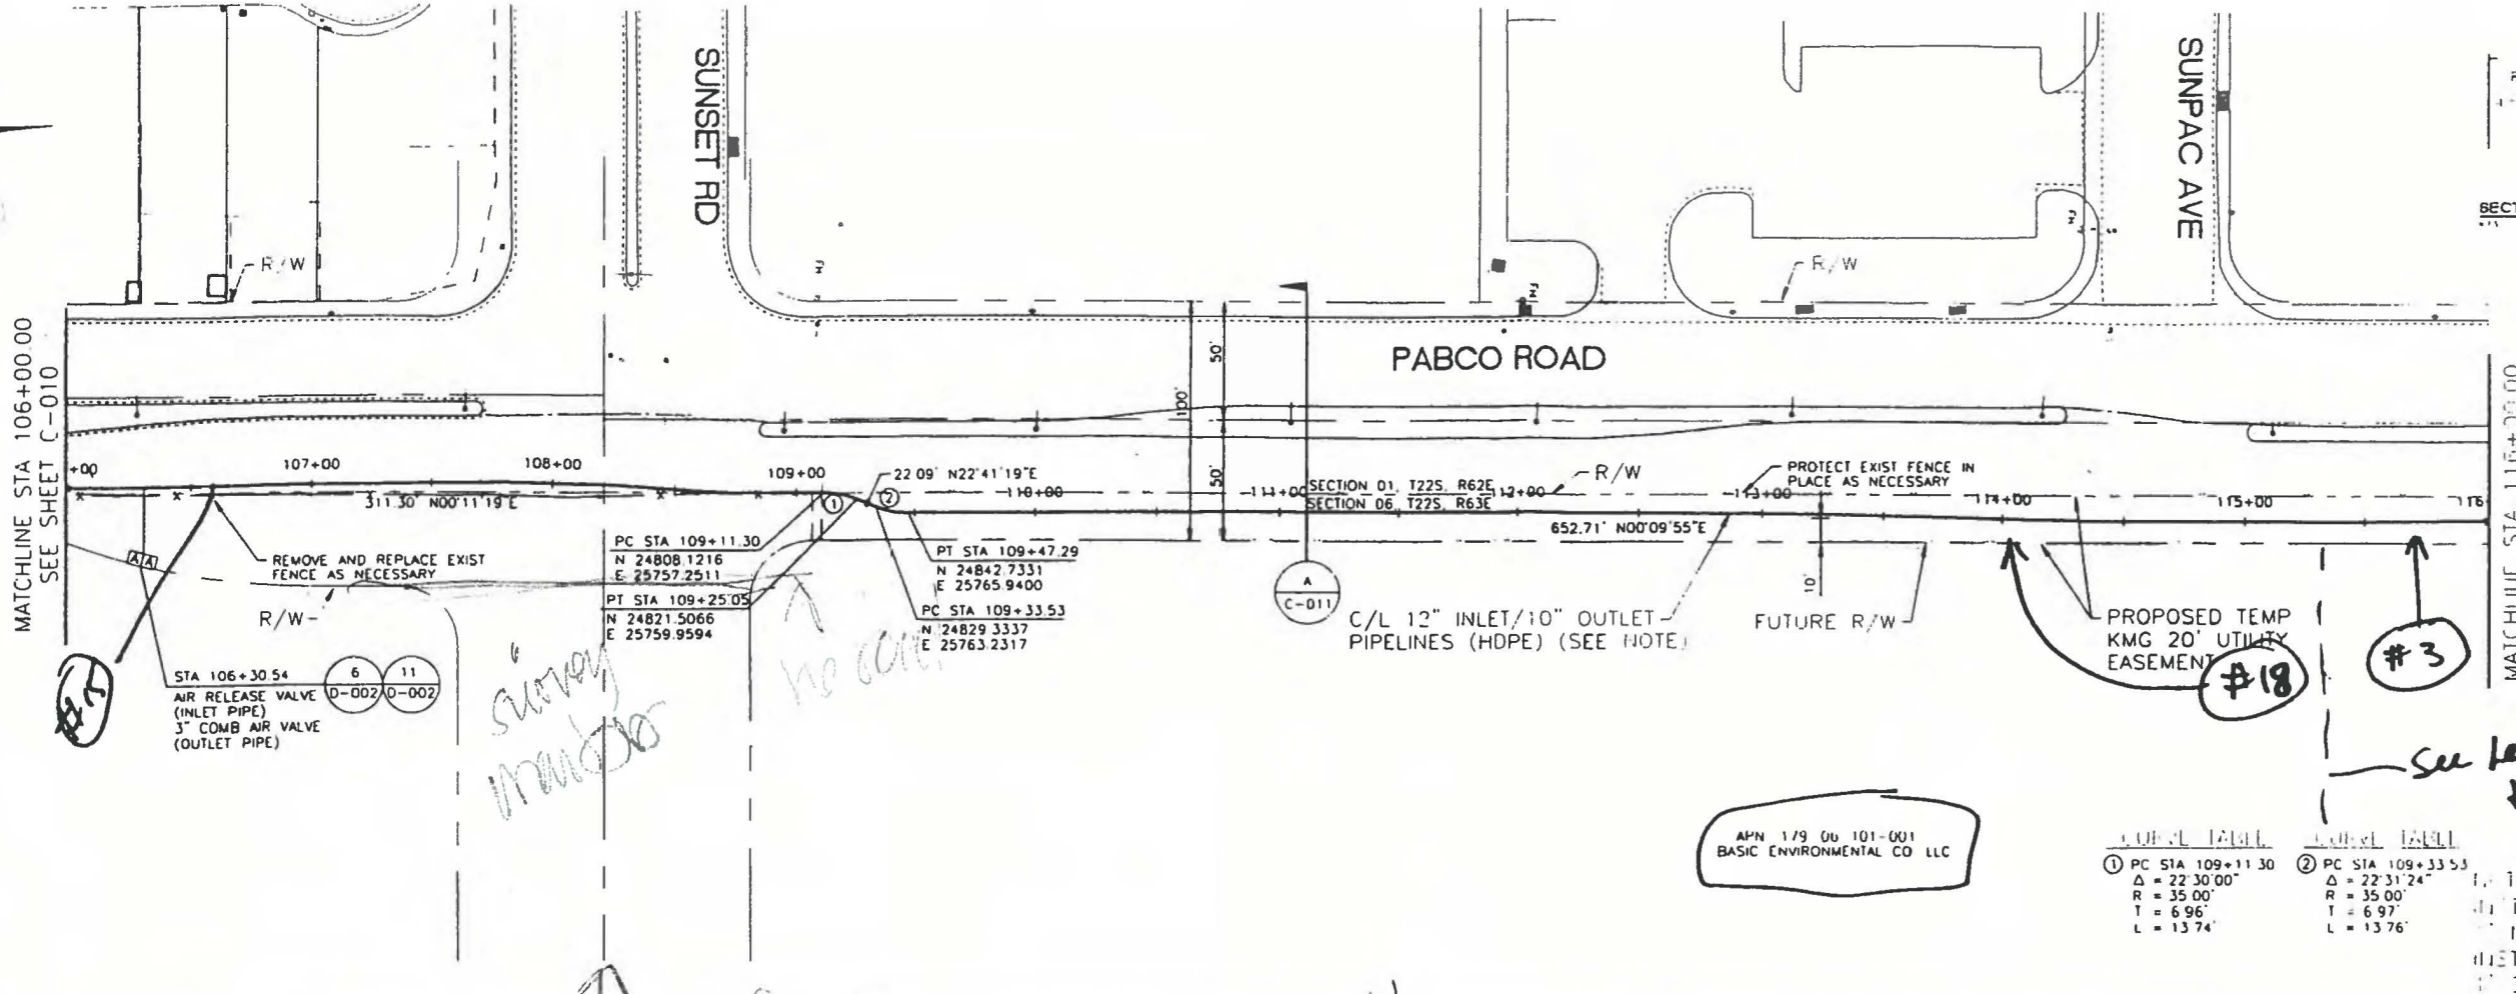

APN 179 00 101-001  
BASIC ENVIRONMENTAL CO LLC


① PC STA 109+11.30  
Δ = 22'30.00"  
R = 35.00'  
T = 6.96'  
L = 13.74'

② PC STA 109+33.53  
Δ = 22'31.24"  
R = 35.00'  
T = 6.97'  
L = 13.76'


See legal document + sketch for location

actually located at 109+00  
Needs repair

GRAPHIC SCALE

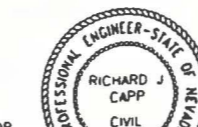

CONFIDENTIAL  
PROPERTY OF KERR-MCGEE CORP.  
MAY NOT BE REPRODUCED, COPIED,  
OR DISTRIBUTED WITHOUT WRITTEN PERMISSION

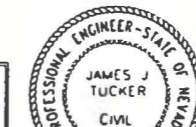

PAPER SIZE  
A

DRAWING NO  
C-011

**KERR-MC GEE CHEMICAL LLC**  
P.O. BOX 55 HENDERSON, NEV. 89009-7000

DESIGN	DATE	APPROVED FOR CONSTRUCTION
DRAWN BY	BY	BY
PROJECT ENGR	PROJECT ENGR	PROJECT ENGR
OPERATIONS MGR	OPERATIONS MGR	OPERATIONS MGR
PRODUCTION BUFT	PRODUCTION BUFT	PRODUCTION BUFT
QUALITY CONTROL	QUALITY CONTROL	QUALITY CONTROL

INLET/OUTLET PIPELINES  
PLAN + PROFILE  
STA 106+00 TO STA 116+00

DATE: 5/1/11



SCALE: AS SHOWN

REVISIONS:  
1. 5/1/11: AS SHOWN  
2. 5/1/11: AS SHOWN

JOB NO. \_\_\_\_\_  
PROJECT: \_\_\_\_\_  
SHEET: \_\_\_\_\_ OF \_\_\_\_\_



Call before you dig

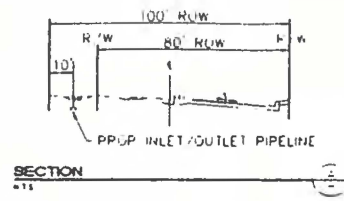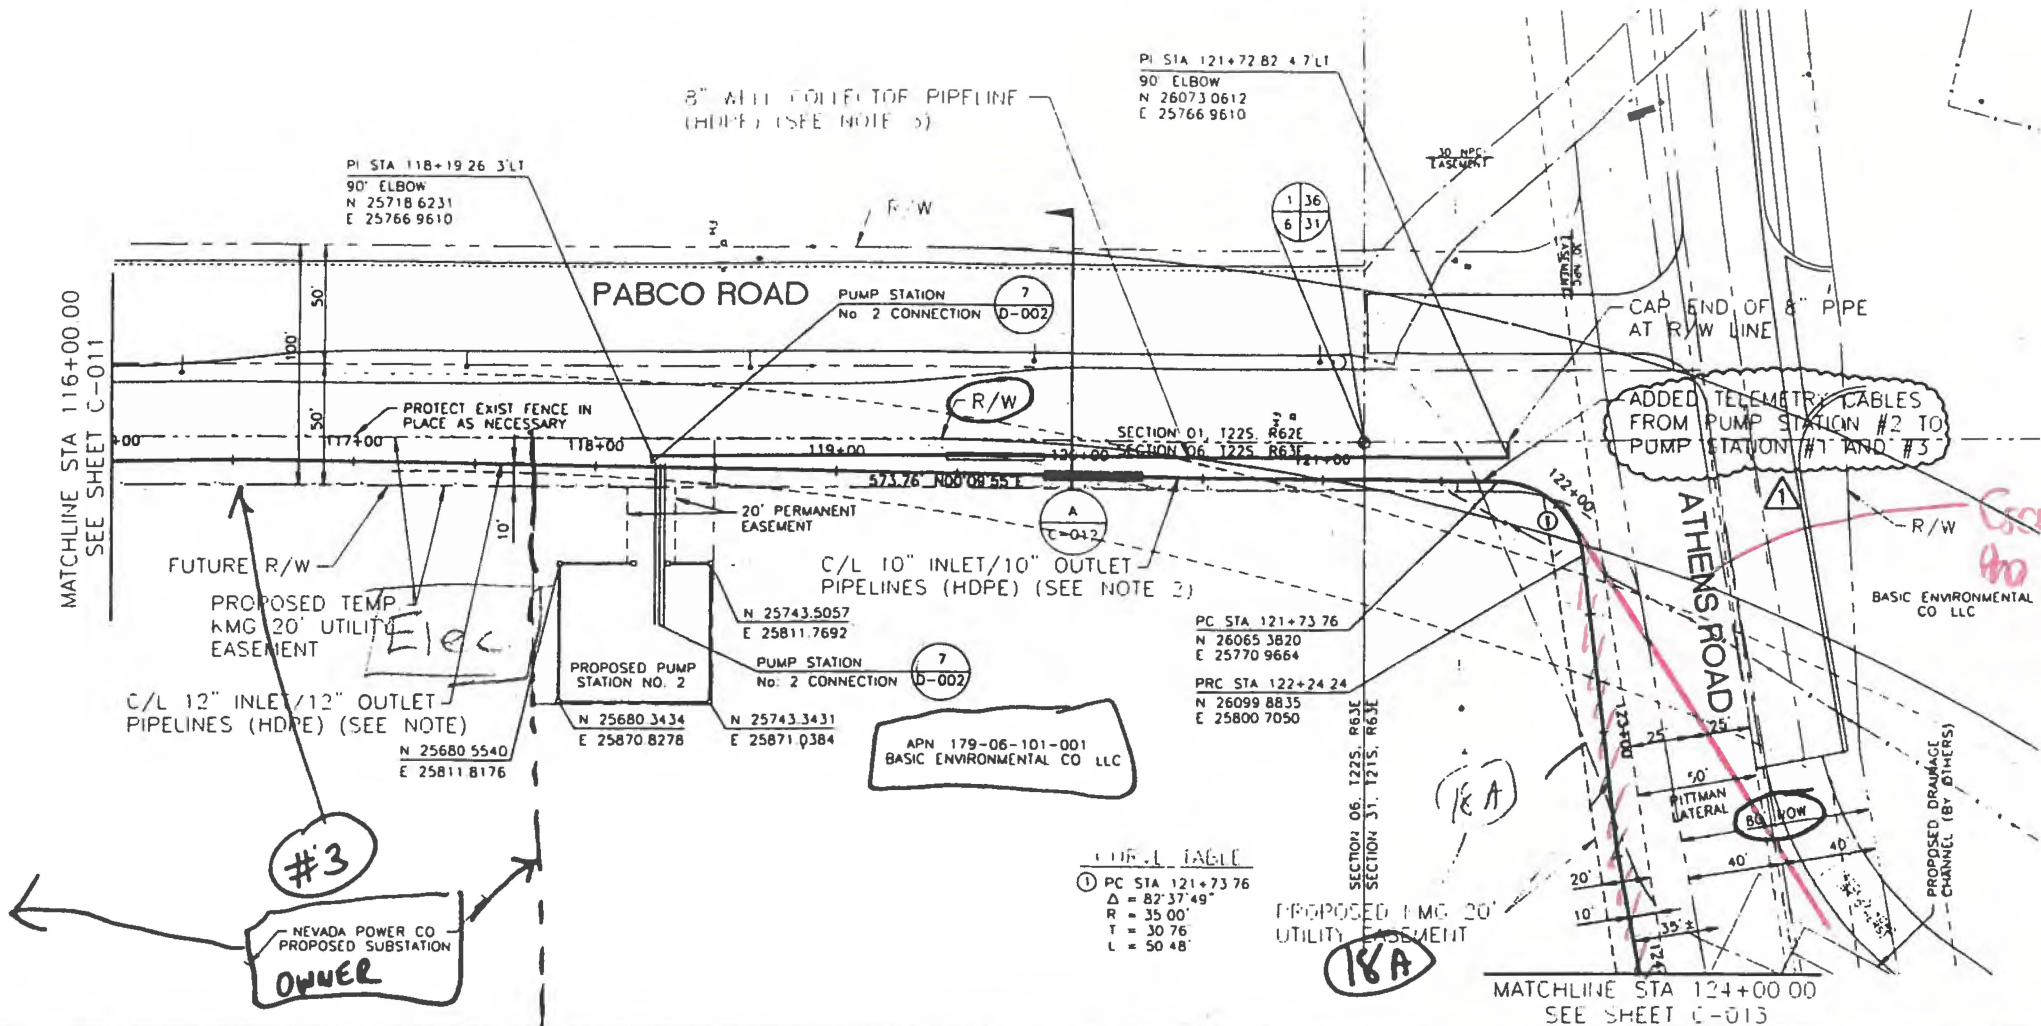


- NOTE
- INSTALL 10" OUTLET PIPELINE 1' WEST OF C/L AND INSTALL 12" INLET PIPELINE 1' EAST OF C/L
  - INSTALL 10" OUTLET PIPELINE 1' NORTH OF C/L AND INSTALL 10" INLET PIPELINE 1' SOUTH OF C/L
  - INSTALL 8" WELL COLLECTOR PIPELINE 2' WEST OF 10" OUTLET PIPELINE IN SAME TRENCH


**#3**  
NEVADA POWER CO  
PROPOSED SUBSTATION  
**OWNER**

**CURVE TABLE**

PC STA	121+73.76
Δ	82°37'49"
R	35.00'
T	30.76'
L	50.48'

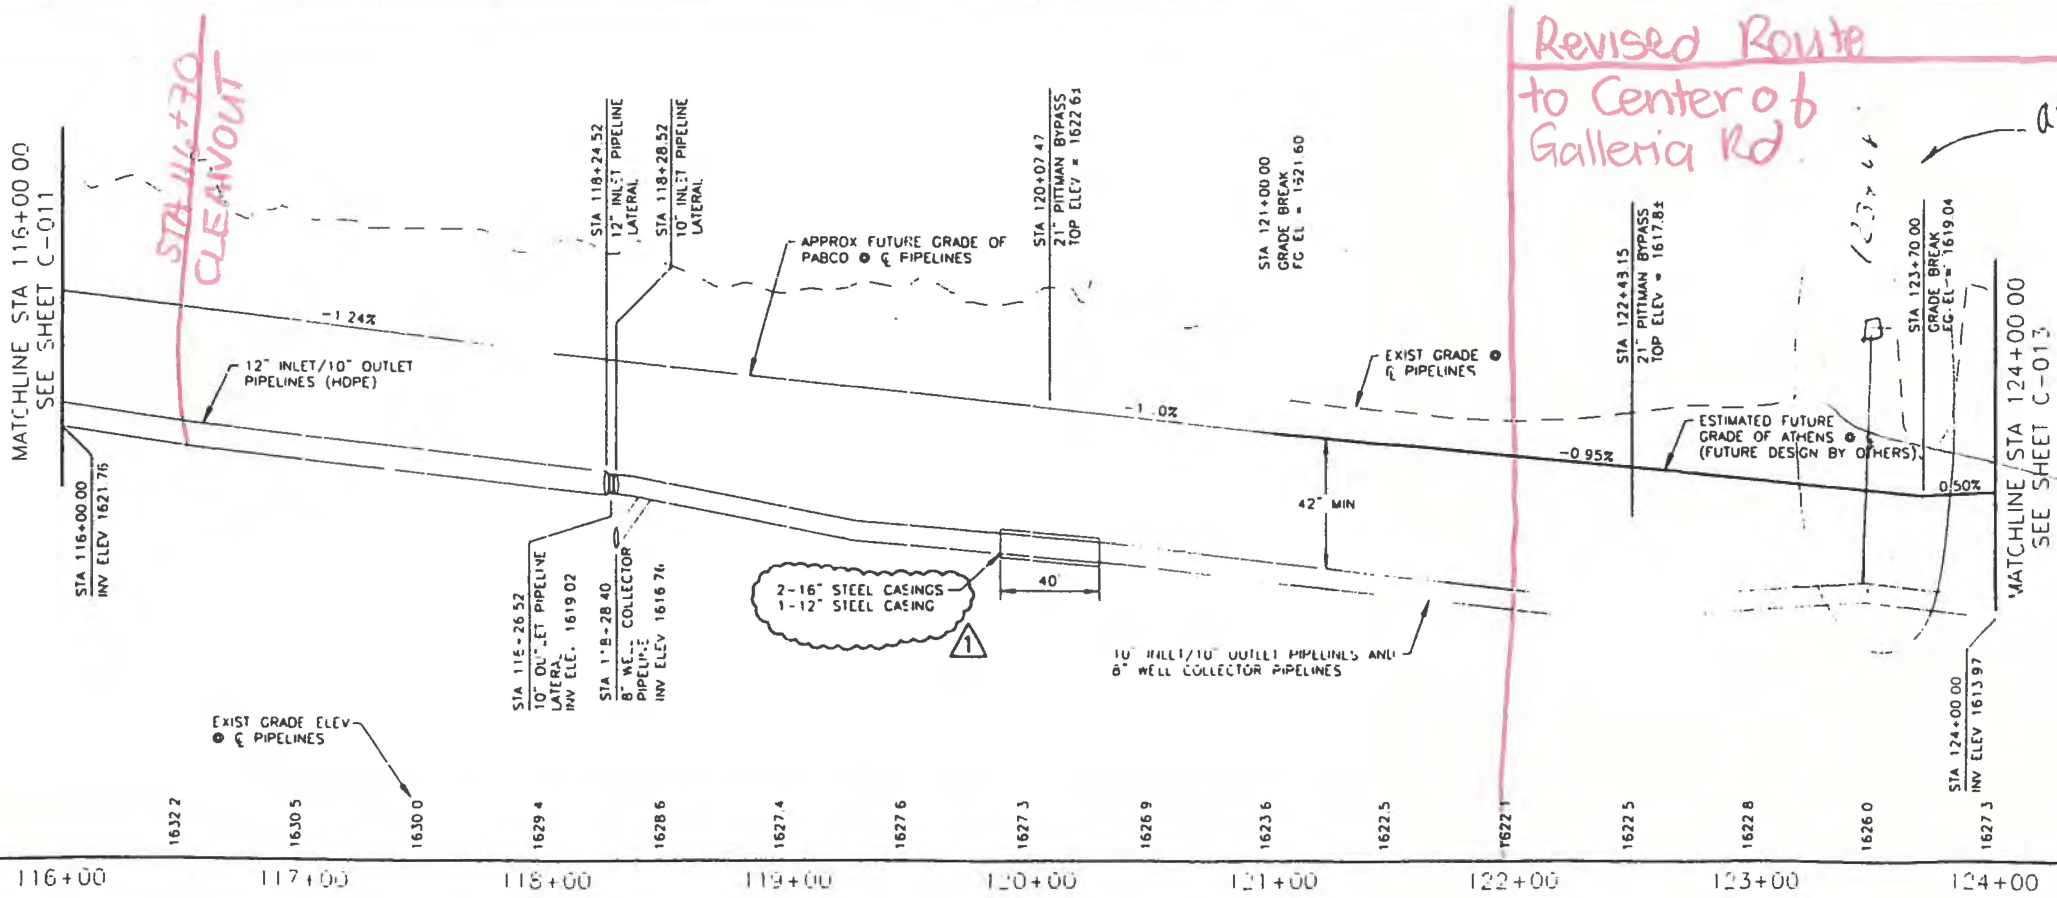

**Revised Route to Center of Galleria Rd**  
ask R camp abk

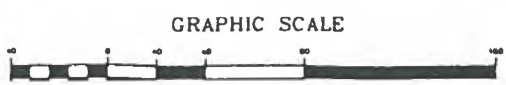

**KERR-MC GEE CHEMICAL LLC**

P.O. BOX 55 HENDERSON, NEV. 89009-7000

DATE: 5/03/01

JOB NO. \_\_\_\_\_

SCALE: AS SHOWN

**INLET/OUTLET PIPELINES PLAN + PROFILE STA 116+00 TO STA 124+00**

DESIGN	DATE	APPROVED FOR CONSTRUCTION	BY	DATE
DESIGN	11/11/01	SAFETY		
DRAWN BY	11/11/01	PROCESS ENGR		
PROJECT ENGR		PROJECT ENGR		
ENVIRONMENTAL		ENVIRONMENTAL		
OPERATIONS ENGR		OPERATIONS ENGR		
PRODUCTION SUPT		PRODUCTION SUPT		
DUTY CONTROL		DUTY CONTROL		


DESIGNER: RICHARD J. CAPP  
PROJECT ENGINEER: JAMES J. TUCKER

CONFIDENTIAL PROPERTY OF KERR-MC GEE CHEMICAL LLC

PAPER SIZE: \_\_\_\_\_ DRAWING NO: \_\_\_\_\_ SHEET: \_\_\_\_\_

Call before you dig



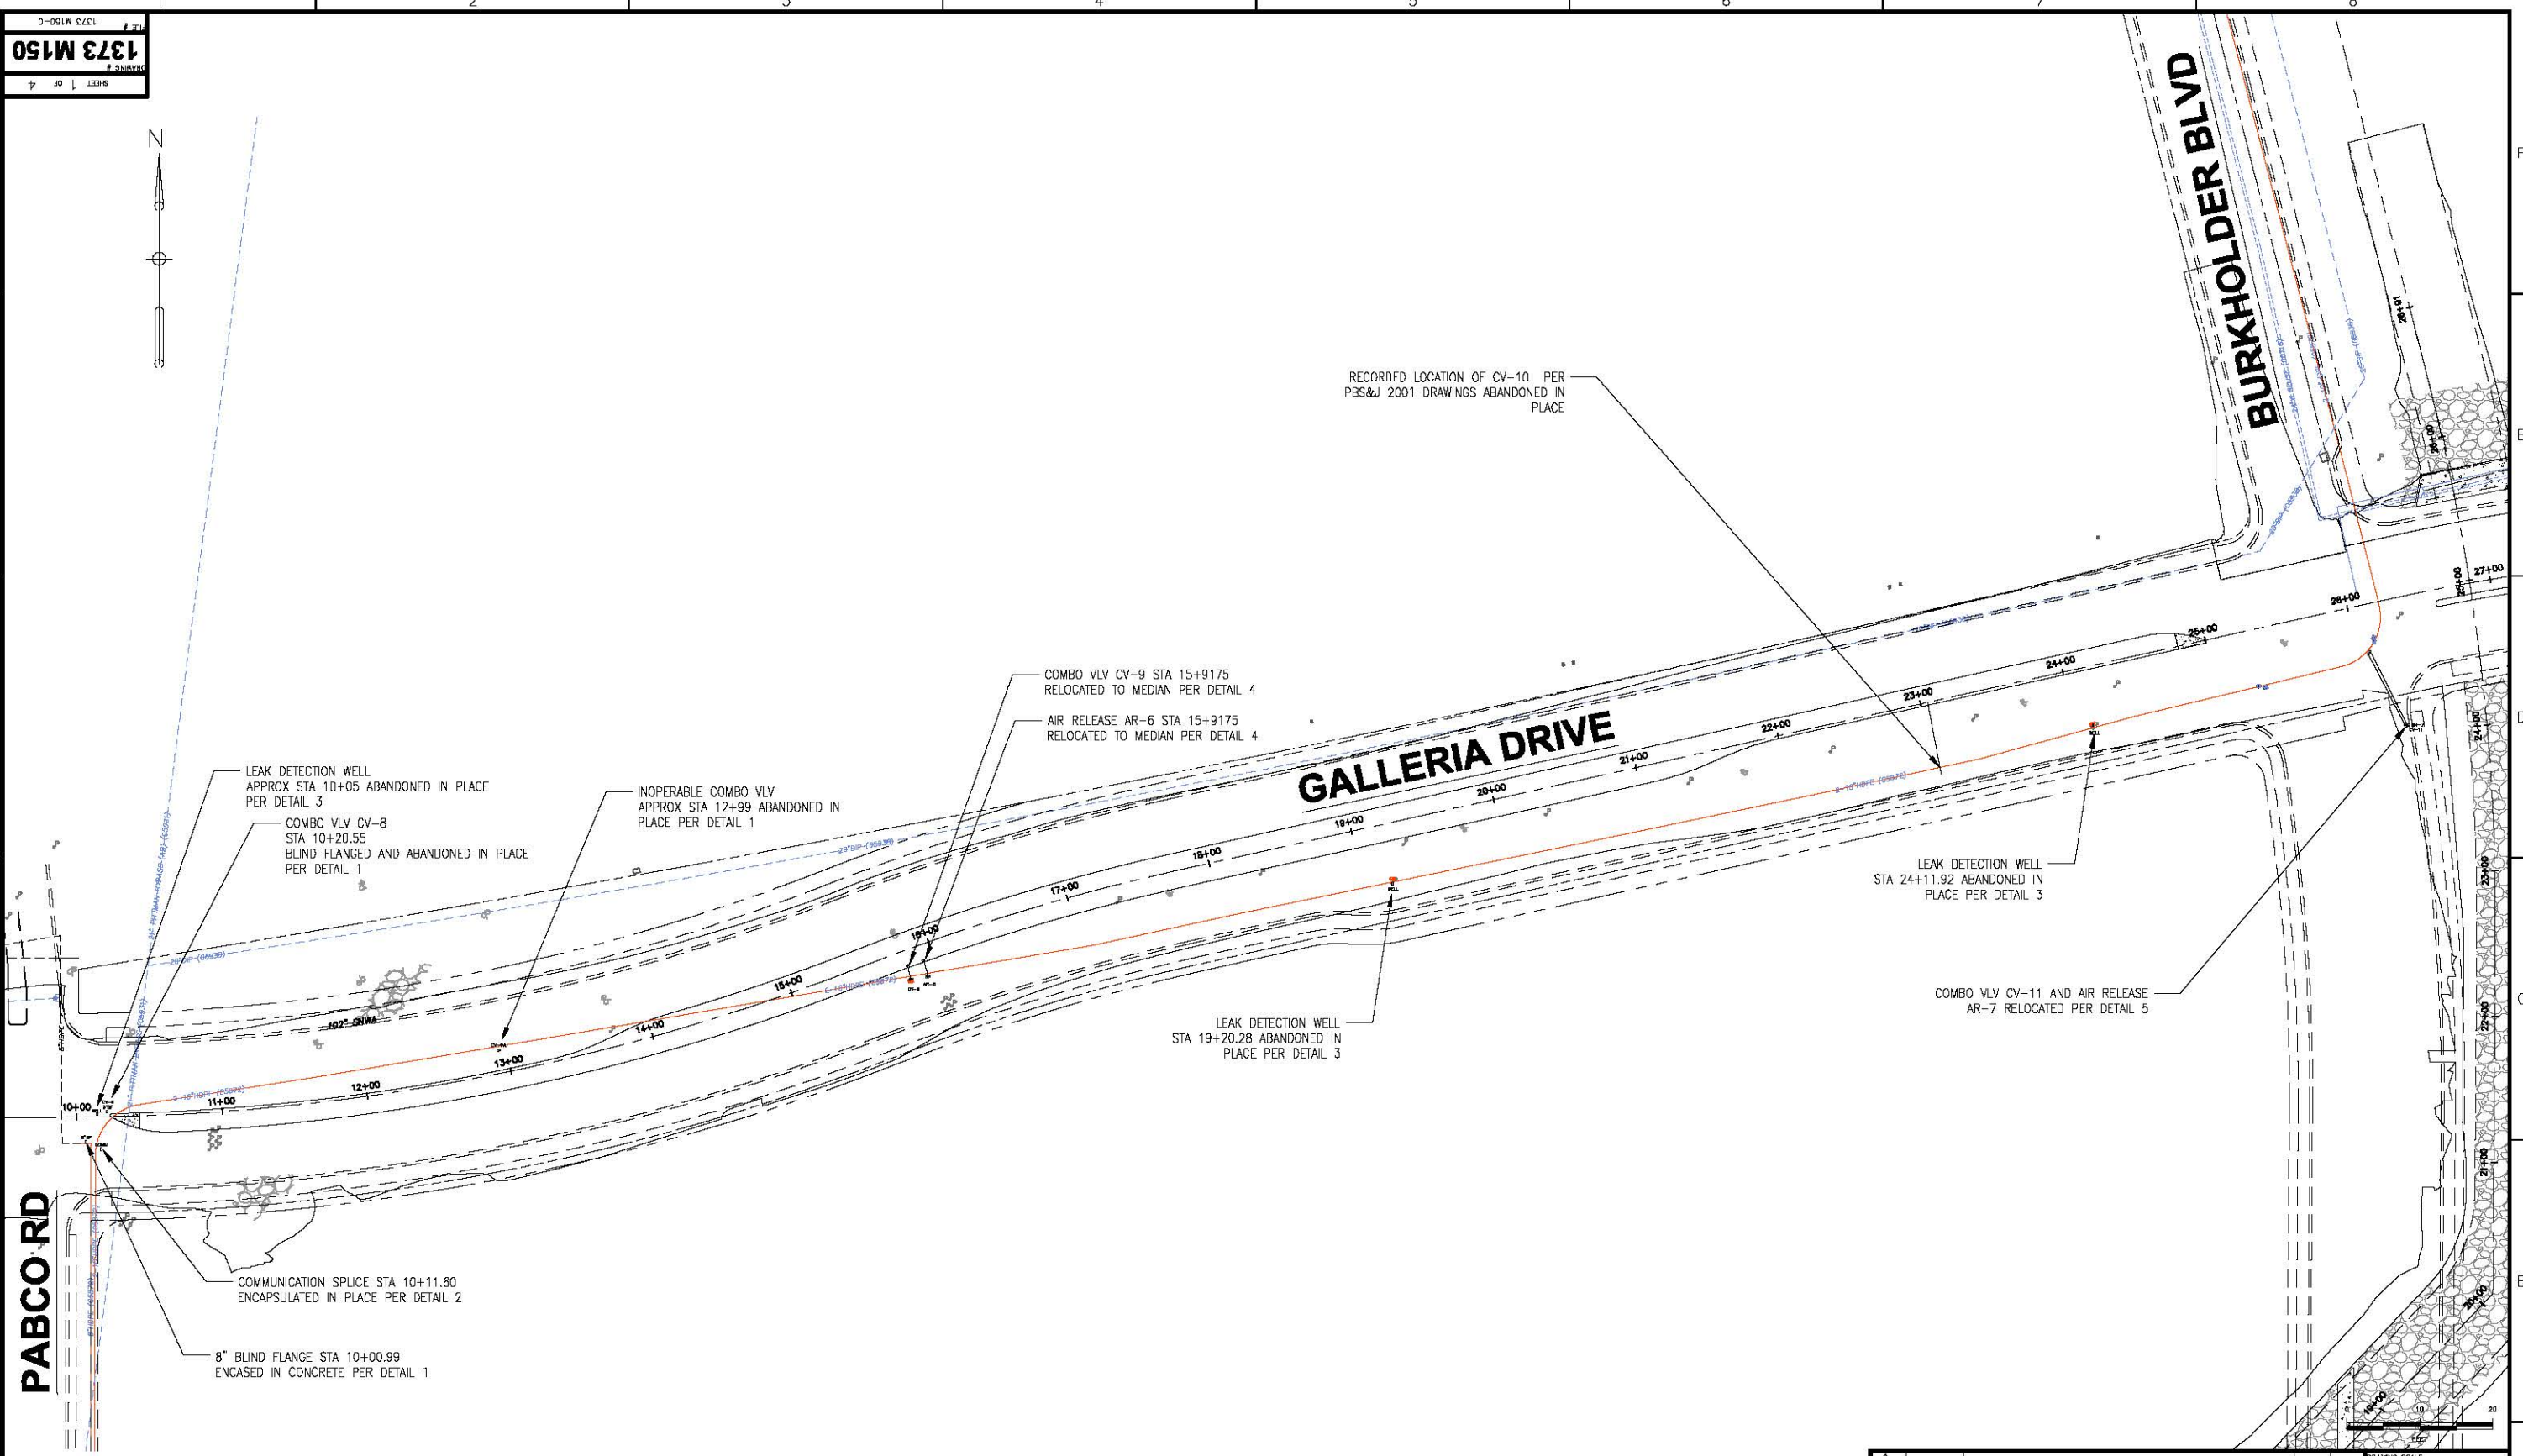

**GENERAL NOTES:**

- SEE SHEETS 2 THRU 4 FOR CONSTRUCTION DETAILS

△									
△	3/18/14	RECORD DRAWING	RL	MDV					
△	2/10/14	ISSUED FOR BID	RL	MDV					
△	2/4/14	ISSUED FOR DISCUSSION	RL						
REV	DATE	DESCRIPTION OF REVISION	REVISION	CHECKED BY	CHECKED BY/DATE				

THIS IS A COMPUTER GENERATED DRAWING AND ONLY EDITS CONSISTENT WITH ENVIROGEN'S ORIGINAL CAD FORMAT SHALL BE CONSIDERED VALID COPIES.

NERT  
HENDERSON, NV

GALLERIA DRIVE IMPROVEMENTS  
VENTING OF PLANT INLET  
AND OUTLET LINES

DRAWING #  
**1373 M150**

FILE #  
1373 M150-0




**ENVIROGEN TECHNOLOGIES**  
260 PHILLIPS BLVD, SUITE 205  
EWING, NJ 08618

A Lifecycle Performance Company

A member of The Amalco Group

ALL INFORMATION CONTAINED ON THIS DOCUMENT IS THE PROPERTY OF ENVIROGEN TECHNOLOGIES, INC. ("ENVIROGEN") AND/OR ITS AFFILIATES. THE DESIGN CONCEPTS AND INFORMATION CONTAINED HEREIN ARE PROPERTY OF ENVIROGEN AND ARE SUBMITTED IN CONFIDENCE. THEY ARE NOT TRANSFERABLE AND MUST BE USED ONLY FOR THE USE AND PROJECT FOR WHICH THE DOCUMENT IS EXPRESSLY SUBMITTED. THEY MUST NOT BE DISCLOSED, REPRODUCED, LOANED OR USED IN ANY OTHER MANNER WITHOUT THE EXPRESS WRITTEN CONSENT OF ENVIROGEN. ENVIROGEN ASSUMES NO RESPONSIBILITY OR LIABILITY FOR THE USE OF THIS DOCUMENT OR THE DESIGN CONCEPTS AND INFORMATION CONTAINED HEREIN FOR ANOTHER PROJECT, OR IN A MANNER THAT DOES NOT RELATE TO THE ORIGINALLY INTENDED USE OF THIS DOCUMENT. IN NO EVENT SHALL THIS DOCUMENT OR THE DESIGN CONCEPTS AND INFORMATION CONTAINED HEREIN BE USED IN ANY MANNER DETRIMENTAL TO THE INTEREST OF ENVIROGEN. THE RIGHTS AND OBLIGATIONS OF ENVIROGEN AND ITS CUSTOMER ARE FURTHER LIMITED BY THE AGREEMENT BETWEEN THEM FOR THIS PROJECT. ALL PATENT AND OTHER RIGHTS ARE RESERVED. ACCEPTANCE OF THE DELIVERY OF THIS DOCUMENT CONSTITUTES AGREEMENT TO THESE TERMS AND CONDITIONS.

LAST EDITED: 3/25/14 BY: RUGGIONE NETWORK PATH: G:\ENVIROGEN\1373-01 - NERT\NERT\1373 M150 - GALLERIA DRIVE IMPROVEMENTS

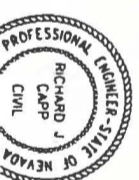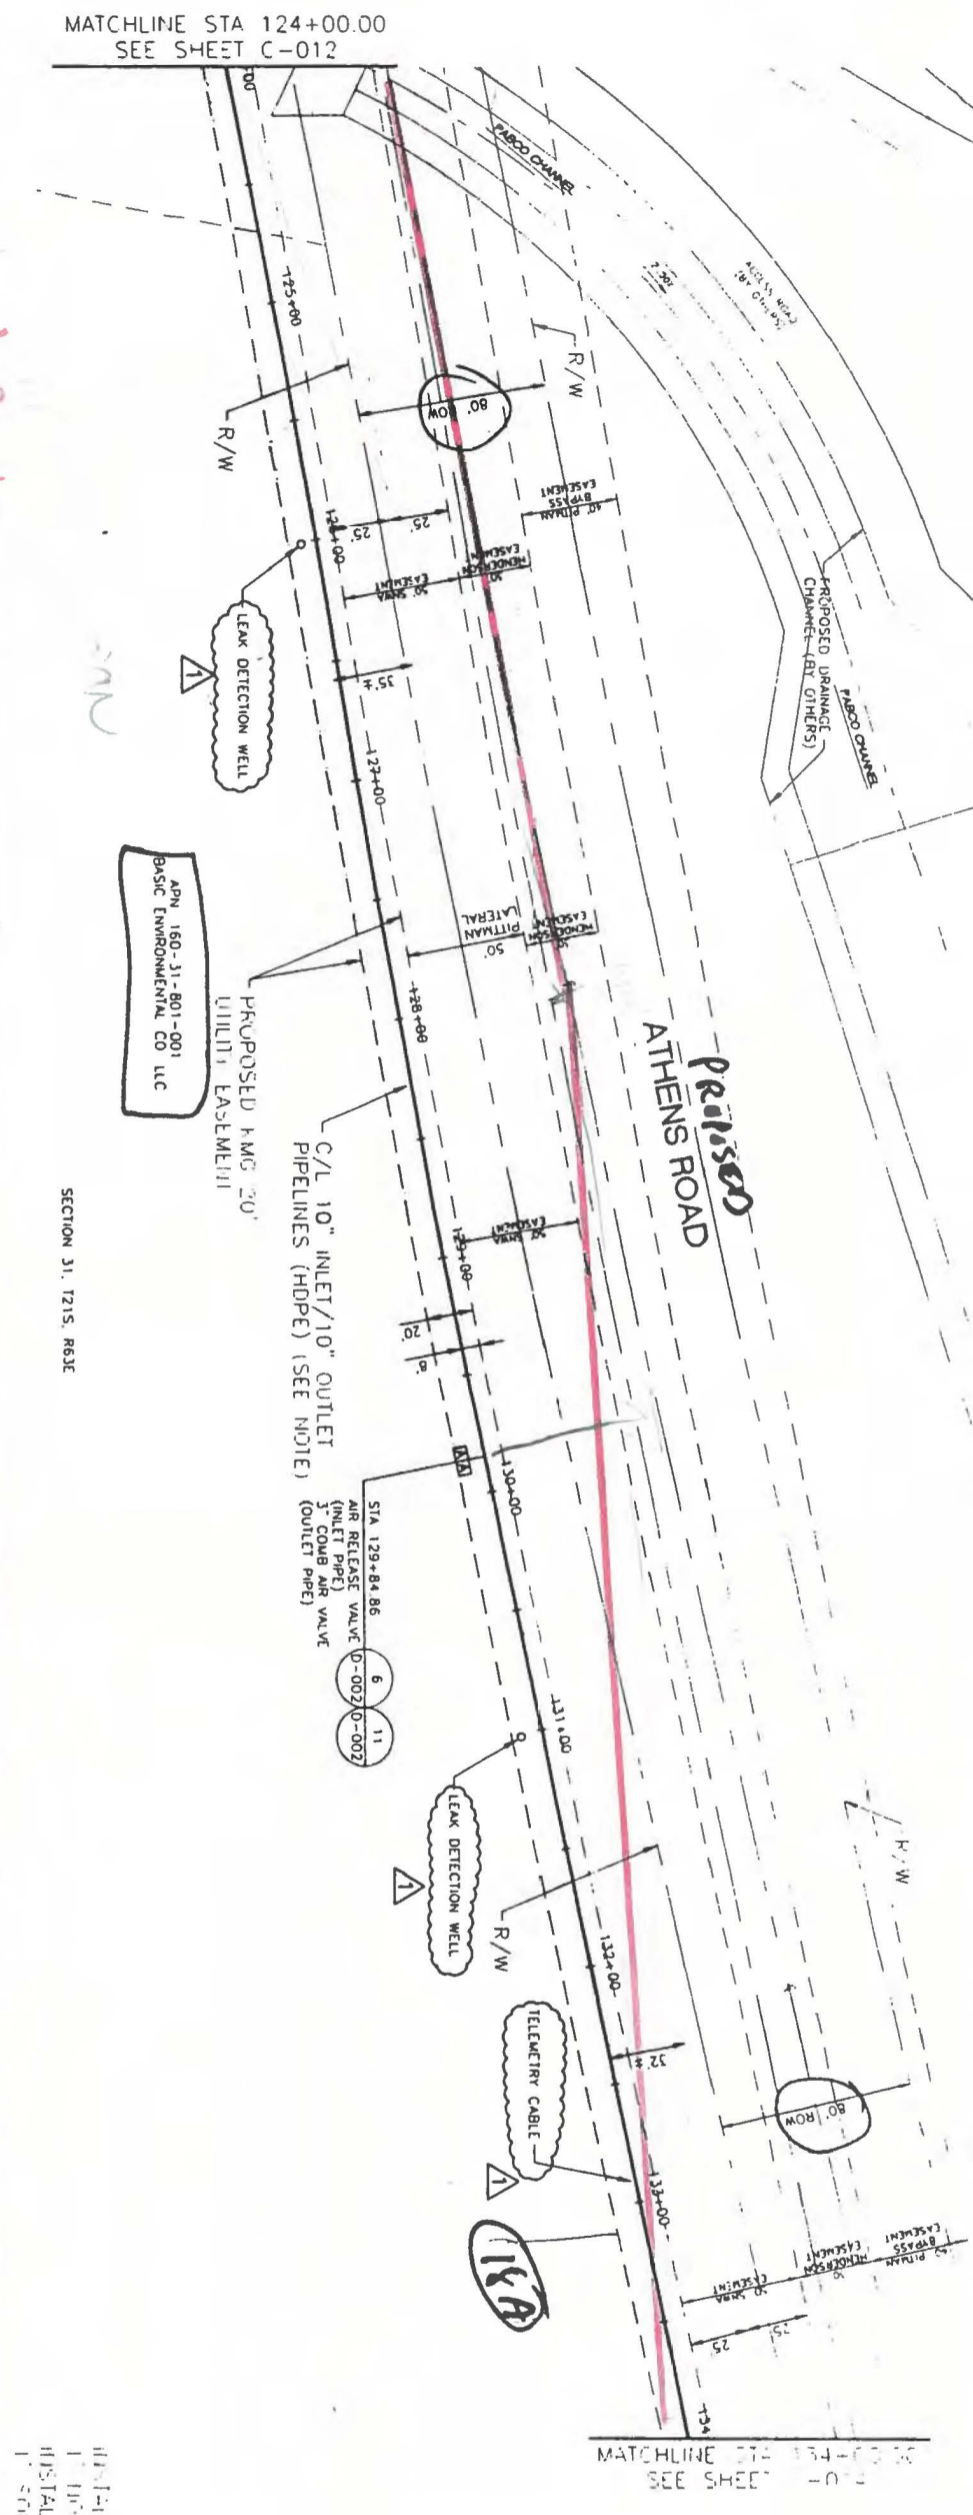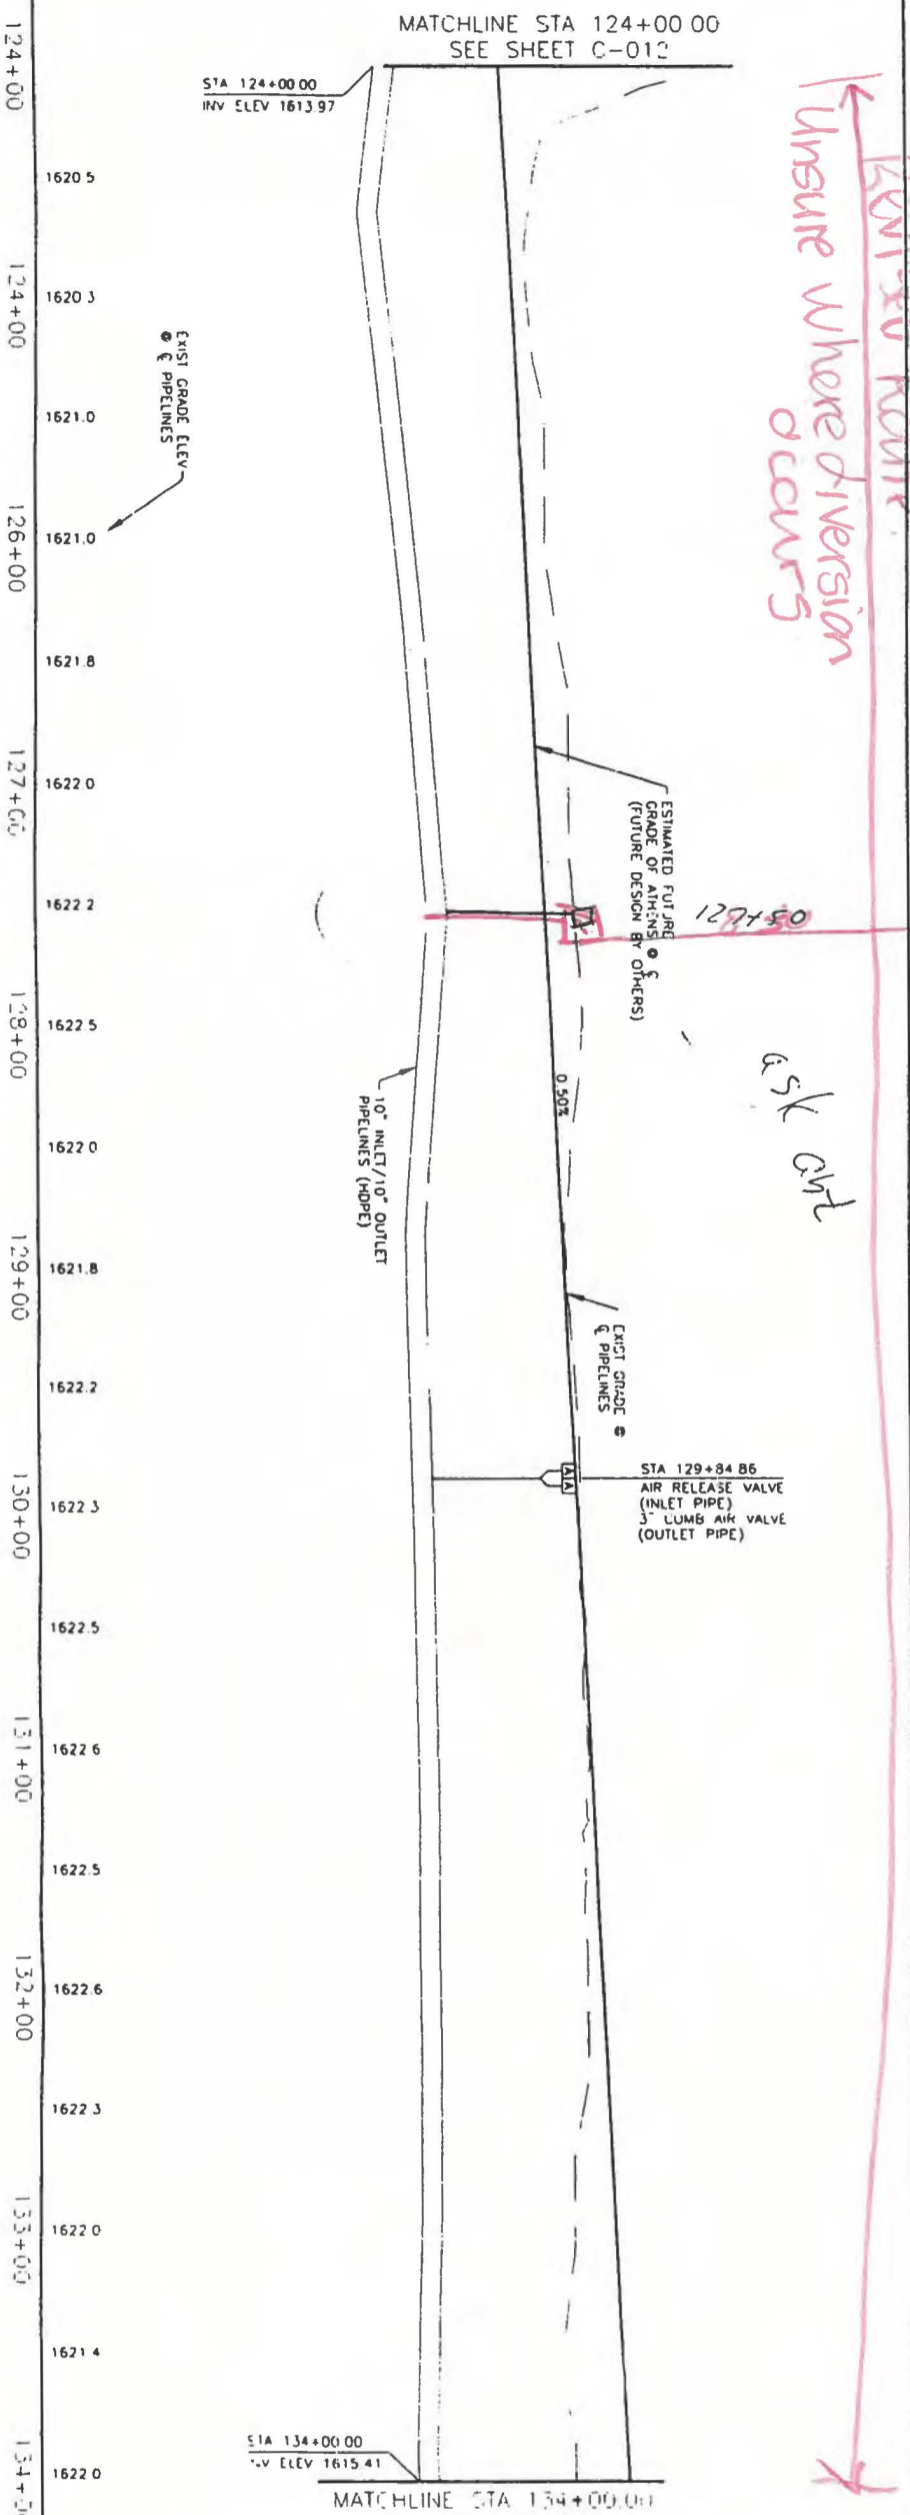


CONFIDENTIAL  
PROPERTY OF KERR-MCGEE CORP.  
MAY NOT BE REPRODUCED, COPIED,  
OR USED FOR ANY PURPOSES WITHOUT



PAPER SIZE: A  
DRAWING NO: C-013

<b>KERR-MC GEE CHEMICAL LLC</b> P.O. BOX 55 HENDERSON, NEV. 89009-7000		TOLERANCE UNLESS OTHERWISE SPECIFIED: FRACTIONS: 1/8" = 0.125"		JOB No. _____	
<b>INLET/OUTLET PIPELINES PLAN + PROFILE STA 124+00 TO STA 134+00</b>			REVISIONS: (LIST ALL CHANGES AND DATE)		
DESIGN DATE: _____		APPROVED FOR CONSTRUCTION: _____		RECORD DRAWINGS: _____	
DRAWN BY: J. ARFO...	PROJ ENGR: J. TUCKER	SAFETY: _____	ENVIRONMENTAL: _____	OPERATIONS MNGR: _____	PRODUCTION Supt: _____
ENGR MNGR: EM SCOFFE	PROCESS ENGR: _____	PROJECT ENGR: _____	ENGR MNGR: _____	PLANT MNGR: _____	QULTY CONTROL: _____
DATE: 5/1/01			SCALE: AS SHOWN		



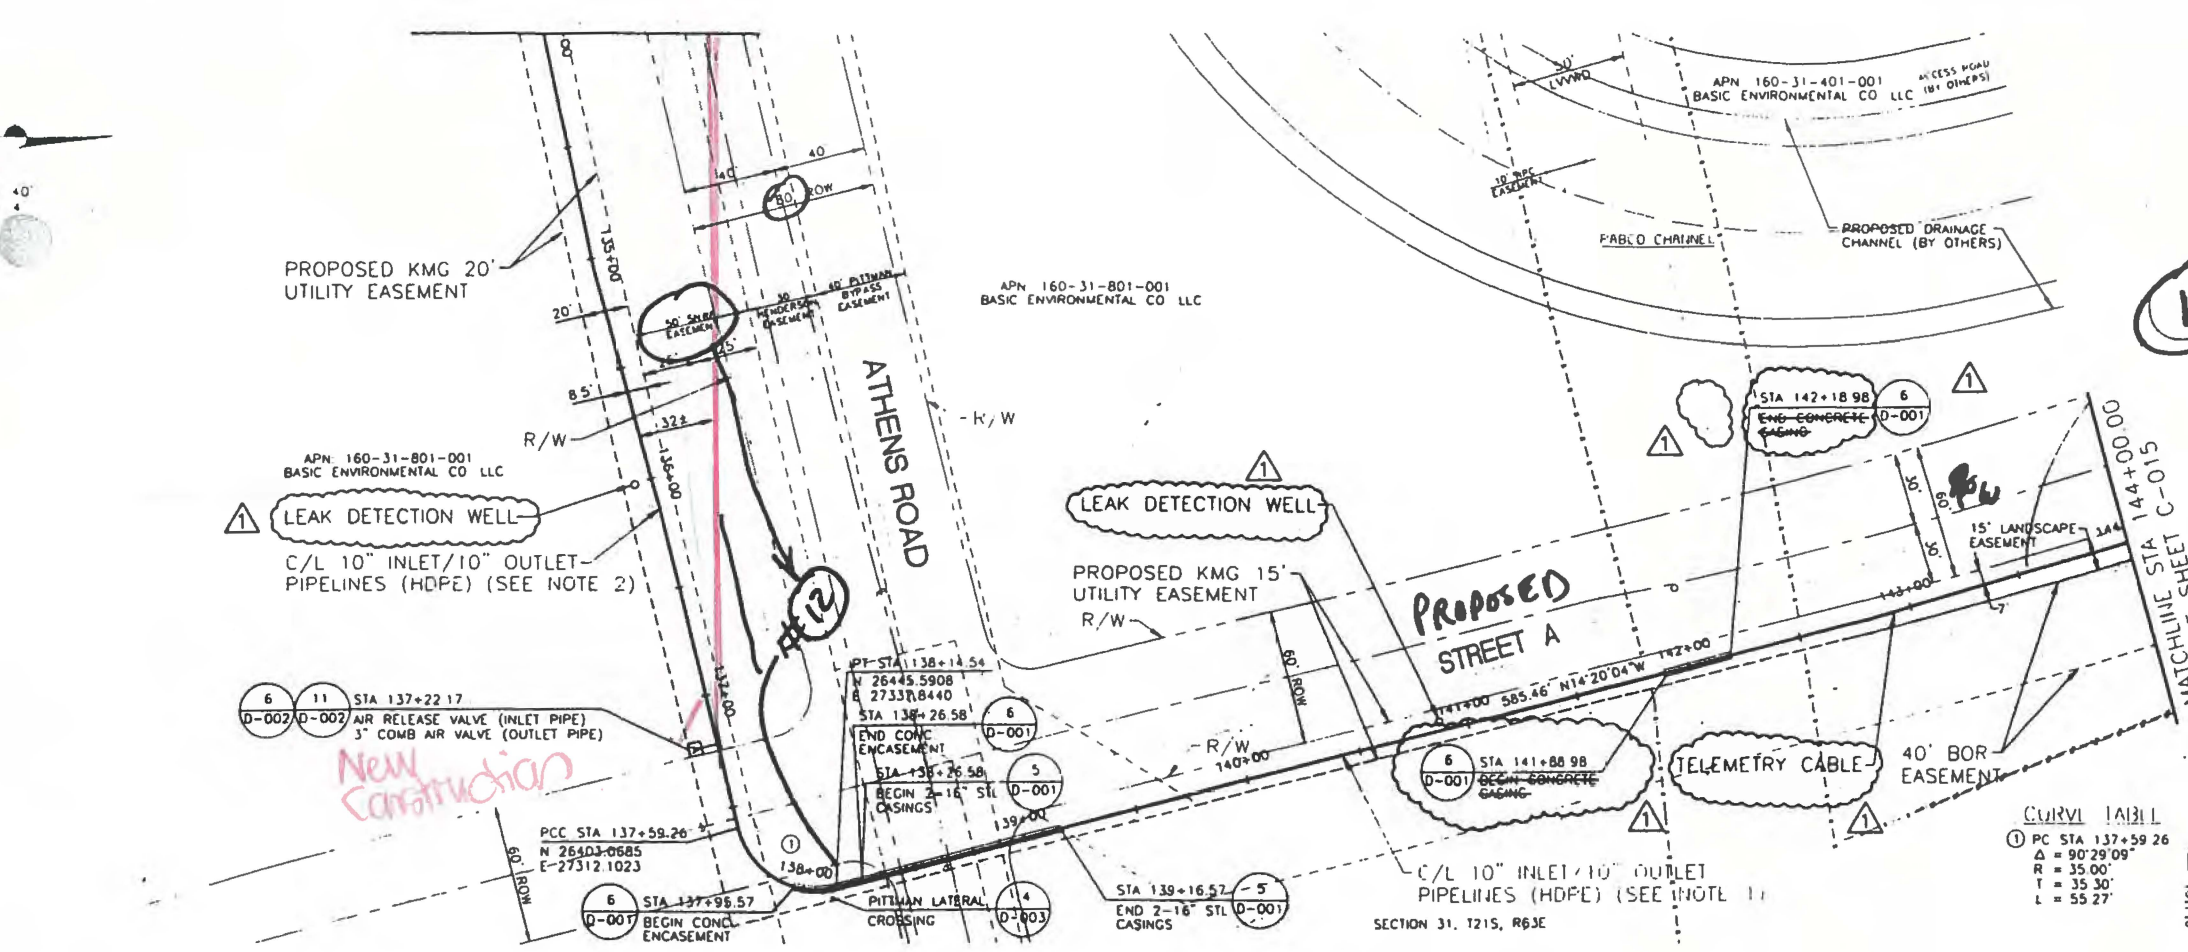

**SNWA CONSTRUCTION NOTE**

CONTRACTOR SHALL FIELD LOCATE AND PROTECT ALL SNWA/SNWS ACCESS APPURTENANCES DURING CONSTRUCTION

CONTRACTOR WILL APPROPRIATELY ADJUST ALL SNWA ABOVE GROUND STRUCTURES AND AT GRADE STRUCTURES TO NEW GRADE AT CONTRACTOR'S EXPENSE CONTRACTOR TO NOTIFY RICK DUSEK AT (702) 567-2301 AT LEAST 48-HOURS PRIOR TO CONSTRUCTION ACTIVITY WITHIN LIMITS OF SNWA/SNWS FACILITIES

SNWA SIGNATURE \_\_\_\_\_ DATE \_\_\_\_\_

NOTE

1 INSTALL 10" OUTLET PIPELINE 1' WEST OF C/L AND INSTALL 10" INLET PIPELINE 1' EAST OF C/L

2 INSTALL 10" OUTLET PIPELINE 1' NORTH OF C/L AND INSTALL 10" INLET PIPELINE 1' SOUTH OF C/L

KERR-MC GEE CHEMICAL LLC

P.O. BOX 55 HENDERSON, NEV. 89009-7000

JOB No. \_\_\_\_\_

SCALE: 1" = 40'

DATE: 5/31/11

INLET/OUTLET PIPELINES PLAN + PROFILE STA 134+00 TO STA 144+00

RECORD DRAWINGS

DATE: 10/18/11

CLL 10/18


JOB NO. \_\_\_\_\_

DESIGN	DATE	APPROVED FOR CONSTRUCTION
DRAWN BY J. ARF.	05/11/11	PROCESS ENGR
PROJ. ENGR J.J. TUDRUP		PROJECT ENGR
ENGR. MGR. L.M. SPACE		ENGR. MGR.
OPERATIONS SUPV. J. W. ...		PLANT MGR.
UTILITY CONTROL		

JOB NO. \_\_\_\_\_


DATE: 10/18/11

CLL 10/18

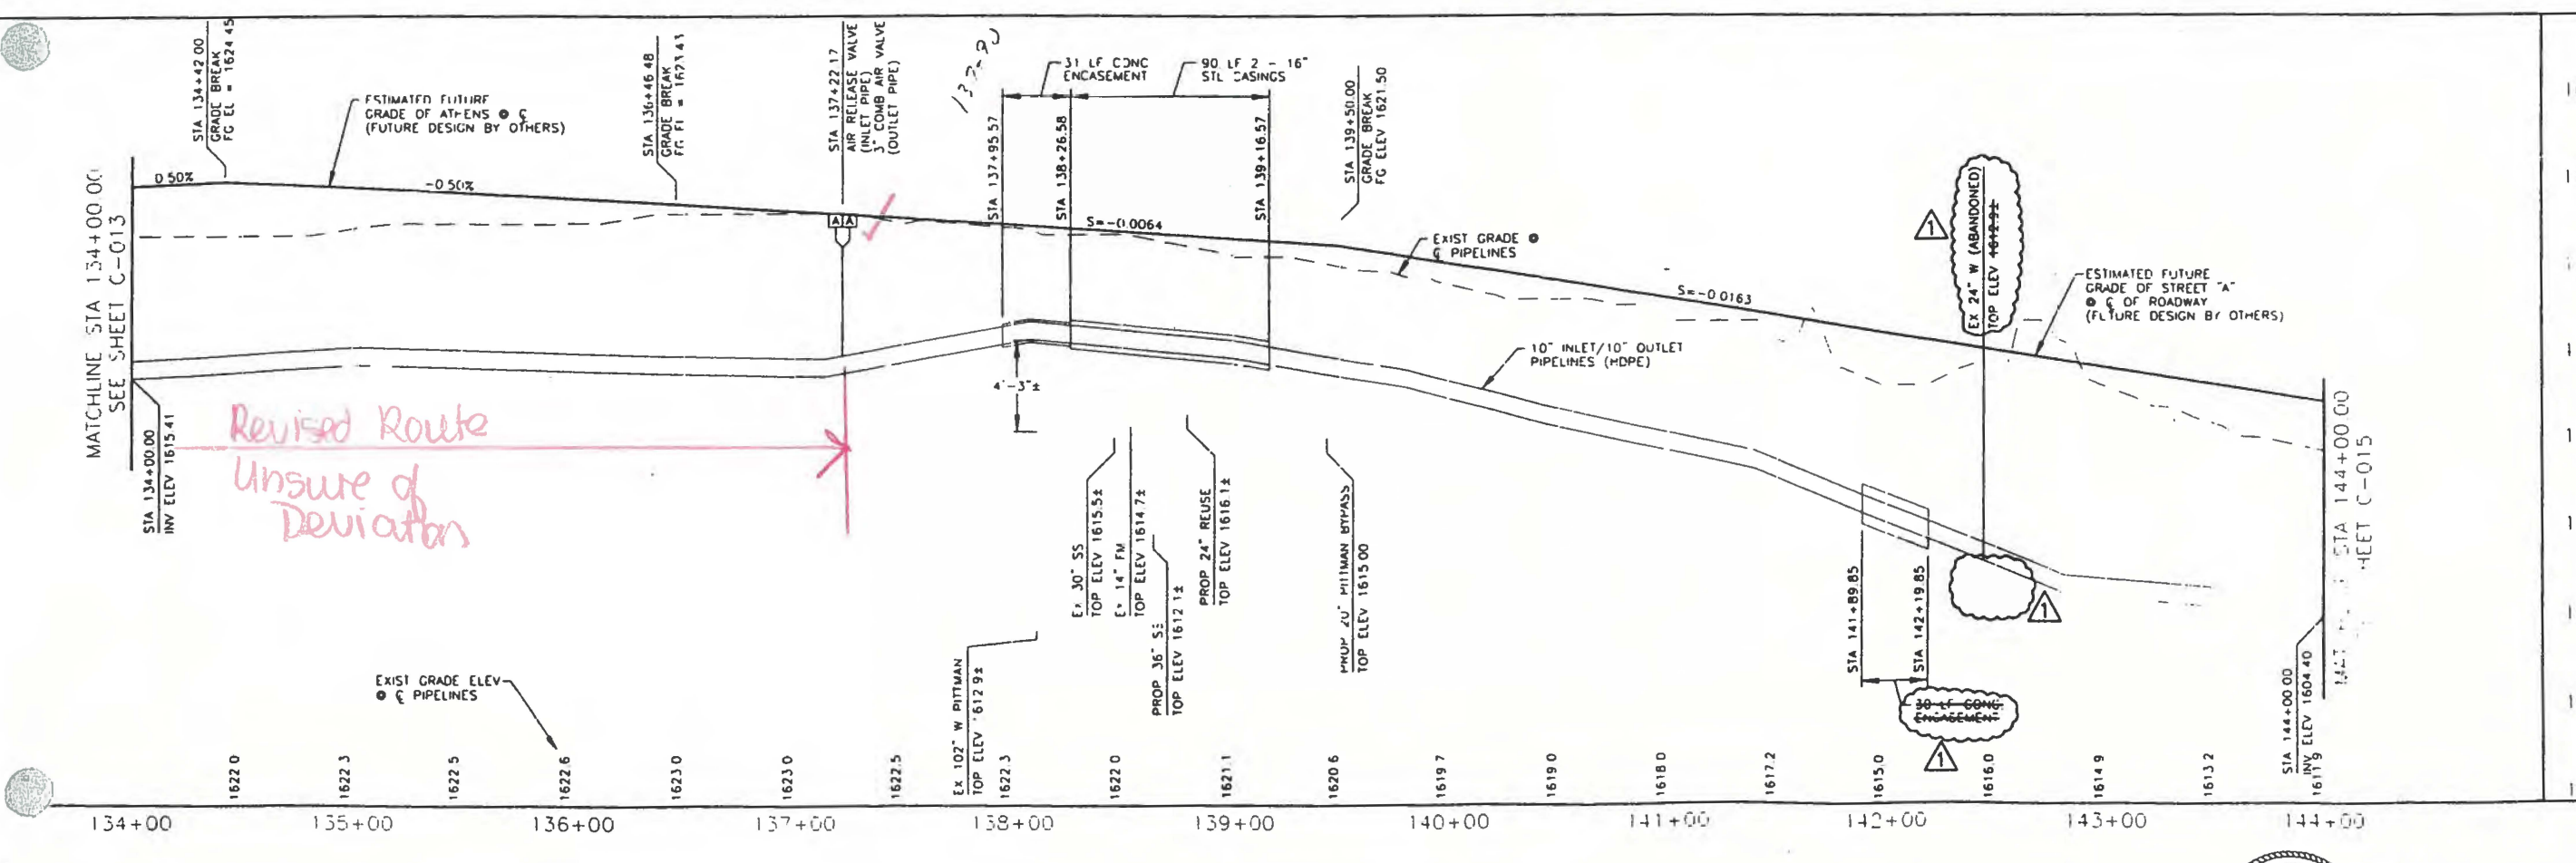


APN 160-31-101-001  
BASIC ENVIRONMENTAL CO. LLC

CURVE TABLE	CURVE TABLE	CURVE TABLE
① PC STA 144+33.85 Δ = 8°39'47" R = 2101.0' T = 35.30' L = 317.68'	② PRC STA 147+51.53 Δ = 9°59'37" R = 1820.72' T = 159.19' L = 317.57'	③ PCC STA 150+69.11 Δ = 18°52'40" R = 999.23' T = 166.12' L = 329.23'

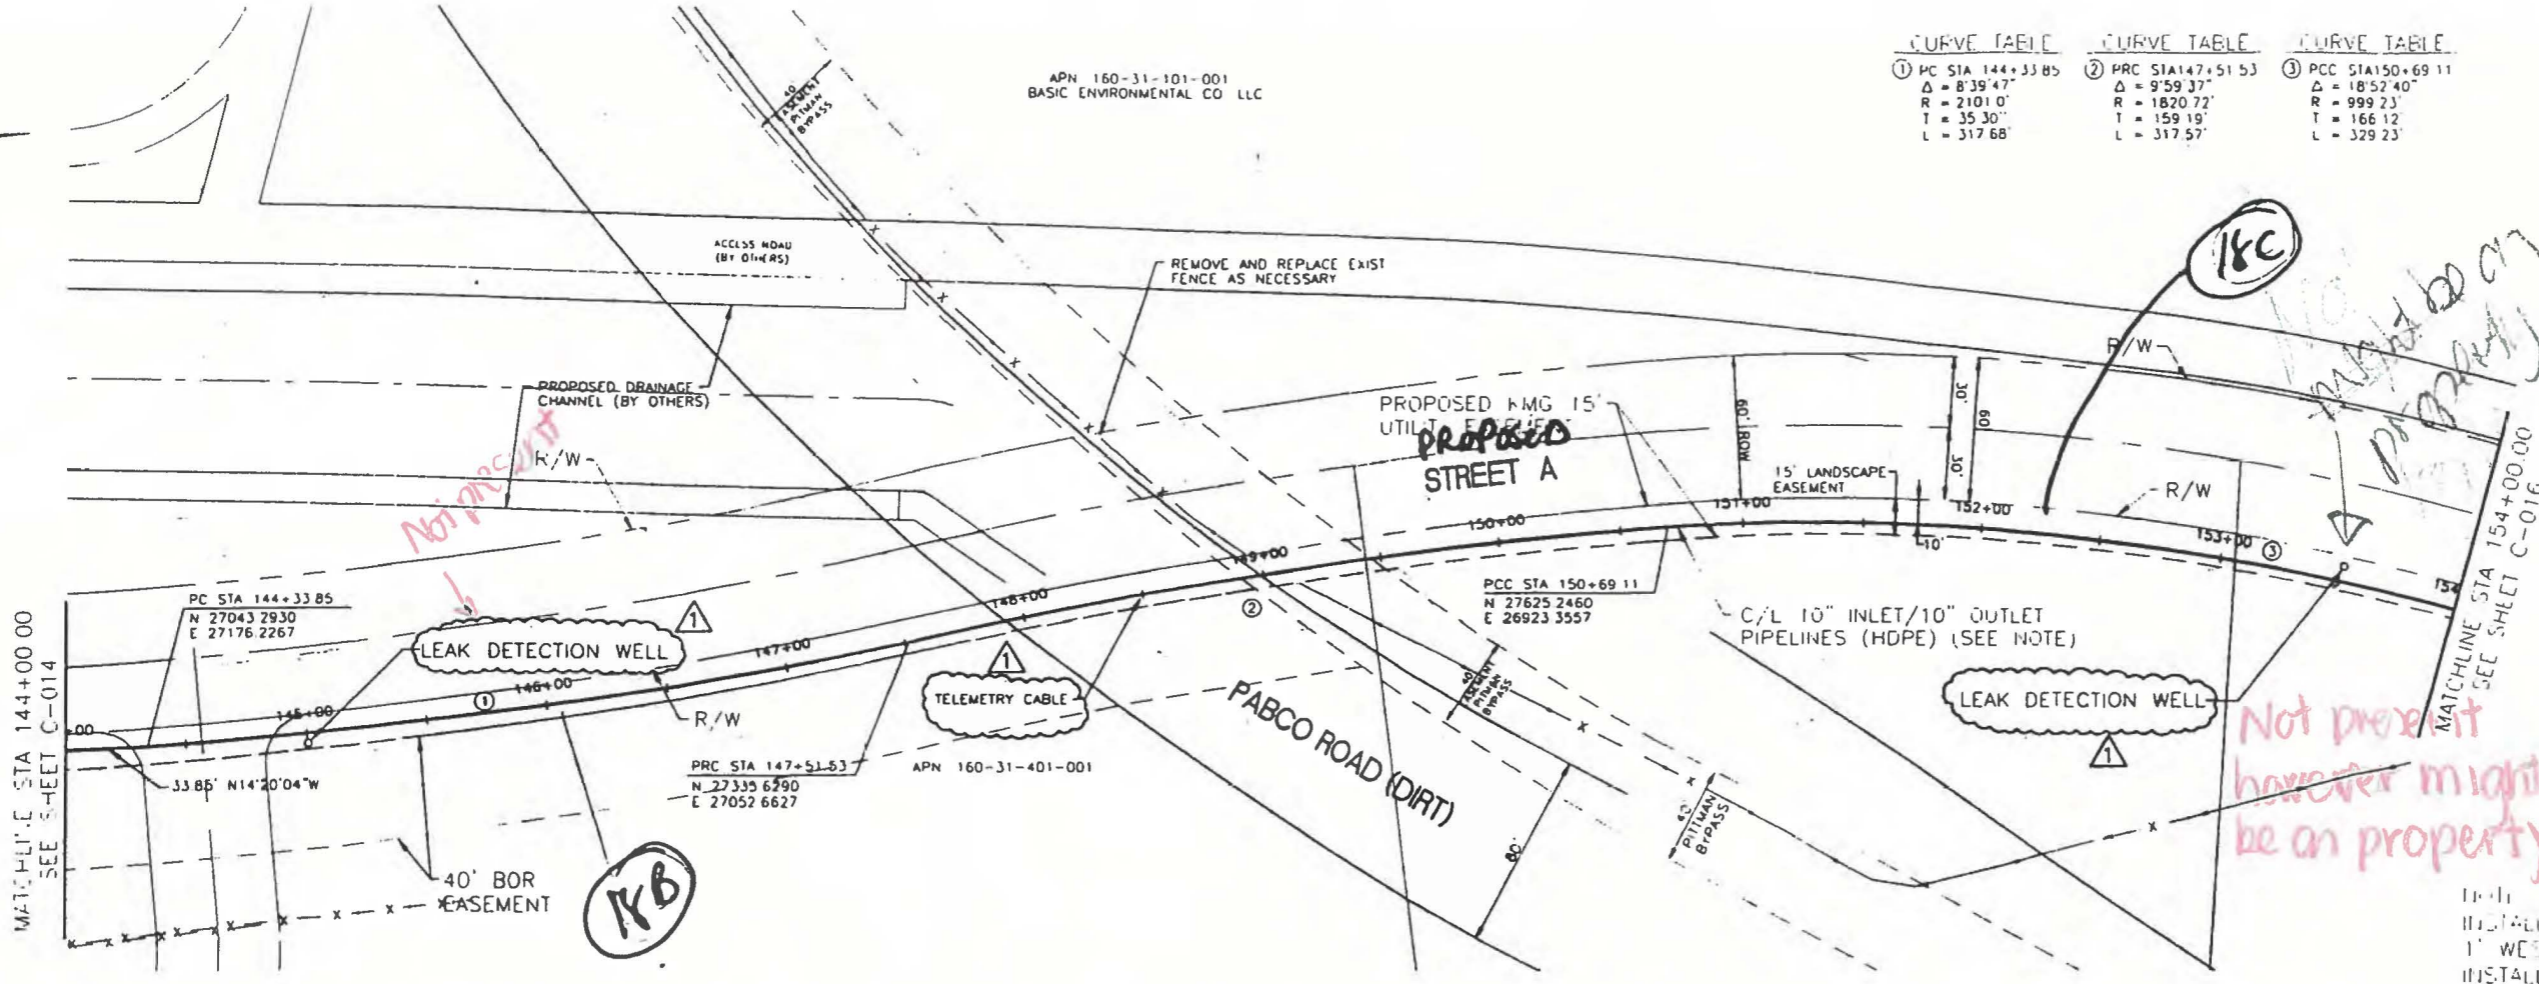

*Not present however might be on property*

INSTALL 10" OUTLET PIPELINE 1' WEST OF C/L AND  
INSTALL 10" INLET PIPELINE 1' EAST OF C/L

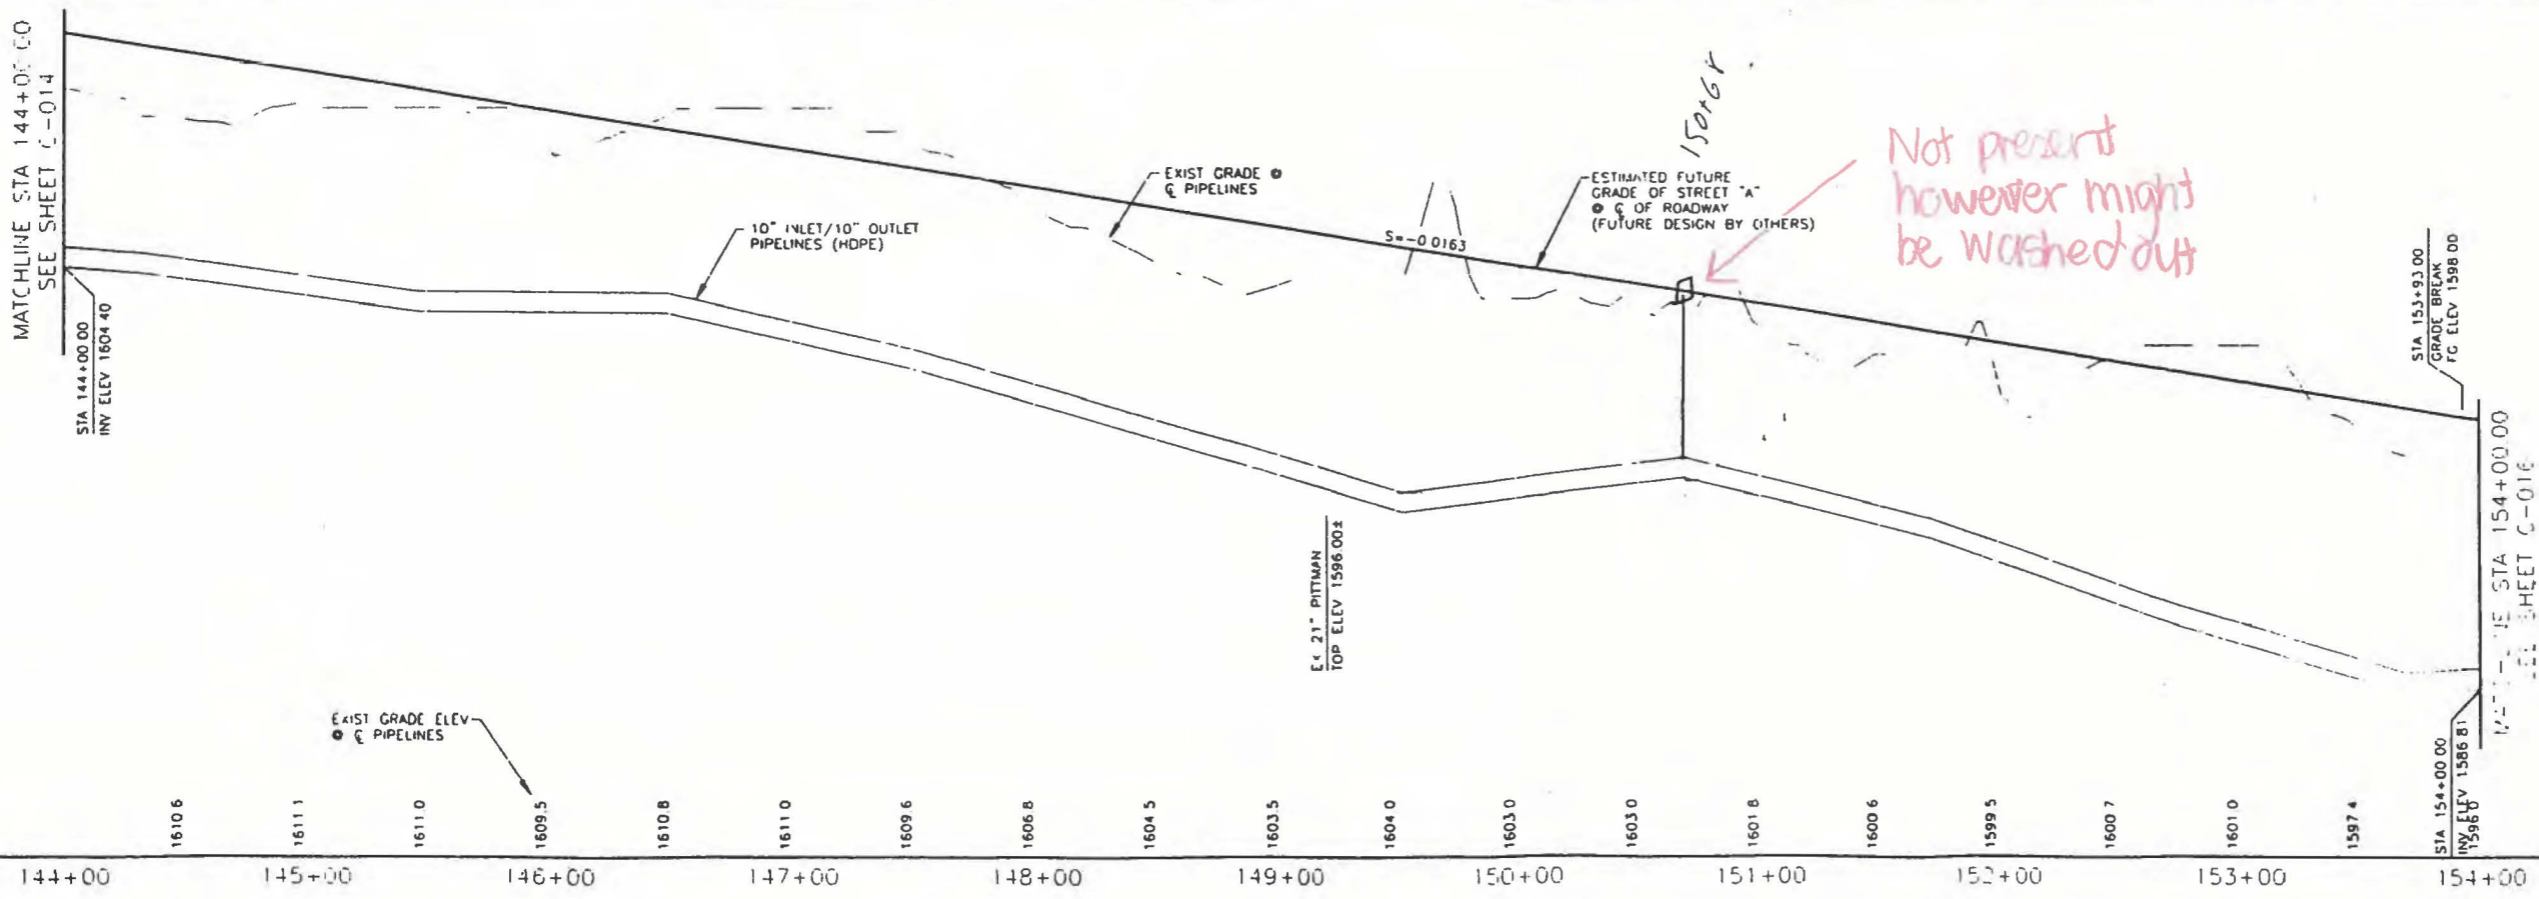

*Not present however might be washed out*

**KERR-MC GEE CHEMICAL LLC**

P.O. BOX 55 HENDERSON, NEV 89009-7000

DATE: 5/21/16

SCALE: 1" = 40'

JOB NO. \_\_\_\_\_

REVISIONS:


NO.	DATE	DESCRIPTION

RECORDED DRAWINGS

INLET/OUTLET PIPELINES  
PLAN + PROFILE  
STA 144+00 TO STA 154+00


DESIGN	DATE	APPROVED FOR CONSTRUCTION
SAFETY		
ENVIRONMENTAL		
OPERATIONS		
PRODUCTION		
UTILITY CONTROL		

DESIGNED BY: J. ARP...  
DRAWN BY: J. TU...  
CHECKED BY: E.M. SP...  
PROJECT ENGR: J. TU...  
PRODUCTION ENGR: J. TU...  
PLANT ENGR: J. TU...

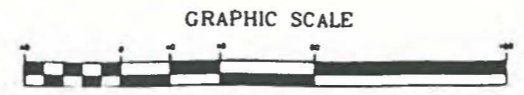

RICHARD J. CAPP RESPONSIBILITY FOR THESE PLANS INCLUDES ALL BUBBLED CHANGES AND CHANGES NOTED IN REVISION BLOCK

CONFIDENTIAL  
PROPERTY OF KERR-MCGEE CORP.  
MAY NOT BE REPRODUCED, COPIED

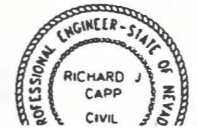

PAPER SIZE  
A

DRAWING NO.  
C-015



SHEET  
10  
10

Call before you dig



Δ = 12' 34.35  
 R = 999.23  
 T = 110.11  
 L = 219.33

1 EAST OF C/L

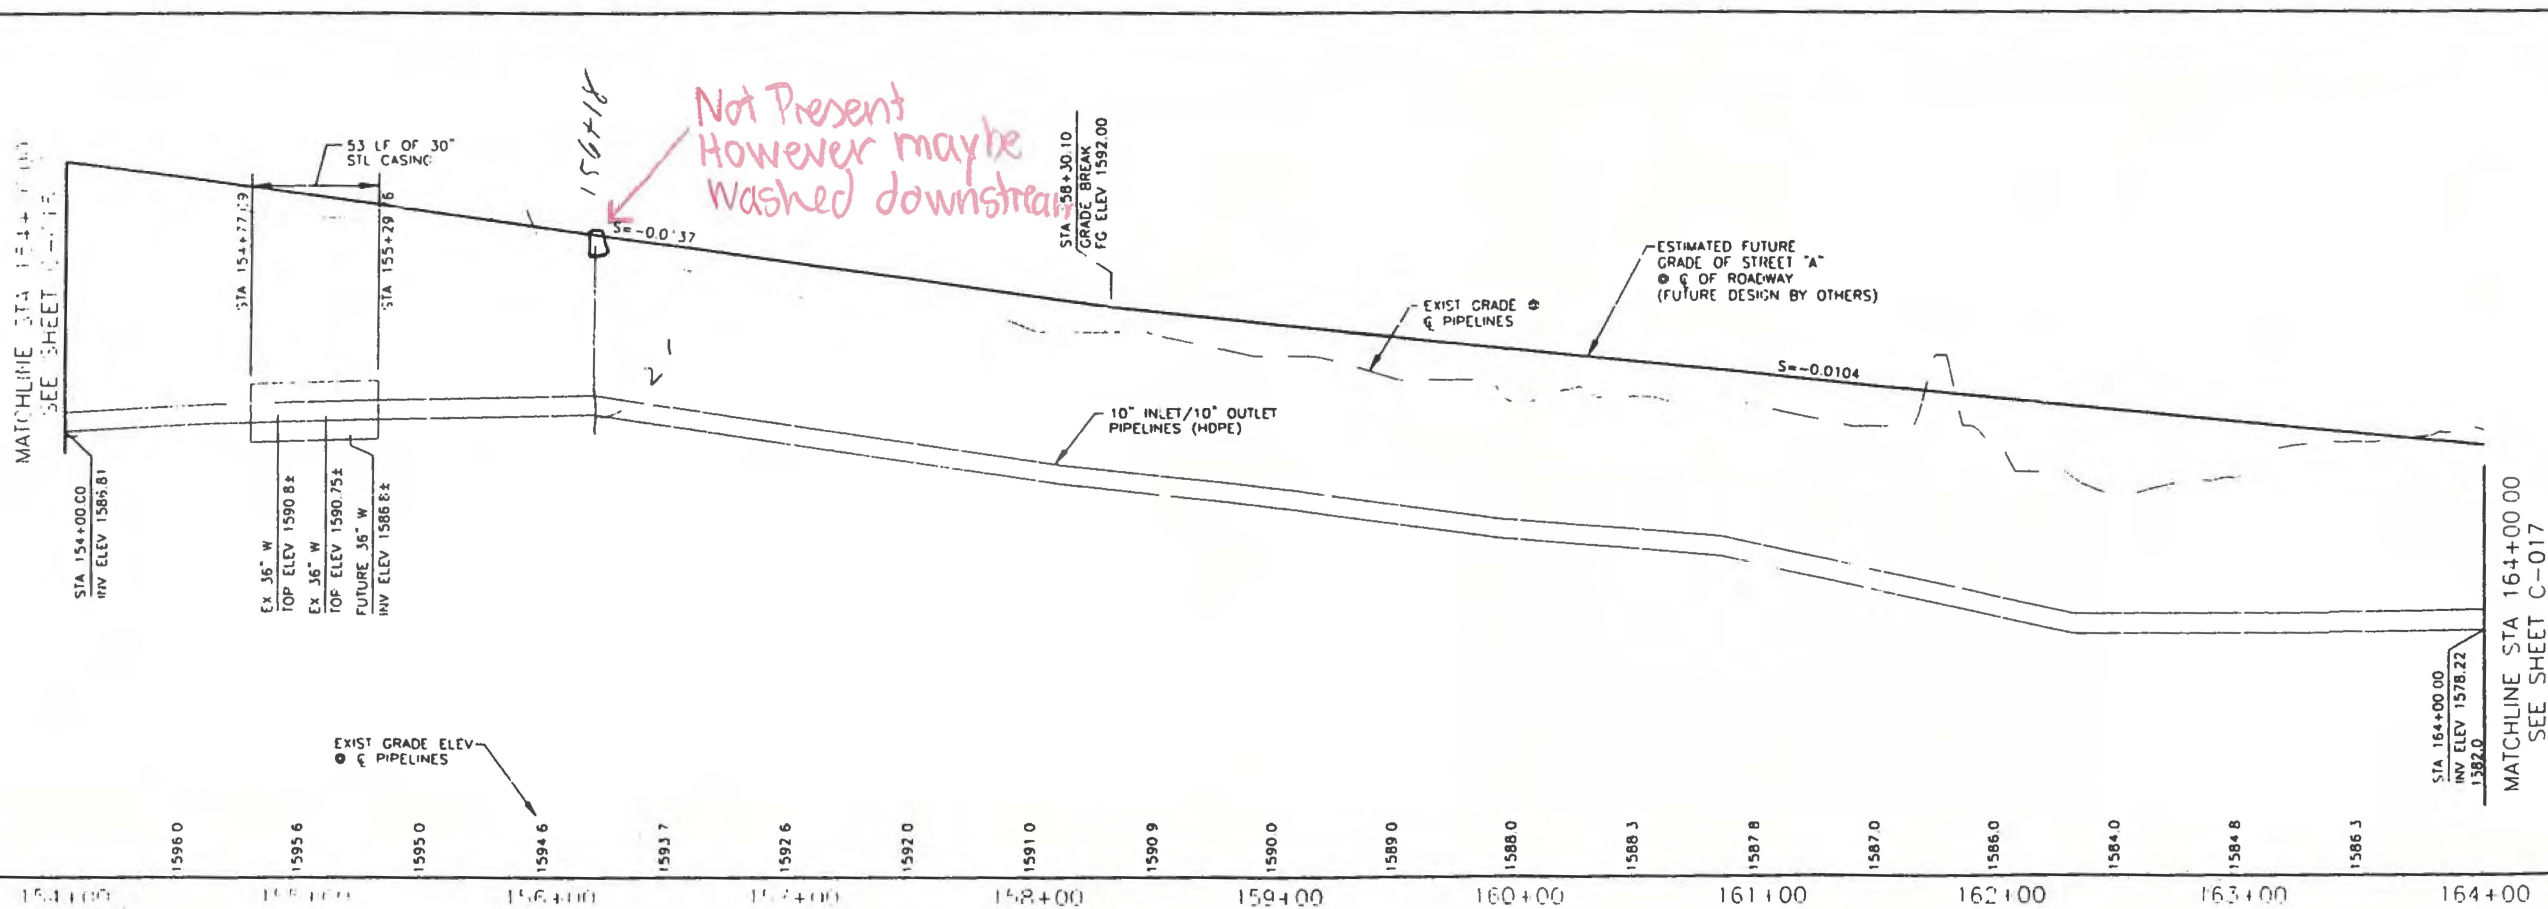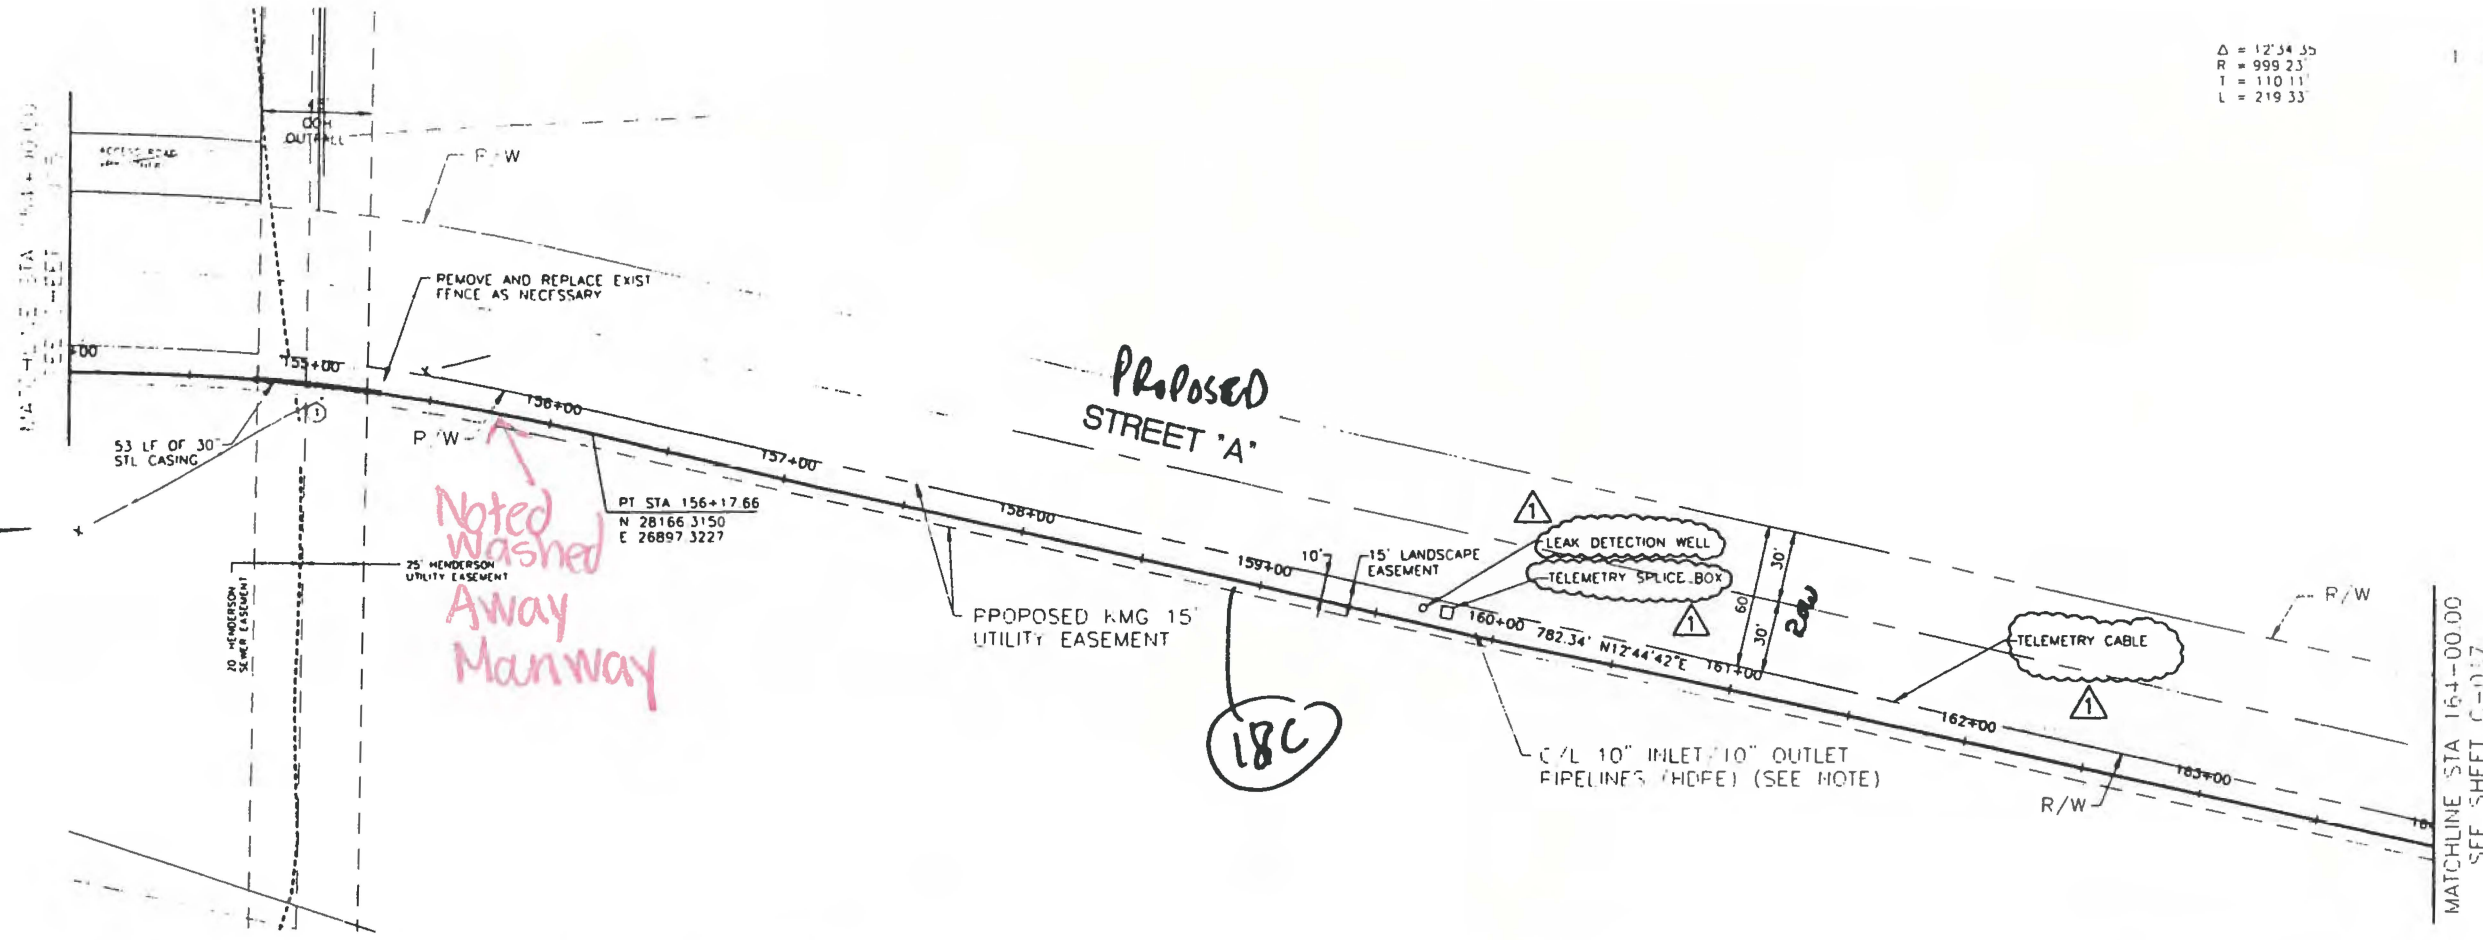

1600  
1596  
1592  
1588  
1584  
1580  
1576  
1572  
1568

KERR-MCGEE CHEMICAL LLC


P.O. BOX 55 HENDERSON, NEV. 89009-7000

DESIGN	DATE	APPROVED FOR CONSTRUCTION	BY	DATE
DRAWN BY J. APPOTO	11/14/17	PROJECT ENGR	J. TUCKER	
PROJ ENGR J.J. TUCKER		ENVIRONMENTAL		
ENGR MAJOR E.V. SPORE		OPERATIONS MAJOR		
		PRODUCTION BUILT		
		CULT. CONTROL		

INLET/OUTLET PIPELINES  
 PLAN + PROFILE  
 STA 154+00 TO STA 164+00

RECORD DRAWINGS  
 DATE: 5/01/18  
 SCALE: AS NOTED

Call before you Dig  
 1-800-995-3000

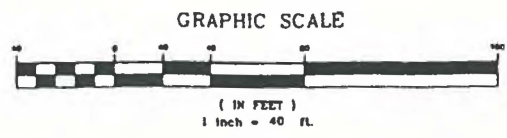

RICHARD J. CAPP RESPONSIBILITY FOR THESE PLANS INCLUDES ALL BUBBLED CHANGES AND CHANGES NOTED IN REVISION BLOCK


CONFIDENTIAL  
 PROPERTY OF KERR-MCGEE CORP.  
 MAY NOT BE REPRODUCED, COPIED, OR USED FOR ANY PURPOSE WITHOUT THE WRITTEN PERMISSION OF KERR-MCGEE CORPORATION




PAPER SIZE	DRAWING NO.	SHEET
A	C-016	20 28
		REVISION

① PC STA 172+72.70  
 Δ = 7°33'27"  
 R = 949.31'  
 L = 62.70'  
 L = 125.22'

1' WEST OF C/L ADD  
 INITIAL 10" INLET PIPELINE  
 1' EAST OF C/L

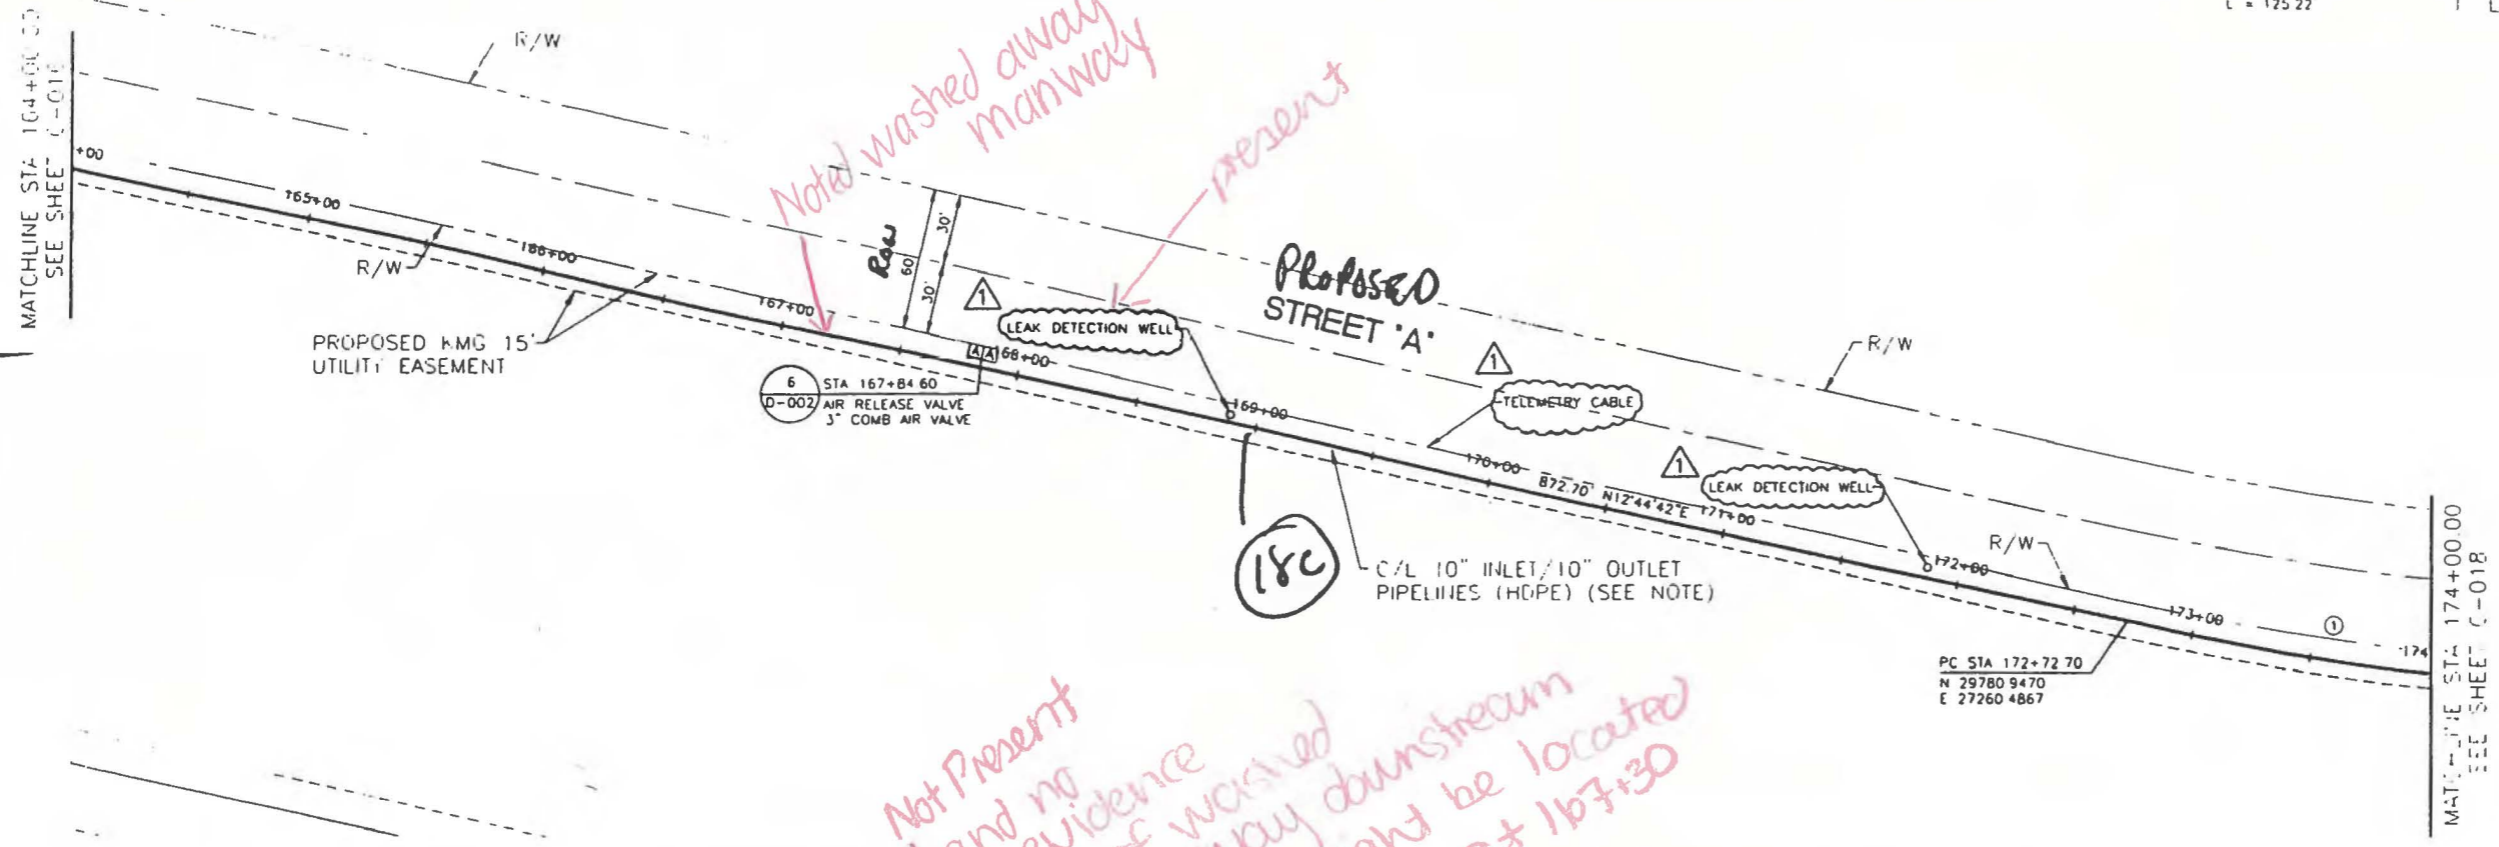


*Not Present  
 and no  
 evidence  
 of washed  
 away downstream  
 might be located  
 at 167+30*

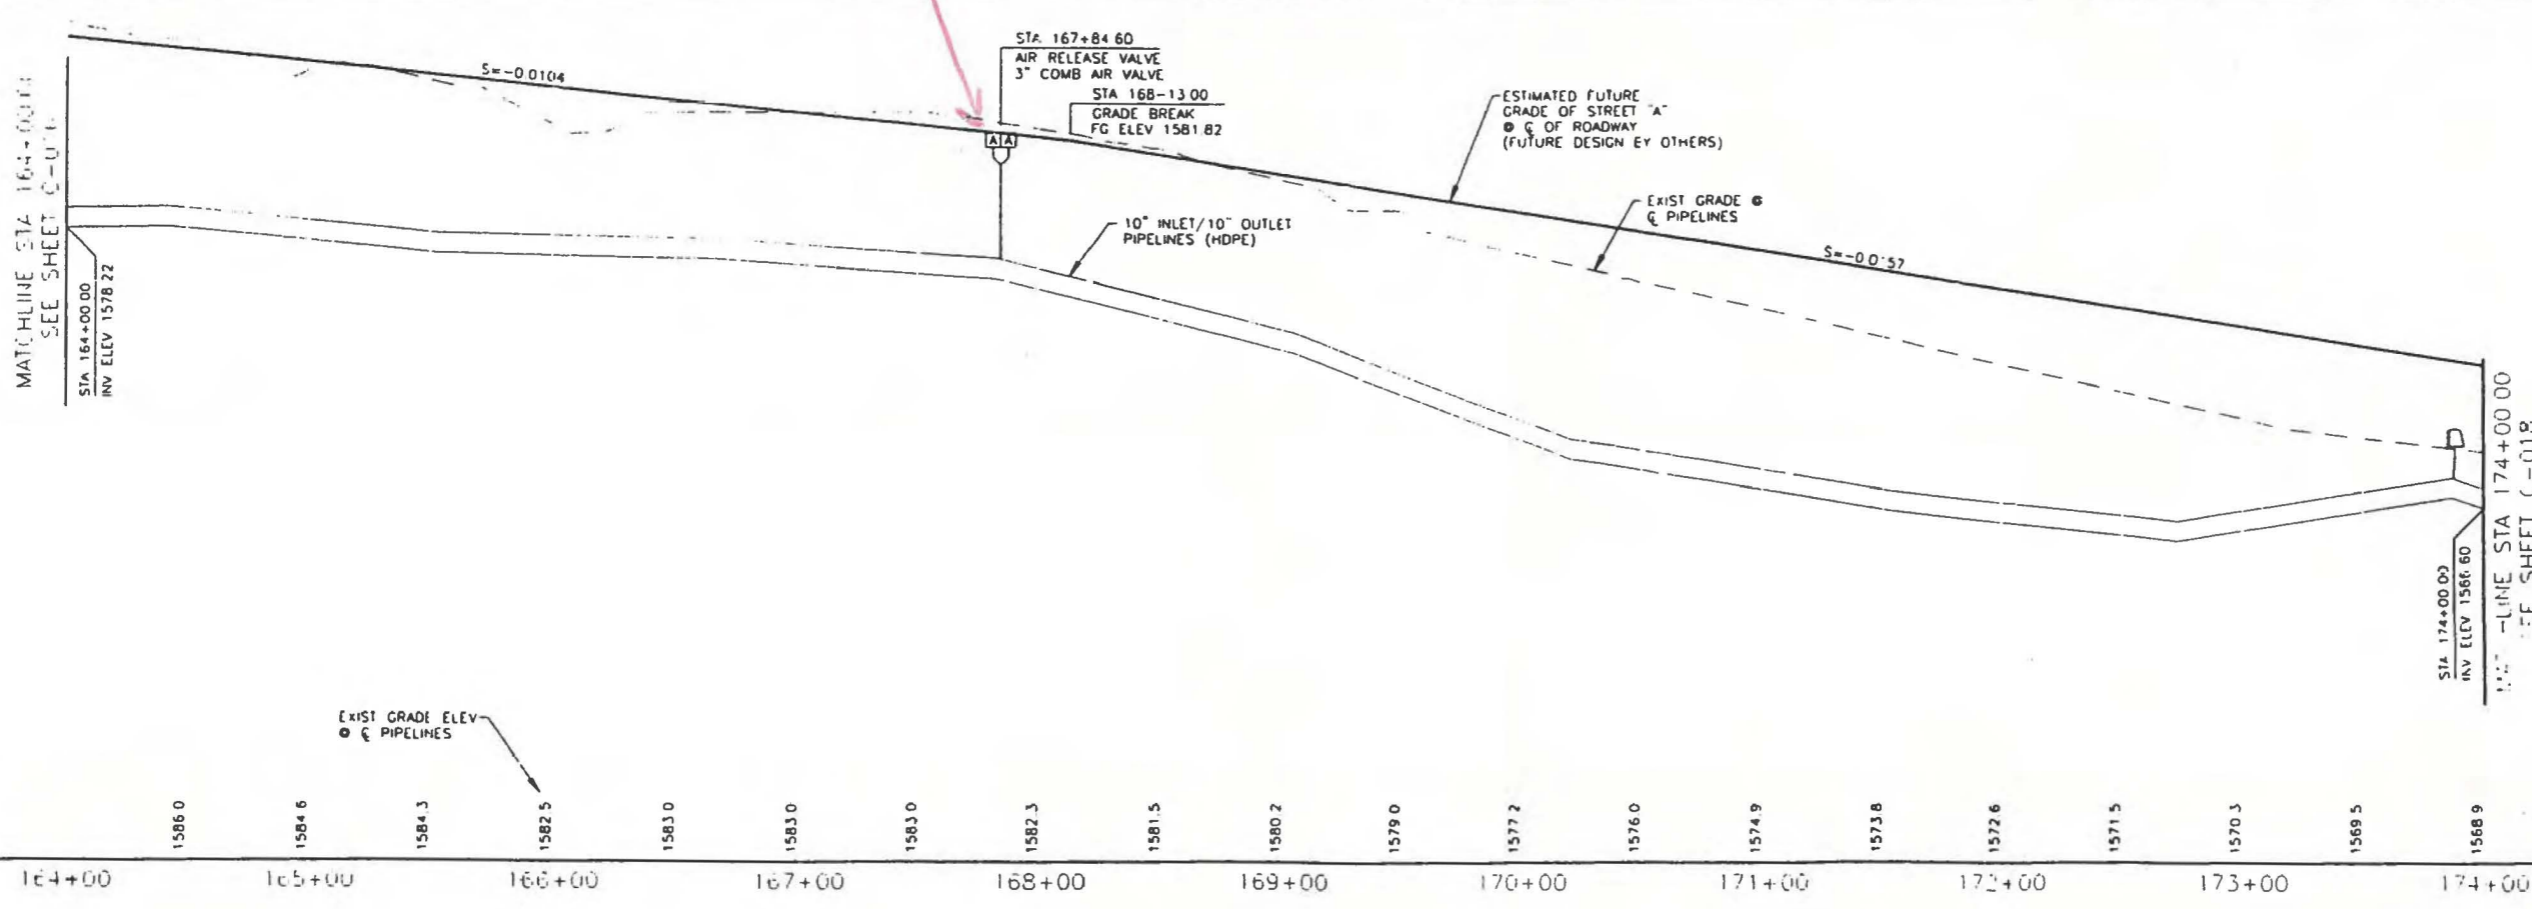


1584
1580
1576
1572
1568
1564
1560
1556
1552

164+00	165+00	166+00	167+00	168+00	169+00	170+00	171+00	172+00	173+00	174+00
--------	--------	--------	--------	--------	--------	--------	--------	--------	--------	--------

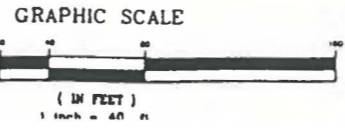

RICHARD J. CAPP RESPONSIBILITY FOR THESE PLANS INCLUDES ALL BUBBLED CHANGES AND CHANGES NOTED IN REVISION BLOCK.

CONFIDENTIAL  
 PROPERTY OF KERR-MCGEE CORP.  
 MAY NOT BE REPRODUCED, COPIED, OR USED FOR ANY PURPOSE WITHOUT THE WRITTEN PERMISSION OF KERR-MCGEE CORPORATION

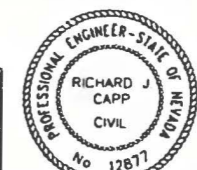

PAPER SIZE	DRAWING NO
A	C-017

**KERR-MC GEE CHEMICAL LLC**



P.O. BOX 55 HENDERSON, NEV. 89009-7000

INLET/OUTLET PIPELINES  
 PLAN + PROFILE  
 STA 164+00 TO STA 174+00

DESIGN	DATE	APPROVED FOR CONSTRUCTION	DATE
DESIGNED BY		BY	
DRAWN BY		PROCESS ENGR	
PROJ ENGR		PROJECT ENGR	
ENGR MAJOR		ENGR MAJOR	
PRODUCTION SFT		PLANT MAJOR	
DUTY CONTROL			

DATE

Call before you Dig

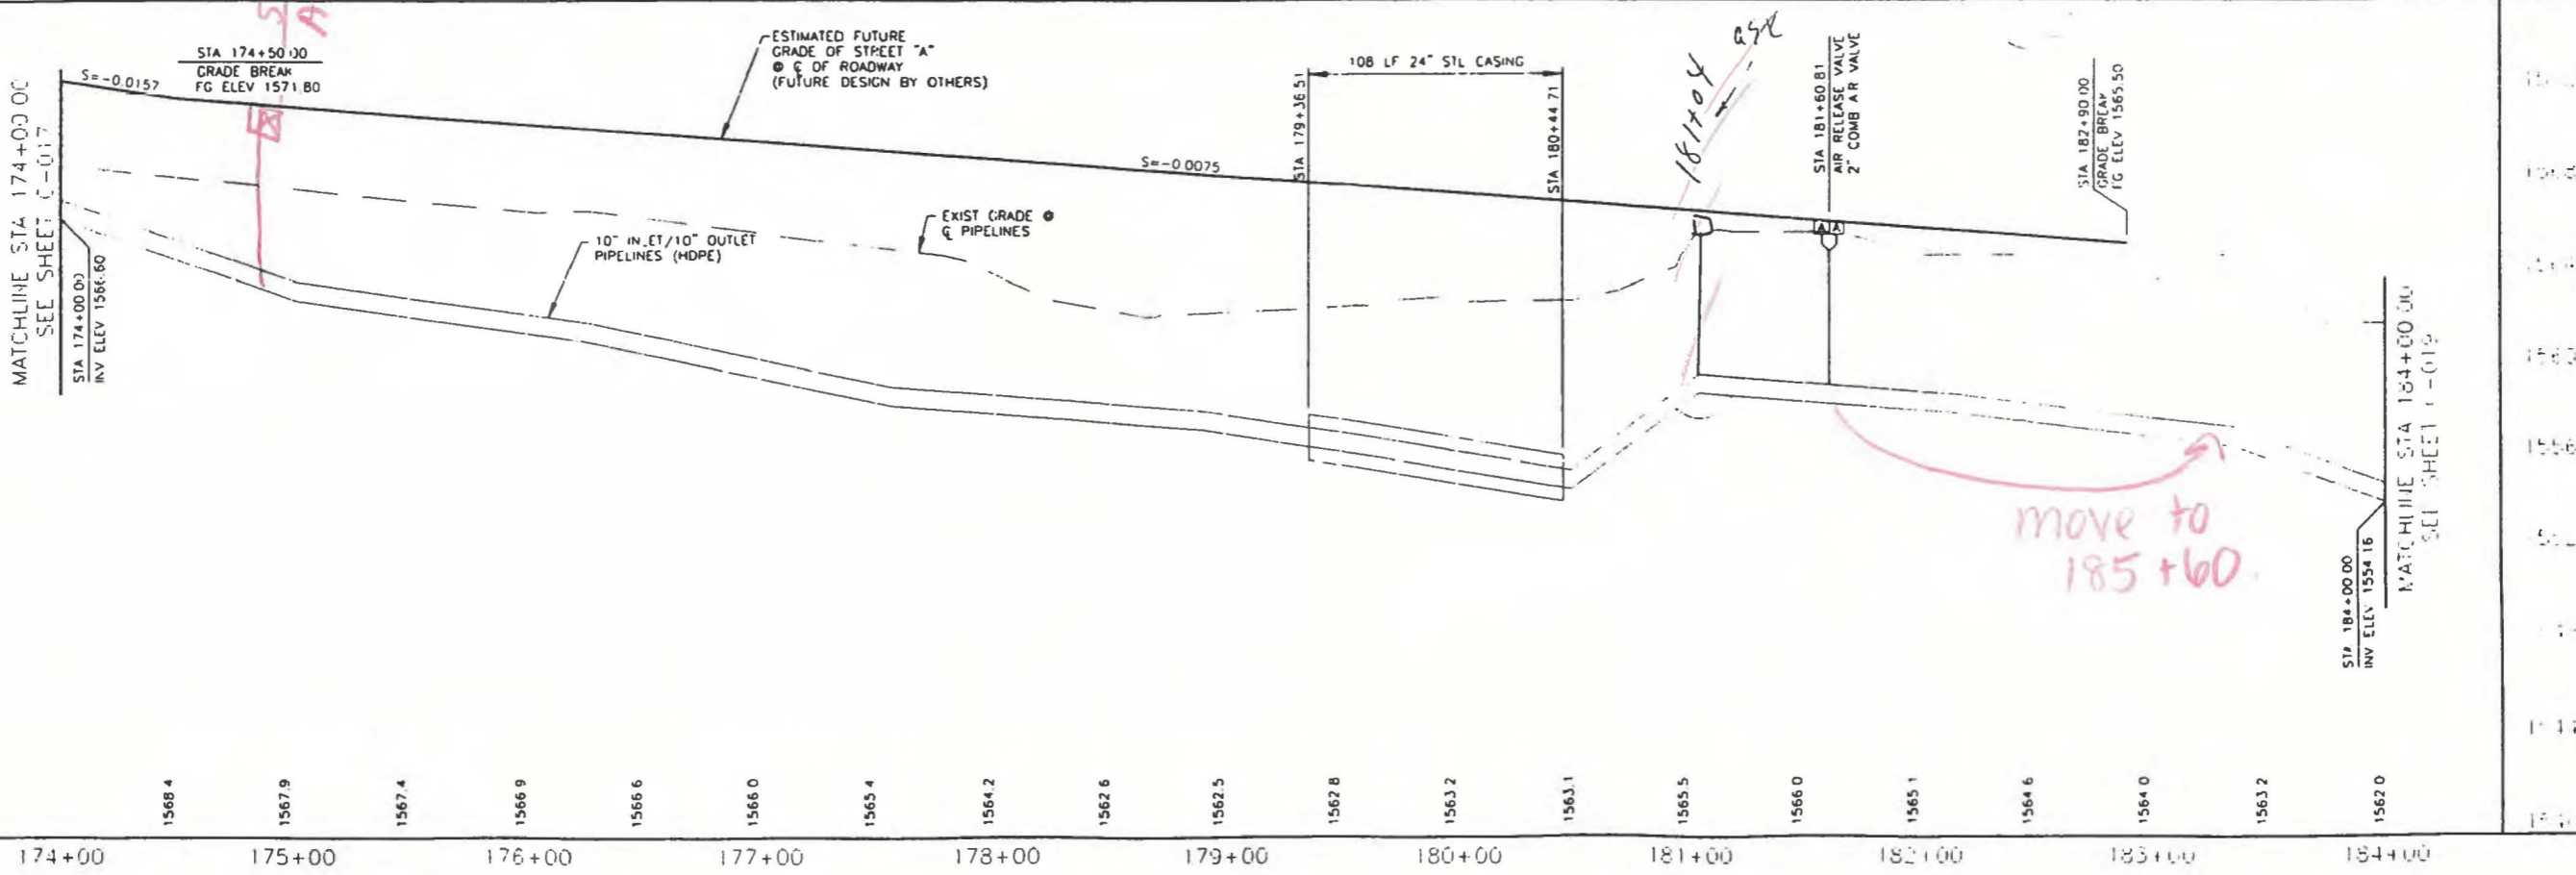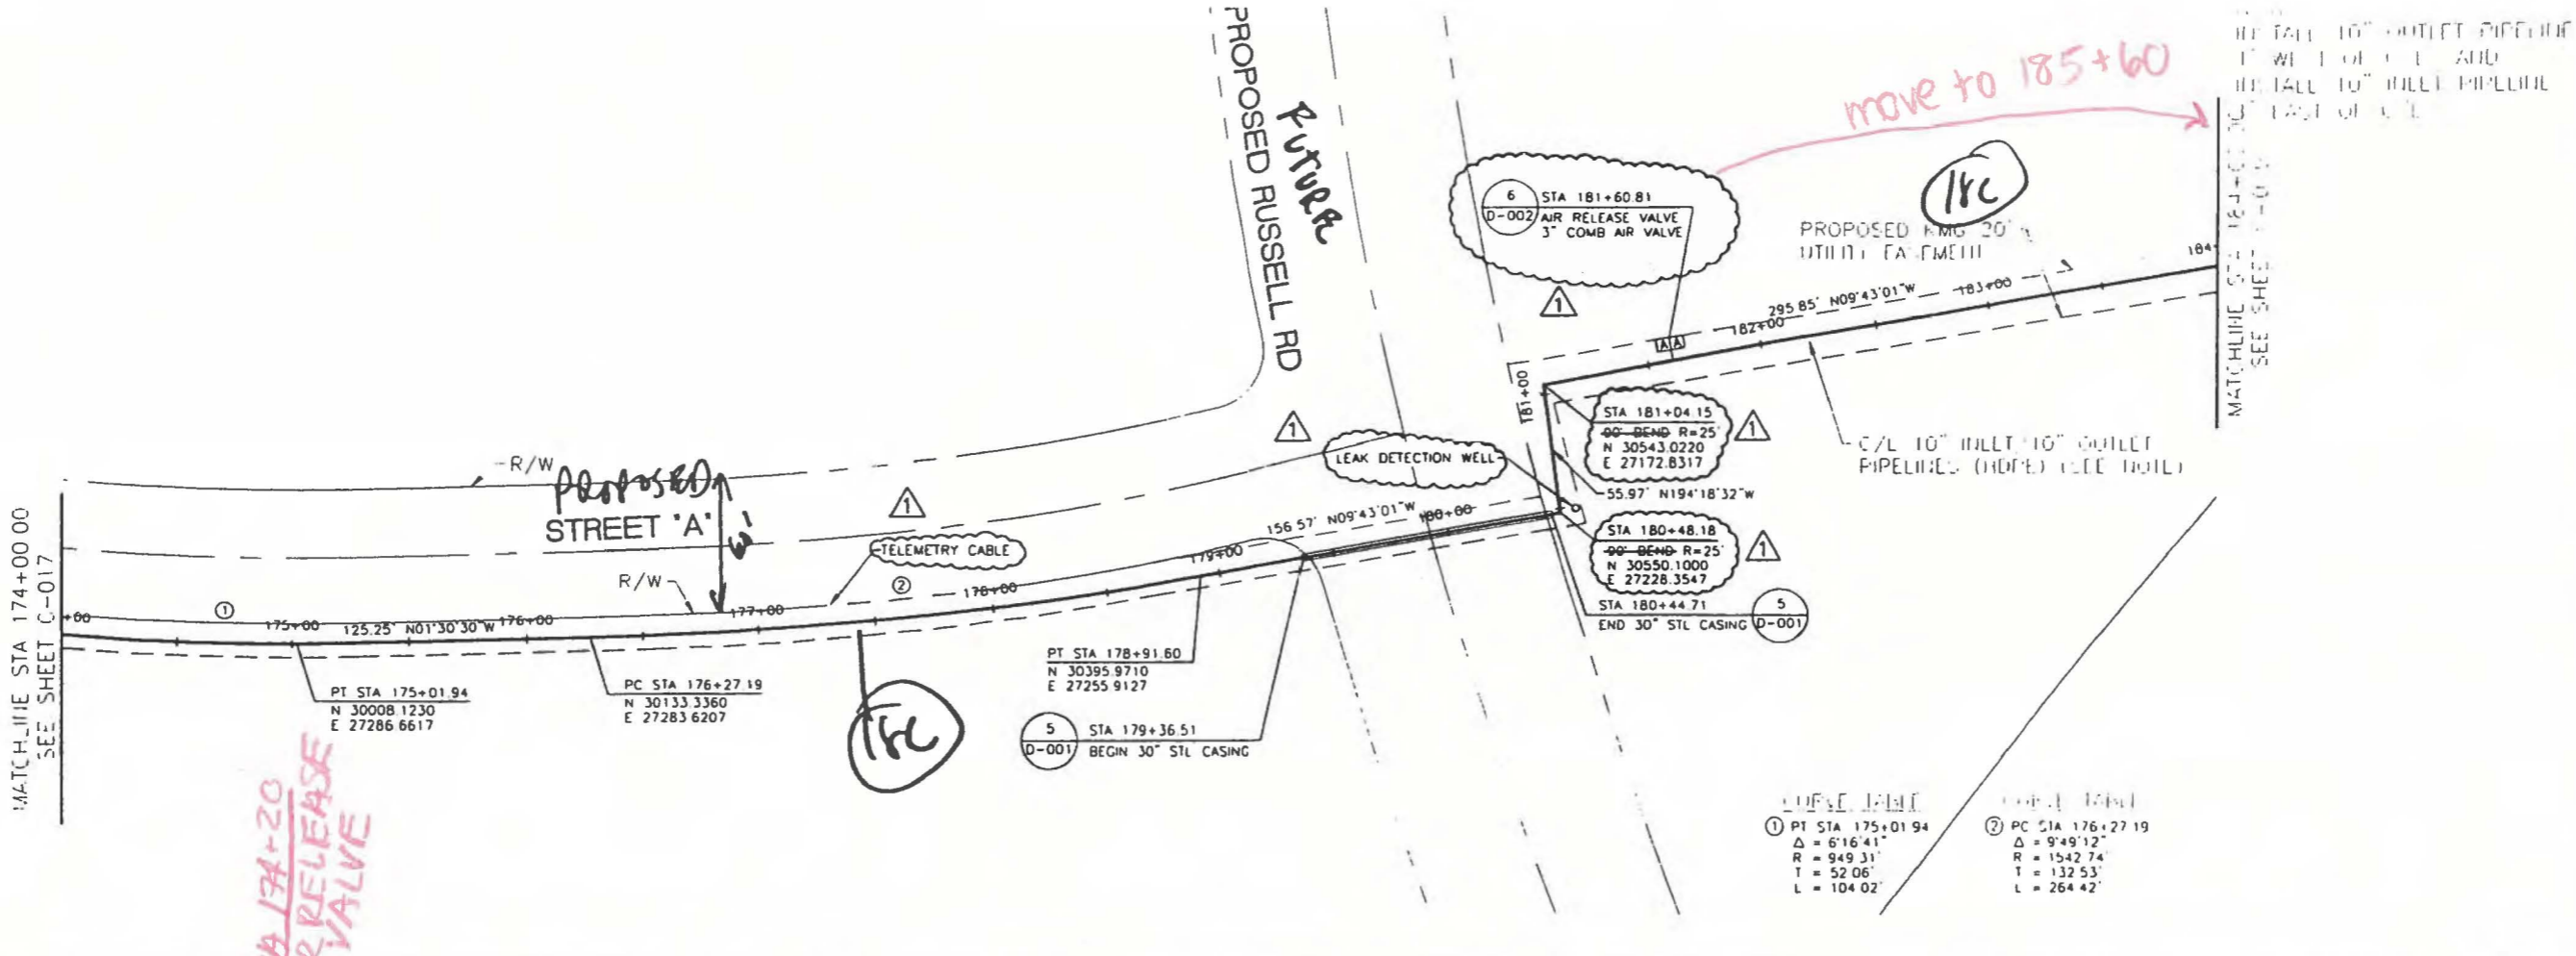


MATCHLINE STA 174+00.00 SEE SHEET C-017

MATCHLINE STA 184+00.00 SEE SHEET C-019

174+00 175+00 176+00 177+00 178+00 179+00 180+00 181+00 182+00 183+00 184+00


1568.4 1567.9 1567.4 1566.9 1566.6 1566.0 1565.4 1564.2 1562.6 1562.5 1562.8 1563.2 1563.1 1563.5 1566.0 1565.1 1564.6 1564.0 1563.2 1562.0

Call before you Dig

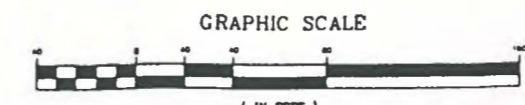

RICHARD J. CAPP RESPONSIBILITY FOR THESE PLANS INCLUDES ALL BUBBLED CHANGES AND CHANGES NOTED IN REVISION BLOCK

CONFIDENTIAL  
PROPERTY OF KERR-MCGEE CORP.  
MAY NOT BE REPRODUCED, COPIED, OR USED FOR ANY PURPOSE WITHOUT

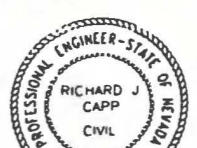

PAPER SIZE: A  
DRAWING NO: C-018

DESIGN	DATE	BY
SAFETY		
ENVIRONMENTAL		
OPERATIONS/MGR		
PRODUCTION/BUP		
UTILITY CONTROL		

APPROVED FOR CONSTRUCTION	DATE	BY
PROJECT ENGR		
PROJECT ENGR		
ENGR MGR		
PLANT MGR		
UTILITY CONTROL		

**KERR-MC GEE CHEMICAL LLC**  
P.O. BOX 55 HENDERSON, NEV. 89009-7000

INLET/OUTLET PIPELINES  
PLAN + PROFILE  
STA 174+00 TO STA 184+00

DATE: 11/11/11

SCALE: 1" = 40'


JOB NO: 89009-7000

TRAFFIC CONTROL SPECIFICATIONS: AFE No. 200

RECORD DRAWINGS: 11/11/11

CLL 10/1/11

PBS&J


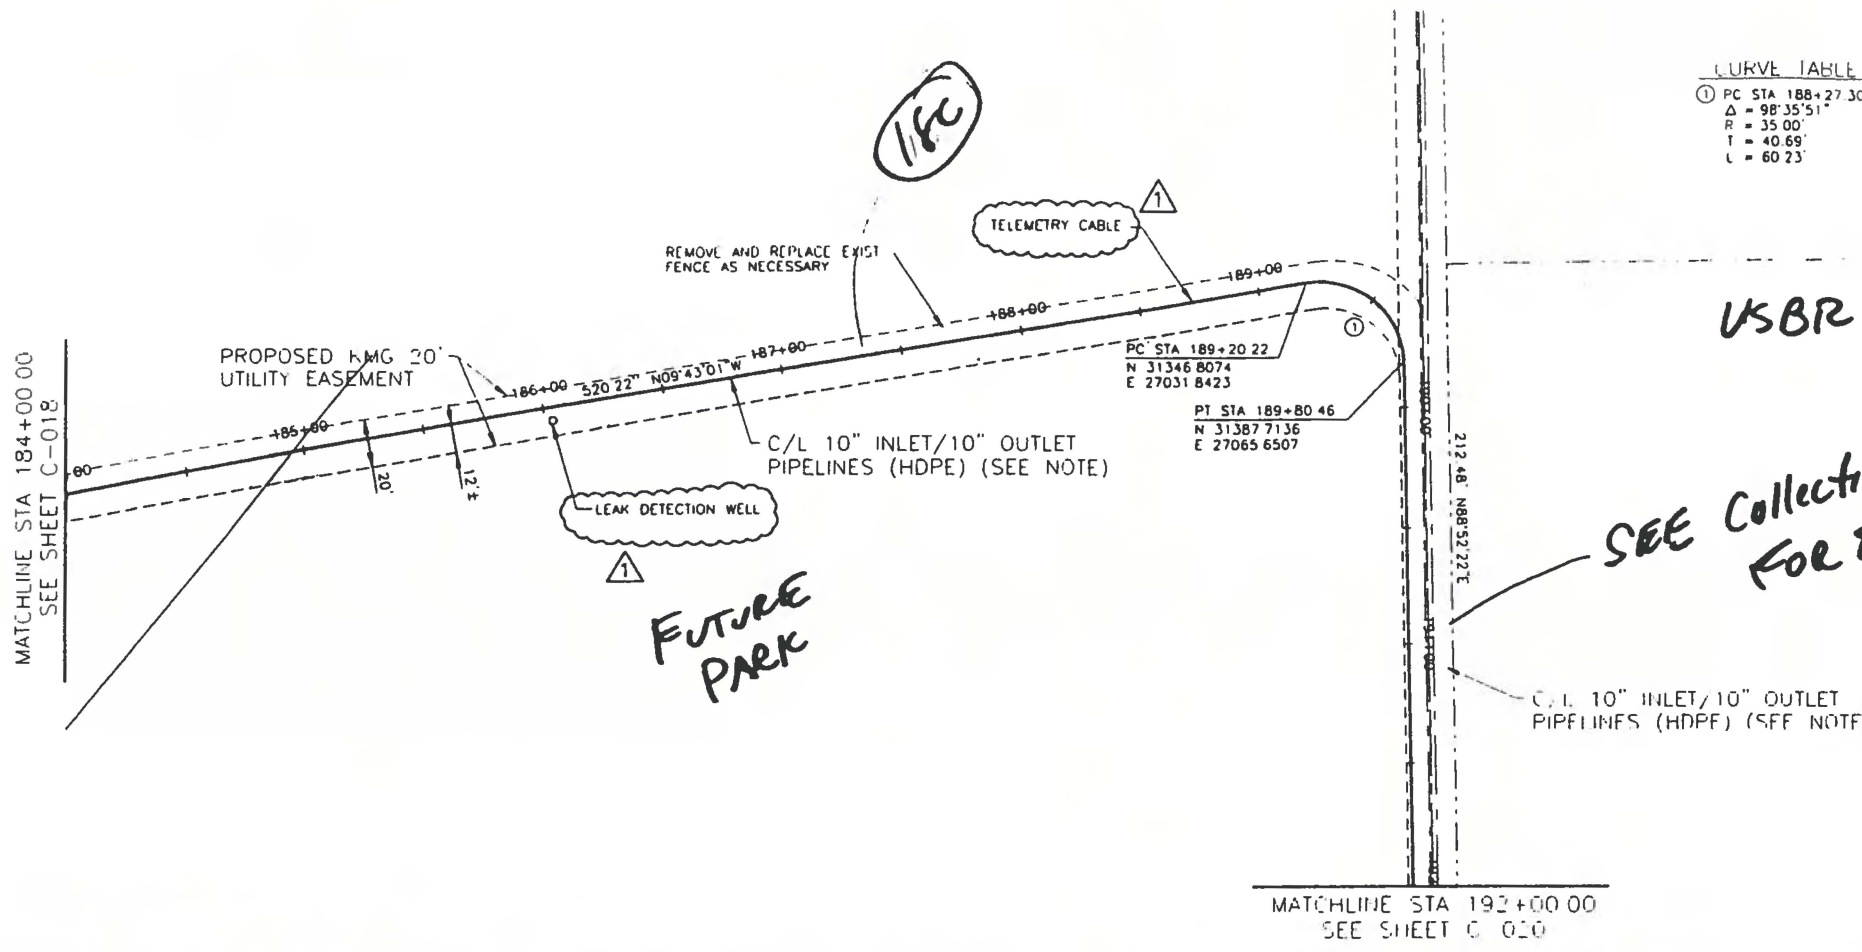


**CURVE TABLE**

① PC STA 188+27.30
Δ = 98°35'51"
R = 35.00
T = 40.69
L = 60.23

*SEE Collectiv treatment Facility plans (LS #1) FOR EASEMENTS (Sept 1999)*

DATE: 11/11/11  
 WEST OF STA 184+00  
 EAST OF STA 192+00

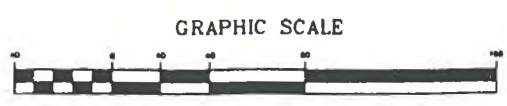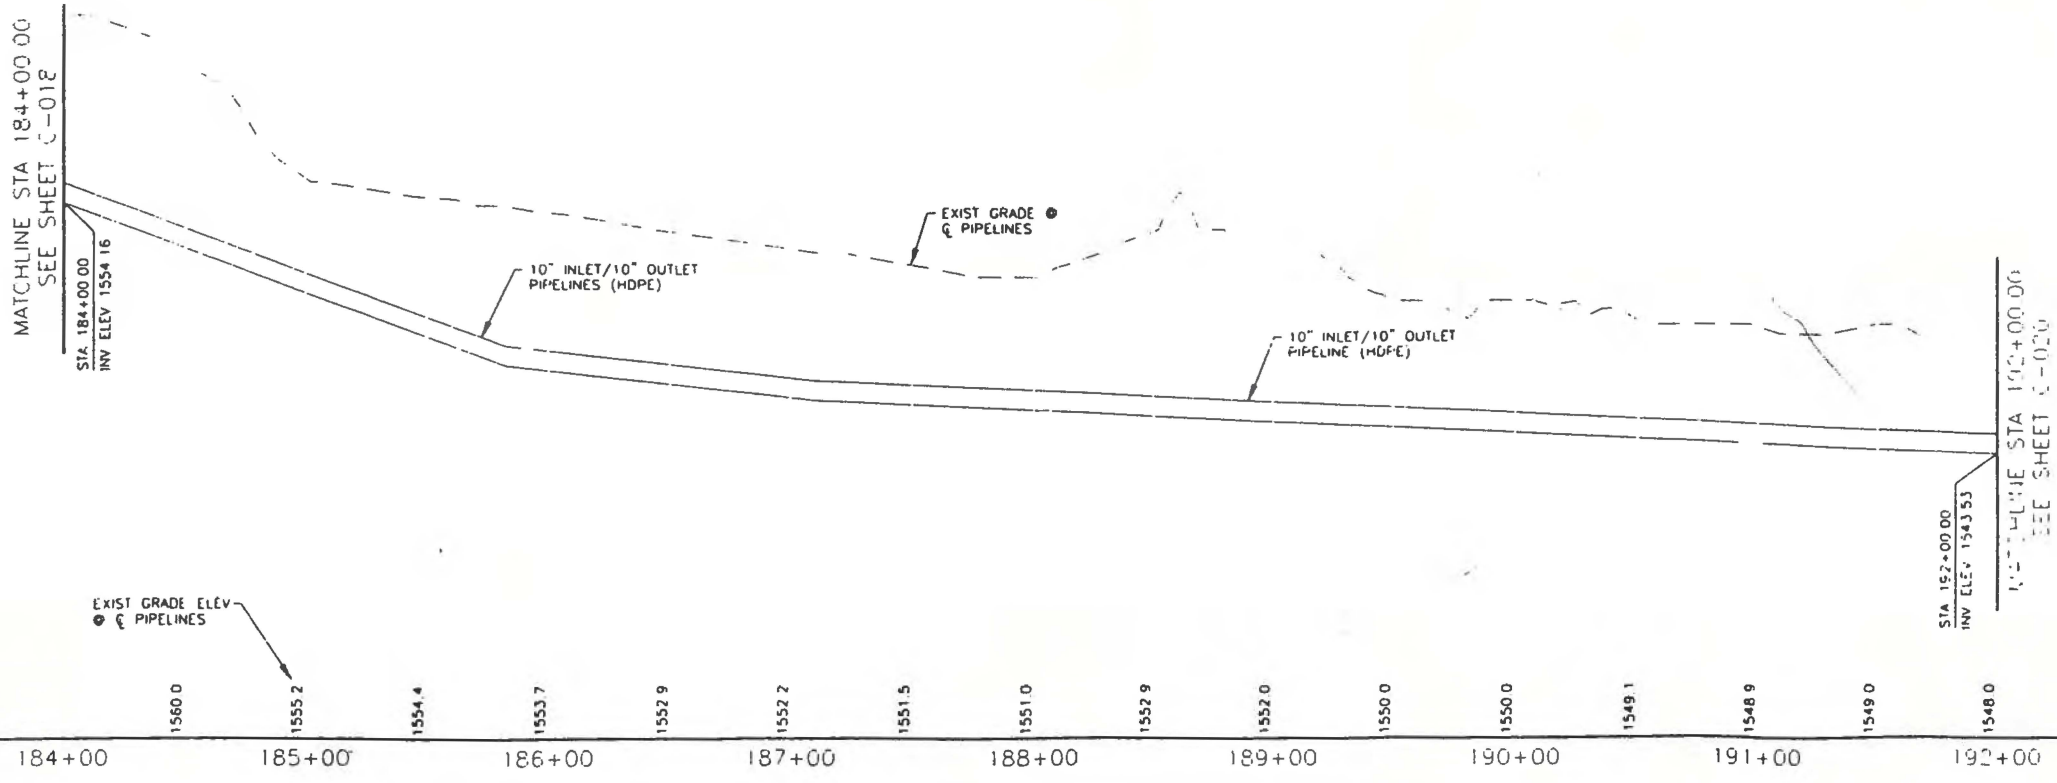

KERR-MC GEE CHEMICAL LLC  
 P.O. BOX 55 HENDERSON, NEV 89009-7000


DESIGN	DATE	APPROVED FOR CONSTRUCTION	BY	DATE
SAFETY	11/11/11	PROCESS ENGR		
ENVIRONMENTAL		PROJECT ENGR		
OPERATIONS MGR		ENGR MGR		
PRODUCTION MGR		PLANT MGR		
QUALITY CONTROL				

INLET/OUTLET PIPELINES  
 PLAN + PROFILE  
 STA 184+00 TO STA 192+00.00

DATE	10/19/19
RECORD DRAWINGS	



Call before you dig

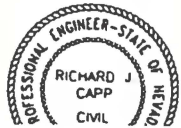

CONFIDENTIAL  
 PROPERTY OF KERR-MCGEE CORP.  
 MAY NOT BE REPRODUCED, COPIED,  
 OR TRANSMITTED IN ANY FORM OR BY ANY MEANS, ELECTRONIC OR MECHANICAL, WITHOUT PERMISSION.



PAPER SIZE  
 A


DRAWING NO  
 C-019

SHEET  
 OF  
 REVISION

USBR


CURVE TABLE	CURVE TABLE	CURVE TABLE	CURVE TABLE	CURVE TABLE
① PC STA 195+62.98 Δ = 24°21'36" R = 35.00' T = 7.55' L = 14.88'	② PC STA 196+29.96 Δ = 24°20'41" R = 35.00' T = 7.55' L = 14.87'	③ PC STA 196+48.97 Δ = 13°07'07" R = 35.00' T = 4.02' L = 8.01'	④ PC STA 195+28.76 Δ = 44°16'39" R = 35.00' T = 14.24' L = 27.05'	⑤ PC STA 195+91.17 Δ = 30°24'28" R = 35.00' T = 9.51' L = 18.58'

MATCHLINE STA 192+00.00  
SEE SHEET C-019

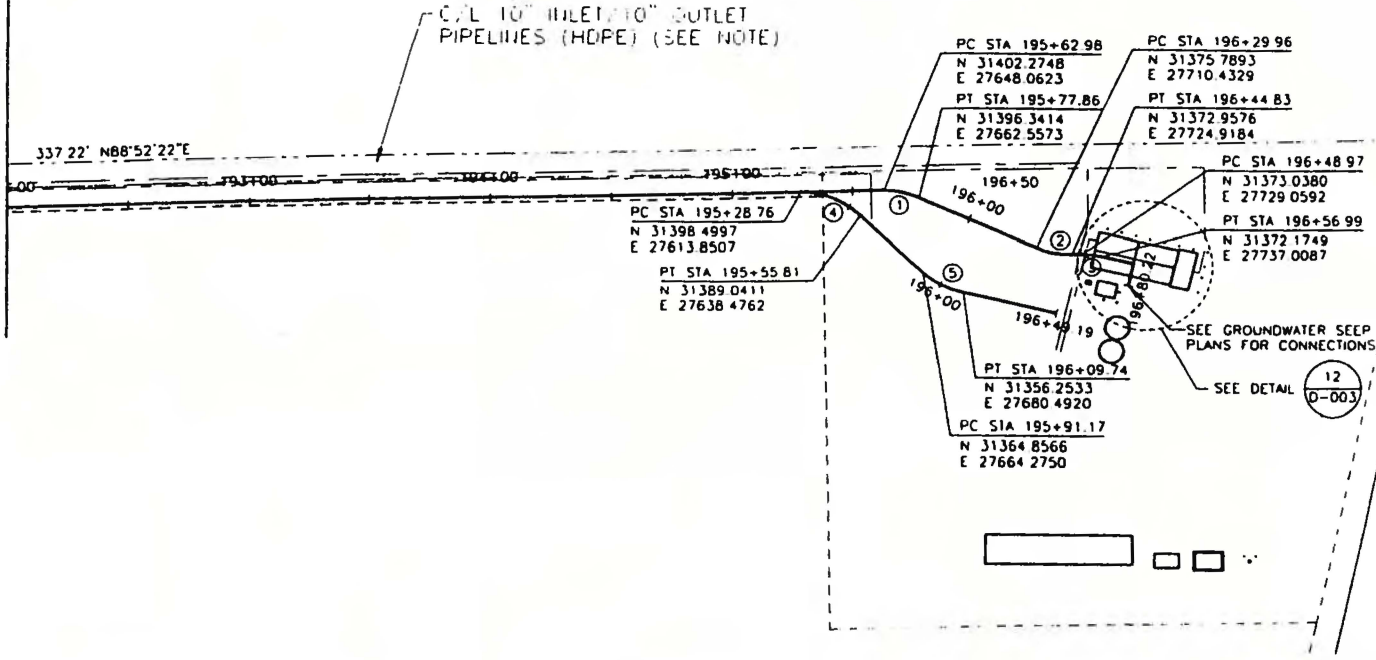

NOTE  
INSTALL 10" OUTLET PIPELINE  
1' WEST OF C/L AND  
INSTALL 10" INLET PIPELINE  
1' EAST OF C/L

MATCHLINE STA 192+00.00  
SEE SHEET C-019

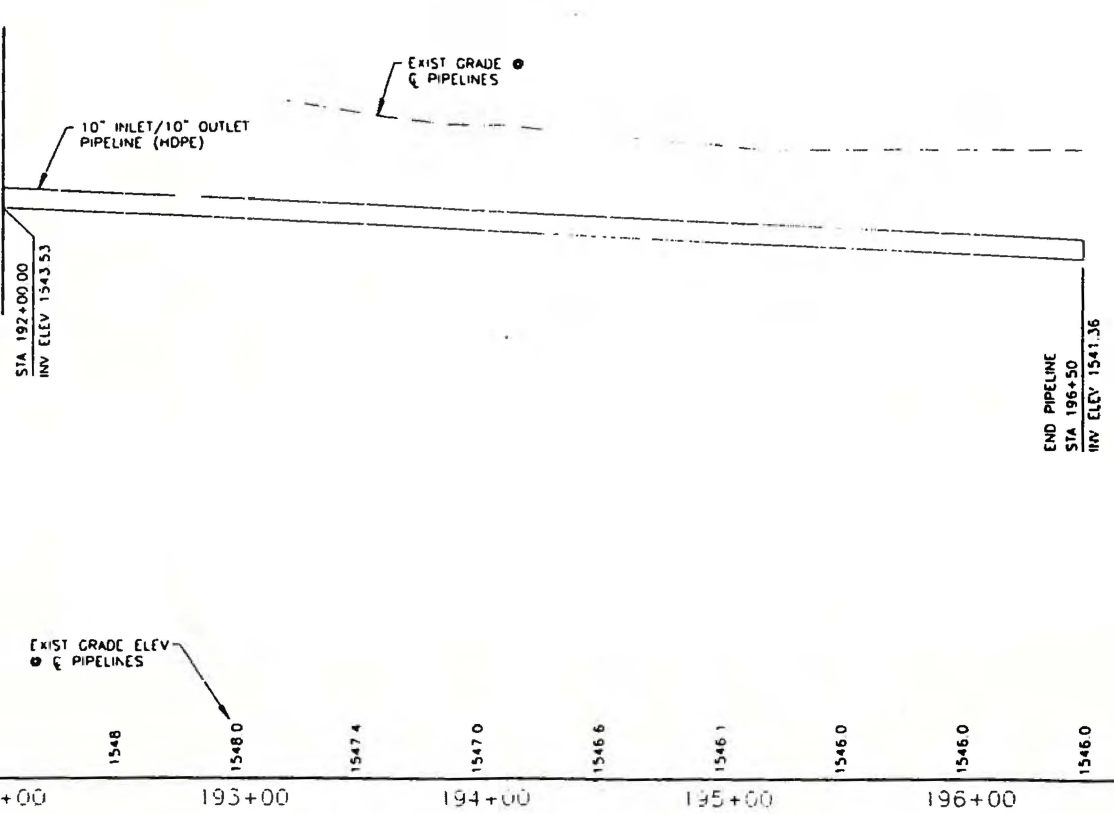

1540	1544	1548	1552	1556	1560
------	------	------	------	------	------

1731  
1541  
1941  
83PSC

**KERR-MC GEE CHEMICAL LLC**

P.O. BOX 55 HENDERSON, NEV. 89009-7000

INLET/OUTLET PIPELINE  
PLAN + PROFILE  
STA 192+00 TO STA 196+92.94


DATE: 11/11/19

DESIGN	DATE	APPROVED FOR CONSTRUCTION
BY: J. TUCKER	11/11/19	BY: DATE
PROJ ENGR: J. TUCKER		PROCESS ENGR:
ENGR MNOR: EM. SCOPE		PROJECT ENGR:
		ENGR MNOR:
		PLANT MNOR:
		SAFETY:
		ENVIRONMENTAL:
		OPERATIONS MNOR:
		PRODUCTION SUP:
		QUALITY CONTROL:


RECORD DRAWINGS

SCALE: AS SHOWN

Call before you Dig

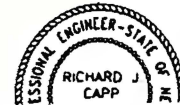

CONFIDENTIAL  
PROPERTY OF KERR-MC GEE CHEMICAL LLC

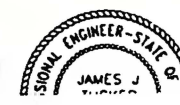

PAPER SIZE: 9-EET  
DRAWING NO.



**APPENDIX C**  
**COSTING INFORMATION**

**Well Field VFD Construction Costs**

Item	Sub Item	Sub Item	HP	No of Units	Units	Unit Price	Extended Price
<b>Seep Well Field</b>							
Mobilization	NA	NA	NA	1	Lump sum	\$ 5,000	\$ 5,000
PC-115R	VFD	Submersible Pump	5	1	Each	\$ 3,480	\$ 3,480
PC-116R	VFD	Submersible Pump	20	1	Each	\$ 4,575	\$ 4,575
PC-117	VFD	Submersible Pump	5	1	Each	\$ 3,480	\$ 3,480
PC-118	VFD	Submersible Pump	5	1	Each	\$ 3,480	\$ 3,480
PC-119	VFD	Submersible Pump	5	1	Each	\$ 3,480	\$ 3,480
PC-120	VFD	Submersible Pump	5	1	Each	\$ 3,480	\$ 3,480
PC-121	VFD	Submersible Pump	5	1	Each	\$ 3,480	\$ 3,480
PC-133	VFD	Submersible Pump	2	1	Each	\$ 3,400	\$ 3,400
PC-99R3	VFD	Submersible Pump	5	1	Each	\$ 3,480	\$ 3,480
VFD Installation	NA	NA	NA	9	Each	\$ 1,623	\$ 14,607
Subtotal							\$ 52,000
Contingency (@30%)							\$ 16,000
Contractor OH&P (@ 20%)							\$ 10,000
Engineering and Management (@20%)							\$ 10,000
<b>Total</b>							<b>\$ 88,000</b>
<b>Athens Road Well Field</b>							
Mobilization	NA	NA	NA	1	Lump sum	\$ 5,000	\$ 5,000
ART-1	VFD	Submersible Pump	2	1	Each	\$ 3,400	\$ 3,400
ART-1A	VFD	Submersible Pump	2	1	Each	\$ 3,400	\$ 3,400
ART-2	VFD	Submersible Pump	3	1	Each	\$ 3,440	\$ 3,440
ART-2A	VFD	Submersible Pump	3	1	Each	\$ 3,440	\$ 3,440
ART-3	VFD	Submersible Pump	3	1	Each	\$ 3,440	\$ 3,440
ART-3A	VFD	Submersible Pump	2	1	Each	\$ 3,400	\$ 3,400
ART-4	VFD	Submersible Pump	1.5	1	Each	\$ 3,400	\$ 3,400
ART-4A	VFD	Submersible Pump	1.5	1	Each	\$ 3,400	\$ 3,400
ART-6	VFD	Submersible Pump	0.75	1	Each	\$ 3,360	\$ 3,360
ART-9	VFD	Submersible Pump	0.75	1	Each	\$ 3,360	\$ 3,360
ART-7A	VFD	Submersible Pump	1.5	1	Each	\$ 3,400	\$ 3,400
ART-7B	VFD	Submersible Pump	1.5	1	Each	\$ 3,400	\$ 3,400
ART-8	VFD	Submersible Pump	1.5	1	Each	\$ 3,400	\$ 3,400
ART-8A	VFD	Submersible Pump	1.5	1	Each	\$ 3,400	\$ 3,400
PC-150	VFD	Submersible Pump	1	1	Each	\$ 3,400	\$ 3,400
PC-116R	VFD	Submersible Pump	20	1	Each	\$ 4,575	\$ 4,575
PC-117	VFD	Submersible Pump	5	1	Each	\$ 3,480	\$ 3,480
PC-118	VFD	Submersible Pump	5	1	Each	\$ 3,480	\$ 3,480
PC-119	VFD	Submersible Pump	5	1	Each	\$ 3,480	\$ 3,480
PC-120	VFD	Submersible Pump	5	1	Each	\$ 3,480	\$ 3,480
PC-121	VFD	Submersible Pump	5	1	Each	\$ 3,480	\$ 3,480
PC-133	VFD	Submersible Pump	2	1	Each	\$ 3,400	\$ 3,400
PC-99R3	VFD	Submersible Pump	5	1	Each	\$ 3,480	\$ 3,480
VFD Installation	NA	NA	NA	15	Each	\$ 1,620	\$ 24,300
Subtotal							\$ 80,000
Contingency (@30%)							\$ 24,000
Contractor OH&P (@ 20%)							\$ 16,000
Engineering and Management (@20%)							\$ 16,000
<b>Total</b>							<b>\$ 136,000</b>

**Well Field VFD Construction Costs (continued)**

Item	Sub Item	Sub Item	HP	No of Units	Units	Unit Price	Extended Price
<b>Interceptor Well Field</b>							
Mobilization	NA	NA	NA	1	Lump sum	\$ 5,000	\$ 5,000
I-AA	VFD	Submersible Pump	0.5	1	Each	\$ 3,360	\$ 3,360
I-AB	VFD	Submersible Pump	0.5	1	Each	\$ 3,360	\$ 3,360
VFD Installation	NA	NA	NA	30	Each	\$ 1,623	\$ 48,690
Subtotal							\$ 154,000
Contingency (@30%)							\$ 46,000
Contractor OH&P (@ 20%)							\$ 31,000
Engineering and Management (@20%)							\$ 31,000
<b>Total</b>							<b>\$ 262,000</b>



**Lift Station VFD Construction Costs**

<b>Item</b>	<b>Sub Item</b>	<b>Sub Item</b>	<b>HP</b>	<b>No of Units</b>	<b>Units</b>	<b>Unit Price</b>	<b>Extended Price</b>
Mobilization	NA	NA	NA	1	Lump sum	\$ 5,000	\$ 5,000
Lift Station #1	VFD	Vertical Turbine Pumps	40	2	Each	\$ 10,310	\$ 20,620
Lift Station #2	VFD	Vertical Turbine Pumps	150	2	Each	\$ 20,000	\$ 40,000
Lift Station #3	VFD	Submersible Pumps	20	2	Each	\$ 6,040	\$ 12,080
VFD Installation	NA	NA	NA	6	Each	\$ 5,000	\$ 30,000
Subtotal							\$ 108,000
Contingency (@30%)							\$ 32,000
Contractor OH&P (@ 20%)							\$ 22,000
Engineering and Management (@ 20%)							\$ 22,000
<b>Total</b>							<b>\$ 184,000</b>

**Lift Station and Effluent Pump Station Pump Replacement Cost Estimates**

Item	No of Units	Units	Unit Price	Extended Price
<b>Lift Station No. 1</b>				
Mobilization	1	Lump sum	\$ 5,000	\$ 5,000
Pump and Pipe Removal	1	Lump sum	\$ 10,000	\$ 10,000
Pumps	2	Each	\$ 23,000	\$ 46,000
Valves and Piping	1	Lump sum	\$ 5,000	\$ 5,000
Installation (Labor, Misc. Tools)	30% of material cost			\$ 15,000
Electrical Conduit and Wiring	10% of equipment material/installation			\$ 6,000
New Motor Starters	2	Each	\$ 10,000	\$ 20,000
Subtotal				\$ 107,000
Contingency (@30%)				\$ 32,000
Contractor OH&P (@ 20%)				\$ 21,000
Engineering and Management				\$ 21,000
<b>Total</b>				<b>\$ 181,000</b>

<b>Lift Station No. 2</b>				
Mobilization	1	Lump sum	\$ 5,000	\$ 5,000
Pump and Pipe Removal	1	Lump sum	\$ 10,000	\$ 10,000
Core Drill for New VT Pump	1	Each	\$ 5,000	\$ 5,000
Pumps	2	Each	\$ 30,000	\$ 60,000
Valves and Piping	1	Lump sum	\$ 5,000	\$ 5,000
Installation (Labor, Misc. Tools)	30% of material cost			\$ 20,000
Electrical Conduit and Wiring	10% of equipment material/installation			\$ 8,000
New Motor Starters	2	Each	\$ 10,000	\$ 20,000
Subtotal				\$ 133,000
Contingency (@30%)				\$ 40,000
Contractor OH&P (@ 20%)				\$ 27,000
Engineering and Management (@20%)				\$ 27,000
<b>Total</b>				<b>\$ 227,000</b>

<b>Lift Station No. 3</b>				
Mobilization	1	Lump sum	\$ 5,000	\$ 5,000
Pump and Pipe Removal	1	Lump sum	\$ 10,000	\$ 10,000
Pumps	2	Each	\$ 18,000	\$ 36,000
Valves and Piping	1	Lump sum	\$ 5,000	\$ 5,000
Installation (Labor, Misc. Tools)	30% of material cost			\$ 12,000
Electrical Conduit and Wiring	10% of equipment material/installation			\$ 5,000
New Motor Starters	2	Each	\$ 10,000	\$ 20,000
Subtotal				\$ 93,000
Contingency (@30%)				\$ 28,000
Contractor OH&P (@ 20%)				\$ 19,000
Engineering and Management (@20%)				\$ 19,000
<b>Total</b>				<b>\$ 159,000</b>

<b>Effluent Pump Station</b>				
Mobilization	1	Lump sum	\$ 5,000	\$ 5,000
Pump and Pipe Removal	1	Lump sum	\$ 10,000	\$ 10,000
Pumps	2	Each	\$ 24,000	\$ 48,000
Valves and Piping	1	Lump sum	\$ 5,000	\$ 5,000
Installation (Labor, Misc. Tools)	30% of material cost			\$ 16,000
Electrical Conduit and Wiring	10% of equipment material/installation			\$ 6,000
New Motor Starters	2	Each	\$ 10,000	\$ 20,000
Subtotal				\$ 110,000
Contingency (@30%)				\$ 33,000
Contractor OH&P (@ 20%)				\$ 22,000
Engineering and Management (@20%)				\$ 22,000
<b>Total</b>				<b>\$ 187,000</b>

**GWTP Capital Cost Estimate, Alternative 1: Bypass GWTP  
and Update FeSO<sub>4</sub> Feed**

<b>Item</b>	<b>No of Units</b>	<b>Units</b>	<b>Unit Price</b>	<b>Extended Price</b>
Mobilization	1	Lump sum	\$5,000	\$5,000
Ferrous sulfate feed pump with automatic flow adjustment	1	Each	\$2,000	\$2,000
Piping and instrumentation to bypass existing GWTP	1	Each	\$5,000	\$5,000
Electronic flowmeter (250-gpm capacity)	1	Each	\$2,000	\$2,000
Installation (piping and instrumentation)	1	Lump sum	\$10,000	\$10,000
Installation (electrical)	1	Lump sum	\$6,000	\$6,000
Subtotal				\$30,000
Contingency (@30%)				\$9,000
Contractor OH&P (@ 20%)				\$6,000
Engineering and Management (@ 20%)				\$6,000
<b>Total</b>				<b>\$51,000</b>

### GWTP Capital Cost Estimate, Alternative 2: Key Equipment Upgrade

Item	No of Units	Units	Unit Price	Extended Price
Mobilization	1	Lump sum	\$5,000	\$ 5,000
Inclined plate clarifier (200-gpm capacity) with intergral flash and floc tanks and two mixers	1	Each	\$51,000	\$ 51,000
Clarifier access platform with ladder, grated steel	1	Each	\$20,000	\$ 20,000
Polymer blending system	1	Each	\$12,000	\$ 12,000
Filter press (10-cu.ft. automatic unit with automatic feed pump controls, self-dumping filter cake discharge hopper, and plate for reduced capacity operaiton)	1	Each	\$31,000	\$ 31,000
Ferrous sulfate chemical feed pump	1	Each	\$2,000	\$ 2,000
Electronic flowmeter (250-gpm capacity)	1	Each	\$2,000	\$ 2,000
Air compressor (15-HP, 50-scfm, 2-stage, 120-gal tank)	1	Each	\$5,000	\$ 5,000
Low head transfer pumps (P-1A and P-1B, 200 gpm @ 30ft, 3 HP)	2	Each	\$2,500	\$ 5,000
High head transfer pumps (P-4A and P-4B, 200 gpm @ 60ft, 5 HP)	2	Each	\$3,000	\$ 6,000
Piping and fittings	1	Each	\$10,000	\$ 10,000
Instrumentation	1	Each	\$5,000	\$ 5,000
Existing equipment removal and disposal	1	Each	\$10,000	\$ 10,000
Installation (equipment, piping, and instrumentation)	1	Lump sum	\$25,000	\$ 25,000
Installation (electrical)	1	Lump sum	\$10,000	\$ 10,000
Shipping	1	Each	\$16,000	\$ 16,000
Subtotal				\$ 215,000
Contingency (@30%)				\$ 65,000
Contractor OH&P (@ 20%)				\$ 43,000
Engineering and Management (@ 20%)				\$ 43,000
<b>Total</b>				<b>\$366,000</b>

### GWTP Capital Cost Estimate, Alternative 3: Entire GWTP Replacement

Item	No of Units	Units	Unit Price	Extended Price
Mobilization	1	Lump sum	\$5,000	\$5,000
Influent tank (4,200 gallons, 8.5'Dx11'H, heavy duty HDPE)	1	Each	\$5,000	\$5,000
Low head transfer pumps (P-1A and P-1B, 200 gpm @ 30 ft, 3 HP)	2	Each	\$2,500	\$5,000
Reaction tank (5,600 gallons, 10'Dx11.5'H, heavy duty HDPE) with Grovhac 1/2-HP electrical paddle mixer	1	Each	\$8,000	\$8,000
Inclined plate clarifier (200-gpm capacity) with intergral flash and floc tanks and two mixers	1	Each	\$51,000	\$51,000
Clarifier access platform with ladder, grated steel	1	Each	\$20,000	\$20,000
Polymer blending system	1	Each	\$12,000	\$12,000
Filter press (10-cu.ft. automatic unit with automatic feed pump controls, self-dumping filter cake discharge hopper, and plate for reduced capacity operation)	1	Each	\$31,000	\$31,000
Air compressor (15-HP, 50-scfm, 2-stage, 120-gal tank)	1	Each	\$5,000	\$5,000
Double-diaphragm air-driven pump (P-2 and P-3, 1-inch discharge, 50-gpm max flow, 45-scfm air consumption)	2	Each	\$2,000	\$4,000
Sludge tank (30-deg cone bottom open top, 2,500 gallons, 7.5'Dx10'H, heavy duty HDPE) with stand	1	Each	\$5,000	\$5,000
Sludge tank top platform with access ladder (grated steel)	1	Each	\$10,000	\$10,000
Volumetric screw feeder (adjustable rate, 5-cu.ft. hopper, 304S, 0.028 to 2.8 cu.ft./hour feed rate)	1	Each	\$9,000	\$9,000
Effluent tank (4,200 gallons, 8.5'Dx11'H, heavy duty HDPE)	1	Each	\$5,000	\$5,000
Ferrous sulfate chemical feed pump	1	Each	\$2,000	\$2,000
Electronic flowmeter (250-gpm capacity)	1	Each	\$2,000	\$2,000
High head transfer pumps (P-4A and P-4B, 200-gpm @ 60 ft, 5-HP)	2	Each	\$3,000	\$6,000
PLC-based control system with HMI and Web access	1	Each	\$25,000	\$25,000
Piping and fittings	1	Each	\$20,000	\$20,000
Instrumentation	1	Each	\$10,000	\$10,000
Existing equipment removal and disposal	1	Each	\$70,000	\$70,000
Installation (equipment, piping, instrumentaiton)	1	Lump sum	\$50,000	\$50,000
Installation (electrical)	1	Lump sum	\$20,000	\$20,000
Shipping	1	Lump sum	\$25,000	\$25,000
Subtotal				\$ 405,000
Contingency (@30%)				\$ 122,000
Contractor OH&P (@ 20%)				\$ 81,000
Engineering and Management (@ 20%)				\$ 81,000
<b>Total</b>				<b>\$689,000</b>

**GW-11 Water Balance Instrumentation Capital Cost Estimate**

<b>Item</b>	<b>No. of Units</b>	<b>Units</b>	<b>Unit Price</b>	<b>Extended Price</b>
Mobilization	1	Lump sum	\$5,000	\$ 5,000
Flowmeters - 8-inch diameter				
Flow Meter	2	Each	\$5,000	\$ 10,000
Pipe Material (Pipe, Flanges, Fittings)	2	Lump sum	\$12,000	\$ 24,000
Installation (Labor, Misc. Tools)	2	Lump sum	\$10,000	\$ 20,000
Electrical Conduit and Wiring	2	Lump sum	\$7,000	\$ 14,000
Flowmeters - 4-inch diameter				
Flow Meter	1	Each	\$3,000	\$ 3,000
Pipe Material (Pipe, Flanges, Fittings)	1	Lump sum	\$9,000	\$ 9,000
Installation (Labor, Misc Tools)	1	Lump sum	\$10,000	\$ 10,000
Electrical Conduit and Wiring	1	Lump sum	\$7,000	\$ 7,000
GW-11 Stilling Well and Level				
Pressure Transducer	1	Each	\$3,000	\$ 3,000
Pipe Material (Pipe, Support)	1	Lump sum	\$5,000	\$ 5,000
Installation (Labor, Misc. Tools)	1	Lump sum	\$7,000	\$ 7,000
Electrical Conduit and Wiring	1	Lump sum	\$8,000	\$ 8,000
Subtotal				\$ 125,000
Contingency (@30%)				\$ 38,000
Contractor OH&P (@ 20%)				\$ 25,000
PLC Modifications and Programming				\$ 52,000
Subtotal				\$ 240,000
Engineering and Management (@ 20%)				\$ 48,000
<b>Total</b>				<b>\$288,000</b>

**Well Field and Lift Station VFD Payback Estimate Summaries**

Pump Designation	Pump Information			Number of Pumps	Rated Flow	Average Flow	Maximum Recorded Flow	HP	kW	Hours Per Year	Annual kWh	Annual Cost (\$0.08/kWh)	Annual Flow (gallons)	Average/Maximum Ratio	Reduced Annual KWH	Reduced Annual kWh Cost	Cost Difference	Total VFD Installation Cost	VFD Payback Period (Years)
	Model Number	Power (HP)	Manufacturer																
<b>Seep Well Field</b>																			
PC-115R	85S50-3	NA	Grundfos	1	91.5	92.4	105.1	5	3.725	8760	32631	\$ 2,610	809,424	0.88	28,688	\$ 2,295	\$ 315		
PC-116R	150S200-11	20	Grundfos	1	124.8	127.8	153.3	7.5	5.5875	8760	48947	\$ 3,916	1,119,528	0.83	40,805	\$ 3,264	\$ 651		
PC-117	85S50-3	5	Grundfos	1	92.8	103.7	125	5	3.725	8760	32631	\$ 2,610	908,412	0.83	27,071	\$ 2,166	\$ 445		
PC-118	85S50-3	5	Grundfos	1	76.3	76.3	93.7	5	3.725	8760	32631	\$ 2,610	668,388	0.81	26,571	\$ 2,126	\$ 485		
PC-119	85S50-3	5	Grundfos	1	65	65.8	93	5	3.725	8760	32631	\$ 2,610	576,408	0.71	23,087	\$ 1,847	\$ 763		
PC-120	85S50-3	5	Grundfos	1	0	0.2	5	5	3.725	8760	32631	\$ 2,610	1,752	0.04	1,305	\$ 104	\$ 2,506		
PC-121	85S50-3	5	Grundfos	1	0	0.1	1.3	5	3.725	8760	32631	\$ 2,610	876	0.08	2,510	\$ 201	\$ 2,410		
PC-133	TBD	1.5	Grundfos	1	2.2	4.2	4.7	1.5	1.1175	8760	9789.3	\$ 783	36,792	0.89	8,748	\$ 700	\$ 83		
PC-99R3	150S200-11	20	Grundfos	1	58	61.6	87.8	5	3.725	8760	32631	\$ 2,610	539,616	0.70	22,894	\$ 1,831	\$ 779		
				<b>Totals</b>	<b>568.6</b>	<b>593.7</b>	<b>756.7</b>	<b>64</b>	<b>47.68</b>	<b>87,600</b>	<b>417,677</b>	<b>\$ 33,414</b>	<b>5,200,812</b>	<b>NA</b>	<b>273,254</b>	<b>\$ 21,860</b>	<b>\$ 11,554</b>	<b>\$ 88,000</b>	<b>7.62</b>
<b>Athens Road Well Field</b>																			
ART-1	40S20-7	2	Grundfos	1	33.0	19.9	23.6	2	1.49	8760	13052	\$ 1,044	174,324	0.84	11,006	\$ 880	\$ 164		
ART-1A	40S20-7	2	Grundfos	1															
ART-2	60S30-5	3	Grundfos	1	71	61.6	62.5	3	2.235	8760	19579	\$ 1,566	539,616	0.99	19,297	\$ 1,544	\$ 23		
ART-2A	60S30-5	3	Grundfos	1															
ART-3	40S20-7	3	Grundfos	1	54	46.1	49.2	1.5	1.1175	8760	9789	\$ 783	403,836	0.94	9,172	\$ 734	\$ 49		
ART-3A	40S20-7	2	Grundfos	1															
ART-4	40S20-7	1.5	Grundfos	1	10	11.5	15.8	1.5	1.1175	8760	9789	\$ 783	100,740	0.73	7,125	\$ 570	\$ 213		
ART-4A	40S20-7	1.5	Grundfos	1															
ART-6	25S07-5	0.75	Grundfos	1	47	49.8	62.4	0.75	0.55875	8760	4895	\$ 392	436,248	0.80	3,906	\$ 313	\$ 79		
ART-9	25S07-5	0.75	Grundfos	1															
ART-7A	40S15-5	1.5	Grundfos	1	32	30.7	31.7	0.75	0.55875	8760	4895	\$ 392	268,932	0.97	4,740	\$ 379	\$ 12		
ART-7B	40S15-5	1.5	Grundfos	1															
ART-8	40S15-5	1.5	Grundfos	1	85	61.7	71.2	5	3.725	8760	32631	\$ 2,610	540,492	0.87	28,277	\$ 2,262	\$ 348		
ART-8A	40S15-5	1.5	Grundfos	1															
PC-150	25S	1	Grundfos	1	0	4.5	4.5	1	0.745	8760	6526	\$ 522	39,420	1.00	6,526	\$ 522	\$ -		
				<b>Totals</b>	<b>332.0</b>	<b>285.8</b>	<b>320.9</b>	<b>15.5</b>	<b>11.5475</b>	<b>70,080</b>	<b>101,156</b>	<b>\$ 8,092.49</b>	<b>2,503,608</b>	<b>NA</b>	<b>90,050</b>	<b>\$ 7,204.02</b>	<b>\$ 888.47</b>	<b>\$ 136,000</b>	<b>153.07</b>
<b>Interceptor Well Field</b>																			
I-AA	NA	0.5	Grundfos	1	1.5	0.9	1.4	0.5	0.3725	8760	3263	\$ 261	7,884	0.642857143	2,098	\$ 168	\$ 93		
I-AB	NA	0.5	Grundfos	1	0.2	0	0.4	0.5	0.3725	8760	3263	\$ 261	-	0	-	\$ -	\$ 261		
I-AC	NA	0.5	Grundfos	1	0.2	0	0.1	0.5	0.3725	8760	3263	\$ 261	-	0	-	\$ -	\$ 261		
I-AD	NA	0.5	Grundfos	1	0.2	0	0.4	0.5	0.3725	8760	3263	\$ 261	-	0	-	\$ -	\$ 261		
I-A-R	NA	0.5	TBD	1	1	1	1.6	0.5	0.3725	8760	3263	\$ 261	8,760	0.63	2,039	\$ 163	\$ 98		
I-B	NA	0.5	Grundfos	1	1.5	1.4	1.8	0.5	0.3725	8760	3263	\$ 261	12,264	0.78	2,538	\$ 203	\$ 58		
I-C	NA	0.5	Grundfos	1	6	5.5	7	0.5	0.3725	8760	3263	\$ 261	48,180	0.79	2,564	\$ 205	\$ 56		
I-D	NA	0.5	Grundfos	1	2	1.9	3.3	0.5	0.3725	8760	3263	\$ 261	16,644	0.58	1,879	\$ 150	\$ 111		
I-E	NA	0.5	Grundfos	1	1.5	2.1	2.9	0.5	0.3725	8760	3263	\$ 261	18,396	0.72	2,363	\$ 189	\$ 72		
I-F	NA	0.5	Grundfos	1	5.7	4.4	4.8	0.5	0.3725	8760	3263	\$ 261	38,544	0.92	2,991	\$ 239	\$ 22		
I-G	NA	0.5	Grundfos	1	0.5	0.6	1.1	0.5	0.3725	8760	3263	\$ 261	5,256	0.55	1,780	\$ 142	\$ 119		
I-H	NA	0.5	Grundfos	1	1.2	1	1.5	0.5	0.3725	8760	3263	\$ 261	8,760	0.67	2,175	\$ 174	\$ 87		
I-I	NA	0.5	Grundfos	1	5	4.8	4.9	0.5	0.3725	8760	3263	\$ 261	42,048	0.98	3,197	\$ 256	\$ 5		
I-J	NA	0.5	Grundfos	1	8	5.7	7	0.5	0.3725	8760	3263	\$ 261	49,932	0.81	2,657	\$ 213	\$ 48		
I-K	NA	0.5	Grundfos	1	4	4	5.3	0.5	0.3725	8760	3263	\$ 261	35,040	0.75	2,463	\$ 197	\$ 64		
I-L	NA	0.5	Grundfos	1	2.5	2.1	3.3	0.5	0.3725	8760	3263	\$ 261	18,396	0.64	2,077	\$ 166	\$ 95		
I-M	NA	0.5	Grundfos	1	2.6	2.7	5	0.5	0.3725	8760	3263	\$ 261	23,652	0.54	1,762	\$ 141	\$ 120		

**Well Field and Lift Station VFD Payback Estimate Summaries (continued)**

Pump Designation	Pump Information			Number of Pumps	Rated Flow	Average Flow	Maximum Recorded Flow	HP	kW	Hours Per Year	Annual kWh	Annual Cost (\$0.08/kWh)	Annual Flow (gallons)	Average/Maximum Ratio	Reduced Annual KWH	Reduced Annual kWh Cost	Cost Difference	Total VFD Installation Cost	VFD Payback Period (Years)
	Model Number	Power (HP)	Manufacturer																
<b>Interceptor Well Field (continued)</b>																			
I-N	NA	0.5	Grundfos	1	3.5	2	3.2	0.5	0.3725	8760	3263	\$ 261	17,520	0.63	2,039	\$ 163	\$ 98		
I-O	NA	0.5	Grundfos	1	2.5	2.1	3.6	0.5	0.3725	8760	3263	\$ 261	18,396	0.58	1,903	\$ 152	\$ 109		
I-P	NA	0.5	Grundfos	1	3	4.1	6.2	0.5	0.3725	8760	3263	\$ 261	35,916	0.66	2,158	\$ 173	\$ 88		
I-Q	NA	0.5	Grundfos	1	2.5	0.5	1.1	0.5	0.3725	8760	3263	\$ 261	4,380	0.45	1,483	\$ 119	\$ 142		
I-R	NA	0.5	Grundfos	1	2.5	2.8	3.9	0.5	0.3725	8760	3263	\$ 261	24,528	0.72	2,343	\$ 187	\$ 74		
I-S	NA	0.5	Grundfos	1	5	4.3	5.2	0.5	0.3725	8760	3263	\$ 261	37,668	0.83	2,698	\$ 216	\$ 45		
I-T	NA	0.5	Grundfos	1	0.4	0.4	0.7	0.5	0.3725	8760	3263	\$ 261	3,504	0.57	1,865	\$ 149	\$ 112		
I-U	NA	0.5	Grundfos	1	0.8	1	1.5	0.5	0.3725	8760	3263	\$ 261	8,760	0.67	2,175	\$ 174	\$ 87		
I-V	NA	0.5	Grundfos	1	4.8	5.4	5.9	0.5	0.3725	8760	3263	\$ 261	47,304	0.92	2,987	\$ 239	\$ 22		
I-W	NA	0.5	Grundfos	1	1.5	0.7	1.1	0.5	0.3725	8760	3263	\$ 261	6,132	0.64	2,077	\$ 166	\$ 95		
I-X	NA	0.5	Grundfos	1	3	2.9	4.3	0.5	0.3725	8760	3263	\$ 261	25,404	0.67	2,201	\$ 176	\$ 85		
I-Y	NA	0.5	Grundfos	1	3	1.3	1.6	0.5	0.3725	8760	3263	\$ 261	11,388	0.81	2,651	\$ 212	\$ 49		
I-Z	NA	0.5	Grundfos	1	8	6.8	8.8	0.5	0.3725	8760	3263	\$ 261	59,568	0.77	2,521	\$ 202	\$ 59		
<b>Totals</b>					<b>84.1</b>	<b>72.4</b>	<b>98.9</b>	<b>15</b>	<b>11.175</b>	<b>262,800</b>	<b>97,893</b>	<b>\$ 7,831</b>	<b>634,224</b>	<b>NA</b>	<b>61,684</b>	<b>\$ 4,935</b>	<b>\$ 2,897</b>	<b>\$ 262,000</b>	<b>90.45</b>
<b>Lift Stations</b>																			
LS1 VT Pumps	CATM and size 12CHC-4 stages	40	NA	2	975	877.5	NA	40	29.8	8760	261048	\$ 20,884	8,541,000	0.90	234,943	\$ 18,795	\$ 2,088		
LS2 VT Pumps	VIT-CFTM and size 12CHC-5 stages	150	NA	2	1340	1206	NA	150	111.75	8760	978930	\$ 78,314	10,564,560	0.90	881,037	\$ 70,483	\$ 7,831		
LS3 Submersible Pumps	4VCX	20	NA	2	850	765	NA	20	14.9	8760	130524	\$ 10,442	6,701,400	0.90	117,472	\$ 9,398	\$ 1,044		
Effluent Goulds Pump	3196 LTi and size 4x6-10G	200	NA	2	1425	1282.5	NA	200	149	8760	1305240	\$ 104,419	11,234,700	0.90	1,174,716	\$ 93,977	\$ 10,442		
<b>Totals</b>					<b>4590</b>	<b>4131</b>	<b>NA</b>	<b>410</b>	<b>305.45</b>	<b>NA</b>	<b>2675742</b>	<b>\$ 214,059</b>	<b>37,041,660</b>	<b>NA</b>	<b>2,408,168</b>	<b>\$ 192,653</b>	<b>\$ 21,406</b>	<b>\$ 292,000</b>	<b>13.64</b>



**APPENDIX D**  
**PROPOSED LIFT STATION PUMP CURVES AND DATA**



To: Tetra Tech

Date: 7/23/15

Quote: PB15-196

ATTN: Caroline Verlander

Reference: Henderson NV Lift Station

---

<u>Quantity</u>	<u>Description</u>	<u>Price</u>
-----------------	--------------------	--------------

**Myers Quote**

**Design Points: 850 GPM @ 62' TDH**

- |   |  |  |
|---|--|--|
| 1 | Myers pump model 4VCX submersible water. The unit will be driven by a 20 HP, 460/3/60 explosion proof submersible motor. |  |
| 1 | Discharge Elbow  |  |
| 2 | 20' sections of stainless steel guide pipe   |  |
| 1 | 25' sections of stainless steel lifting chain and shackles   |  |
| 1 | Stainless steel upper guide bar bracket  |  |

Your total net price for the pump, panel & appurtenances listed above-----\$ 16,233.00

Notes and Clarifications:

1. Equipment sizing and configuration based on the drawings.
2. Taxes are not included in the pricing.
3. Anything not specifically listed above is not included.

Terms: Net 30 days with approved credit

Submittal data: Approx. 4 weeks if required

Delivery: Approx. 12-14 weeks

Freight: FOB factory w/ freight charges allowed

Quote valid: 30 days

Charles Greaves / Peter Botsonis

## STANDARD TERMS AND CONDITIONS

Price is FOB factory. Price does not include any freight charges. Price does not include any applicable duties or sales tax, use tax, excise tax, value-added or other similar taxes that may apply to this equipment and/or project. Unless specifically stated, price does not include manual or automatic controls, starters, protective or signal devices, wiring, anchor bolts, gauges, vibration isolation devices, installation, startup or testing.

If the price is included in a proposal, the price is firm for receipt of an order within 30 days of the date shown on the proposal. Any additional terms and conditions included in the proposal are specifically included in these terms and conditions.

Payment terms are net 30 days with approved credit. An interest charge of 1-1/2% per month will be added to balances over 30 days. Retainage of any invoiced amount is unacceptable unless specifically agreed to by Company at the time of order, and shall in no case exceed a period of 120 days. If payments are not timely received by Company, and this account is turned over to an attorney for collections, Customer agrees to pay all reasonable costs and attorney fees incurred in collection of the past due amounts.

Payment of "commercial transaction" invoices by credit card will be charged a fee based upon Cogent's average discount rate for credit card transactions for the prior calendar year. This fee will change annually and is currently 2.55%.

All equipment either rented from or through Company is subject to all of the terms and conditions listed on the back of the rental contract. Pricing does not include any overtime running of power equipment.

In no event shall Company's obligations and liabilities under this Agreement include any direct, indirect, punitive, special, incidental or consequential damages or losses that Customer may suffer or incur in connection with this sale, service or rental, including, but not limited to, loss of revenue or profits, damages or losses as a result of Customer's inability to operate, perform its obligations to third persons or injuries to goodwill; nor shall Company's liability extend to damages or losses Customer may suffer or incur as a result of such claims, suits or other proceedings made or instituted against Customer by third parties. Customer remises, releases and discharges Company from any and all liability or damages which might be caused by failure to deliver any equipment within the agreed time by Company.


Customer shall be responsible for determining the good operating condition of all materials and equipment prior to accepting the materials and equipment. **NO WARRANTY OR GUARANTEE, EXPRESS OR IMPLIED, INCLUDING ANY WARRANTY AS TO MERCHANTABILITY OR FITNESS FOR ANY PARTICULAR PURPOSE IS MADE UNLESS THE SAME IS SPECIFICALLY SET FORTH IN WRITING AND ACCEPTED IN WRITING BY COMPANY, BUT IN SUCH CASE THE WARRANTY OR GUARANTEE IS LIMITED AS ABOVE PROVIDED.** Notwithstanding the foregoing, Company will pass through to the Customer any warranty provided by the manufacturer of any equipment supplied by Company.

Customer covenants and agrees to defend, indemnify and hold Company harmless from any claims, damages or liability arising out of the use, maintenance or delivery of the equipment or materials purchased or rented hereunder. Customer shall further defend, indemnify and hold Company harmless from any and all damages to third persons or to property caused by Customer's use or possession of the equipment or materials, to the fullest extent allowable by law.

In connection with a proposal, if Customer has any further questions or comments regarding the proposal, please feel free to contact Company. If the proposal meets with Customer's approval, please sign, date and mail or fax a copy of the proposal back to Company's office, and the identified equipment will be ordered and/or scheduled for delivery.

This agreement shall be governed by the laws of the state where the Company's branch office is located from which the equipment is rented or purchased. Customer further agrees that venue and jurisdiction shall be appropriate in the county in which Company's branch office is located from which the equipment was rented or purchased. Any provisions hereof which may prove unenforceable under any law shall not affect the validity of any other provision hereof.

Revised January 2015

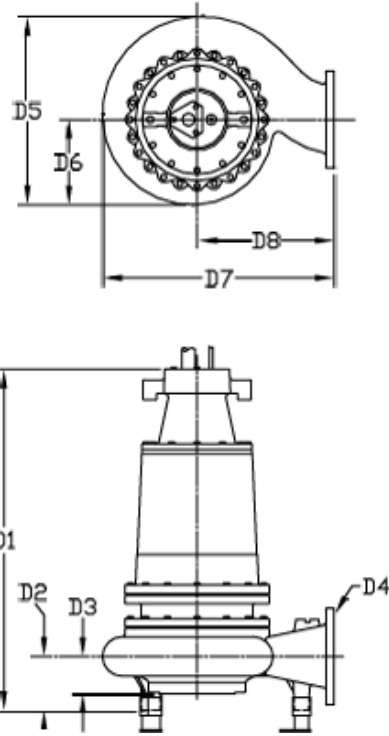

All dimensions are in inches

D1	D2	D3	D4	D5	D6	D7	D8	D9	D10	D11	D12	D13	D14	D15	D16	D17	D18	D19	D20	D21
38.50		4.13	4.00	18.00	8.50	22.00	13.00													
D22	D23	D24	D25	D26	D27	D28	D29	D30	D31	D32	D33	D34	D35	D36	D37	D38	D39	D40	D41	D42

Motor Data				
Environment	Ordinary	Frame Size	250	
Horse Power	20.00 hp	RPM	1,750 rpm	
Voltage/Phase	460/3	Hertz	60 Hz	
Oil Type	Dielectric transformer	Cord Size	8-4	
Cord Length	35 ft	Cord Jacket Matl	W	
Pump Data				
Seal Type	Dual Mechanical Seal	O-Ring Matl	Nitrile	
Upper Seal Matl	Carbon ceramic - Nitrile	Lower Seal Matl	Carbon ceramic - Nitrile	
Impeller Matl	Ductile Iron	Impeller Wear Ring Matl	None	
Volute Matl	Cast iron	Volute Wear Ring Matl	None	
Discharge Orientation	Horizontal discharge	Discharge Configuration	Flanged discharge	
Pump Coating Matl	Green air dry enamel			
General Data				
GPM	850.0 USgpm	Liquid Temperature	0.00 deg F	
TDH	62.00 ft	Specific Gravity	1.000 SG	
Solid Handling Size	3.19 in	pH	0	
Impeller Diameter	0	Viscosity	1.00 cP	
Rail System	None	Wet Well Depth	0	
Estimated Weights				
Pump	0	Driver	0	
Base	0	Accessories	0	
		Total	0	
Pump Flanges				
Flange	Size	Rating	Facing	
Suction	0	0	0	
Discharge	0	0	0	
Flange	"X" Force	"Y" Force	"Z" Force	Resultant Force
Suction	0	0	0	0
Discharge	0	0	0	0
Flange	"X" Moment	"Y" Moment	"Z" Moment	Resultant Moment
Suction	0	0	0	0
Discharge	0	0	0	0
Notes:				
1. All dimensions are in inches				
-				
Certification Correct				
Customer				
Customer Quote #				
Job Name	-			
Market	-			
Pump Size	Myers - 4VC/4VCX			
	Item #	004		
	Date Drawn	-		
	Date Approved	-		

Item number	: 004	Size	: Myers - 4VC/4VCX
Service	:	Stages	: 1
Quantity	: 1	Based on curve number	: SUB_S_E_AH_00027_E_4 Rev 2012-03-23
Quote number	: 353586	Date last saved	: 23 Jul 2015 3:18 PM

**Operating Conditions**

Flow, rated	: 850.0 USgpm
Differential head / pressure, rated (requested)	: 62.00 ft
Differential head / pressure, rated (actual)	: 61.88 ft
Suction pressure, rated / max	: 0.00 / 0.00 psi.g
NPSH available, rated	: Ample
Frequency	: 60 Hz

**Performance**

Speed, rated	: 1,750 rpm
Impeller diameter, rated	: 9.38 in
Impeller diameter, maximum	: 12.00 in
Impeller diameter, minimum	: 8.00 in
Efficiency	: 73.64 %
NPSH required / margin required	: - / 0.00 ft
nq (imp. eye flow) / S (imp. eye flow)	: N/A Metric units
Minimum Continuous Stable Flow	: 234.4 USgpm
Head, maximum, rated diameter	: 94.43 ft
Head rise to shutoff	: 52.61 %
Flow, best eff. point (BEP)	: 929.7 USgpm
Flow ratio (rated / BEP)	: 91.43 %
Diameter ratio (rated / max)	: 78.13 %
Head ratio (rated dia / max dia)	: 46.75 %
Cq/Ch/Ce/Cn [ANSI/HI 9.6.7-2010]	: 1.00 / 1.00 / 1.00 / 1.00
Selection status	: Acceptable

**Liquid**

Liquid type	: Water
Additional liquid description	:
Solids diameter, max	: 0.00 in
Solids concentration, by volume	: 0.00 %
Temperature, max	: 68.00 deg F
Fluid density, rated / max	: 1.000 / 1.000 SG
Viscosity, rated	: 1.00 cP
Vapor pressure, rated	: 0.34 psi.a

**Material**


Material selected	: Standard
-------------------	------------

**Pressure Data**

Maximum working pressure	: 40.87 psi.g
Maximum allowable working pressure	: N/A
Maximum allowable suction pressure	: N/A
Hydrostatic test pressure	: N/A

**Driver & Power Data**

Driver sizing specification	: Rated power
Margin over specification	: 0.00 %
Service factor	: 1.00
Power, hydraulic	: 13.28 hp
Power, rated	: 18.03 hp
Power, maximum, rated diameter	: 20.81 hp
Minimum recommended motor rating	: 20.00 hp / 14.91 kW

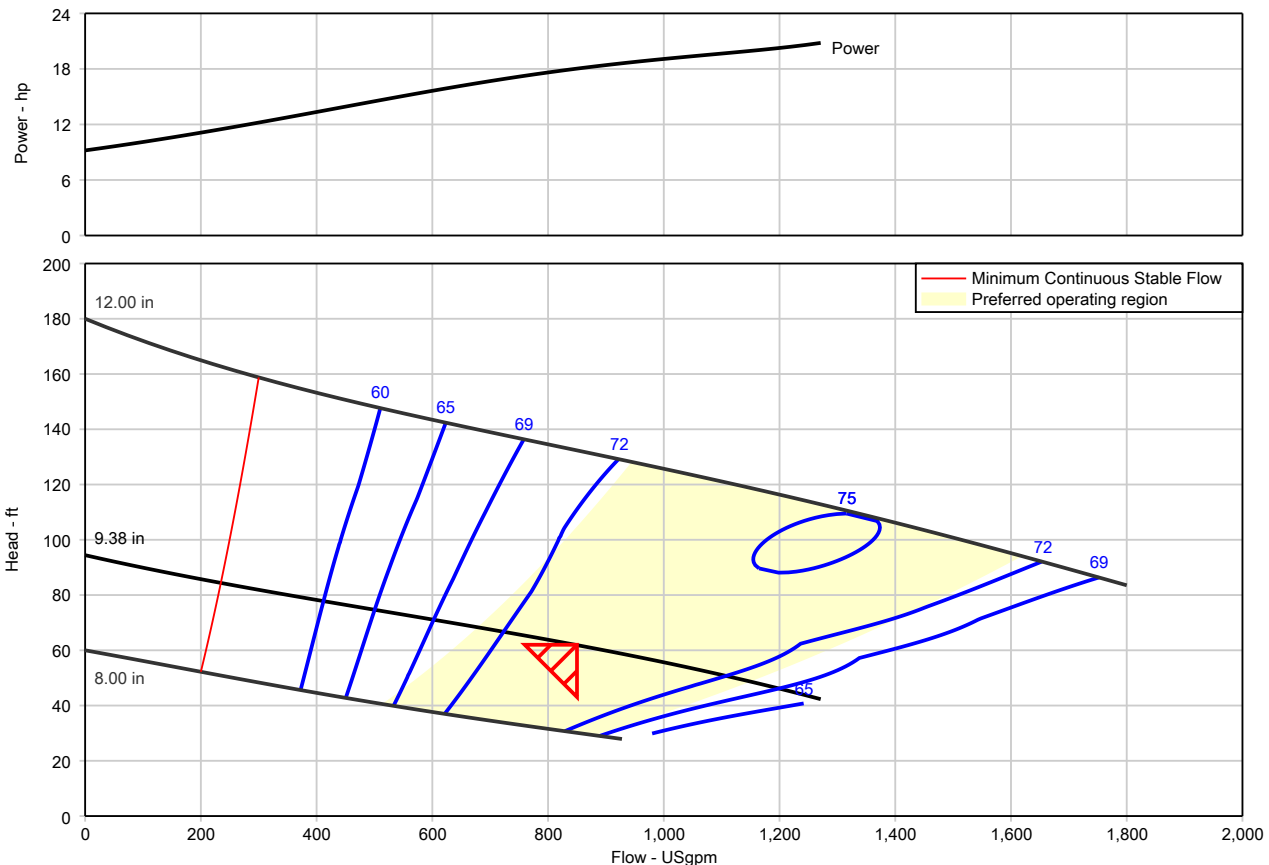

DXP/Quadna  
14452 W 44th Ave  
Golden, CO 80403

Attention: **Caroline Verlander**

July 22, 2015  
9001-150722-027 - 0

Thank you for your inquiry. Please find enclosed our quotation for your review and acceptance.

Please let me know if you have any questions or require any further clarification.

Respectfully,

**Chad Post**

External Goulds  
303-215-4981  
cpost@quadna.com

Quote Number: 9001-150722-027

DXP/Quadna  
14452 W 44th Ave  
Golden, CO 80403

July 22, 2015

Terms: FCA

Job:

We are pleased to quote you for the following equipment, subject to Xylem approval and acceptance of Xylem terms and conditions of sale. Quantities are not guaranteed and should be verified, with any Prices adjusted, prior to placing an order. This quotation is subject to change without notice and void after August 21, 2015.

Item #	Qty	Description		
1	1	<b>VIT - Short Set Lineshaft Turbine Pumps</b> Lineshaft Turbine: Open Lineshaft, 12CHC/4-Stage, VIT-CATM		<b>\$21,052.00</b>
			<b>2,241.00 (lb) wt.</b>	
1.1	1	<b>Bowl Assembly</b> 12CHC / 4-STG / Manufacturer's Standard		
			<b>635.00 (lb) wt.</b>	
1.2	1	<b>Column Assembly</b> 8" x 1.19" Threaded W/L Column		
			<b>555.00 (lb) wt.</b>	
1.3	1	<b>Discharge Head Assembly</b> 6" x 12.0" CA Head		
			<b>335.00 (lb) wt.</b>	
1.4	1	<b>Driver Assembly</b> TECO VHS 40 HP 1800 RPM 324TP		
			<b>716.00 (lb) wt.</b>	
1.5	1	<b>Tests and Services</b> Hydrostatic Testing (Non-Witness): Bowl Performance Testing (Non-Witness): Lab Motor, Bowl Assembly		
			<b>(lb) wt.</b>	
2	1	<b>VIT - Short Set Lineshaft Turbine Pumps</b> Lineshaft Turbine: Open Lineshaft, 12CHC/5-Stage, VIT-CFTM		<b>\$27,080.00</b>
			<b>3,929.00 (lb) wt.</b>	
2.1	1	<b>Bowl Assembly</b> 12CHC / 5-STG / Manufacturer's Standard		
			<b>759.00 (lb) wt.</b>	
2.2	1	<b>Column Assembly</b> 8" x 1.50" Threaded W/L Column		
			<b>555.00 (lb) wt.</b>	

Quote Number: 9001-150722-027

Item #	Qty	Description	
2.3	1	<b>Discharge Head Assembly</b> 8" x 16.5" CF Head	
			<b>540.00 (lb) wt.</b>
2.4	1	<b>Driver Assembly</b> GE VHS 150 HP 1800 RPM L444TP	
			<b>2,075.00 (lb) wt.</b>
2.5	1	<b>Tests and Services</b> Hydrostatic Testing (Non-Witness): Bowl Performance Testing (Non-Witness): Lab Motor, Bowl Assembly	
			<b>(lb) wt.</b>
		<b>Total Quotation Net Price USD</b>	<b>\$48,132.00</b>
		<b>Total Weight (lb)</b>	<b>6,170.00</b>



## OPERATING CONDITIONS

Temp / SG	70° F / SP.GR 1.00
Fluid Type	Water
Lubrication Method	Water (Open Lineshaft)
Vapor Pressure	0.3633 psi
Viscosity	0.9695 cP
Specified Flow	975.00 USGPM
Total Dynamic Head	306.00 ft
Pumping Level	1.000 ft
TPL	0.000 ft
Sump/Pit Depth	20.000 ft
Documentation	Standard pump installation and operation manual and order data

## PERFORMANCE AT 1770 RPM

Bowl Efficiency	88.30 @design, 88.90 Best Efficiency
Run Out Capacity	1800.00 USGPM
Power	85.00 @design, 101.00 NOL (Hp)
Npshr	12.10 ft @design
Design Thrust	2594.50 @design (lb)
Shut off Pressure	150.20 psi

## MATERIALS AND DIMENSIONS

Bowl	Cast iron with glass enamel		
Suction Bell	Cast Iron CL30		
Bowl Wear Ring	Not Included		
Impeller	316SS		
Impeller Diameter	8.3100 inch		
Impeller Wear Ring	Not Included		
Impeller Balance	Manufacturer's Standard		
Impeller Lock Method	Taper lock	Key Material	None
Bowl Shaft	416SS, 1.6875 inch diam.		
Suction Bearing	Bronze C90300 "G" Modified		
Bowl Bearings	Bronze C90300 "G" Modified		
Rifled Drill Shaft	No		
Collets	Carbon steel		
Strainer Type	None Not Included		
Tube Bearing Adapter Material	Not Included		
Column	Carbon Steel, 8" [203mm] (in) diam., 14.39 ft, Threaded		
Column Shaft Diameter	416SS, 1.1875 (in) diam.		
Column Bearing Retainer	304SS		
Lineshaft Bearings	Rubber EPDM		
Column Bearing Options	Not Included		
Max Bearing Space	10 ft (3 m) Spacing		
Lineshaft Coupling	416SS		

### DO NOT USE FOR CONSTRUCTION UNLESS CERTIFIED

Certified by	
Date of certification	
Pump serial number	
Project Name	
Tag:	

Column Shaft Sleeve	Not Included
Tube Material	Carbon Steel
Discharge Head	Cast Iron CL30
Discharge Head Style	CA
Discharge Flange	8 (in), 125#
Head Shaft Coupling	CS Type AR Rigid
Steel Sub Base	Not Included
150# Disch Companion Flange	Not Included
300# Disch Convenience Flange	Not Included
Head Bolting	Carbon steel
Head Sleeve	None
Thrust Pot	Not Required
Sealing Method	Mechanical Seal
Packing	
Mechanical Seal	John Crane 5610 XF551058H

## DRIVER INFORMATION

Motor Type	
Motor Manufacturer	TECO
Rating	40 Hp
Efficiency Level	
Motor Part Number	TN0401812119
Enclosure	WP1
Phase / Frequency / Volts	3 / 60 Hz / 230/460
Speed	1800 RPM

## TESTING

Hydrostatic:	Hydrostatic Testing (Non-Witness): Bowl
Performance:	Performance Testing (Non-Witness): Lab Motor, Bowl Assembly
Vibration:	None
NPSH:	None
Post Inspection:	None
Final Inspection:	None
Other:	None

## COATING

Coating Information:	Goulds Water Technology Standard Blue Enamel; Bowl Assembly - STD; Column Assembly - STD; Head Assembly - STD
----------------------	---

## ADDITIONAL FEATURES

- Additional Bowl Features
- Additional Column Features
- Additional Head Features:
- Additional Driver Features:

<b>DO NOT USE FOR CONSTRUCTION UNLESS CERTIFIED</b>	
Certified by	
Date of certification	
Pump serial number	
Project Name	
Tag:	



# TURBINE SUBMITTAL

Quote Number: 9001-150722-027:1

Model: VIT-CATM

Size: 12CHC 4 Stage(s)

Additional Can features:

Additional Misc features:

## WEIGHTS

Total bowl weight	635 lbs
Total column weight	555 lbs
Discharge head weight	335.00 lbs
Driver weight	716.00 lbs
Approximate net weight	2241.00 lbs

Our offer does not include specific review and incorporation of any Statutory or Regulatory Requirements and the offer is limited to the requirements of the design specifications. Should any Statutory or Regulatory requirements need to be reviewed and incorporated then the Customer is responsible to identify those and provide copies for review and revision of our offer.

Our quotation is offered in accordance with our comments and exceptions identified in our proposal and governed by our standard terms and conditions of sale – Xylem Americas attached hereafter.

For units requiring performance test, all performance tests will be conducted per ANSI/HI 14.6 standards unless otherwise noted in the selection software submittal documents. Test results meeting with grade 2B tolerances for pumps with a rated shaft power of 134HP or less and grade 1B for greater than 134HP will be considered passing.

Customer is responsible for verifying that the recommendations made and the materials selected are satisfactory for the Customer's intended environment and Customer's use of the selected pump. Customer is responsible for determining the suitability of Xylem recommendations for all operating conditions within Customer's and/or End User's control. Xylem disclaims all warranties, express or implied warranties, including, but not limited to, warranties of merchantability and fitness for a particular purpose and all express warranties other than the limited express warranty set forth in the attached standard terms and conditions of sale – Xylem Americas attached hereafter.

Xylem does not guarantee any pump intake configuration. The hydraulic and structural adequacies of these structures are the sole responsibility of the Customer or his representatives. Further, Xylem accepts no liability arising out of unsatisfactory pump intake field operating conditions.

The Customer or his representatives are referred to the Hydraulic Institute Standards for recommendations on pump intake design. To optimize the hydraulic design of a field pump intake configuration, the Customer should strongly consider performing a detailed scale model pump intake study. However, the adequacies of these recommendations are the sole responsibility of the Customer.

### DO NOT USE FOR CONSTRUCTION UNLESS CERTIFIED

Certified by	
Date of certification	
Pump serial number	
Project Name	
Tag:	

## OVERALL PUMP PARAMETERS

Capacity:	975.00 USGPM	Total Dynamic Head:	306.00 ft
Total Pump Length:	0.000 ft	Impeller Trim:	8.3100 inch
Pump Type:	VIT - Short Set Lineshaft Turbine Pumps	Head Type:	Type CA (Cast Iron A-Head)
Pump K-Factor:	7.5000 lbs/ft	Number of Stages:	4
Additional Pump K-Factor:	7.5000 lbs/ft	Pumping Level:	1.000 ft
Pump Operating Speed [RPM]:	1770		

## LINE SHAFT RELATED DATA

Shaft Diameter:	1.1875 inch	Shaft Limit :	125 Hp
Shaft Material:	416SS	Material Correction Fact:	1.18
Line Shaft Length:	172.64 inch	Shaft Elongation:	0.01228 inch
Line Shaft Type:	Water (Open Lineshaft)	Impeller Running Clearance:	0.13 inch

## BOWL DATA

Total Bowl Length:	59.36 inch	Bowl Shaft Limit:	371 Hp
Bowl Shaft Diameter:	1.6875 inch	Bowl Shaft Material:	416SS
Bowl Diameter:	11.750 inch		

## COLUMN DATA

Column Diameter [in]:	8	Column Elongation:	0.00177 inch
Column Wall Thickness:	0.320 inch	Shut Off Column Elongation:	0.00201 inch
Column Load:	2808.80 lb		

## HORSEPOWER DATA

Shaft Friction Loss:	0.10419 Hp	Thrust Load Loss:	0.32343 Hp
Bowl Hp at Design:	85 Hp	Motor Hp:	40 Hp

## OTHER DATA

Hydraulic Thrust:	2294.80 lb	Thrust at Design:	2594.50 lb
Thrust at Shut Off:	2921.52 lb	Actual Head Above Grade:	304.19 ft
Available Lateral:	1.00 inch	Design Lateral:	0.14051 inch
Shut Off Lateral:	0.14274 inch		
Suction Head:	0.00 ft	Shut Off Discharge Pressure:	150.20 psi
Column Loss:	0.37 ft	NPSHa:	48.21 ft
Head Loss:	0.44 ft	NPSHr:	12.10 ft @design
Total Loss:	0.81 ft	NPSH Margin:	2.00 ft

## EFFICIENCY DATA

Bowl Efficiency:	88.90 %	Overall Efficiency:	81.50 %
Motor Efficiency:	93.00 %	KWH per 1000 gallons:	1.18
Pump Efficiency:	87.60 %		

## FLUID DATA


Fluid Type:	Water	Specific Gravity:	0.9999
Temperature:	70°F	Viscosity:	0.9695 cP

## COMPONENT WEIGHTS

Bowl Weight:	635 lbs	Column Weight:	555 lbs
Head Weight:	335 lbs	Can Weight:	0 lbs
Driver Weight:	716 lbs	Total Pump Weight:	2241 lbs

**DO NOT USE FOR CONSTRUCTION UNLESS CERTIFIED**

Certified by	
Date of certification	
Pump serial number	
Project Name	
Tag	

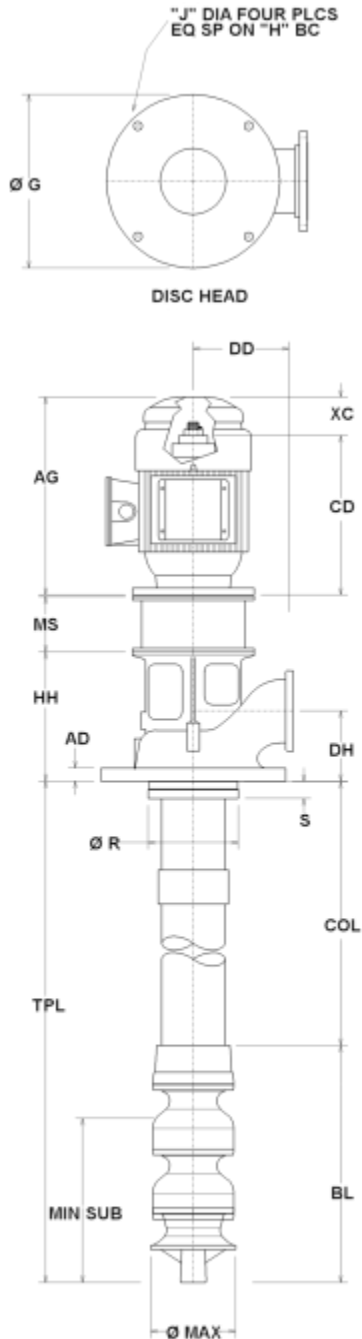

## DIMENSIONS

AD	1.00	inch
AG	32.71	inch
BD	12.0	inch
BL	59.36	inch
CD	28.22	inch
CL	0.00	inch
COL	172.68	inch
DD	12.00	inch
MIN SUB	23.87	inch
DH	6.75	inch
G	23.50	inch
H	21.25	inch
HH	15.50	inch
J	0.75	inch
L	0.00	inch
M		
R	10.25	inch
S	1.81	inch
SU	0.00	inch
SUT	0.00	inch
TUBE	0.00	inch
TPL	0.00	inch
UG	0.00	inch
V	0.00	inch
W	0.00	inch
X	0.00	inch
XC	4.49	inch
Y	0.00	inch
Z	0.00	inch
Max Dia	11.75	inch
Discharge	(125 #) 8	inch
Suction	(150 #) 8	inch

## Weights

Total bowl	635.00	lb
Total column	555	lb
Discharge head	335.00	lb
Driver	716.00	lb
Approx weight	2241.00	lb

## PUMP DATA

No. of Units	1.00
Model:	VIT-CATM 12CHC
Stages:	4
Col Size:	8" [203mm]
Shaft:	1.1875 in dia
Flow:	975.00 USGPM
Head:	306.00 ft
Driver Mfr:	TECO
Driver Type:	VHS
Size:	40 Hp
Speed:	1800 RPM
Phase:	3
Frequency:	60 Hz
Voltage:	230/460


No.	NOTES
1	Total Pump Length $\pm$ 1.0 inch.
2	Tolerance on all dimensions is .12 or $\pm$ .12 inch per 5 ft, whichever is greater.
3	All dimensions shown are in inches unless otherwise specified.
4	Drawing not to scale.
5	½" NPT – Gauge Conn (plugged)
6	Driver may be rotated at 90° intervals about vertical centerline for details refer to driver dimension drawing.
7	Before starting pump, impeller must be lifted 0.19 inch.
8	This assembly has been designed so that its natural frequency responses avoid the specific operating speeds by an adequate safety margin. The design has assumed the foundation to be rigid.

## DO NOT USE FOR CONSTRUCTION UNLESS CERTIFIED

Certified by	
Date of certification	
Pump serial number	
Project Name	
Tag	


## BILL OF MATERIAL

ITEM	Part Name	CODE	MATERIAL	ASTM#
<b>Discharge Head Assembly</b>				
600	Head – Discharge	1003	Cast Iron CL30	A48-94ae1
602	Head – Base Plate	N/A	Not Included	N/A
604	Nut – Adjusting	2242	Carbon Steel 1018	A108-99
608	Headshaft	2227	416SS	A582M-95b
616	Housing	1003	Cast Iron CL30	A48-94-ae1
617	Bearing-Housing	1109	Bronze C90300 "G" Modified	B584-00
626	Seal	0000	John Crane 5610 XF551058H	
730	Key – Motor GIB	2242	Carbon Steel 1018	A108-99
779	Gasket – Housing	5136	Acrylic/Nitrile	5136 Rev 4
<b>Column and Lineshaft Assembly</b>				
637	Hanger Flange	1003	Cast Iron CL30	A48-94ae1
642	Column Pipe	9645	Carbon Steel	A53
645	Column-Coupling	9645	Carbon Steel	A53
646	Lineshaft	2227	416SS	A582M-95b
649	Lineshaft Coupling	2265	416SS	A582M-95b
652	Retainer-Bearing	1205	304SS	A744M-00
656	Lineshaft Bearing	5121	Rubber EPDM	D3568-98
<b>Bowl Assembly</b>				
660	Bowl-Shaft	2227	416SS	A582M-95b
664	Bearing – Disc Bowl	1109	Bronze C90300 "G" Modified	B584-00
670	Bowl-Inter	6911	Cast Iron CL30 Enamel	A48-94e1
672	Bearing-Int Bowl	1109	Bronze C90300 "G" Modified	B584-00
673	Impeller	1203	316SS	A744M-00
677	Collet-Impeller	2242	Carbon steel	A108-99
674	Key-Impeller	N/A	None	N/A
680	Wear Ring-Bowl	N/A	Not Included	N/A
681	Wear Ring-Impeller	N/A	Not Included	N/A
688	Bowl/Bell-Suction	1003	Cast Iron CL30	A48-94e1
690	Bearing-Suction	1109	Bronze C90300 "G" Modified	B584-00
692	Sandcollar	1205	304SS	A744M-00
698	Strainer Type	N/A	None	N/A
747	Plug-Pipe	1046	Malleable Iron	A197
760	Capscrew-Hex	2298	Steel Bolting Gr8	J429-99

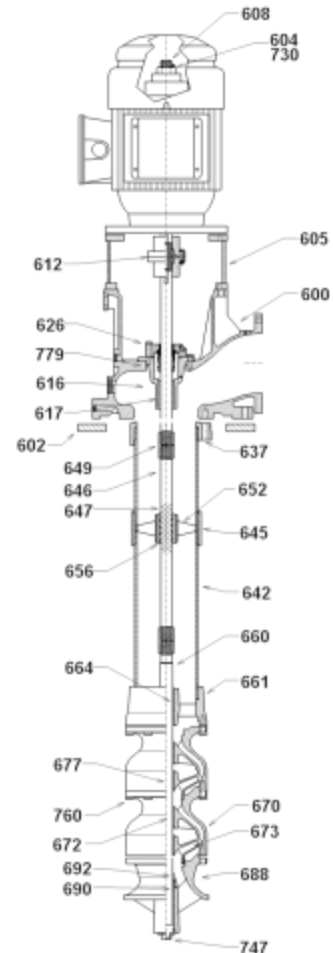

**DO NOT USE FOR CONSTRUCTION UNLESS CERTIFIED**

Certified by	
Date of certification	
Pump serial number	
Project Name	
Tag	

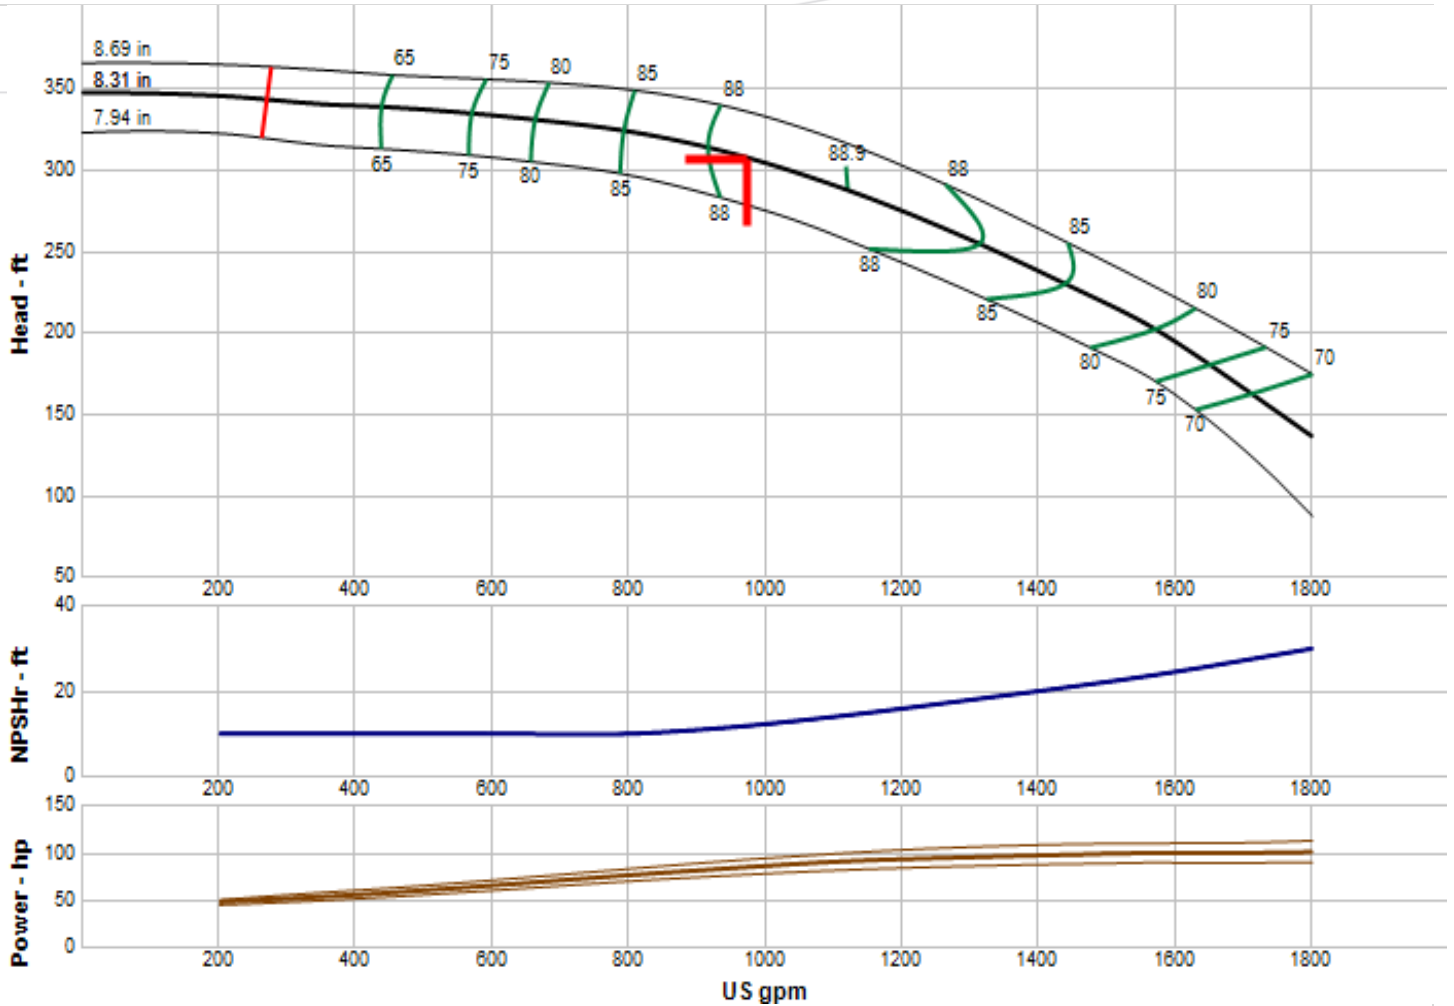

Driver Size Criteria:	Max power on design curve (NOL)	Best Efficiency:	88.90 %
Speed:	1770	Flow at BEP:	1120.00 USGPM
Impeller Trim:	8.3100 inch	Min Flow:	280.00 USGPM
Frequency:	60 Hz	Derate Factor:	0.0000
Additional Impeller Trim:	8.310 inch	NPSH Required:	12.10 ft
Impeller Maximum Trim:	8.6900 inch	Specified NPSH Avail:	34.00 ft
Specified Flow:	975.00 USGPM	Shut-Off Head:	347.00 ft
Specified Head:	305.00 ft	Fluid Type:	Water
Head at Design:	306.00 ft	Temperature / Specific Gravity:	70°F / 1.00
Efficiency at Design:	88.30 %	Viscosity:	0.9695 cP
Power at Design:	85.00 Hp	Allowable Sphere Size:	0.94 inch
Flow on Design Trim at Max Power:	1800 USGPM	Thrust K Factor:	7.5000 lbs/ft
Max Power on Design Curve:	101.00 Hp	Additional Thrust K Factor:	7.5000 lbs/ft
Run-Out Flow:	0.00 USGPM	Max Lateral:	1.00 inch
Run-Out Head:	0 ft		

**DO NOT USE FOR CONSTRUCTION UNLESS CERTIFIED**

Certified by	
Date of certification	
Pump serial number	
Project Name	
Tag	

## OPERATING CONDITIONS

Temp / SG	70° F / SP.GR 1.00
Fluid Type	Water
Lubrication Method	Water (Open Lineshaft)
Vapor Pressure	0.3633 psi
Viscosity	0.9695 cP
Specified Flow	1340.00 USGPM
Total Dynamic Head	311.00 ft
Pumping Level	5.000 ft
TPL	0.000 ft
Sump/Pit Depth	20.000 ft
Documentation	Standard pump installation and operation manual and order data

## PERFORMANCE AT 1770 RPM

Bowl Efficiency	87.10 @design, 88.90 Best Efficiency
Run Out Capacity	1800.00 USGPM
Power	121.00 @design, 126.00 NOL (Hp)
Npshr	19.00 ft @design
Design Thrust	2595.10 @design (lb)
Shut off Pressure	187.86 psi

## MATERIALS AND DIMENSIONS

Bowl	Cast iron with glass enamel		
Suction Bell	Cast Iron CL30		
Bowl Wear Ring	Not Included		
Impeller	316SS		
Impeller Diameter	8.3100 inch		
Impeller Wear Ring	Not Included		
Impeller Balance	Manufacturer's Standard		
Impeller Lock Method	Taper lock	Key Material	None
Bowl Shaft	416SS, 1.6875 inch diam.		
Suction Bearing	Bronze C90300 "G" Modified		
Bowl Bearings	Bronze C90300 "G" Modified		
Rifled Drill Shaft	No		
Collets	Carbon steel		
Strainer Type	None Not Included		
Tube Bearing Adapter Material	Not Included		
Column	Carbon Steel, 8" [203mm] (in) diam., 13.47 ft, Threaded		
Column Shaft Diameter	416SS, 1.5000 (in) diam.		
Column Bearing Retainer	304SS		
Lineshaft Bearings	Rubber EPDM		
Column Bearing Options	Not Included		
Max Bearing Space	10 ft (3 m) Spacing		
Lineshaft Coupling	416SS		

### DO NOT USE FOR CONSTRUCTION UNLESS CERTIFIED

Certified by	
Date of certification	
Pump serial number	
Project Name	
Tag:	



Column Shaft Sleeve	Not Included
Tube Material	Carbon Steel
Discharge Head	Cast Iron CL30
Discharge Head Style	CF
Discharge Flange	8 (in), 250#
Head Shaft Coupling	CS Type AR Rigid
Steel Sub Base	Not Included
150# Disch Companion Flange	Not Included
300# Disch Convenience Flange	Not Included
Head Bolting	Carbon steel
Head Sleeve	None
Thrust Pot	Not Required
Sealing Method	Mechanical Seal
Packing	
Mechanical Seal	John Crane 5610 XF551058H

## DRIVER INFORMATION

Motor Type	
Motor Manufacturer	GE
Rating	150 Hp
Efficiency Level	
Motor Part Number	GN1501820150
Enclosure	WP1
Phase / Frequency / Volts	3 / 60 Hz / 460PWS
Speed	1800 RPM

## TESTING

Hydrostatic:	Hydrostatic Testing (Non-Witness): Bowl
Performance:	Performance Testing (Non-Witness): Lab Motor, Bowl Assembly
Vibration:	None
NPSH:	None
Post Inspection:	None
Final Inspection:	None
Other:	None

## COATING

Coating Information:	Goulds Water Technology Standard Blue Enamel; Bowl Assembly - STD; Column Assembly - STD; Head Assembly - STD
----------------------	---

## ADDITIONAL FEATURES

Additional Bowl Features	None added
Additional Column Features	None added
Additional Head Features:	None added
Additional Driver Features:	None added

### DO NOT USE FOR CONSTRUCTION UNLESS CERTIFIED

Certified by	
Date of certification	
Pump serial number	
Project Name	
Tag:	



# TURBINE SUBMITTAL

Quote Number: 9001-150722-027:2

Model: VIT-CFTM

Size: 12CHC 5 Stage(s)

Additional Can features:	None added
Additional Misc features:	None added

## WEIGHTS

Total bowl weight	759 lbs
Total column weight	555 lbs
Discharge head weight	540.00 lbs
Driver weight	2075.00 lbs
Approximate net weight	3929.00 lbs

Our offer does not include specific review and incorporation of any Statutory or Regulatory Requirements and the offer is limited to the requirements of the design specifications. Should any Statutory or Regulatory requirements need to be reviewed and incorporated then the Customer is responsible to identify those and provide copies for review and revision of our offer.

Our quotation is offered in accordance with our comments and exceptions identified in our proposal and governed by our standard terms and conditions of sale – Xylem Americas attached hereafter.

For units requiring performance test, all performance tests will be conducted per ANSI/HI 14.6 standards unless otherwise noted in the selection software submittal documents. Test results meeting with grade 2B tolerances for pumps with a rated shaft power of 134HP or less and grade 1B for greater than 134HP will be considered passing.

Customer is responsible for verifying that the recommendations made and the materials selected are satisfactory for the Customer's intended environment and Customer's use of the selected pump. Customer is responsible for determining the suitability of Xylem recommendations for all operating conditions within Customer's and/or End User's control. Xylem disclaims all warranties, express or implied warranties, including, but not limited to, warranties of merchantability and fitness for a particular purpose and all express warranties other than the limited express warranty set forth in the attached standard terms and conditions of sale – Xylem Americas attached hereafter.

Xylem does not guarantee any pump intake configuration. The hydraulic and structural adequacies of these structures are the sole responsibility of the Customer or his representatives. Further, Xylem accepts no liability arising out of unsatisfactory pump intake field operating conditions.

The Customer or his representatives are referred to the Hydraulic Institute Standards for recommendations on pump intake design. To optimize the hydraulic design of a field pump intake configuration, the Customer should strongly consider performing a detailed scale model pump intake study. However, the adequacies of these recommendations are the sole responsibility of the Customer.

**DO NOT USE FOR CONSTRUCTION UNLESS CERTIFIED**

Certified by	
Date of certification	
Pump serial number	
Project Name	
Tag:	

## OVERALL PUMP PARAMETERS

Capacity:	1340.00 USGPM	Total Dynamic Head:	311.00 ft
Total Pump Length:	0.000 ft	Impeller Trim:	8.3100 inch
Pump Type:	VIT - Short Set Lineshaft Turbine Pumps	Head Type:	Type CF (Cast Iron F-Head)
Pump K-Factor:	7.5000 lbs/ft	Number of Stages:	5
Additional Pump K-Factor:	7.5000 lbs/ft	Pumping Level:	5.000 ft
Pump Operating Speed [RPM]:	1770		

## LINE SHAFT RELATED DATA

Shaft Diameter:	1.5000 inch	Shaft Limit :	256 Hp
Shaft Material:	416SS	Material Correction Fact:	1.18
Line Shaft Length:	161.64 inch	Shaft Elongation:	0.00736 inch
Line Shaft Type:	Water (Open Lineshaft)	Impeller Running Clearance:	0.13 inch

## BOWL DATA

Total Bowl Length:	70.36 inch	Bowl Shaft Limit:	371 Hp
Bowl Shaft Diameter:	1.6875 inch	Bowl Shaft Material:	416SS
Bowl Diameter:	11.750 inch		

## COLUMN DATA

Column Diameter [in]:	8	Column Elongation:	0.00166 inch
Column Wall Thickness:	0.320 inch	Shut Off Column Elongation:	0.00229 inch
Column Load:	2808.80 lb		

## HORSEPOWER DATA

Shaft Friction Loss:	0.14912 Hp	Thrust Load Loss:	0.33443 Hp
Bowl Hp at Design:	121 Hp	Motor Hp:	121 Hp

## OTHER DATA

Hydraulic Thrust:	2332.30 lb	Thrust at Design:	2595.10 lb
Thrust at Shut Off:	3541.41 lb	Actual Head Above Grade:	304.53 ft
Available Lateral:	1.00 inch	Design Lateral:	0.13570 inch
Shut Off Lateral:	0.13820 inch		
Suction Head:	0.00 ft	Shut Off Discharge Pressure:	187.86 psi
Column Loss:	0.64 ft	NPSHa:	44.21 ft
Head Loss:	0.83 ft	NPSHr:	19.00 ft @design
Total Loss:	1.47 ft	NPSH Margin:	2.00 ft

## EFFICIENCY DATA

Bowl Efficiency:	88.90 %	Overall Efficiency:	82.00 %
Motor Efficiency:	95.00 %	KWH per 1000 gallons:	1.19
Pump Efficiency:	86.30 %		

## FLUID DATA


Fluid Type:	Water	Specific Gravity:	0.9999
Temperature:	70°F	Viscosity:	0.9695 cP

## COMPONENT WEIGHTS

Bowl Weight:	759 lbs	Column Weight:	555 lbs
Head Weight:	540 lbs	Can Weight:	0 lbs
Driver Weight:	2075 lbs	Total Pump Weight:	3929 lbs

**DO NOT USE FOR CONSTRUCTION UNLESS CERTIFIED**

Certified by	
Date of certification	
Pump serial number	
Project Name	
Tag	

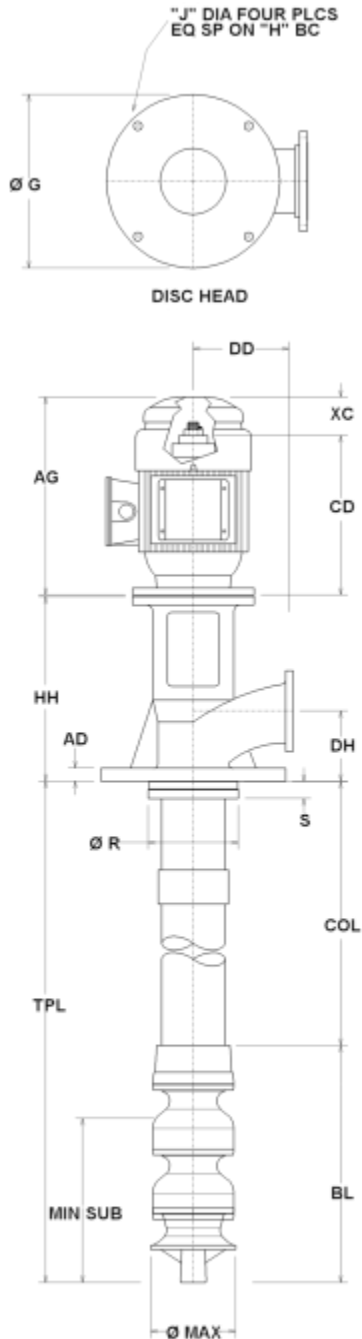

### DIMENSIONS

AD	1.19	inch
AG	50.11	inch
BD	20.0	inch
BL	70.36	inch
CD	44.80	inch
CL	0.00	inch
COL	161.64	inch
DD	12.00	inch
MIN SUB	26.57	inch
DH	8.75	inch
G	21.00	inch
H	18.75	inch
HH	26.00	inch
J	0.75	inch
L	0.00	inch
M		
R	12.00	inch
S	2.06	inch
SU	0.00	inch
SUT	0.00	inch
TUBE	0.00	inch
TPL	0.00	inch
UG	0.00	inch
V	0.00	inch
W	0.00	inch
X	0.00	inch
XC	0.00	inch
Y	0.00	inch
Z	0.00	inch
Max Dia	11.75	inch
Discharge	(250 #) 8	inch
Suction	(150 #) 10	inch

### Weights

Total bowl	759.00	lb
Total column	555	lb
Discharge head	540.00	lb
Driver	2075.00	lb
Approx weight	3929.00	lb

### PUMP DATA

No. of Units	1.00
Model:	VIT-CFTM 12CHC
Stages:	5
Col Size:	8" [203mm]
Shaft:	1.5000 in dia
Flow:	1340.00 USGPM
Head:	311.00 ft
Driver Mfr:	GE
Driver Type:	VHS
Size:	121 Hp
Speed:	1800 RPM
Phase:	3
Frequency:	60 Hz
Voltage:	460PWS


No.	NOTES
1	Total Pump Length $\pm$ 1.0 inch.
2	Tolerance on all dimensions is .12 or $\pm$ .12 inch per 5 ft, whichever is greater.
3	All dimensions shown are in inches unless otherwise specified.
4	Drawing not to scale.
5	1/2" NPT – Gauge Conn (plugged)
6	Driver may be rotated at 90° intervals about vertical centerline for details refer to driver dimension drawing.
7	Before starting pump, impeller must be lifted 0.19 inch.
8	This assembly has been designed so that its natural frequency responses avoid the specific operating speeds by an adequate safety margin. The design has assumed the foundation to be rigid.

### DO NOT USE FOR CONSTRUCTION UNLESS CERTIFIED

Certified by	
Date of certification	
Pump serial number	
Project Name	
Tag	


## BILL OF MATERIAL

ITEM	Part Name	CODE	MATERIAL	ASTM#
<b>Discharge Head Assembly</b>				
600	Head – Discharge	1003	Cast Iron CL30	A48-94ae1
602	Head – Base Plate	N/A	Not Included	N/A
604	Nut – Adjusting	2242	Carbon Steel 1018	A108-99
608	Headshaft	2227	416SS	A582M-95b
616	Housing	1003	Cast Iron CL30	A48-94-ae1
617	Bearing-Housing	1109	Bronze C90300 "G" Modified	B584-00
626	Seal	0000	John Crane 5610 XF551058H	
730	Key – Motor GIB	2242	Carbon Steel 1018	A108-99
779	Gasket – Housing	5136	Acrylic/Nitrile	5136 Rev 4
<b>Column and Lineshaft Assembly</b>				
637	Hanger Flange	1003	Cast Iron CL30	A48-94ae1
642	Column Pipe	9645	Carbon Steel	A53
645	Column-Coupling	9645	Carbon Steel	A53
646	Lineshaft	2227	416SS	A582M-95b
649	Lineshaft Coupling	2265	416SS	A582M-95b
652	Retainer-Bearing	1205	304SS	A744M-00
656	Lineshaft Bearing	5121	Rubber EPDM	D3568-98
<b>Bowl Assembly</b>				
660	Bowl-Shaft	2227	416SS	A582M-95b
664	Bearing – Disc Bowl	1109	Bronze C90300 "G" Modified	B584-00
670	Bowl-Inter	6911	Cast Iron CL30 Enamel	A48-94e1
672	Bearing-Int Bowl	1109	Bronze C90300 "G" Modified	B584-00
673	Impeller	1203	316SS	A744M-00
677	Collet-Impeller	2242	Carbon steel	A108-99
674	Key-Impeller	N/A	None	N/A
680	Wear Ring-Bowl	N/A	Not Included	N/A
681	Wear Ring-Impeller	N/A	Not Included	N/A
688	Bowl/Bell-Suction	1003	Cast Iron CL30	A48-94e1
690	Bearing-Suction	1109	Bronze C90300 "G" Modified	B584-00
692	Sandcollar	1205	304SS	A744M-00
698	Strainer Type	N/A	None	N/A
747	Plug-Pipe	1046	Malleable Iron	A197
760	Capscrew-Hex	2298	Steel Bolting Gr8	J429-99

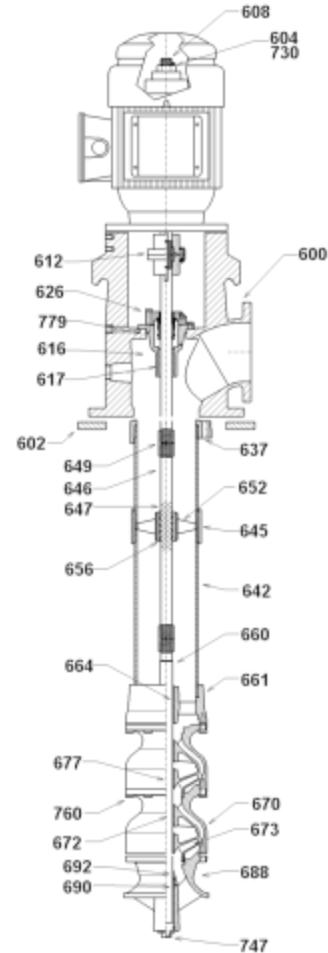

**DO NOT USE FOR CONSTRUCTION UNLESS CERTIFIED**

Certified by	
Date of certification	
Pump serial number	
Project Name	
Tag	

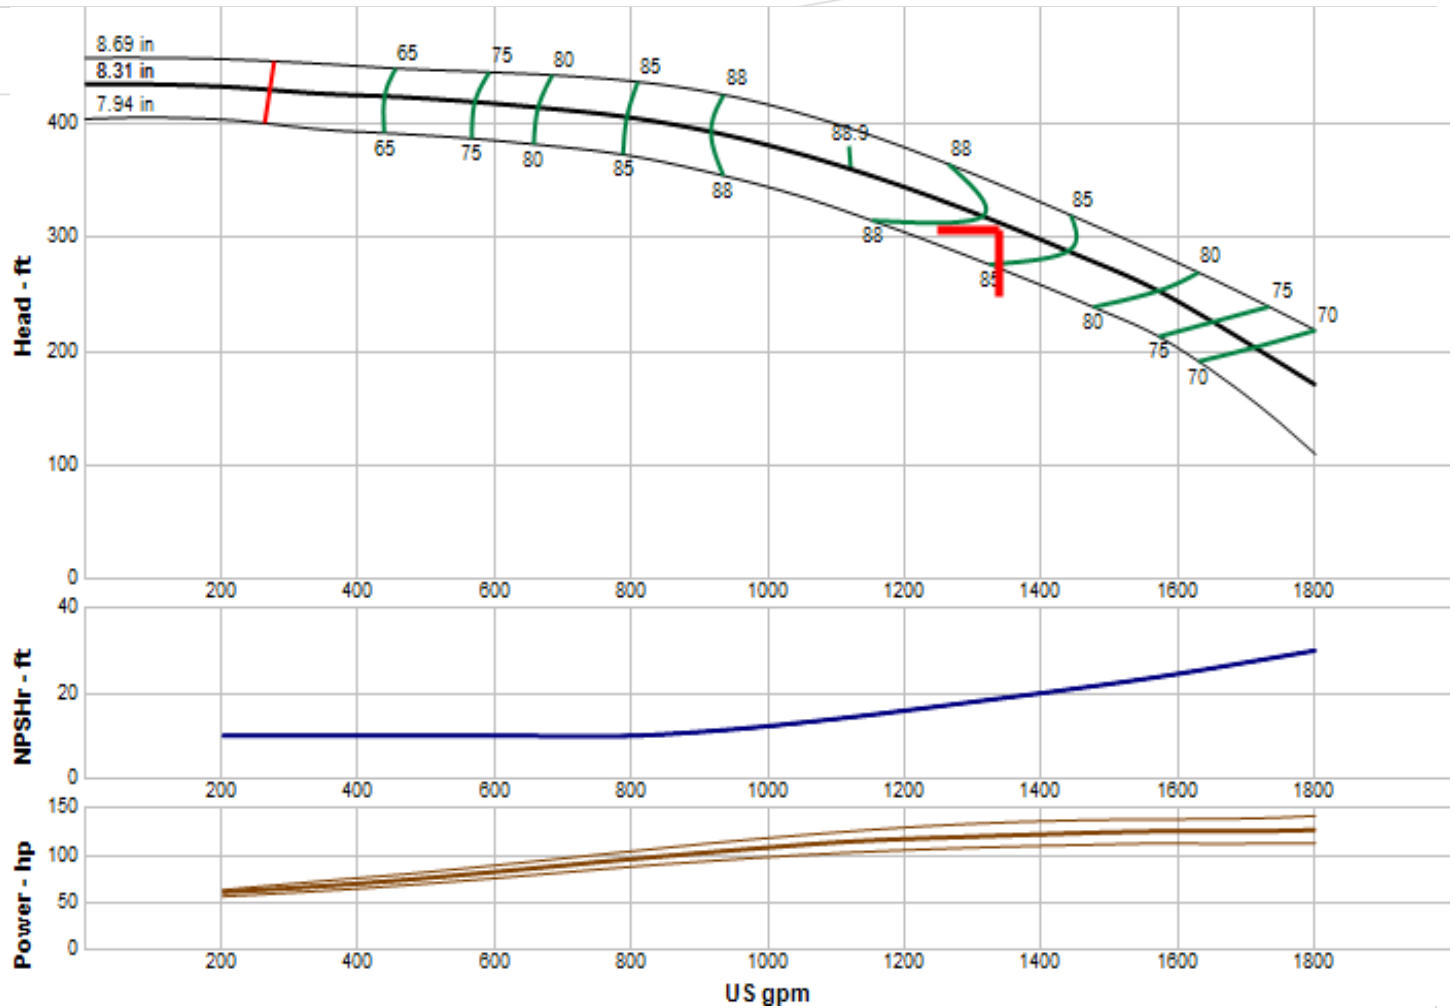

Driver Size Criteria:	Max power on design curve (NOL)	Best Efficiency:	88.90 %
Speed:	1770	Flow at BEP:	1120.00 USGPM
Impeller Trim:	8.3100 inch	Min Flow:	280.00 USGPM
Frequency:	60 Hz	Derate Factor:	0.0000
Additional Impeller Trim:	8.310 inch	NPSH Required:	19.00 ft
Impeller Maximum Trim:	8.6900 inch	Specified NPSH Avail:	34.00 ft
Specified Flow:	1340.00 USGPM	Shut-Off Head:	434.00 ft
Specified Head:	305.00 ft	Fluid Type:	Water
Head at Design:	311.00 ft	Temperature / Specific Gravity:	70°F / 1.00
Efficiency at Design:	87.10 %	Viscosity:	0.9695 cP
Power at Design:	121.00 Hp	Allowable Sphere Size:	0.94 inch
Flow on Design Trim at Max Power:	1800 USGPM	Thrust K Factor:	7.5000 lbs/ft
Max Power on Design Curve:	126.00 Hp	Additional Thrust K Factor:	7.5000 lbs/ft
Run-Out Flow:	0.00 USGPM	Max Lateral:	1.00 inch
Run-Out Head:	0 ft		

**DO NOT USE FOR CONSTRUCTION UNLESS CERTIFIED**

Certified by	
Date of certification	
Pump serial number	
Project Name	
Tag	



**1. Agreement, Integration and Conflict of Terms.** These terms and conditions, together with any special conditions expressly incorporated thereto in the quotation or sales form, are to govern any sale between the Seller and Buyer. The Seller shall mean the applicable affiliate of Xylem Inc. that is party to the Agreement ("Seller"). The Buyer shall mean the entity that is party to the Agreement with Seller. This writing is an offer or counteroffer by Seller to sell the goods and/or services set forth on the quotation or sales form subject to these terms and conditions and is expressly made conditional on Buyer's assent to these terms and conditions. Acceptance by Buyer is expressly limited to these terms and conditions. Any additional or different terms and conditions contained in Buyer's purchase order or other communication shall not be effective or binding upon Seller unless specifically agreed to in writing by Seller; Seller hereby objects to any such conditions, and the failure of Seller to object to specific provisions contained in any purchase order or other communication from Buyer shall not be construed as a waiver of these terms and conditions nor an acceptance of any such provisions. Neither Seller's commencement of performance nor delivery shall be deemed or construed as acceptance of Buyer's additional or different terms and conditions. Buyer agrees that these terms and conditions, together with any accompanying quotation and any special conditions or limited process guarantees or documents referred to or included within the quotation and expressly made a part of this agreement, (e.g., drawings, illustrations, specifications, or diagrams), is the complete and final agreement between Buyer and the Seller ("Agreement"). This Agreement supersedes all prior negotiations, representations, or agreements, either written or oral, between the parties and, further, can only be altered, modified or amended with the express written consent of Seller.

**2. Quotation, Withdrawal, Expiration.** Quotes are valid for thirty (30) calendar days from the date of issuance unless otherwise provided therein. Seller reserves the right to cancel or withdraw the quotation at any time with or without notice or cause prior to acceptance by Buyer. There is no Agreement if any conditions specified within the quotation **or** sales form are not completed by Buyer to Seller's satisfaction within thirty (30) calendar days of Seller's acknowledgement in writing of an order. Seller nevertheless reserves its right to accept any contractual documents received from Buyer after this 30-day period.

**3. Prices.** Prices apply to the specific quantities stated on the quotation or sales form. Unless otherwise agreed to in writing by Seller, all prices are Ex Works Seller's plant (as defined in accordance with the latest version of Incoterms), and do not include transportation costs or charges relating to transportation, which costs and charges shall be solely the responsibility of Buyer. Prices include standard packing according to Seller's specifications for delivery. All costs and taxes for special packing requested by Buyer, including packing for exports, shall be paid by Buyer as an additional charge. Prices are subject to change without notice.

**4. Taxes.** The price for the goods does not include any applicable sales, use, excise, GST, VAT, or similar tax, duties or levies. Buyer shall have the responsibility for the payment of such taxes if applicable.

**5. Payment Terms.** Seller reserves the right to require payment in advance or C.O.D. and otherwise modify credit terms should Buyer's credit standing not meet Seller's acceptance. Unless different payment terms are expressly set forth in the quotation or sales form or order acknowledgment or Sales Policy Manual, goods will be invoiced upon shipment. **Payment shall be made in U.S. Dollars.** Payment in full is due within thirty (30) days from the invoice date. In the event payment is not made when due, Buyer agrees to pay Seller a service or finance charge of the lesser of (i) one and one-half percent (1.5%) per month (18% per annum), or (ii) the highest rate permitted by applicable law, on the unpaid balance of the invoice from and after the invoice due date. Buyer is responsible for all costs and expenses associated with any checks returned due to insufficient funds. All credit sales are subject to prior approval of Seller's credit department. Export shipments will require payment prior to shipment or an appropriate Letter of Credit. If, during the performance of the contract with Buyer, the financial responsibility or condition of Buyer is such that Seller in good faith deems itself insecure, or if Buyer becomes insolvent, or if a material change in the ownership of Buyer occurs, or if Buyer fails to make any payments in accordance with the terms of its contract with Seller, then, in any such event, Seller is not obligated to continue performance under the contract and may stop goods in transit and defer or decline to make delivery of goods, except upon receipt of satisfactory security or cash payments in

advance, or Seller may terminate the order upon written notice to Buyer without further obligation to Buyer whatsoever. If Buyer fails to make payments or fails to furnish security satisfactory to Seller, then Seller shall also have the right to enforce payment to the full contract price of the work completed and in process. Upon default by Buyer in payment when due, Buyer shall immediately pay to Seller the entire unpaid amounts for any and all shipments made to Buyer irrespective of the terms of said shipment and whether said shipments are made pursuant to this Agreement or any other contract of sale between Seller and Buyer, and Seller may withhold all subsequent shipments until the full amount is settled. Acceptance by Seller of less than full payment shall not be a waiver of any of its rights hereunder. Buyer shall not assign or transfer this Agreement or any interest in it, or monies payable under it, without the written consent of Seller and any assignment made without such consent shall be null and void.

**6. Delivery, Risk of Loss.** Delivery dates are estimates, and time is not of the essence. All shipments will be made Ex Works Seller's plant or Distribution Center unless otherwise specified. Seller shall not be responsible to Buyer for any loss, whether direct, indirect, incidental or consequential in nature, including without limitation loss of profits, arising out of or relating to any failure of the goods to be delivered by the specified delivery date. In the absence of specific instructions, Seller will select the carrier. Upon delivery to the common carrier, title and the risk of loss for the material shall pass to Buyer. Buyer shall reimburse Seller for the additional cost of its performance resulting from inaccurate or lack of delivery instructions, or by any act or omission on Buyer's part. Any such additional cost may include, but is not limited to, storage, insurance, protection, re-inspection and delivery expenses. Buyer further agrees that any payment due on delivery shall be made on delivery into storage as though goods had been delivered in accordance with the order.

Buyer grants to Seller a continuing security interest in and a lien upon the products and the proceeds thereof (including insurance proceeds), as security for the payment of all such amounts and the performance by Buyer of all of its obligations to Seller pursuant to the order and all such other sales, and Buyer shall have no right to sell, encumber or dispose of the products. Buyer shall execute any and all financing statements and other documents and instruments and do and perform any and all other acts and things which Seller may consider necessary, desirable or appropriate to establish, perfect or protect Seller's title, security interest and lien. In addition, Buyer authorizes Seller and its agents and employees to execute any and all such documents and instruments and do and perform any and all such acts and things, at Buyer's expense, in Buyer's name and on its behalf. Such documents and instruments may also be filed without the signature of Buyer to the extent permitted by law.

**7. Warranty.** For goods sold by Seller to Buyer that are used by Buyer for personal, family or household purposes, Seller warrants the goods to Buyer on the terms of Seller's limited warranty available on Seller's website. For goods sold by Seller to Buyer for any other purpose, Seller warrants that the goods sold to Buyer hereunder (with the exception of membranes, seals, gaskets, elastomer materials, coatings and other "wear parts" or consumables all of which are not warranted except as otherwise provided in the quotation or sales form) will be (i) be built in accordance with the specifications referred to in the quotation or sales form, if such specifications are expressly made a part of this Agreement, and (ii) free from defects in material and workmanship for a period of one (1) year from the date of installation or eighteen (18) months from the date of shipment (which date of shipment shall not be greater than thirty (30) days after receipt of notice that the goods are ready to ship), whichever shall occur first, unless a longer period is provided by law or is specified in the product documentation (the "Warranty").

Except as otherwise provided by law, Seller shall, at its option and at no cost to Buyer, either repair or replace any product which fails to conform with the Warranty; provided, however, that under either option, Seller shall not be obligated to remove the defective product or install the replaced or repaired product and Buyer shall be responsible for all other costs, including, but not limited to, service costs, shipping fees and expenses. Seller shall have complete discretion as to the method or means of repair or replacement. Buyer's failure to comply with Seller's repair or replacement directions shall constitute a waiver of its rights and render all warranties void. Any parts repaired or replaced under the Warranty are warranted only for the balance of the warranty period on the parts that were repaired or



replaced. The Warranty is conditioned on Buyer giving written notice to Seller of any defects in material or workmanship of warranted goods within ten (10) days of the date when any defects are first manifest. Seller shall have no warranty obligations to Buyer with respect to any product or parts of a product that: (a) have been repaired by third parties other than Seller or without Seller's written approval; (b) have been subject to misuse, misapplication, neglect, alteration, accident, or physical damage; (c) have been used in a manner contrary to Seller's instructions for installation, operation and maintenance; (d) have been damaged from ordinary wear and tear, corrosion, or chemical attack; (e) have been damaged due to abnormal conditions, vibration, failure to properly prime, or operation without flow; (f) have been damaged due to a defective power supply or improper electrical protection; or (g) have been damaged resulting from the use of accessory equipment not sold by Seller or not approved by Seller in connection with products supplied by Seller hereunder. In any case of products not manufactured by Seller, there is no warranty from Seller; however, Seller will extend to Buyer any warranty received from Seller's supplier of such products.

**THE FOREGOING WARRANTY IS EXCLUSIVE AND IN LIEU OF ANY AND ALL OTHER EXPRESS OR IMPLIED WARRANTIES, GUARANTEES, CONDITIONS OR TERMS OF WHATEVER NATURE RELATING TO THE GOODS PROVIDED HEREUNDER, INCLUDING WITHOUT LIMITATION ANY IMPLIED WARRANTIES OF MERCHANTABILITY AND FITNESS FOR A PARTICULAR PURPOSE, WHICH ARE HEREBY EXPRESSLY DISCLAIMED AND EXCLUDED. EXCEPT AS OTHERWISE PROVIDED BY LAW, BUYER'S EXCLUSIVE REMEDY AND SELLER'S AGGREGATE LIABILITY FOR BREACH OF ANY OF THE FOREGOING WARRANTIES ARE LIMITED TO REPAIRING OR REPLACING THE PRODUCT AND SHALL IN ALL CASES BE LIMITED TO THE AMOUNT PAID BY THE BUYER HEREUNDER. IN NO EVENT IS SELLER LIABLE FOR ANY OTHER FORM OF DAMAGES, WHETHER DIRECT, INDIRECT, LIQUIDATED, INCIDENTAL, CONSEQUENTIAL, PUNITIVE, EXEMPLARY OR SPECIAL DAMAGES, INCLUDING BUT NOT LIMITED TO LOSS OF PROFIT, LOSS OF ANTICIPATED SAVINGS OR REVENUE, LOSS OF INCOME, LOSS OF BUSINESS, LOSS OF PRODUCTION, LOSS OF OPPORTUNITY OR LOSS OF REPUTATION.**

**8. Inspection.** Buyer shall have the right to inspect the goods upon their receipt. When delivery is to Buyer's site or to a project site ("Site"), Buyer shall notify Seller in writing of any nonconformity of the goods with this Agreement within three (3) days from receipt by Buyer. For all other deliveries, Buyer shall notify Seller in writing of any nonconformity with this Agreement within fourteen (14) days from receipt by Buyer. Failure to give such applicable notice shall constitute a waiver of Buyer's right to inspect and/or reject the goods for nonconformity and shall be equivalent to an irrevocable acceptance of the goods by Buyer. Claims for loss of or damage to goods in transit must be made to the carrier, and not to Seller.

**9. Seller's Limitation of Liability. EXCEPT AS OTHERWISE PROVIDED BY LAW, IN NO EVENT SHALL SELLER'S LIABILITY UNDER THIS AGREEMENT EXCEED THE AMOUNT PAID BY BUYER UNDER THIS AGREEMENT. SELLER SHALL HAVE NO LIABILITY FOR LOSS OF PROFIT, LOSS OF ANTICIPATED SAVINGS OR REVENUE, LOSS OF INCOME, LOSS OF BUSINESS, LOSS OF PRODUCTION, LOSS OF OPPORTUNITY, LOSS OF REPUTATION, INDIRECT, CONSEQUENTIAL, INCIDENTAL, PUNITIVE OR EXEMPLARY DAMAGES.**

**10. Force Majeure.** Seller may cancel or suspend this Agreement and Seller shall have no liability for any failure to deliver or perform, or for any delay in delivering or performing any obligations, due to acts or omissions of Buyer and/or its contractors, or due to circumstances beyond Seller's reasonable control, including but not limited to acts of God, fire, flood or other natural disasters, war and civil disturbance, riot, acts of governments, terrorism, disease, currency restrictions, labor shortages or disputes, unavailability of materials, fuel, power, energy or transportation facilities, failures of suppliers or subcontractors to effect deliveries, in which case the time for performance shall be extended in an amount equal to the excused period, provided that Seller shall have, as soon as reasonably practicable after it has actual knowledge of the beginning of any excusable delay, notified Buyer of such delay, of the reason therefor and of the probable duration and consequence thereof. Seller shall use its best efforts to

eliminate the cause of the delay, interruption or cessation and to resume performance of its obligations hereunder with the least possible delay.

**11. Cancellation.** Except as otherwise provided in this Agreement, no order may be cancelled on special or made-to-order goods or unless otherwise requested in writing by either party and accepted in writing by the other. In the event of a cancellation by Buyer, Buyer shall, within thirty (30) days of such cancellation, pay Seller a cancellation fee, which shall include all costs and expenses incurred by Seller prior to the receipt of the request for cancellation including, but not limited to, all commitments to its suppliers, subcontractors and others, all fully burdened labor and overhead expended by Seller, plus a reasonable profit charge." Return of goods shall be in accordance with Seller's most current Return Materials Authorization and subject to a minimum fifteen percent (15%) restocking fee.

Notwithstanding anything to the contrary herein, in the event of the commencement by or against Buyer of any voluntary or involuntary proceedings in bankruptcy or insolvency, or in the event Buyer shall be adjusted bankrupt, make a general assignment for the benefit of its creditors, or if a receiver shall be appointed on account of Buyer's insolvency, or if Buyer fails to make payment when due under this Agreement, or in the event Buyer does not correct or, if immediate correction is not possible, commence and diligently continue action to correct any default of Buyer to comply with any of the provisions or requirements of this Agreement within ten (10) calendar days after being notified in writing of such default by Seller, Seller may, by written notice to Buyer, without prejudice to any other rights or remedies which Seller may have, terminate its further performance of this Agreement. In the event of such termination, Seller shall be entitled to receive payment as if Buyer has cancelled the Agreement as per the preceding paragraph. Seller may nevertheless elect to complete its performance of this Agreement by any means it chooses. Buyer agrees to be responsible for any additional costs incurred by Seller in so doing. Upon termination of this Agreement, the rights, obligations and liabilities of the parties which shall have arisen or been incurred under this Agreement prior to its termination shall survive such termination.

**12. Drawings.** All drawings are the property of Seller. Seller does not supply detailed or shop working drawings of the goods; however, Seller will supply necessary installation drawings. The drawings and bulletin illustrations submitted with Seller's quotation show general type, arrangement and approximate dimensions of the goods to be furnished for Buyer's information only and Seller makes no representation or warranty regarding their accuracy. Unless expressly stated to the contrary within the quotation or sales form, all drawings, illustrations, specifications or diagrams form no part of this Agreement. Seller reserves the right to alter such details in design or arrangement of its goods which, in its judgment, constitute an improvement in construction, application or operation. All engineering information necessary for installation of the goods shall be forwarded by Seller to Buyer to upon Buyer's acceptance of this Agreement. After Buyer's acceptance of this Agreement, any changes in the type of goods, the arrangement of the goods, or application of the goods requested by Buyer will be made at Buyer's expense. Instructions necessary for installation, operating and maintenance will be supplied when the goods are shipped.

**13. Proprietary Information, Injunction.** Seller's designs, illustrations, drawings, specifications, technical data, catalogues, "know-how", economic or other business or manufacturing information (collectively "Proprietary Information") disclosed to Buyer shall be deemed proprietary and confidential to Seller. Buyer agrees not to disclose, use, or reproduce any Proprietary Information without first having obtained Seller's express written consent. Buyer's agreement to refrain from disclosing, using or reproducing Proprietary Information shall survive completion of the work under this Agreement. Buyer acknowledges that its improper disclosure of Proprietary Information to any third party will result in Seller's suffering irreparable harm. Seller may seek injunctive or equitable relief to prevent Buyer's unauthorized disclosure.

**14. Installation and Start-up.** Unless otherwise agreed to in writing by Seller, installation shall be the sole responsibility of Buyer. Where start-up service is required with respect to the goods purchased hereunder, it must be performed by Seller's authorized personnel or agents; otherwise, the Warranty is void. In the event Buyer has engaged Seller to provide an engineer for start-up supervision, such engineer will function in a supervisory capacity only and Seller shall have no responsibility for the





quality of workmanship of the installation. In any event, Buyer understands and agrees that it shall furnish, at Buyer's expense, all necessary foundations, supplies, labor and facilities that might be required to install and operate the goods.

**15. Specifications.** Changes in specifications requested by Buyer are subject to approval in writing by Seller. In the event such changes are approved, the price for the goods and the delivery schedule shall be changed to reflect such changes.

**16. Buyer Warranty.** Buyer warrants the accuracy of any and all information relating to the details of its operating conditions, including temperatures, pressures, and where applicable, the nature of all hazardous materials. Seller can justifiably rely upon the accuracy of Buyer's information in its performance. Should Buyer's information prove inaccurate, Buyer agrees to reimburse Seller for any losses, liabilities, damages and expenses that Seller may have incurred as a result of any inaccurate information provided by Buyer to Seller.

**17. Minimum Order.** Seller reserves the right to refuse to process any order that does not meet quantity requirements that Seller may establish for any given product or group of products.

**18. Quality Levels.** Prices are based on quality levels commensurate with normal processing. If a different quality level is required, Buyer must specify its requirements, as approved in writing by Seller, and pay any additional costs that may be applicable.

**19. Product Recalls.** *In cases where Buyer purchases for resale, Buyer shall take all reasonable steps (including, without limitation, those measures prescribed by the seller): (a) to ensure that all customers of the Buyer and authorized repairers who own or use affected products are advised of every applicable recall campaign of which the Buyer is notified by the Seller; (b) to ensure that modifications notified to Buyer by Seller by means of service campaigns, recall campaigns, service programs or otherwise are made with respect to any products sold or serviced by Buyer to its customers or authorized repairers. The reimbursement of Buyer for parts and labor used in making those modifications shall be as set forth in the campaign or program instructions. Without the prior consent of the Seller, the Buyer shall not disclose to any third party the information contained in service campaign, recall campaign or service program literature. Should Buyer fail to perform any of the actions required under this section, Seller shall have the right to obtain names and address of the Buyer's customers and shall be entitled to get into direct contact with such customers.*

**19. GOVERNING LAW.** THE TERMS OF THIS AGREEMENT AND ALL RIGHTS AND OBLIGATIONS HEREUNDER SHALL BE GOVERNED BY THE LAWS OF THE STATE OF SELLER'S OFFICE TO WHICH THIS ORDER HAS BEEN SUBMITTED (WITHOUT REFERENCE TO PRINCIPLES OF CONFLICTS OF LAWS). THE RIGHTS AND OBLIGATIONS OF THE PARTIES HEREUNDER SHALL NOT BE GOVERNED BY THE 1980 U.N. CONVENTION ON CONTRACTS FOR THE INTERNATIONAL SALE OF GOODS.

**20. Titles.** The section titles are for reference only, and shall not limit or restrict the interpretation or construction of this Agreement.

**21. Waiver.** Seller's failure to insist, in any one or more instances, upon Buyer's performance of this Agreement, or to exercise any rights conferred, shall not constitute a waiver or relinquishment of any such right or right to insist upon Buyer's performance in any other regard.

**22. Severability.** The partial or complete invalidity of any one or more provisions of this Agreement shall not affect the validity or continuing force and effect of any other provision.

# QUADNA

Proposal No: CP15-07-22 01  
 Item No: ITEM 001

DXP/Quadna  
 14452 W. 44th Avenue  
 Golden, CO 80403  
 Ph: 303-430-0521  
 Fax: 303-430-0851  
 Chad Post  
 cpost@quadna.com

July 22, 2015

**MODEL:3196 LTi SIZE:4x6-10G QTY: 1**

## Operating Conditions

### SERVICE

LIQUID Water Temp. 70.0 deg F, SP.GR 1.000, Viscosity 1.000 cp, rated / max. suction pressure 0.0 / 0.0 psi g

CAPACITY Rated 1,425.0 gpm

HEAD 300.0 (ft)

## Performance at 3560 RPM per HI 14.6 1B basis power

PUBLISHED EFFY 72.0% (CDS)

RATED EFFY 72.0%

RATED POWER 156.7 hp (incl. Mech. seal drag 0.52). (Run out 161.2 hp)

NPSHR 37.4 ft

DISCH PRESSURE (R) 135.8 psi g (179.0 psi g @ Shut off) based on 0.0 psi g rated suction pressure

PERF. CURVE 5379-2 (Rotation CW viewed from coupling end)

SHUT OFF HEAD 413.6 ft

MIN. FLOW Continuous Stable: 460.8 gpm Hydraulic: 460.8 gpm Thermal: N/A

## Materials

CONSTRUCTION Ductile iron

CASING Ductile iron (max.casing pressure @ rated temp. 250.0 psi g)

ST.BOX COVER Ductile iron

IMPELLER Ductile iron - Open (9.8750 in rated, max=10.2500 in, min=7.5000 in)

CASING GASKETS Aramid Fiber with EPDM and Silicate Filler

IMPELLER O-RING Teflon

SHAFT MATERIAL SAE 4140

SHAFT SLEEVE 316SS

LUBRICATION Flood oil

SEAL CHAMBER Taper bore plus with axial ribs

GLAND 316SS Flush quench and drain

BEARINGS 6311 (Inboard) 7310 (Outboard)

COUPLING T.B. Wood's - SCH8-35-10-S.F. 1.00

COUPLING GUARD Carbon steel

BASEPLATE Fabricated steel to ANSI B73.1M 1991 D07087A

## Sealing Method

MECHANICAL SEAL John Crane 5611Q X(1)O(58)1XO(58)1 (Silicon Carbide vs Silicon Carbide with Viton) - (Cartridge - Single)

## Flanges

**i-FRAME™**



PRICE in USD	
Pump Unit	Incl
Driver	Incl
Boxing	
Testing	Incl
Freight	
<b>Total 1 Unit</b>	<b>21,265</b>

150# flat face

## Frame Connections

Bearing frame drain  
 Frame cooler access  
 Oil fill connection

## Frame features

Ductile iron frame adapter  
 Duplex bearing  
 Inpro VBXX-D Hybrid Bearing Isolators  
 i-ALERT™ Condition Monitor

## Assembly and Testing

Casing & Cover - Standard hydro test  
 Impeller balanced to ISO G1.0

## Painting

Goulds Blue standard painting

## Warranty

5 Year Extended Warranty (All the components, manufactured by ITT Goulds pumps, in the liquid end and power end are covered).

## Driver : Electric motor Manufacturer : Pump mfg's Choice

FURNISHED BY	Pump mfg	MOUNTED BY	Pump mfg
RATING	200.0 hp (149.1 KW)	ENCLOSURE	TEFC - Premium Efficiency
PHASE/FREQ/VOLTS	3/60 Hz/460	SPEED	3600 RPM
INSULATION/SF	F/1.15	FRAME	447TS

## Freight Terms

**Freight invoices received from ITT partner carriers are proprietary information and cannot be divulged for any reason. ITT will provide an ITT generated freight invoice upon request.**

## Weights and Measurements

TOTAL NET UNIT WEIGHT / VOLUME	3,092.0 lb / 35.5 ft <sup>3</sup>
TOTAL GROSS UNIT WEIGHT / GROSS VOLUME	3,514.0 lb / 84.4 ft <sup>3</sup>

Program Version 1.53.3.0

### Drawing Revision Limit

Drawings returned with status approved as noted or revise and re-submit will be corrected and resubmitted only once. Thereafter, additional comments or revisions to these drawings will incur a charge of \$250 per drawing.

Our offer does not include specific review and incorporation of any Statutory or Regulatory Requirements and the offer is limited to the requirements of the design specifications. Should any Statutory or Regulatory requirements need to be reviewed and incorporated then the Customer is responsible to identify those and provide copies for review and revision of our offer.

**Our quotation is offered in accordance with our conditions of Sale.**

[Click here](#) to download the pump Bulletin

[Click here](#) to learn more about the new *i-FRAME*™


## Are you aware of PumpSmart Process Systems?

PumpSmart is a system that utilizes a standard process pump in conjunction with ITT unique and patented PumpSmart Control System and Software. The software, which resides on the controller microprocessor chip, allows the pump to monitor and react to any system condition.

### **PumpSmart**

- \* Eliminates control valves, flow meters, and recirculation lines.
- \* Significantly reduces energy costs.
- \* Significantly increases MTBF.

Please contact your local Goulds Pumps representative for details and a demonstration CD-ROM. You may also contact us at [www.gouldspumps.com](http://www.gouldspumps.com) or e-mail [pumpsmart@fluids.ittind.com](mailto:pumpsmart@fluids.ittind.com).

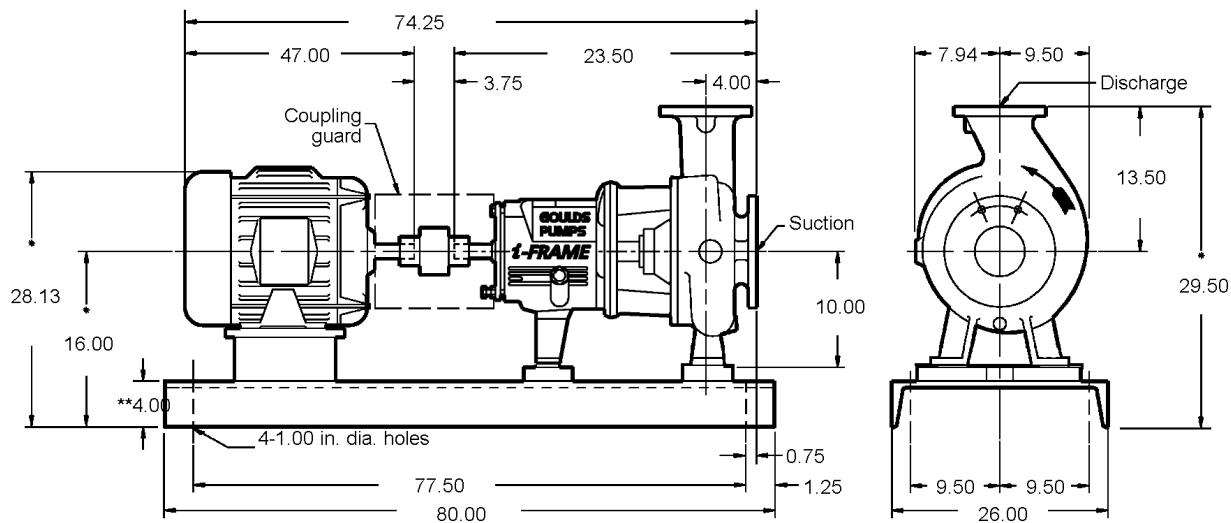

**Pump Specification**

SUCT.FLANGE SIZE	6"	DRILLING	ANSI 150#	FACING	FF	FINISH	SERRATED
DISCH.FLANGE SIZE	4"	DRILLING	ANSI 150#	FACING	FF	FINISH	SERRATED
PUMP ROTATION ( LOOKING AT PUMP FROM MOTOR )				CW			
TYPE OF LUBRICATION	FLOOD OIL			COOLED	NO		
TYPE OF STUFFING BOX	TAPER BORE PLUS WITH AXIAL RIBS			COOLED	NO		
TYPE OF SEALING	MECHANICAL SEAL						

**Weights and Measurements**

PUMP	295.0 lb
MOTOR/CPLG	2,260.0/15.0 lb
BASEPLATE	522.0 lb
TOTAL	3,092.0 lb
GR.VOLUME w/BOX	84.4 ft <sup>3</sup>
GR.WEIGHT w/BOX	3,514.0 lb

**Motor Specification**

MOTOR BY	PUMP MFG	MOUNT BY	PUMP MFG	MFG.	PUMP MFG'S CHOICE
FRAME	447TS	POWER	200.0 hp	RPM	3600
PHASE	3	FREQUENCY	60 HZ	VOLTS	460
INSULATION	F	S.F.	1.15		
ENCLOSURE	TEFC - PREMIUM EFFICIENCY				

**Notes and References**

<ul style="list-style-type: none"> <li>- MTR DIMENSIONS ARE APPROXIMATE</li> <li>- INSTALL FOUNDATION BOLTS IN PIPE SLEEVES</li> <li>- ALLOW FROM 0.75 to 1.50in. FOR GROUTING. SEE INSTRUCTION BOOK FOR DETAILS.</li> </ul> <p>* Tolerance is -0.38 +0.38 ** Foundation bolt grip thickness</p>
<p>FOR PUMP TAPPED OPENINGS REFER TO DWG.: TCP15-07-22 01 / ITEM 001</p>

**Auxiliary Specification**


COUPLING BY	PUMP MFG	CPLG TYPE	T.B. WOOD'S SCH8-35-10
CPL GUARD BY	PUMP MFG	CPLG GUARD MATL.	CARBON STEEL
BASEPLATE	FABRICATED STEEL TO ANSI B73.1M 1991 D07087A		
MECH.SEAL	JOHN CRANE 5611Q X(1)O(58)IXO(58)I (SILICON CARBIDE VS SILICON CARBIDE WITH VITON)		

DRAWING IS FOR REFERENCE ONLY.  
NOT CERTIFIED FOR CONSTRUCTION UNLESS SIGNED.

Customer: QUADNA  
Serial No:  
Customer P.O. No:  
Item No: ITEM 001  
End User: Tetra Tech  
Service:

Copyright 2015  
ITT Corp

**DRAWING NO** CP15-07-22 01/ITEM 001

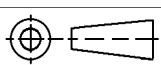

All dimensions are in inches.  
Drawing is not to scale  
Weights (lbs) are approximate

Job/Inq.No. :

Purchaser : QUADNA  
 End User: Tetra Tech  
 Item/Equip.No. : ITEM 001

Issued by : Chad Post  
 Quotation No. : CP15-07-22 01

Date : 07/22/2015

Service :

Order No. :

Certified By :

Rev. : 0


**Operating Conditions**

Liquid: Water  
 Temp.: 70.0 deg F  
 S.G./Visc.: 1.000/1.000 cp  
 Flow: 1,425.0 gpm  
 TDH: 300.0 ft  
 NPSHa: 0.0 ft  
 Solid size:  
 % Susp. Solids (by wtg):

**Pump Performance**

Published Efficiency: 72.0 %  
 Rated Pump Efficiency: 72.0 %  
 Rated Total Power: 156.7 hp  
 Non-Overloading Power: 161.2 hp  
 Imp. Dia. First 1 Stg(s): 9.8750 in  
 NPSHr: 37.4 ft  
 Shut off Head: 413.6 ft  
 Vapor Press:  
 Suction Specific Speed: 9,717 gpm(US) ft  
 Min. Hydraulic Flow: 460.8 gpm  
 Min. Thermal Flow: N/A  
 Max. Solids Size: 1.0000 in

- Notes:**
1. Power and efficiency losses are not reflected on the curve below.
  2. Elevated temperature effects on performance are not included.

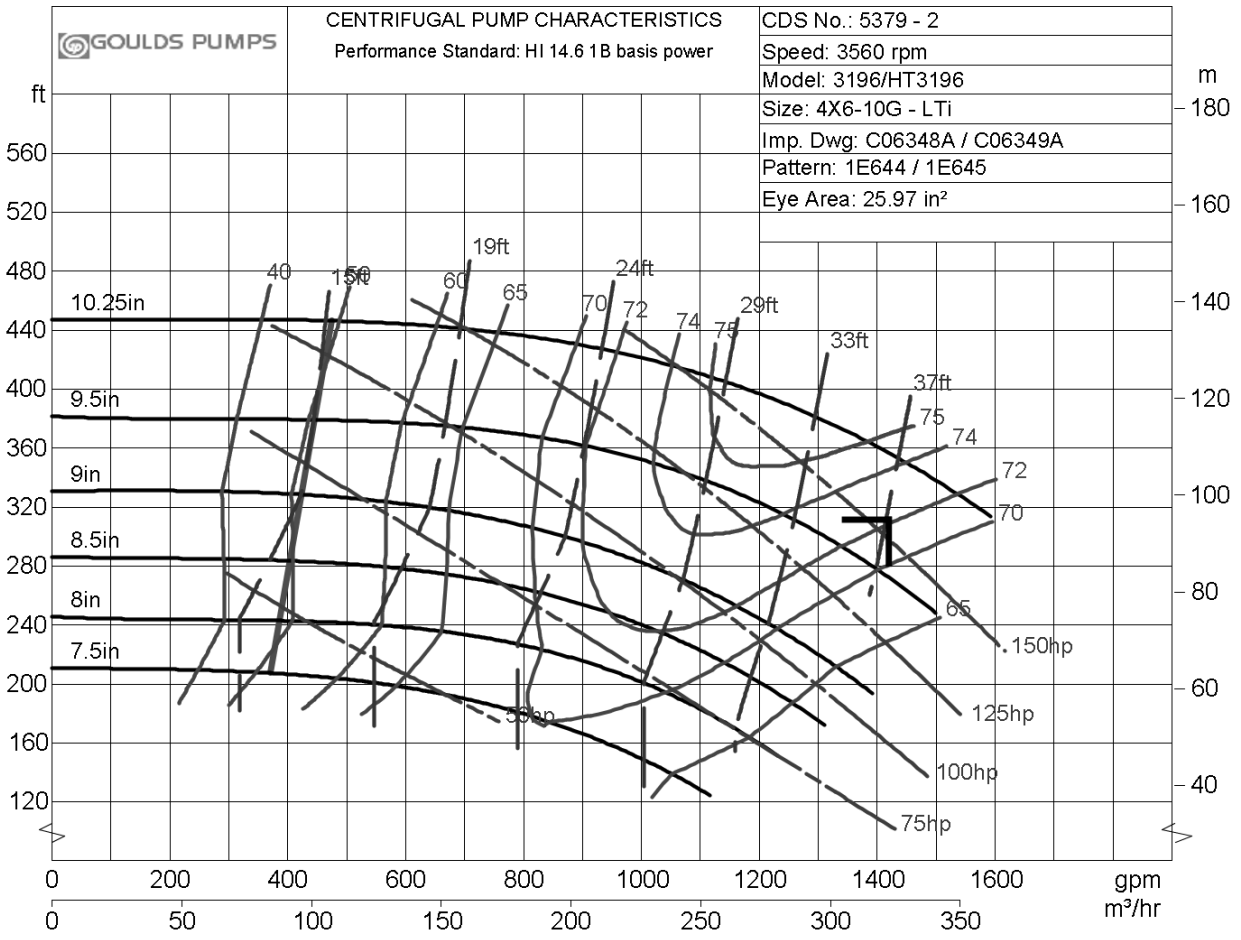

Model: 3196

Size: 4x6-10G

Group: LTI

60Hz

RPM: 3560

Stages: 1

Job/Inq.No. :

Purchaser : QUADNA

End User : Tetra Tech

Item/Equip.No. : ITEM 001

Service :

Order No. :

Issued by : Chad Post

Quotation No. : CP15-07-22 01

Rev. : 0

Date : 07/22/2015

Certified By :

Operating Conditions


Liquid: Water
Temp.: 70.0 deg F
S.G./Visc.: 1.000/1.000 cp
Flow: 1,425.0 gpm
TDH: 300.0 ft
NPSHa: 0.0 ft
Solid size:

Pump Performance

Published Efficiency: 72.0 %
Rated Pump Efficiency: 72.0 %
Rated Total Power: 156.7 hp
Non-Overloading Power: 161.2 hp
Imp. Dia. First 1 Stg(s): 9.8750 in
NPSHr: 37.4 ft
Max. Solids Size: 1.0000 in
Suction Specific Speed: 9,717 gpm(US) ft
Min. Hydraulic Flow: 460.8 gpm
Min. Thermal Flow: N/A
Shut off Head: 413.6 ft
% Susp. Solids (by wtg):

Vapor Press:

Notes: 1. Elevated temperature effects on performance are not included.

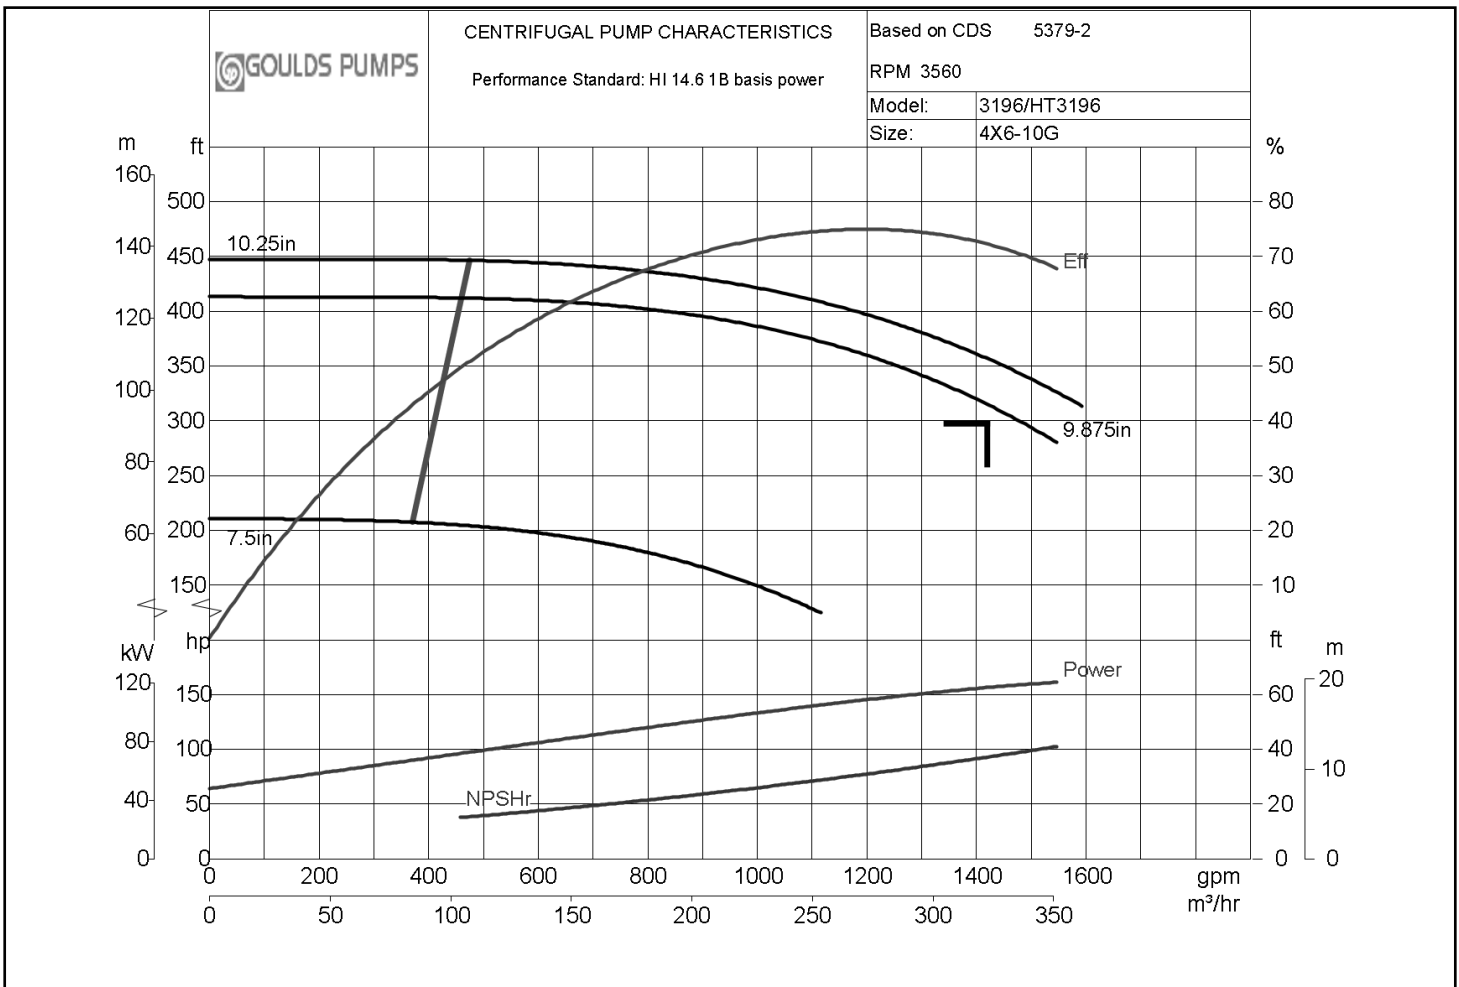



# Industrial Process

## Terms & Conditions of Sale

### WARRANTY

(a) Company warrants that on the date of shipment the goods are of the kind and quality described herein and are free of non-conformities in workmanship and material. This warranty does not apply to goods or parts delivered by Company but manufactured by others. (b) Buyer exclusive remedy for nonconformity in any item of the goods shall be the repair or the replacement (at Company option) of the item and any affected part of the goods. Company obligation to repair or replace shall be in effect for a period of one (1) year from initial operation of the goods but not more than eighteen (18) months from Company shipment of the goods, provided Buyer has sent written notice within that period of time to Company that the goods do not conform to the above warranty. Repaired and replacement parts shall be warranted for the remainder of the original period of notification set forth above, but in no event less than 12 months from repair or replacement. At its sole expense, Buyer shall remove and ship to Company any such nonconforming goods and shall reinstall the repaired or replaced goods or parts. Buyer shall grant Company access to the goods at all reasonable times in order for Company to determine any nonconformity in the goods. Company shall have the right of disposal of items replaced by it. If Company is unable or unwilling to repair or replace, or if repair or replacement does not remedy the nonconformity, Company and Buyer shall negotiate an equitable adjustment in the order price, which may include a full refund of the order price for the nonconforming goods. (c) COMPANY HEREBY DISCLAIMS ALL OTHER WARRANTIES, EXPRESS OR IMPLIED, EXCEPT THAT OF TITLE. SPECIFICALLY, IT DISCLAIMS THE IMPLIED WARRANTIES OF MERCHANTABILITY, FITNESS FOR A PARTICULAR PURPOSE, COURSE OF DEALING AND USAGE OF TRADE. (d) Buyer and successors of Buyer are limited to the remedies specified in this article and shall have no others for a nonconformity in the goods. Buyer agrees that these remedies provide Buyer and its successors with a minimum adequate remedy and are their exclusive remedies, whether Buyer or its successors remedies are based on contract, warranty, tort (including negligence), strict liability, indemnity, or any other legal theory, and whether arising out of warranties, representations, instructions, installations, or non-conformities in any cause. Buyer shall assume all responsibility and expense for removal, reinstallation and freight in connection with these remedies. (e) Company neither assumes, nor authorizes any person to assume for it, any other obligation in connection with the sale of its goods. This warranty shall not apply to any goods that: (1) have been repaired or altered outside of Company factories or authorized service centers, in any manner; or (2) have been subjected to misuse, negligence or accidents; or (3) have been improperly stored or handled or used in a manner contrary to Company instructions or recommendations; or (4) have design errors due to inaccurate or incomplete information supplied by Buyer or its agents.

### LIMITATION OF LIABILITY

NEITHER COMPANY, NOR ITS SUPPLIERS SHALL BE LIABLE, WHETHER IN CONTRACT, WARRANTY, FAILURE OF A REMEDY TO ACHIEVE ITS INTENDED OR ESSENTIAL PURPOSES, TORT (INCLUDING NEGLIGENCE), STRICT LIABILITY, INDEMNITY OR ANY OTHER LEGAL THEORY, FOR LOSS OF USE, REVENUE OR PROFIT, OR FOR COSTS OF CAPITAL OR OF SUBSTITUTE USE OR PERFORMANCE, OR FOR INDIRECT, SPECIAL, LIQUIDATED, INCIDENTAL OR CONSEQUENTIAL DAMAGES, OR FOR ANY OTHER LOSS OR COST OF A SIMILAR TYPE, OR FOR CLAIMS BY BUYER FOR DAMAGES OF BUYER CUSTOMERS. COMPANY MAXIMUM LIABILITY UNDER THIS CONTRACT SHALL BE THE CONTRACT PRICE. BUYER AND COMPANY AGREE THAT THE EXCLUSIONS AND LIMITATIONS SET FORTH IN THIS ARTICLE ARE SEPARATE AND INDEPENDENT FROM ANY REMEDIES WHICH BUYER MAY HAVE HEREUNDER AND SHALL BE GIVEN FULL FORCE AND EFFECT WHETHER OR NOT ANY OR ALL SUCH REMEDIES SHALL BE DEEMED TO HAVE FAILED OF THEIR ESSENTIAL PURPOSE.

### GENERAL

(a) Company will comply with all laws applicable to Company during manufacture and sale of the goods. Purchaser will comply with all laws applicable to Purchaser during operation or use of the goods. (b) The laws of the State of New York shall govern the validity, interpretation and enforcement of any order of which these provisions are a part, without giving effect to any rules governing the conflict of laws. The application of the United Nations Convention on Contracts for the International Sale of Goods shall be excluded. (c) Assignment may be made only with written consent of both parties; provided, however, Company may assign to its affiliate without Buyer consent. (d) Buyer shall be liable to Company for any attorney fees and costs incurred by Company in enforcing any of its rights hereunder. This document and any other documents specifically referred to as being a part hereof, constitute the entire contract on the subject matter, and it shall not be modified except in writing signed by both parties. Unless otherwise specified, any reference to Buyer order is for identification only.

### ACCEPTANCE

The determination of compliance with performance guarantees will be based on results of factory tests under controlled conditions with calibrated instruments and tested per standards of the Hydraulic Institute, ISO standards, API standards, or other nationally recognized accreditation standards.

### STATUTE OF LIMITATIONS

To the extent permitted by applicable law, any lawsuit for breach of contract, including breach of warranty, arising out of the transactions covered by this order, must be commenced not later than twelve (12) months from the date the cause of action accrued.

### SHIPMENT

The term shipment means delivery to the initial carrier in accordance with the delivery terms of this order. Company may make partial shipments. Company shall select method of transportation and route, unless terms are f.o.b. point of shipment and Buyer specifies the method and route and is to pay the freight costs in addition to the price. When terms are f.o.b. destination or freight allowed to destination, destination means common carrier delivery point -within the continental United States, excluding Alaska- nearest the destination. For movement outside the United States, company shall arrange for inland carriage to port of exit and shall cooperate with Buyer agents in making necessary arrangements for overseas carriage and preparing necessary documents.

### SPECIAL SHIPPING DEVICES

On shipments to a destination in the continental United States or Canada, Company has the right to add to the invoice, as a separate item, the value of any special shipping device (barrel, reel, tarpaulin, cradle, crib and the like) used to contain or protect the goods invoiced, while in transit. Full credit will be given on the return to Company of the device in a reusable condition, f.o.b. destination, freight prepaid.

### DELAYS

If Company suffers delay in performance due to any cause beyond its control, including but not limited to act of God, war, act or failure to act of government, act or omission of Buyer, fire, flood, strike or labor troubles, sabotage, or delay in obtaining from others suitable services, materials, components, equipment or transportation, the time of performance shall be extended a period of time equal to the period of the delay and its consequences. Company will give Buyer notice in writing within a reasonable time after Company becomes aware of any such delay.

### NONCANCELLATION

Buyer may not cancel or terminate for convenience, or direct suspension of manufacture, except with Company written consent upon terms agreed to by Company.

### STORAGE

Any item of the goods on which manufacture or shipment is delayed by causes within Buyer control, or by causes which affect Buyer ability to receive the goods, may be placed in storage by Company for Buyer account and risk and Buyer shall pay all charges for storage and shipping and incidental expenses.

### TITLE AND INSURANCE

Title to the goods and risk of loss or damage shall pass to Buyer at the f.o.b. point, except that a security interest in the goods and proceeds and any replacement shall remain in Company, regardless of mode of attachment to realty or other property, until the full price has been paid in cash. Buyer agrees to do all acts necessary to perfect and maintain said security interest, and to protect Company interest by adequately insuring the goods against loss or damage from any external cause with Company named as insured or co-insured.

### INSPECTIONS / EXPEDITING

The Company restricts access to its facilities and requires seventy two (72) hours notice prior to each visit. Company requires that its agents or employees accompany inspectors/expeditors on their visit(s).

### TERMS OF PAYMENT

Unless otherwise stated, all payments shall be by Letter of Credit or Net Thirty (30) Days and in United States dollars, and a pro rata payment shall become due as each shipment is made. If shipment is delayed by Buyer, date of readiness for shipment shall be deemed to be date of shipment for payment purposes. If at any time in Company judgment Buyer may be or may become unable or unwilling to meet the terms specified, Company may require satisfactory assurances or full or partial payment as a condition to commencing or continuing manufacture or making shipment; and may, if shipment has been made, recover the goods from the carrier, pending receipt of such assurances.

### GOODS RETURN

Goods can be returned for credit only after receiving Company written authorization and shipping instructions. Consignor name and address must be plainly written on the shipping tag. Special goods fabricated to order are not returnable under any conditions.

### PATENTS

Company shall pay costs and damages finally awarded in any suit against Buyer or its vendees to the extent based upon a finding that the design or construction of the goods as furnished, infringes a United States patent (except infringement occurring as a result of incorporating a design or modification at Buyer request), provided that Buyer promptly notifies Company of any charge of infringement, and Company is given the right at its expense to settle such charge and to defend or control the defense of any suit based upon such charge. Company shall have no obligation hereunder with respect to claims, suits or proceedings, resulting from or related to, in whole or in part, (a) the use of software or software documentation, (b) compliance with Buyer specifications, (c) the combination with, or modification of, the goods after delivery by Company, or (d) the use of the goods, or any part thereof, in the practice of a process. THIS ARTICLE SETS FORTH COMPANY ENTIRE LIABILITY WITH RESPECT TO PATENTS.

### BUYER DATA

Timely performance is contingent upon the Buyer supplying to the Company, when needed, all required technical information, including drawing approval, and all required commercial documentation.

### NUCLEAR

Buyer represents and warrants that the goods covered by this order shall not be used in or in connection with a nuclear facility or application.

### PRICES

The prices stated herein will remain firm for the period up to the stated date of shipment providing the shipment is not delayed by the Buyer. If shipment is delayed by the Buyer beyond the shipment date quoted herein, the prices will be based on the prices in effect at time of shipment, including storage and material handling costs. In no event shall the adjusted price be less than the original order price, including change orders. Prices are F.O.B. Shipping Point, unless otherwise specified. When price includes transportation and other charges pertaining to the shipment of goods, any increase in transportation rates and other charges will be for the account of the Buyer. There will be an extra charge for any test other than that which may be normally run by the Company, or for any test performed to suit the convenience of the Buyer. Any applicable duties or sales, use, excise, value added or similar taxes will be added to the price and invoiced separately.

### CONTROLLING PROVISIONS

These terms and conditions shall control with respect to any purchase order or sale of the Company goods. No waiver, alteration or modification of these terms and conditions whether on Buyer purchase order or otherwise shall be valid unless the waiver, alteration or modification is specifically accepted in writing and signed by an authorized representative of the Company.

### EXPORT

If this transaction involves EXPORT, the following additional terms and conditions shall apply:

- Compliance is required for ALL applicable US export laws, and the export laws of the country from where the goods are exported. Buyer acknowledges that it will comply with all applicable export or re-export restrictions and regulatory requirements in the purchase or resale of Products from the Company. Buyer acknowledges that this may include US export or re-export restrictions and controls in addition to requirements enforced by other international export control regimes, as applicable. Buyer agrees to full disclosure of all parties to a proposed sales transaction, and to comply with all license terms and conditions, destination control statements, or other restrictions on the export or re-export of Products. Buyer agrees that it will not divert such products to any unauthorized party or destination, including embargoed or sanctioned territories or countries. Buyer will include all information pertaining to export classification (ECCN or equivalent), applicable license restrictions, and authorized destination of the Product in its export and shipping documentation.
- **PACKING**  
When packing is available, equipment will be packed, boxed or crated in accordance with the Company standard commercial practice, for underdeck export shipment, unless otherwise agreed.
- **LETTER OF CREDIT**  
Unless otherwise specified in writing, payment shall be made by irrevocable letter of credit in form acceptable to Company, confirmed by a major USA bank, acceptable to the Company and providing for payment in full in United States dollars against presentation of United States inland shipping documents and invoices, such letter of credit to be established prior to Company acceptance of the order. The letter of credit shall also provide that in the event Company is, for any reason beyond its control, prevented from making shipment from Company factory or delivery at the port of embarkation, a certificate of manufacture of the whole or any part of the goods shall constitute delivery of such whole or any part of the goods and payment in full of any and all drafts drawn against the letter of credit for the goods so delivered shall be made upon presentation of such certificates of manufacture in lieu of United States inland shipping documents. In the event that Company is prevented by law, or otherwise, from making shipment from Company factory or delivery at the port of embarkation of the goods or any part thereof, on completion of manufacture, Company reserved the right to place the goods in storage for the Buyer account and risk. Any charges incurred in this connection will be for the account of the Buyer at cost and will be payable upon demand. In regions where Letters of Credit are not available, surety bonds will be utilized in lieu of the bank guarantee.
- **COMPANY AS AGENT**  
If Company makes or arranges for ocean shipment, Company shall act as agent for the Buyer and reserves the right to procure full insurance coverage, including war risk insurance, at the expense of the Buyer. All expenses incurred in this connection will be payable upon demand to the Company. If Company as agent applies for or secures manufacturing, financing, exporting or other licenses required by the United States Government, or any department thereof, Company shall make such applications or secure such licenses solely as agent for the Buyer, and assumes no responsibility therefore.



## CANCELLATION SCHEDULE

Planned Shipment (weeks)	Elapsed Time - Date of Order to Date of Cancellation (weeks)																	
	0 to 2	2.01 to 4	4.01 to 6	6.01 to 8	8.01 to 12	12.01 to 16	16.01 to 20	20.01 to 24	24.01 to 28	28.01 to 32	32.01 to 36	36.01 to 40	40.01 to 44	44.01 to 48	48.01 to 52	52.01 to 56	56.01 to 60	60.01 to 64
Up to 8	20	50	75	100														
8.01 to 12	15	40	60	80	100													
12.01 to 16	10	25	45	60	85	100												
16.01 to 20	10	15	25	45	65	85	100											
20.01 to 24	10	10	20	25	50	70	90	100										
24.01 to 28	10	10	15	20	25	50	70	90	100									
28.01 to 32	10	10	10	15	20	35	60	75	90	100								
32.01 to 36	10	10	10	15	20	25	50	60	85	95	100							
36.01 to 40	10	10	10	10	15	25	50	60	70	85	95	100						
40.01 to 44	10	10	10	10	15	25	45	55	65	80	90	95	100					
44.01 to 48	10	10	10	10	15	25	45	55	60	65	80	90	95	100				
48.01 to 52	10	10	10	10	15	20	40	50	55	60	70	85	90	95	100			
52.01 to 56	10	10	10	10	15	20	35	50	55	60	70	80	85	90	95	100		
Above 56	*	*	*	*	*	*	*	*	*	*	*	*	*	*	*	*	*	*

Note: The above cancellation rates apply to manufactured equipment only. Any sub-supplier cancellation charges are not reflected above, and would apply accordingly.

\* to Be Assigned