



APPENDIX G

FINAL DRAWING LIST

Nevada Environmental Response Trust (NERT)
DRAWING LIST

DRAWING NO.	DRAWING TITLE	ISSUED FOR APPROVAL						ISSUED FOR CONSTRUCTION		LATEST REVISION		REMARKS
		ISSUED FOR APPROVAL		ISSUED FOR CONSTRUCTION		LATEST REVISION		NO.	DATE			
		DATE	REV	DATE	REV	NO.	DATE					
	PROCESS											
A-0	Cover Sheet - Overall							1	9/20/06			
P-0	Cover Sheet			1/9/06	0	3	11/15/13					
PFD-1 Sht 1	Process Flow Diagram	7/25/05	H	1/9/06	0	3	11/15/13					
PFD-1 Sht 2	Process Flow Diagram Mass Balance	7/25/05	H	1/9/06	0	3	11/15/13					
PFD-2	Process Flow Diagram Well & EQ System	7/25/05	B	1/9/06	0	3	11/15/13					
PID-LA	P&ID Legend Sheets					2	11/15/13					
PID-LB	P&ID Legend Sheets					2	11/15/13					
PID-N1	P&ID Process Notes	7/21/05	F	1/9/06	0	3	11/15/13					
PID-1A	P&ID Fluid Bed Perchlorate System	7/21/05	E	1/9/06	0	3	11/15/13					
PID-1B	P&ID Fluid Bed Perchlorate System	7/21/05	E	1/9/06	0	2	11/15/13					
PID-2A	P&ID Fluid Bed Perchlorate System	7/21/05	D	1/9/06	0	3	11/15/13					
PID-2B	P&ID Fluid Bed Perchlorate System	4/25/05	C	1/9/06	0	2	11/15/13					
PID-3A	P&ID Fluid Bed Perchlorate System	7/21/05	E	1/9/06	0	3	11/15/13					
PID-3B	P&ID Fluid Bed Perchlorate System	4/25/05	B	1/9/06	0	2	11/15/13					
PID-3C	P&ID Fluid Bed Perchlorate System	7/7/05	C	1/9/06	0	2	11/15/13					
PID-3D	P&ID Fluid Bed Perchlorate System	7/7/05	C	1/9/06	0	2	11/15/13					
PID-4	P&ID Fluid Bed Perchlorate System	7/21/05	D	1/9/06	0	3	11/15/13					
PID-5	P&ID Fluid Bed Perchlorate System	7/21/05	F	1/9/06	0	2	11/15/13					
PID-6	P&ID Fluid Bed Perchlorate System	7/21/05	G	1/9/06	0	4	11/15/13					
PID-7A	P&ID Fluid Bed Perchlorate System	7/21/05	G	1/9/06	0	3	11/15/13					

NERT GWETS Perchlorate Treatment System
Revision 2 – November 2013
1373-O-02

Nevada Environmental Response Trust (NERT)
DRAWING LIST

DRAWING NO.	DRAWING TITLE	ISSUED FOR APPROVAL		ISSUED FOR CONSTRUCTION		LATEST REVISION		REMARKS
		DATE	REV	DATE	REV	NO.	DATE	
		PID-7B	P&ID Fluid Bed Perchlorate System	7/21/05	F	1/9/06	0	
PID-7C	P&ID Fluid Bed Perchlorate System	7/1/05	E	1/9/06	0	2	11/15/13	
PID-8	P&ID Fluid Bed Perchlorate System	7/21/05	D	1/9/06	0	3	11/15/13	
PID-9	P&ID Fluid Bed Perchlorate System	7/21/05	E	1/9/06	0	4	11/15/13	
PID-10A	P&ID Existing EQ Area & Modifications	7/21/05	E	1/9/06	0	5	11/15/13	
PID-10B	P&ID Existing EQ Area & Modifications	4/25/05	B	1/9/06	0	3	11/15/13	
PID-10C	P&ID Existing EQ Area & Modifications	7/21/05	F	1/9/06	0	5	11/15/13	
PID-11	P&ID Utility Systems	7/21/05	F	1/9/06	0	4	11/15/13	
PID-12	P&ID Utility Systems	7/21/05	F	1/9/06	0	4	11/15/13	
PID-13	P&ID AP-5 Pond Equipment	7/21/05	G	1/9/06	0	3	11/15/13	
PID-14	P&ID FBR-A System	7/21/05	G	1/9/06	0	3	11/15/13	
PID-15	P&ID Phosphoric Acid Feed	7/21/05	G	1/9/06	0	4	11/15/13	
PID-16	P&ID Sludge Storage & Oxygen Skid	7/21/05	G	1/9/06	0	4	11/15/13	
PID-17	P&ID Sand Filter	7/21/05	G	1/9/06	0	3	11/15/13	
HYD-1 Sheet 1	Hydraulic Profile	12/21/05	A	1/9/06	0	4	11/15/13	
HYD-1 Sheet 2	Hydraulic Profile	12/21/05	A	1/9/06	0	4	11/15/13	

Nevada Environmental Response Trust (NERT)
DRAWING LIST

DRAWING NO.	DRAWING TITLE							REMARKS
		ISSUED FOR APPROVAL		ISSUED FOR CONSTRUCTION		LATEST REVISION		
		DATE	REV	DATE	REV	NO.	DATE	
	<u>Mechanical</u>							
FC-1	Fire Code Review							
GA-1 Sht 1	Overall Equipment Arrangement	7/26/05	D2					DRAWING NO.S NOT USED AFTER ORIGINAL APPROVAL.
GA-1 Sht 2	AP-5 Pond Area	7/26/05	D2					
GA-1 Sht 3	FBR-A Area	7/26/05	D2					
GA-1 Sht 4	Sand Filter	7/26/05	D2					
GA-1 Sht 5	D-1 Building	7/26/05	D2					
GA-1 Sht 6	Chemical Feeds	7/26/05	D2					
KP-1	Piping Drawing Key Plan	1/30/06	A			4	10/2/06	
M-1	Overall Plant Arrangement	1/30/06	A		0	0	9/27/06	REINSTATED DWG NO.
M-2	Equipment Location Plan	1/30/06	A	4/17/06	2	3	9/27/06	2 SHEETS
M-3	Equipment Location Plan AP-5 Pond Area	3/7/06	A	3/21/06	0	1	9/27/06	DUPL NO M-3
M-04	PE Stamp Drawing Cover Sheet				0	0	9/27/06	
M-10	Piping Plan					7	10/2/06	
M-11	Piping Plan					6	10/25/06	
M-12	Piping Plan					3	4/7/04	
M-13	Piping Plan					3	4/7/04	
M-14	Piping Plan					6	10/3/06	
M-15	Piping Plan					5	10/3/06	
M-16	Piping Plan					8	10/3/06	
M-17	Piping Plan					7	10/3/06	

Nevada Environmental Response Trust (NERT)
DRAWING LIST

DRAWING NO.	DRAWING TITLE	ISSUED FOR APPROVAL		ISSUED FOR CONSTRUCTION		LATEST REVISION		REMARKS	
		DATE	REV	DATE	REV	NO.	DATE		
		M-18	Piping Plan & Sections						
M-19	Piping Plan & Diagram					4	3/18/04		
M-20	Piping Sections					5	10/3/06		
M-21	Piping Sections					5	4/28/06		
M-22	Piping Sections					5	4/7/04		
M-23	Piping Sections					4	4/7/04		
M-27	Enlarged Piping Plan Biofilter Area					5	10/10/06		
M-3	Equipment Location Plan, EQ Area					3	4/23/04	DUPL NO M-3	
M-30	Piping Plan, EQ Area					2	4/7/04		
M-31	Piping Sections, EQ Area					4	10/4/06		
M-32	Piping Sections, EQ Area					2	4/7/04		
M-39	Structural Notes					3	4/2/04		
M-40	Pipe Support Rack A Plan View & Details					2	12/2/03		
M-41	Pipe Support Rack A Sections & Details					3	12/2/03		
M-42	Pipe Support Racks B1 to B4 Plan View Sections & Details					2	12/2/03		
M-43	Tank Farm Area Misc. Pipe Supports					2	12/2/03		
M-44	Tank Farm Area Misc. Pipe Support Locations					1	12/2/03		
M-45	Misc. Supports Plan View					2	12/2/03		
M-46	Pipe Rack D and E Plans					2	12/2/03		
M-47	Pipe Rack D and E Plan & Sections					2	12/2/03		

Nevada Environmental Response Trust (NERT)
DRAWING LIST

DRAWING NO.	DRAWING TITLE							REMARKS	
		ISSUED FOR APPROVAL		ISSUED FOR CONSTRUCTION		LATEST REVISION			
		DATE	REV	DATE	REV	NO.	DATE		
M-48	Pipe Rack D Sections and Details					2	12/2/03		
M-49	Pipe Rack D & E Sections and Details					2	12/2/03		
M-50	Pipe Rack D and E Plans					2	12/2/03		
M-51	Pipe Rack D and E Plan & Sections					1	12/2/03		
M-52	Pipe Rack D Sections and Details					1	12/2/03		
M-53	Pipe Rack D & E Sections and Details					1	12/2/03		
M-54	Pipe Rack C Sections and Details					1	12/2/03		
M-55	Electrical Tray & Pipe Supports Details					1	12/2/03		
M-56	Pipe & Electrical Trays Supports Location Plan Fluidized Bed Area					2	12/2/03		
M-57	Pipe Support Details Fluidized Bed Area					3	12/2/03		
M-58	Pipe Support Details Fluidized Bed Area					1	12/2/03		
M-59	Pipe Supports - Sections and Details					1	12/2/03		
M-60	Column and Beam Schedule					1	12/2/03		
M-61	Column and Beam Schedule					1	12/2/03		
M-62	Column & Beam Schedule Pipe Racks C & D					2	12/2/03		
M-65	Piping Plan & Details	4/5/06	A	4/17/06	0	1	10/9/06		
M-66	Piping Plan & Details	4/5/06	A	4/17/06	0	3	10/9/06		
M-67	Piping Plan & Details	4/5/06	A	4/17/06	0	3	10/16/06		
M-68	Piping Plan & Details	4/5/06	A	4/17/06	0	3	10/5/06		
M-69	Overall Piping Plan	4/5/06	A	4/17/06	0	2	10/4/06	2 SHEETS	

Nevada Environmental Response Trust (NERT)
DRAWING LIST

DRAWING NO.	DRAWING TITLE							REMARKS	
		ISSUED FOR APPROVAL		ISSUED FOR CONSTRUCTION		LATEST REVISION			
		DATE	REV	DATE	REV	NO.	DATE		
M-70	Piping Plan & Details	4/5/06	A	4/17/06	0	2	10/4/06		
M-71	Piping Plan & Details	4/5/06	A	4/17/06	0	3	10/4/06		
M-72	Piping Supports Plan Locations	4/28/06	A	5/15/06	0	1	10/25/06		
M-73	Piping Supports Plan Locations	4/28/06	A	5/15/06	0	1	10/25/06		
M-74	Piping Support Details	4/28/06	A	5/15/06	0	2	10/25/06		
M-100	Arrangement - Sand Reactors FBR's 3&4					1	3/4/04		
M-101	Arrangement - Sand Reactors FBR's 1&2					1	3/4/04		
M-110	Arrangement - Separators T-2011, -2012					1	3/4/04		
M-130	Arrangement - Aeration Tank T-401					1	3/4/04		
M-120	Arrangement - GAC Reactors FBR's 5&6					1	3/4/04		
M-121	Arrangement - GAC Reactors FBR's 7&8					2	10/25/06		
40591-600	Arrangement - DAF's					1	3/11/04		
40591-601	Arrangement - DAF's					2	3/11/04		
40591-602	Arrangement - DAF's					3	3/11/04		
40591-603	Arrangement - DAF's					1	3/11/04		
40591-604	Arrangement - DAF's					3	3/11/04		
40591-500	Arrangement - Aeration Equipment					1	3/11/04		
40591-501	Arrangement - Aeration Equipment					1	3/11/04		
M-102	Arrangement - Separators T-3011, -3012					1	4/7/04		
M-180	Arrangement - Solids Conditioning Tank T-901					1	3/4/04		
M-140	Arrangement - Effluent Tank T-601					1	3/4/04		

NERT GWETS Perchlorate Treatment System
Revision 2 – November 2013
1373-O-02

Nevada Environmental Response Trust (NERT)
DRAWING LIST

DRAWING NO.	DRAWING TITLE							REMARKS
		ISSUED FOR APPROVAL		ISSUED FOR CONSTRUCTION		LATEST REVISION		
		DATE	REV	DATE	REV	NO.	DATE	
M-170	Arrangement - Ferric Chloride Tank T-751					1	3/4/04	
M-150	Arrangement - Nutrient Tank T-702					1	3/4/04	
M-190	Arrangement - Filtrate Tank T-902					1	3/4/04	
M-160	Arrangement - Ethanol Tank T-703					2	3/4/04	
40591-200	Component Specs - FBR Pump Skids 1-2 & 3-4					1	3/11/04	
40591-201	Arrangement - FBR Pump Skid 1-2					3	4/13/04	
40591-202	Arrangement - FBR Pump Skid 1-2					2	4/13/04	
40591-203	Arrangement - FBR Pump Skid 3-4					3	4/13/04	
40591-204	Arrangement - FBR Pump Skid 3-4					2	4/13/04	
40591-220	Component Specs - FBR Pump Skids 5-6 & 7-8					1	3/11/04	
40591-221	Arrangement - FBR Pump Skid 5-6					3	4/13/04	
40591-222	Arrangement - FBR Pump Skid 5-6					3	4/13/04	
40591-223	Arrangement - FBR Pump Skid 7-8					3	4/13/04	
40591-224	Arrangement - FBR Pump Skid 7-8					3	4/13/04	
40591-240	Arrangement - Effluent Pump Skid					1	3/11/04	
40591-241 Sht.1	Arrangement - Effluent Pump Skid					2	3/11/04	
40591-241 Sht.2	Arrangement - Effluent Pump Skid					2	3/11/04	
M-165	Arrangement - Ethanol Pump Skid	5/17/06	4			6	10/25/06	
M-135	Arrangement - Biofilter					1	3/4/04	
M-136	Arrangement - Biofilter					2	10/25/06	

Nevada Environmental Response Trust (NERT)
DRAWING LIST

DRAWING NO.	DRAWING TITLE							REMARKS	
		ISSUED FOR APPROVAL		ISSUED FOR CONSTRUCTION		LATEST REVISION			
		DATE	REV	DATE	REV	NO.	DATE		
TSOV-4408	Arrangement - Caustic Pump Skid	5/17/06	B	5/23/06	B				
TSOV-4409	Arrangement - Nutrient Pump Skid	5/17/06	B	5/23/06	B				
	AP-5 EQUIPMENT ARRANGEMENTS								
M-103	Arrangement - FBR-A	1/17/06	A	4/6/06	0	2	10/25/06		
M-104	Arrangement - FBR-A Separator	1/17/06	A	4/6/06	0	2	10/25/06		
M-105	Arrangement - FBR-A Fluidization Pumps			4/6/06	0	2	10/25/06		
M-111	Arrangement - Sludge Tank T-1603			5/15/06	0	0	3/30/06		
M-112	Arrangement - Effluent Pump Suction Tank T-621			5/15/06	0	1	10/25/06		
M-113	Arrangement - Polymer Feed System			5/15/06	0	0	5/15/06		
M-114	Arrangement - AP-5 Pond Pump Skid	2/28/06	B	4/6/06	0	1	5/18/06		
M-115	Arrangement - Caustic Tank T-701	2/28/06	A	5/15/06	0	1	10/25/06		
M-116	Arrangement - Oxygenation System					0	3/30/06		
M-117	Arrangement - Sand Filter Basin T-1702			5/15/06	0	1	10/25/06	Appvd as GA-1 sht 4	
M-118	Arrangement Backwash Pump Skid P-1701A/B	2/28/06	A	4/6/06	0	2	10/25/06		
M-119	Arrangement - Filter Reject Tank	2/28/06	A	5/15/06	0	1	10/25/06		
M-125	Arrangement Phosphoric Acid Pump Skid		A			0	5/15/06		
	2013 NERT MODIFICATIONS								
1373 M-204	FBR 1-4 BIOMASS SEPARATOR INSTALLATION					A	11/15/13		
1373 M-205	FBR 1-4 BIOMASS SEPARATOR AIR PANEL					0	11/15/13		
1373 M-300	FBR 1-4 BIOMASS SEPARATOR DETAIL					0	11/15/13		

Nevada Environmental Response Trust (NERT)
DRAWING LIST

DRAWING NO.	DRAWING TITLE							REMARKS
		ISSUED FOR APPROVAL		ISSUED FOR CONSTRUCTION		LATEST REVISION		
		DATE	REV	DATE	REV	NO.	DATE	
1373 M-301	Equalization Area Piping Revisions					A	11/15/13	
1373 M-302	Equalization Area Piping Revisions					A	11/15/13	
1373 M-303	Equalization Area Piping Revisions					A	11/15/13	
1373 M-304	Equalization Area Piping Revisions					A	11/15/13	
1373 M-305	Equalization Area Piping Revisions					C	11/15/13	
1373 M-350	GW-11 Pond Suction Fitting					D	11/15/13	
	CIVIL							
C-1	Site Plan					0	2/6/04	
C-2	Drainage Plan					0	2/6/04	
C-3	North Elevation View					0	2/6/04	
C-4	Site Grading Plan					3	3/31/04	
C-5	Site Plan Evacuation Route					1	4/2/04	
	STRUCTURAL							
S-1	Concrete Foundation					6	2/6/04	
S-2	Floor Plan					11	2/6/04	
S-3	Sections and Details					7	3/31/04	
S-4	Tank Walkway					8	2/6/04	
S-5	Tank Walkway					4	3/31/04	
S-6	Tank Walkway Plan					4	12/2/03	
S-7	Pipe Bridge, DAF & Solids Tk Walkway Plan					6	2/6/04	

NERT GWETS Perchlorate Treatment System
Revision 2 – November 2013
1373-O-02

G-10

Drawing List

Nevada Environmental Response Trust (NERT)
DRAWING LIST

DRAWING NO.	DRAWING TITLE	ISSUED FOR APPROVAL		ISSUED FOR CONSTRUCTION		LATEST REVISION		REMARKS
		DATE	REV	DATE	REV	NO.	DATE	
		S-8	Stairs & Platform Sections and Details					
S-9	Pipe Bridge Sections and Details					3	12/2/03	
S-10	Sections and Details					2	2/6/04	
S-11	Guide Rail Ethanol Tank					1	2/6/04	
S-12	Concrete Plan & Sections - Equalization Area					2	2/6/04	
KP-2	Steel Platform and Pipe Rack Key Plan					3	12/2/03	
	<u>AP-5 STRUCTURAL</u>							
S-21	Sand Filter Concrete Layout	7/25/05	A	1/13/06	0	5	10/16/06	
S-21A	Concrete Notes sand Filter			4/20/06	0	1	10/16/06	
S-22	Sand Filter Concrete Details	7/25/05	A	1/13/06	0	3	10/16/06	
S-23	Sand Filter Concrete Details	7/25/05	A	1/13/06	0	3	10/16/06	
S-24	FBR-A Concrete Layout	7/25/05	A	1/13/06	0	2	10/16/06	
S-25	FBR-A Concrete Details	7/25/05	A	1/13/06	0	2	10/16/06	
S-26	FBR-A Catwalk Extension	7/25/05	A	1/13/06	0	2	10/18/06	
S-27	FBR D-1 Bldg New Pad Layouts and Detail	7/25/05	A	1/13/06	0	5	10/18/06	
S-28	Stair Notes			4/20/06	0	1	10/18/06	
S-29	Stair Plan Sand Filter			4/20/06	0	2	10/18/06	
S-30	Concrete Sections			4/20/06	0	2	10/19/06	
S-31	Stair Sections & Details			4/20/06	0	2	10/19/06	

Nevada Environmental Response Trust (NERT)
DRAWING LIST

DRAWING NO.	DRAWING TITLE							REMARKS
		ISSUED FOR APPROVAL		ISSUED FOR CONSTRUCTION		LATEST REVISION		
		DATE	REV	DATE	REV	NO.	DATE	
	<u>ELECTRICAL</u>							
E-0	Electrical Drawing List	7/25/05	2	1/13/06	3	5	4/19/06	
E-1	Single Line Diagram					1	3/19/04	
E-2	Single Line Diagram					1	3/19/04	
E-3	Elementary Diagram					1	3/19/04	
E-4	Elementary Diagram					2	3/19/04	
E-5	Elementary Diagram					1	3/19/04	
E-6	Elementary Diagram					1	3/19/04	
E-7	Elementary Diagram					1	3/19/04	
E-8	Elementary Diagram					1	3/19/04	
E-9	Site Grounding	7/25/05	6	1/13/06	7	8	2/21/06	
E-10	Grounding Details & Sections			1/13/06	3			
E-11	Lighting Plan - Tank Containment Area	7/25/05	3	1/13/06	4			
E-12	Schedules and General Notes	7/25/05	4	1/13/06	5			
E-13	Cable Tray Plan	7/25/05	4	1/13/06	5	6	2/16/06	
E-14	Cable Tray Section & Details & B/M	7/25/05	2	1/13/06	3			
E-15	Cable Tray Section & Details					1	3/19/04	
E-16	Exposed Conduit Plan					2	3/19/04	
E-17	Exposed Conduit Plan	7/25/05	4	1/13/06	5	6	2/16/06	
E-18	Exposed Conduit Plan					3	3/19/04	
E-19	Exposed Conduit Plan					4	3/19/04	

Nevada Environmental Response Trust (NERT)
DRAWING LIST

DRAWING NO.	DRAWING TITLE							REMARKS
		ISSUED FOR APPROVAL		ISSUED FOR CONSTRUCTION		LATEST REVISION		
		DATE	REV	DATE	REV	NO.	DATE	
E-20	Exposed Conduit Plan					4	3/19/04	
E-21	Exposed Conduit Plan	7/25/05	2	1/13/06	3			
E-22	Exposed Conduit Plan					1	3/19/04	
E-23	Partial Exposed Conduit Plan	7/25/05	6	1/13/06	7			
E-24	Standard Details					1	3/19/04	
E-25	Conduit and Cable Schedule					1	3/19/04	
E-26	Conduit and Cable Schedule					1	3/19/04	
E-27	Conduit and Cable Schedule					2	3/19/04	
E-28	Conduit and Cable Schedule					1	3/19/04	
E-29	Conduit and Cable Schedule					5	3/19/04	
E-30	Conduit and Cable Schedule					2	3/19/04	
E-31	Conduit and Cable Schedule					1	3/19/04	
E-32	Conduit and Cable Schedule					2	3/19/04	
E-33	Conduit and Cable Schedule					1	3/19/04	
E-34	Conduit and Cable Schedule					2	3/19/04	
E-35	Conduit and Cable Schedule					3	3/19/04	
E-36	Conduit and Cable Schedule					4	3/19/04	
E-38	Exposed Conduit Plan					2	4/13/04	
E-40	Heat Trace - Standard Details					1	3/19/04	

Nevada Environmental Response Trust (NERT)
DRAWING LIST

DRAWING NO.	DRAWING TITLE							REMARKS	
		ISSUED FOR APPROVAL		ISSUED FOR CONSTRUCTION		LATEST REVISION			
		DATE	REV	DATE	REV	NO.	DATE		
E-41	Heat Trace - Schematic Diagram					2	3/19/04		
E-42	Heat Trace - Schematic Diagram	7/25/05	2	1/13/06	3	4	2/16/06		
E-43	Heat Trace - Schematic Diagram								
E-45	Heat Trace - Schedule					2	3/19/04		
E-46	Heat Trace - Schedule & Bill of Materials								
E-47	Grounding Details EQ Area					1	3/19/04		
E-48	Grounding Plan	7/25/05	A	1/13/06	0				
E-49	Lighting Plan	7/25/05	A	1/13/06	0	1	2/16/06		
E-50	Conduit and Cable Tray Extension Plan	7/25/05	A	1/13/06	0	2	5/9/06		
E-51	Conduit Plan	7/25/05	A	1/13/06	0	1	2/16/06		
E-52	Conduit Plan	7/25/05	A	1/13/06	0	1	2/16/06		
E-53	Electrical Elementary Diagram	7/25/05	A	1/13/06	0	2	5/9/06		
E-54	Electrical Elementary Diagram	7/25/05	A	1/13/06	0	1	2/16/06		
E-55	Electrical Elementary Diagram	7/25/05	A	1/13/06	0	1	2/16/06		
E-56	Conduit and Cable Schedule	7/25/05	A	1/13/06	0	1	2/16/06		
E-57	Conduit and Cable Schedule	7/25/05	A	1/13/06	0	2	5/9/06		
E-58	Conduit and Cable Schedule	7/25/05	A	1/13/06	0	2	4/3/06		
E-59	Conduit and Cable Schedule	7/25/05	A	1/13/06	0	1	2/16/06		
E-60	System Architecture	7/25/05	A	1/13/06	0				
E-61	Building D-1 MCC-1 Front Elevation	7/25/05	A	1/13/06	0	2	5/9/06		

Nevada Environmental Response Trust (NERT)
DRAWING LIST

DRAWING NO.	DRAWING TITLE							REMARKS	
		ISSUED FOR APPROVAL		ISSUED FOR CONSTRUCTION		LATEST REVISION			
		DATE	REV	DATE	REV	NO.	DATE		
E-62	Building D-1 MCC-1 One Line Diagram	7/25/05	A	1/13/06	0	3	5/9/06		
E-63	Building D-1 MCC-1 One Line Diagram	7/25/05	A	1/13/06	0	2	4/19/06		
E-64	Building D-1 MCC-2 Layout	7/25/05	A	1/13/06	0	1	2/16/06		
E-65	Building D-1 MCC-2 One Line Diagram	7/25/05	A	1/13/06	0	2	4/19/06		
E-66	Building D-1 MCC-2 One Line Diagram	7/25/05	A	1/13/06	0	2	4/19/06		
E-67	Building D-1 MCC-2 One Line Diagram	7/25/05	A	1/13/06	0	1	2/16/06		
E-68	Building D-1 MCC-1 PLC I/O	7/25/05	A	1/13/06	0	1	2/16/06		
E-69	Building D-1 MCC-1 PLC I/O	7/25/05	A	1/13/06	0	1	2/16/06		
E-70	Building D-1 MCC-1 PLC I/O	7/25/05	A	1/13/06	0	1	2/16/06		
E-71	Building D-1 MCC-1 PLC I/O	7/25/05	A	1/13/06	0	1	4/19/06		
E-72	Building D-1 MCC-1 PLC I/O	7/25/05	A	1/13/06	0	1	2/16/06		
E-73	Building D-1 MCC-2 PLC I/O	7/25/05	A	1/13/06	0	1	2/16/06		
E-74	Building D-1 MCC-2 PLC I/O	7/25/05	A	1/13/06	0	1	2/16/06		
E-75	Building D-1 MCC-2 PLC I/O	7/25/05	A	1/13/06	0	1	2/16/06		
E-76	MCC Building PLC I/O	7/25/05	A	1/13/06	0				
E-77	Electrical Schematic Diagram AP-5 Control Panel	8/8/05	A	1/13/06	0	1	2/16/06		
E-78	Electrical Schematic Diagram AP-5 Control Panel	8/8/05	A	1/13/06	0				
E-79	Electrical Details AP-5 Control Panel	8/8/05	A	1/13/06	0	1	2/16/06		
E-80	Electrical Details AP-5 Control Panel	8/8/05	A	1/13/06	0	1	2/16/06		

Nevada Environmental Response Trust (NERT)
DRAWING LIST

DRAWING NO.	DRAWING TITLE	ISSUED FOR APPROVAL		ISSUED FOR CONSTRUCTION		LATEST REVISION		REMARKS
		DATE	REV	DATE	REV	NO.	DATE	
		<u>ELECTRICAL REFERENCE DRAWINGS</u>						
E-165-1	Bill of Materials, Electron Donor Skid- Sht 1					1	11/24/03	
E-165-2	Electrical Details, Electron Donor Skid- Sht 2					1	11/24/03	
E-165-3	Electrical Details, Electron Donor Skid- Sht 3					1	11/24/03	
E-165-4	Electrical Details, Electron Donor Skid- Sht 4					1	11/24/03	
E-165-5	Electrical Details, Electron Donor Skid- Sht 5					1	11/24/03	
E-165-6	Electrical Details, Electron Donor Skid- Sht 6					1	11/24/03	
E-165-7	Electrical Details, Electron Donor Skid- Sht 7					1	11/24/03	
E-308-1	Dual H-120 Biofilter Control Panel Layout					0	11/24/03	
E-308-2	Dual H-120 Biofilter Control Panel Schematic					0	11/24/03	
	<u>Instrumentation</u>							
	Instrumentation Site Plan							
	Instrumentation Site Plan							
40591-894-01	PLC Panel - Electrical Schematic	7/25/05	3	1/13/06	4			
40591-894-02	PLC Panel - Electrical Schematic					2	3/11/04	
40591-894-03	PLC Panel - Electrical Schematic					2	3/11/04	
40591-894-04	PLC Panel - Electrical Schematic					2	3/11/04	
40591-894-05	PLC Panel - Electrical Schematic	7/25/05	3	1/13/06	4			
40591-894-06	PLC Panel - Electrical Schematic					2	3/11/04	
40591-894-07	PLC Panel - Electrical Schematic					1	3/11/04	

Nevada Environmental Response Trust (NERT)
DRAWING LIST

DRAWING NO.	DRAWING TITLE							REMARKS	
		ISSUED FOR APPROVAL		ISSUED FOR CONSTRUCTION		LATEST REVISION			
		DATE	REV	DATE	REV	NO.	DATE		
40591-894-08	PLC Panel - Electrical Schematic					2	3/11/04		
40591-894-09	PLC Panel - Electrical Schematic					1	3/11/04		
40591-894-10	PLC Panel - Electrical Schematic					2	3/11/04		
40591-894-11	PLC Panel - Electrical Schematic					2	3/11/04		
40591-894-12	PLC Panel - Electrical Schematic	7/25/05	4	1/13/06	5	6	2/16/06		
40591-894-13	PLC Panel - Electrical Schematic					1	3/11/04		
40591-894-14	PLC Panel - Electrical Schematic					1	3/11/04		
40591-894-15	PLC Panel - Electrical Schematic					2	3/11/04		
40591-894-16	PLC Panel - Electrical Schematic					3	3/11/04		
40591-894-17	PLC Panel - Electrical Schematic					1	3/11/04		
40591-894-18	PLC Panel - Electrical Schematic					2	3/11/04		
40591-894-19	PLC Panel - Electrical Schematic					3	3/11/04		
40591-894-20	PLC Panel - Interior Layout					3	3/11/04		
40591-894-21	PLC Panel - Exterior Layout and BOM					3	3/11/04		
40591-894-22	PLC Panel - List of Interconnects					3	3/11/04		
40591-894-23	PLC Panel - List of Interconnects					3	3/11/04		
40591-894-24	PLC Panel - List of Interconnects					3	3/11/04		
40591-894-25	Interconnect Diagram					1	3/11/04		

Nevada Environmental Response Trust (NERT)
DRAWING LIST

DRAWING NO.	DRAWING TITLE							REMARKS	
		ISSUED FOR APPROVAL		ISSUED FOR CONSTRUCTION		LATEST REVISION			
		DATE	REV	DATE	REV	NO.	DATE		

G:\ENGRING\1373-101 Tronox Service\5.0 O&M Manual\Rev 2-April-2014\0-Working_Parts\1373-OM-zAPG_Rev2_Drawing List.xls

Nevada Environmental Response Trust (NERT)
DRAWING LIST

DRAWING NO.	DRAWING TITLE								
		ISSUED FOR APPROVAL		ISSUED FOR CONSTRUCTION		LATEST REVISION		REMARKS	
		DATE	REV	DATE	REV	NO.	DATE		

Nevada Environmental Response Trust (NERT)
DRAWING LIST

DRAWING NO.	DRAWING TITLE	ISSUED FOR APPROVAL						ISSUED FOR CONSTRUCTION		LATEST REVISION		REMARKS
		ISSUED FOR APPROVAL		ISSUED FOR CONSTRUCTION		LATEST REVISION		NO.	DATE			
		DATE	REV	DATE	REV	NO.	DATE					

Nevada Environmental Response Trust (NERT)
DRAWING LIST

DRAWING NO.	DRAWING TITLE							REMARKS	
		ISSUED FOR APPROVAL		ISSUED FOR CONSTRUCTION		LATEST REVISION			
		DATE	REV	DATE	REV	NO.	DATE		

NERT GWETS Perchlorate Treatment System
Revision 2 – November 2013
1373-O-02

G:\ENGRING\1373-101 Tronox Service\5.0 O&M Manual\Rev 2-April-2014\0-Working_Parts\1373-OM-zAPG_Rev2_Drawing List.xls

Nevada Environmental Response Trust (NERT)
DRAWING LIST

DRAWING NO.	DRAWING TITLE								
		ISSUED FOR APPROVAL		ISSUED FOR CONSTRUCTION		LATEST REVISION		REMARKS	
		DATE	REV	DATE	REV	NO.	DATE		

APPENDIX H P&ID'S

NEVADA ENVIRONMENTAL RESPONSE TRUST GWETS FLUIDIZED BED PERCHLORATE TREATMENT SYSTEM PROCESS DRAWINGS


DRAWING #	KMG FILE #	DESCRIPTION
X	1373-P0	Cover Sheet
X	1373-PFD01 Sht 1	Process Flow Diagram
X	1373-PFD01 Sht 2	Process Flow Diagram Mass Balance
X	1373-PFD02	Process Flow Diagram Well & EQ System
X	1373-PID-LA Sht LA	P&ID Legend Sheets
X	1373-PID-LA Sht LB	P&ID Legend Sheets
X	1373-PID-NI	P&ID Notes
X	1373-PID01A	P&ID Fluid Bed Perchlorate System
X	1373-PID01B	P&ID Fluid Bed Perchlorate System
X	1373-PID02A	P&ID Fluid Bed Perchlorate System
X	1373-PID02B	P&ID Fluid Bed Perchlorate System
X	1373-PID03A	P&ID Fluid Bed Perchlorate System
X	1373-PID03B	P&ID Fluid Bed Perchlorate System
X	1373-PID03C	P&ID Fluid Bed Perchlorate System
X	1373-PID03D	P&ID Fluid Bed Perchlorate System
X	1373-PID04	P&ID Fluid Bed Perchlorate System
X	1373-PID05	P&ID Fluid Bed Perchlorate System
X	1373-PID06	P&ID Fluid Bed Perchlorate System
X	1373-PID07A	P&ID Fluid Bed Perchlorate System
X	1373-PID07B	P&ID Fluid Bed Perchlorate System
X	1373-PID07C	P&ID Fluid Bed Perchlorate System
X	1373-PID08	P&ID Fluid Bed Perchlorate System
X	1373-PID09	P&ID Fluid Bed Perchlorate System
X	1373-PID10A	P&ID Equalization Area & Basin
X	1373-PID10B	P&ID Equalization Area, Piping & Basin
X	1373-PID10C	P&ID Equalization Area, Piping & Basin
X	1373-PID11	P&ID Utility Systems
X	1373-PID12	P&ID Utility Systems
X	1373-PID13	P&ID AP-5 Pond Equipment
X	1373-PID14	P&ID FBR-A System
X	1373-PID15	P&ID Phosphoric Acid Feed
X	1373-PID16	P&ID Sludge Storage & Oxygen Skid
X	1373-PID17	P&ID Sand Filter
X	1373-HYD01 Sht 1	Hydraulic Profile
X	1373-HYD01 Sht 2	Hydraulic Profile

NOTE: ALL ITEMS MARKED WITH "X" ARE NEW OR MODIFIED DRAWINGS

REV.	DATE	DESCRIPTION OF REVISION	REVISION BY	DATE
Δ	11-15-13	RECORD DRAWING - REVISED FOR 2013 CURRENT OPERATIONS & REVISED DATA WORKSHEET	DM	DM
Δ	9-26-06	RECORD DRAWING	DM	RE
Δ	4-26-06	ISSUED FOR CONSTRUCTION, PER-108 WORKED	DM	RE
Δ	12-27-05	ISSUED FOR CONSTRUCTION	DM	SF



U.S. PATENTS 5750028, 5788842, 6706521 AND PATENTS PENDING.

THIS DRAWING IS A VISUAL REPRESENTATION OF THE EQUIPMENT AND/OR SYSTEM PROPOSED. IT IS NOT INTENDED FOR CONSTRUCTION PURPOSES.

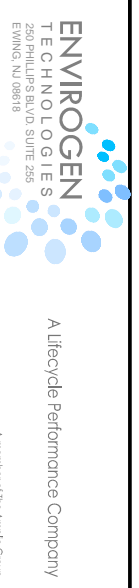

ALL INFORMATION CONTAINED ON THIS DOCUMENT IS THE PROPERTY OF ENVIROGEN TECHNOLOGIES, INC. ("ENVIROGEN") AND/OR ITS AFFILIATES. THE DESIGN CONCEPTS AND INFORMATION CONTAINED HEREIN ARE PROPERTY OF ENVIROGEN AND ARE SUBMITTED IN CONFIDENCE. THEY ARE NOT TRANSFERABLE AND MUST BE USED ONLY FOR THE PROJECT AND/OR SITE SPECIFICALLY IDENTIFIED HEREIN. NO PART OF THIS DOCUMENT IS TO BE REPRODUCED, COPIED, LOANED OR USED IN ANY OTHER MANNER WITHOUT THE EXPRESS WRITTEN CONSENT OF ENVIROGEN. ENVIROGEN ASSUMES NO RESPONSIBILITY OR LIABILITY FOR THE USE OF THIS DOCUMENT OR THE DESIGN CONCEPTS CONTAINED HEREIN FOR ANY PROJECT OTHER THAN THAT SPECIFICALLY IDENTIFIED HEREIN. ENVIROGEN'S ORIGINAL INTENDED USE OF THIS DOCUMENT IN NO EVENT SHALL THIS DOCUMENT OR THE DESIGN CONCEPTS CONTAINED HEREIN BE USED FOR ANY OTHER PROJECT OR SITE WITHOUT THE EXPRESS WRITTEN CONSENT OF ENVIROGEN. THE RIGHTS AND OBLIGATIONS OF ENVIROGEN AND ITS CUSTOMER ARE RESERVED AND ACCEPTANCE OF THE DELIVERY OF THIS DOCUMENT CONSTITUTES AGREEMENT TO THESE TERMS AND CONDITIONS.

FORMING SCALE	N/A
DESIGNED BY/DATE	DM / 12-21-05
DRAWN BY/DATE	DM / 12-21-05
CHECKED BY/DATE	SF / 12-21-05
SHEET SIZE	D
REVISION	3
PROJECT #	1373-P0
SHEET 1 OF 1	

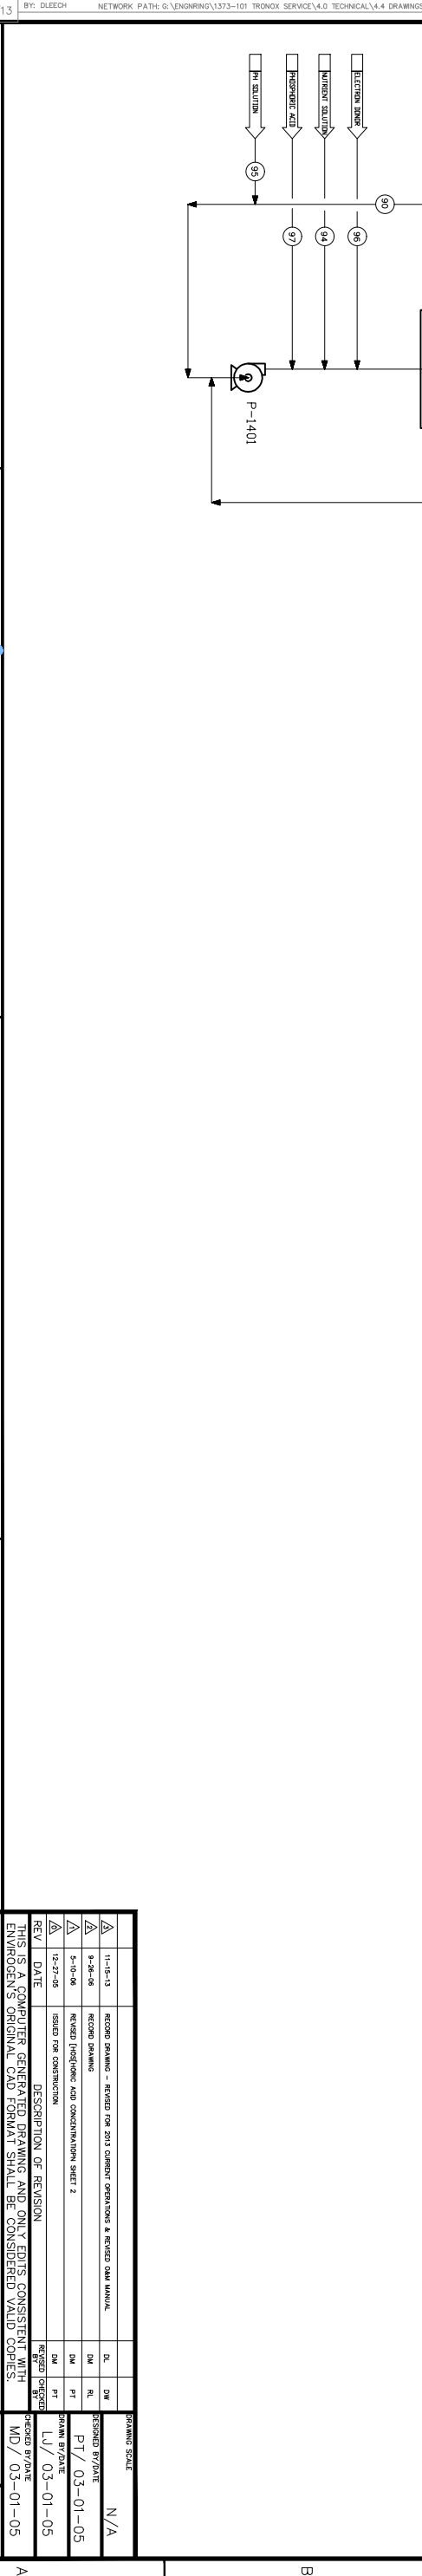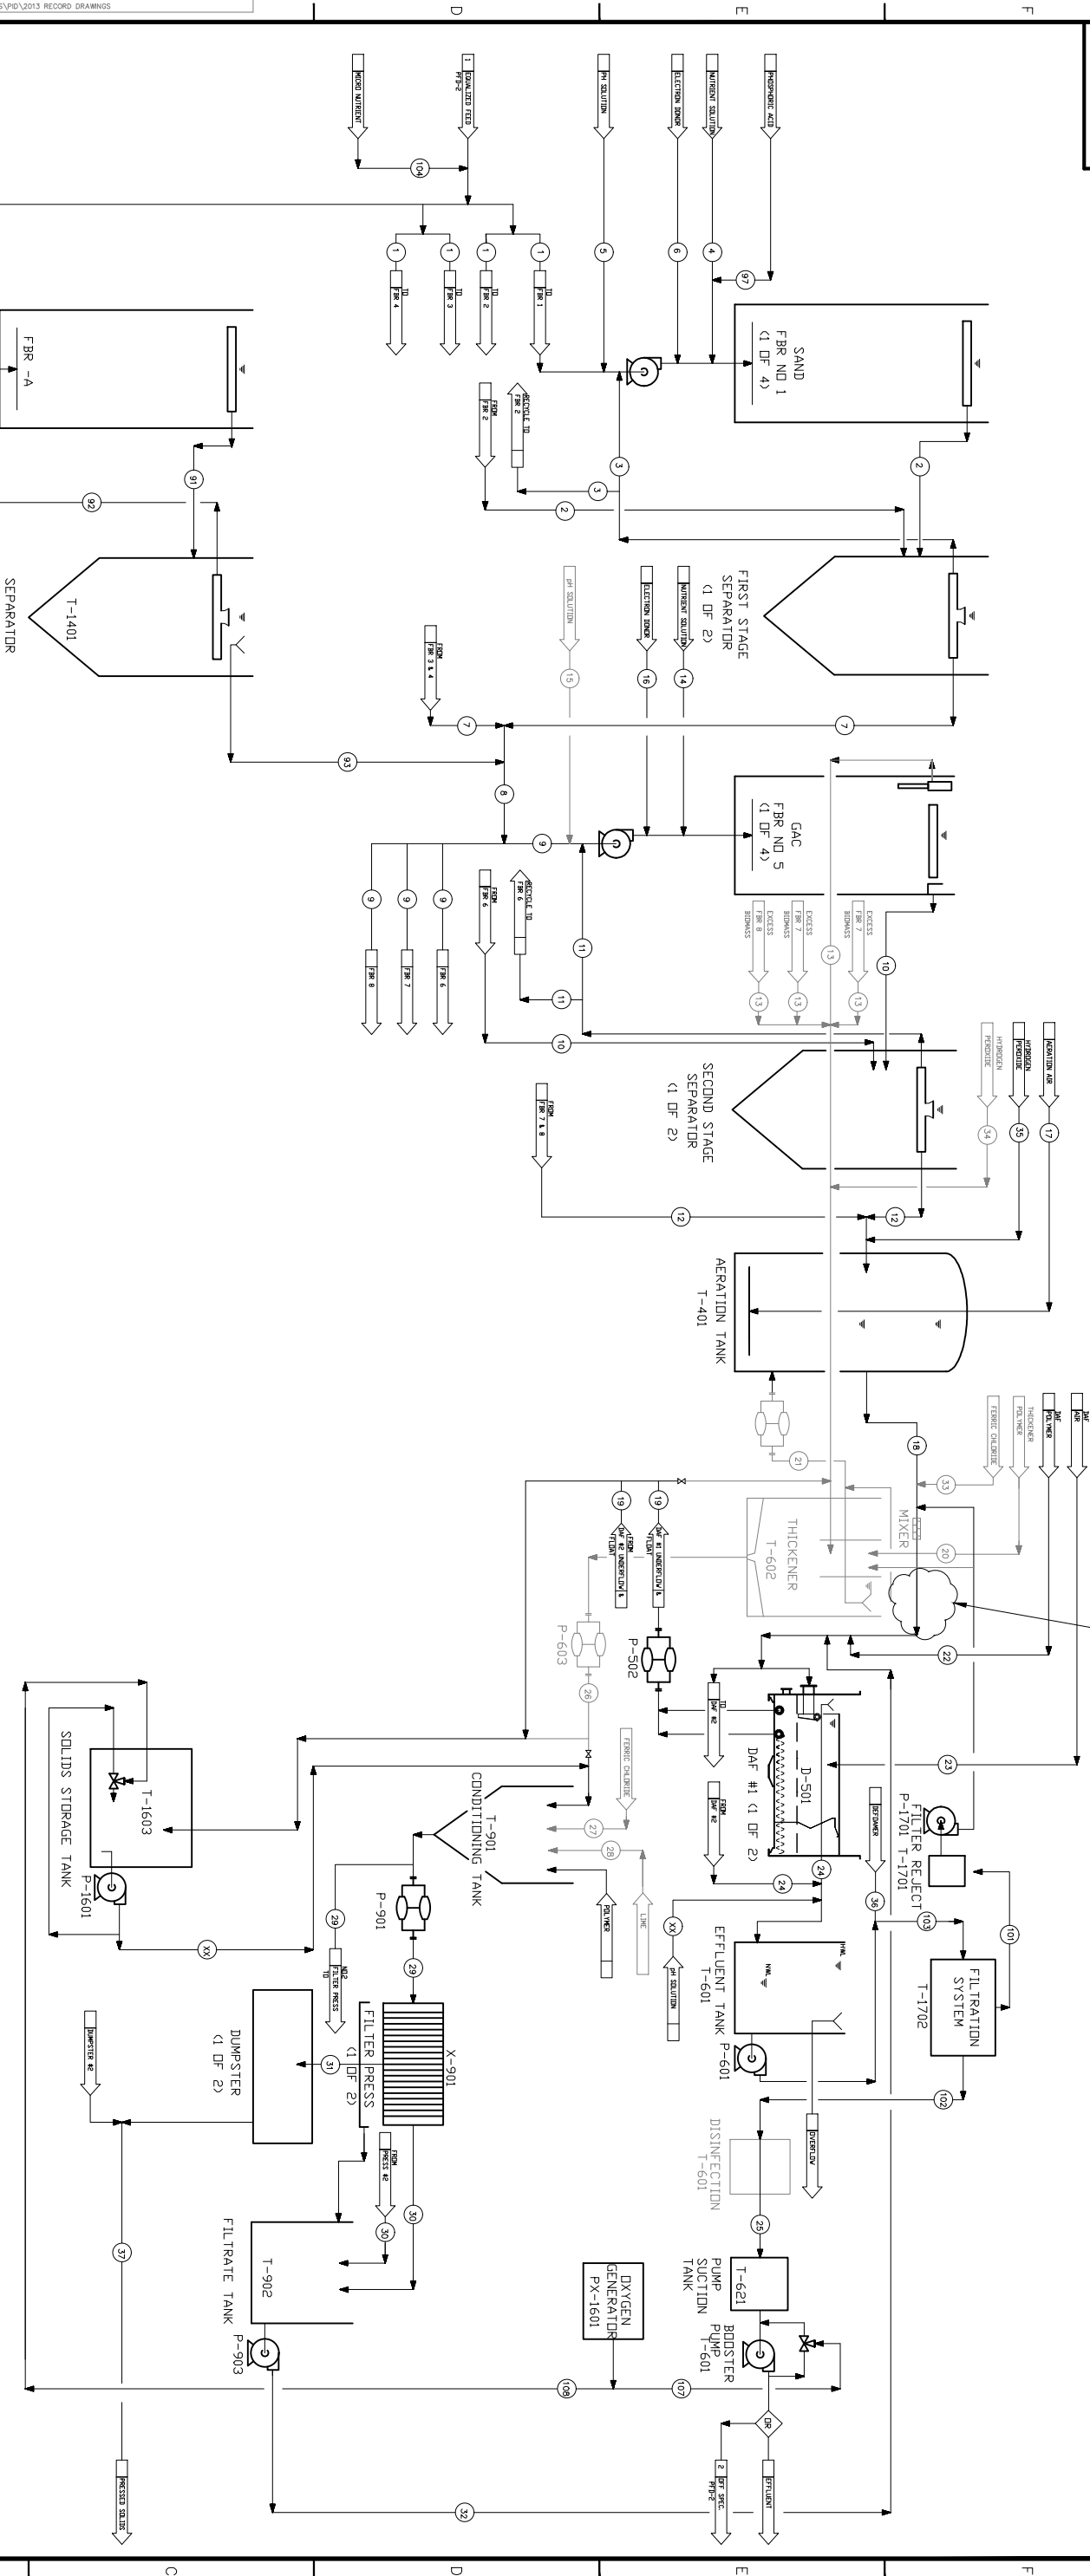

U.S. PATENTS 5750028, 5788842, 6706521 AND PATENTS PENDING.

ENVIROGEN TECHNOLOGIES
 250 PHILLIPS BLVD. SUITE 255
 EMMEN, NV 08818

A lifecycle Performance Company
 A member of The Amgen Group

ALL INFORMATION CONTAINED ON THIS DOCUMENT IS THE PROPERTY OF ENVIROGEN TECHNOLOGIES, INC. (ENVIROGEN) AND/OR ITS AFFILIATES. THE DESIGN CONCEPTS AND INFORMATION CONTAINED HEREIN ARE PROPERTY OF ENVIROGEN AND ARE SUBMITTED IN CONFIDENCE. THEY ARE NOT TRANSFERABLE AND MUST BE USED ONLY FOR THE PROJECT AND/OR THE FACILITY FOR WHICH THEY WERE DEVELOPED. ANY REPRODUCTION, DISTRIBUTION, OR REPRODUCTION, LOANED OR USED IN ANY OTHER MANNER WITHOUT THE EXPRESS WRITTEN CONSENT OF ENVIROGEN IS STRICTLY PROHIBITED. ENVIROGEN ASSUMES NO RESPONSIBILITY OR LIABILITY FOR THE USE OF THIS DOCUMENT OR THE DESIGN CONCEPTS CONTAINED HEREIN. ENVIROGEN MAKES NO WARRANTY, REPRESENTATION, OR GUARANTEE, EXPRESS OR IMPLIED, REGARDING THE ORIGINALITY, INTENDED USE OF THIS DOCUMENT. IN NO EVENT SHALL THIS DOCUMENT OR THE DESIGN CONCEPTS CONTAINED HEREIN BE CONSIDERED A CONTRACT OR A SOURCE OF OBLIGATIONS OF ENVIROGEN AND ITS CUSTOMER. ENVIROGEN'S LIABILITY IS LIMITED TO THE EXTENT OF THE DOCUMENTS AND OBLIGATIONS OF ENVIROGEN AND ITS CUSTOMER ARE RESERVED. ACCEPTANCE OF THE DELIVERY OF THIS DOCUMENT CONSTITUTES AGREEMENT TO THESE TERMS AND CONDITIONS.

REV.	DATE	DESCRIPTION OF REVISION	DESIGNED BY/DATE	CHECKED BY/DATE
1	11-15-13	RECORD DRAWING - REVISED FOR 2013 CURRENT OPERATIONS & REVISED DAM MATERIAL	DM	DM
2	9-26-06	RECORD DRAWING	DM	DM
3	5-10-06	REVISED HYDROCHLORIC ACID CONCENTRATION SHEET 2	DM	DM
4	12-27-05	ISSUED FOR CONSTRUCTION	DM	DM

THIS IS A COMPUTER GENERATED DRAWING AND ONLY EDITS CONSISTENT WITH ENVIROGEN'S ORIGINAL CAD FORMAT SHALL BE CONSIDERED VALID COPIES.

PROCESS FLOW DIAGRAM
 FLUIDIZED BED PERCHLORATE
 TREATMENT SYSTEM

HENDERSON, NV
 NERT

SHEET 1 OF 2
 1373-PFD01
 SHEET SIZE: D
 REVISION: 3

MATERIAL BALANCE

THE MATERIAL BALANCE REFLECTS THE MAXIMUM DESIGN CAPABILITY OF THE 2006 PERCHLORATE TREATMENT PROCESS.

Values During Effluent Discharge at 30-Day Average Maximum Flow																															
Characteristic	1	2	3	4	5	6	7	8	9	10	11	12	13	14	15	16	17	18	19	20	21	22	23	24	25	26	27	28	29	30	
WATER FLOW (NOTE 4, 9, 10, 11)	gal/min	199	1,801	-	-	-	396	995	249	1,998	1,751	473	125	-	-	-	-	48	1,052	3.1	107	-	4	523	995	4.7	-	-	2,822	2.5	
AIR OR OXYGEN FLOW	scfm	-	-	-	-	-	-	-	-	-	-	-	-	-	-	-	-	-	-	-	-	-	-	<0.004	<0.004	<0.004	<0.004	<0.004	<0.004	<0.004	
ClO ₂ (NOTE 3)	mg/L	25	25	-	-	-	25	25	<0.004	<0.004	<0.004	<0.004	<0.004	<0.004	<0.004	<0.004	<0.004	<0.004	<0.004	<0.004	<0.004	<0.004	<0.004	<0.004	<0.004	<0.004	<0.004	<0.004	<0.004	<0.004	
NO ₂ -N	mg/L	<0.1	<0.1	-	-	-	<0.1	<0.1	<0.1	<0.1	<0.1	<0.1	<0.1	<0.1	<0.1	<0.1	<0.1	<0.1	<0.1	<0.1	<0.1	<0.1	<0.1	<0.1	<0.1	<0.1	<0.1	<0.1	<0.1	<0.1	
NH ₃ -N	mg/L	<0.1	<0.1	-	-	-	<0.1	<0.1	<0.1	<0.1	<0.1	<0.1	<0.1	<0.1	<0.1	<0.1	<0.1	<0.1	<0.1	<0.1	<0.1	<0.1	<0.1	<0.1	<0.1	<0.1	<0.1	<0.1	<0.1	<0.1	
PO ₄ -P	mg/L	12	0.5	0.5	-	-	0.5	0.5	0.5	0.5	0.5	0.5	0.5	0.5	0.5	0.5	0.5	0.5	0.7	0.7	2.5	-	0.7	0.7	0.5	6.4	6.4	>10.3	>10.3	>10.3	
Chloride	mg/L	2,000	2,316	-	-	-	2,316	2,316	2,316	2,325	2,325	2,325	2,325	2,325	2,325	2,325	2,412	2,412	2,433	3,190	-	6.4	-	6.4	6.4	6.4	-	-	19,581	19,581	
pH		7.3	6.5	6.5	-	-	6.5	6.5	6.4	6.4	6.4	6.4	6.4	6.4	6.4	6.4	6.5	6.5	6.4	6.4	-	6.4	-	6.4	6.4	6.4	-	-	26,516	26,516	
TDS	mg/L	5,400	5,882	-	-	-	5,882	5,882	5,882	5,882	5,882	5,882	5,882	5,882	5,882	5,882	5,973	5,994	5,994	6,901	-	5,994	-	5,994	5,994	5,994	-	-	100,000	11,750	
TSS	mg/L	<10	150	150	-	-	150	150	152	152	152	152	152	152	152	152	197	25,000	25,000	-	599	-	599	-	-	-	-	-	-	-	
NUTRIENT SOLUTION (NOTE 1)	lbs/day	-	-	-	-	-	-	-	-	-	-	-	-	-	-	-	-	-	-	-	-	-	-	-	-	-	-	-	-	-	
ELECTRON DONOR (NOTE 2)	gal/day	-	-	-	-	-	-	-	-	-	-	-	-	-	-	-	-	-	-	-	-	-	-	-	-	-	-	-	-	-	
CAUSTIC (25%)	gal/day	-	-	-	-	-	-	-	-	-	-	-	-	-	-	-	-	-	-	-	-	-	-	-	-	-	-	-	-	-	
POLYMER #1 (DAF)	gal/day	-	-	-	-	-	-	-	-	-	-	-	-	-	-	-	-	-	-	-	-	-	-	-	-	-	-	-	-	-	
POLYMER #2 (CLARIFIER)	gal/day	-	-	-	-	-	-	-	-	-	-	-	-	-	-	-	-	-	-	-	-	-	-	-	-	-	-	-	-	-	
FERRIC CHLORIDE (36%) (NOTE 14)	gal/day	-	-	-	-	-	-	-	-	-	-	-	-	-	-	-	-	-	-	-	-	-	-	-	-	-	-	-	-	-	-
LIME (NOTE 13, 14)	lbs/day	-	-	-	-	-	-	-	-	-	-	-	-	-	-	-	-	-	-	-	-	-	-	-	-	-	-	-	-	-	-
HYDROGEN PEROXIDE (35%)	gal/day	-	-	-	-	-	-	-	-	-	-	-	-	-	-	-	-	-	-	-	-	-	-	-	-	-	-	-	-	-	-
DEFOAMER	gal/day	-	-	-	-	-	-	-	-	-	-	-	-	-	-	-	-	-	-	-	-	-	-	-	-	-	-	-	-	-	-
MICRONUTRIENTS	gal/day	-	-	-	-	-	-	-	-	-	-	-	-	-	-	-	-	-	-	-	-	-	-	-	-	-	-	-	-	-	-
PHOSPHORIC ACID (75%)	gal/day	-	-	-	-	-	-	-	-	-	-	-	-	-	-	-	-	-	-	-	-	-	-	-	-	-	-	-	-	-	-

- GENERAL NOTES:
1. FLOW IS FOR UREA SOLUTION (4.0 LB UREA/GALLON)
 2. FLOW IS FOR DENATURED ETHANOL AS ELECTRON DONOR (95% ETHANOL, 5% OTHER ORGANIC), 190 PROOF.
 3. THE PERCHLORATE CONCENTRATION IS THE VALUE SHOWN OR THE MDL WHICHEVER IS GREATER.
 4. UNLESS STATED OTHERWISE, FLOWS ARE AVERAGE MAXIMUM FLOWS, NOT MAXIMUM INSTANTANEOUS FLOWS.
 5. VALUES STATED ARE IN GALLONS/DAY.
 6. CAUSTIC ADDED AS REQUIRED.
 7. VALUES STATED ARE IN CU FT/DAY AVERAGE FROM EACH PRESS.

8. LIMITS BASED ON LOAD AND CALCULATED BY THE FORMULA:

$$\frac{((0.90 \times \text{NO}_2\text{-N}) + (0.17 \times \text{ClO}_2) + (0.18 \times \text{ClO}_2))}{(\text{FLOW} \times 1.440(1,000,000))} \times 34 < 1.983$$

$$\frac{\text{WHI NO}_2\text{-N}}{34} < \text{OR} = 50 \text{ mg/L AND}$$

$$\frac{\text{ClO}_2 < \text{OR} = 500 \text{ mg/L AND}}$$

$$\frac{\text{ClO}_2 < \text{OR} = 400 \text{ mg/L}}$$
 ASSUMES OPERATION AT 100% OF FULL LOAD.

9. SYSTEM DESIGNED FOR A MAXIMUM HYDRAULIC FLOW OF 1,000 GALLONS PER MINUTE
10. SYSTEM 30-DAY AVERAGE MAXIMUM FLOW = 1,000 GPM
11. SYSTEM DESIGN AVERAGE ANNUAL FLOW = 950 GPM
12. LIFTED FLOWS FOR TWO DAFs & FILTER PRESSES OPERATING.
13. LIME USAGE BASED ON PREVIOUS SYSTEM USAGE OF 20 TONS PER PER MONTH.

Values During Effluent Discharge at 30-Day Average Maximum Flow																															
Characteristic	31	32	33	34	35	36	37	90	91	92	93	94	95	96	97	101	102	103	104	107	108										
WATER FLOW (NOTE 4, 9, 10, 11)	gal/min	101	5.0	-	-	-	201	199	2,000	1,801	199	-	-	-	-	50	995	1,045	-	-	-										
AIR OR OXYGEN FLOW	scfm	-	-	-	-	-	-	-	-	-	-	-	-	-	-	-	-	-	-	-	-										
ClO ₂ (NOTE 3)	mg/L	<0.004	<0.004	-	-	-	<0.004	(NOTE 8)	25	<0.1	<0.1	<0.1	<0.1	<0.1	<0.1	<0.004	<0.1	<0.1	<0.1	<0.1	<0.1										
NO ₂ -N	mg/L	<0.1	<0.1	-	-	-	<0.1	(NOTE 8)	<0.1	<0.1	<0.1	<0.1	<0.1	<0.1	<0.1	<0.1	<0.1	<0.1	<0.1	<0.1	<0.1										
NH ₃ -N	mg/L	<0.1	<0.1	-	-	-	<0.1	(NOTE 8)	<0.1	<0.1	<0.1	<0.1	<0.1	<0.1	<0.1	<0.1	<0.1	<0.1	<0.1	<0.1	<0.1										
PO ₄ -P	mg/L	-	200	-	-	-	-	12	1	0.5	0.5	0.5	0.5	0.5	0.7	0.7	0.7	0.7	0.7	0.7	0.7										
Chloride	mg/L	19,581	19,581	-	-	-	19,581	2,000	2,316	2,316	2,316	-	-	-	-	2,433	2,433	2,433	-	-	-										
pH		>10.3	>10.3	-	-	-	>10.3	7.3	6.5	6.5	6.5	6.5	6.5	6.5	6.4	6.4	6.4	6.4	6.4	6.4	6.4										
TDS	mg/L	26,516	26,516	-	-	-	26,516	6,400	5,882	5,882	5,882	-	-	-	-	5,994	5,994	5,994	-	-	-										
TSS	mg/L	300,000	11,750	-	-	-	300,000	<10	150	150	150	-	-	-	-	567	3	30	-	-	-										
NUTRIENT SOLUTION (NOTE 1)	gal/day	-	-	-	-	-	-	3,765	-	-	-	-	-	-	-	-	-	-	-	-	-										
ELECTRON DONOR (NOTE 2)	gal/day	-	-	-	-	-	-	-	-	-	-	-	-	-	-	-	-	-	-	-	-										
CAUSTIC (25%)	gal/day	-	-	-	-	-	-	-	-	-	-	-	-	-	-	-	-	-	-	-	-										
POLYMER #1 (DAF)	gal/day	-	-	-	-	-	-	-	-	-	-	-	-	-	-	-	-	-	-	-	-										
POLYMER #2 (CLARIFIER)	gal/day	-	-	-	-	-	-	-	-	-	-	-	-	-	-	-	-	-	-	-	-										
FERRIC CHLORIDE (36%) (NOTE 14)	gal/day	-	-	-	-	-	-	-	-	-	-	-	-	-	-	-	-	-	-	-	-										
LIME (NOTE 13, 14)	lbs/day	-	-	-	-	-	-	-	-	-	-	-	-	-	-	-	-	-	-	-	-										
HYDROGEN PEROXIDE (35%)	gal/day	-	-	-	-	-	-	-	-	-	-	-	-	-	-	-	-	-	-	-	-										
DEFOAMER	gal/day	-	-	-	-	-	-	-	-	-	-	-	-	-	-	-	-	-	-	-	-										
MICRONUTRIENTS	gal/day	-	-	-	-	-	-	-	-	-	-	-	-	-	-	-	-	-	-	-	-										
PHOSPHORIC ACID (75%)	gal/day	-	-	-	-	-	-	-	-	-	-	-	-	-	-	-	-	-	-	-	-										

- GENERAL NOTES:
14. FLOWSHEET ASSUMES WORST CASE OF USING LIME AND FERRIC CHLORIDE FOR SOLIDS CONDITIONING. FROM EXPERIENCE, USE OF POLYMER SUBSTANTIALLY REDUCES LIME AND FERRIC CHLORIDE USAGE AND REDUCES SLUDGE GENERATION.

REV	DATE	DESCRIPTION OF REVISION	DESIGNED BY/DATE	CHECKED BY/DATE	SCALE
1	11-14-13	RECORD DRAWING - REVISED FOR 2013 CURRENT OPERATIONS & REVISED DATA	DM	DM	N/A
2	9-26-06	RECORD DRAWING	DM	DM	PT/03-01-05
3	5-10-06	REVISED PHOSPHORIC ACID CONCENTRATION	DM	DM	PT/03-01-05
4	12-27-06	ISSUED FOR CONSTRUCTION	DM	DM	PT/03-01-05
5	12-27-06	REVISED RECORD DRAWING	DM	DM	PT/03-01-05

THIS IS A COMPUTER GENERATED DRAWING AND ONLY EDITS CONSISTENT WITH ENVIROGEN'S ORIGINAL CAD FORMAT SHALL BE CONSIDERED VALID COPIES.

PROCESS FLOW DIAGRAM
 FLUIDIZED BED PERCHLORATE
 TREATMENT SYSTEM

HENDERSON, NV


SHEET 2 OF 2

PROJECT # 1373-PFD01

DATE 03-01-05

SCALE 3/8" = 1'-0"

U.S. PATENTS 5750028, 5788842, 6706521 AND PATENTS PENDING.

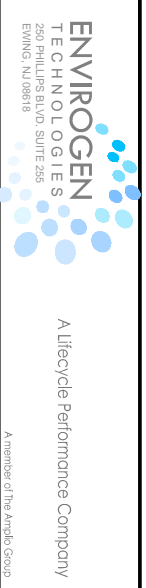


All information contained on this document is the property of Envirogen Technologies, Inc. ("Envirogen") and/or its affiliates. The design concepts and information contained herein are proprietary to Envirogen and are submitted in confidence. They are not to be reproduced and must be used only for the project and site specifically identified herein. No part of this document may be reproduced, stored, copied, or used in any other manner without the express written consent of Envirogen. Envirogen assumes no responsibility or liability for the use of any information or design concepts shown herein. ORIGINAL INTENDED USE OF THIS DOCUMENT IS NO EVENT SHALL THIS DOCUMENT OR THE DESIGN CONCEPTS THEREIN BE REPRODUCED, STORED, COPIED, OR USED IN ANY OTHER MANNER WITHOUT THE EXPRESS WRITTEN CONSENT OF ENVIROGEN. THE DESIGN CONCEPTS SHOWN HEREIN ARE NOT TO BE REPRODUCED, STORED, COPIED, OR USED IN ANY OTHER MANNER WITHOUT THE EXPRESS WRITTEN CONSENT OF ENVIROGEN.

U.S. PATENTS 5750028, 5788842, 6706521 AND PATENTS PENDING.

ENVIROGEN TECHNOLOGIES
 250 PHILLIPS BLVD, SUITE 255
 ENVIRO, NV 89818

A Lifecycle Performance Company

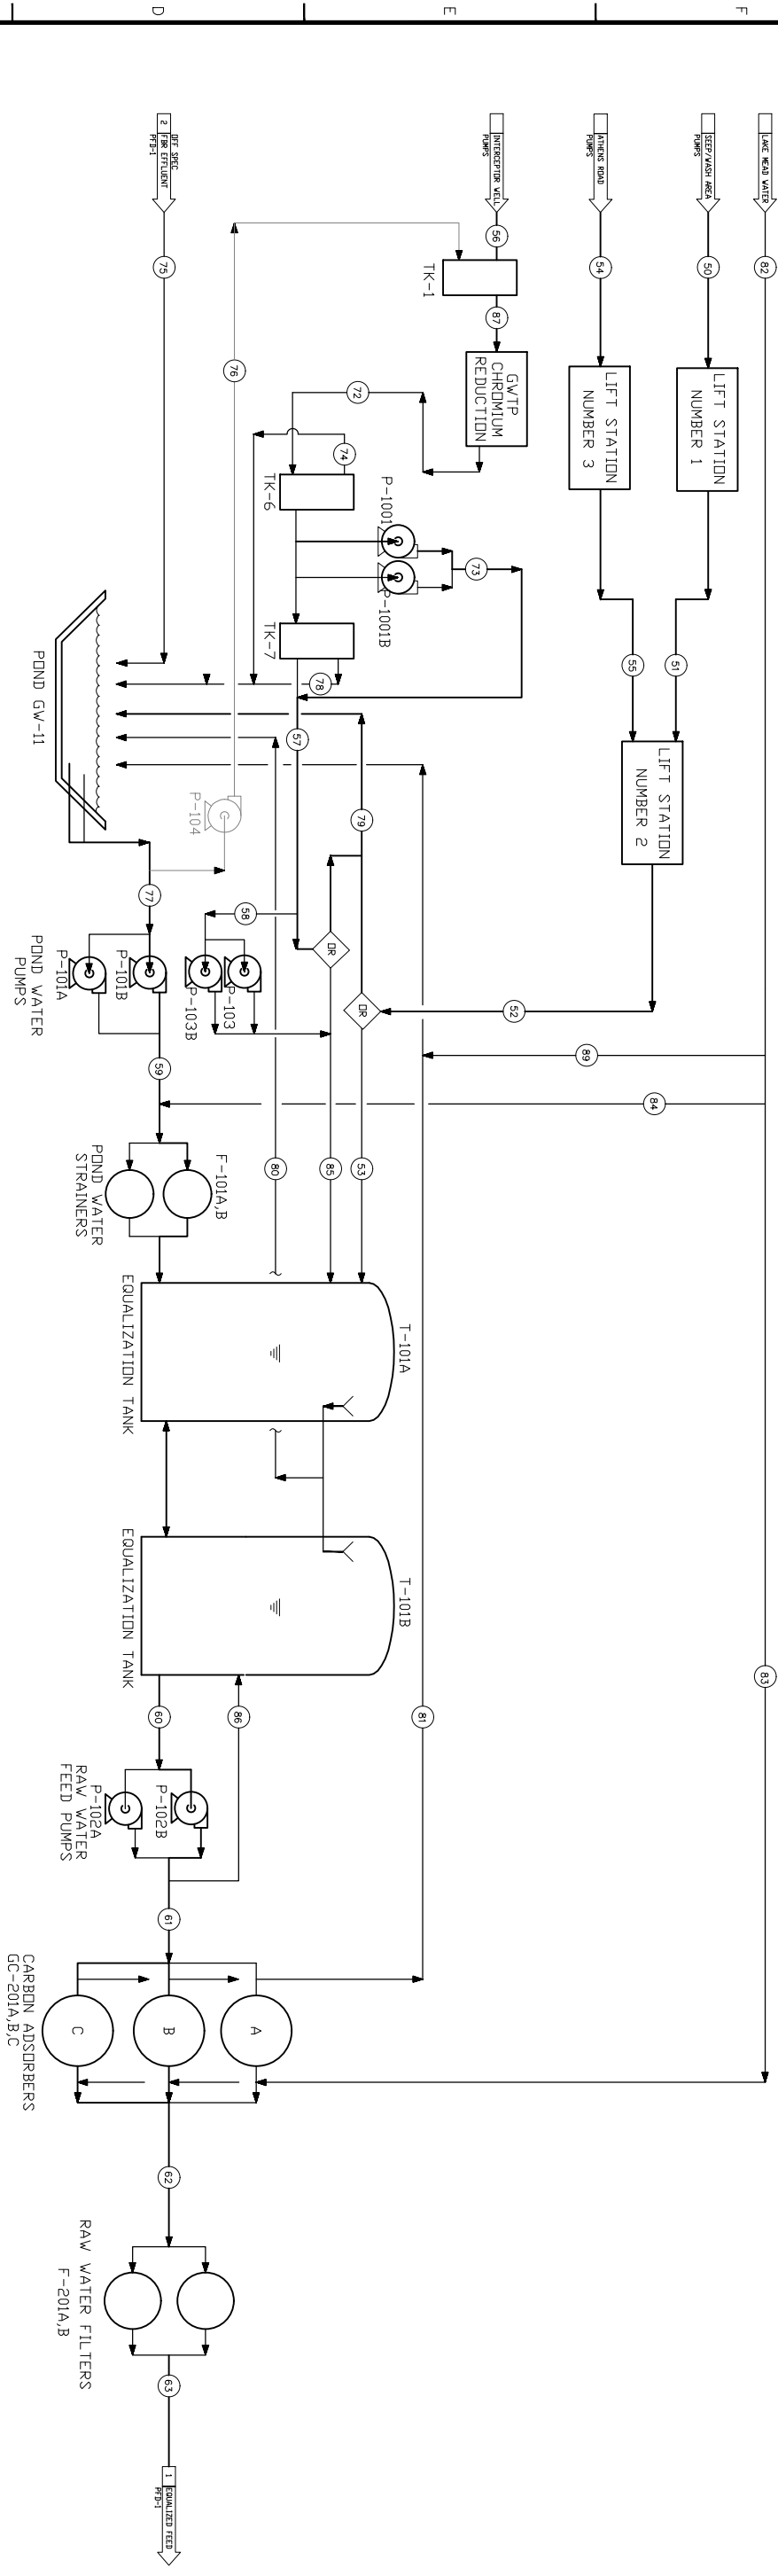

THE MATERIAL BALANCE REFLECTS THE MAXIMUM DESIGN CAPABILITY OF THE 2006 PERCHLORATE TREATMENT PROCESS.

MATERIAL BALANCE

Characteristic	50	51	52	53	54	55	56	57	58	59	60	61	62	63	64	65	66	67	68	69	70	71	72	73	74	75	76 (NOTE 6)	77	78	79	80	81	82	83	84	85	86	87	88	89
Flow (Notes 2, 3, 4, 5)	675	675	925	925	250	250	58	70	70	995	995	0	0	0	0	0	0	0	0	73	73	0	0	0	0	15	0	3	0	0	0	0	0	0	0	73	400 (NOTE 8)	39,700 (NOTE 7)	—	
ClO ₄	23	23	90	90	271	271	1,400	3,373	3,373	321	321	—	—	—	—	—	—	—	—	3,373	3,373	—	—	—	—	11,000	—	3,373	—	—	—	—	—	—	—	3,373	39,700	—		
ClO ₃	35	35	130	130	386	386	3,200	5,008	5,008	473	473	—	—	—	—	—	—	—	—	5,008	5,008	—	—	—	—	12,000	—	5,008	—	—	—	—	—	—	5,008	325	—			
NO ₃ -N	6	6	17	17	46	46	42	97	97	22	22	—	—	—	—	—	—	—	—	97	97	—	—	—	—	310	—	97	—	—	—	—	—	—	97	115	—			
TDS	—	—	—	—	—	—	—	—	—	6,400	6,400	—	—	—	—	—	—	—	—	—	—	—	—	—	—	—	—	—	—	—	—	—	—	—	—	106,700	—			

VALUES DURING EFFLUENT DISCHARGE AT 30 DAY AVERAGE MAXIMUM FLOW

- GENERAL NOTES:
- OPERATED ONLY WHEN CARBON ADSORBERS ARE BACKWASHED.
 - UNLESS STATED OTHERWISE, FLOWS ARE AVERAGE MAXIMUM FLOWS.
 - SYSTEM DESIGNED FOR A MAXIMUM HYDRAULIC FLOW OF 1,000 GALLONS PER MINUTE
 - SYSTEM 30 DAY AVERAGE MAXIMUM FLOW = 1,000 GPM

- SYSTEM DESIGN AVERAGE ANNUAL FLOW = 950 GPM
- APPROXIMATE GW-11 COMPOSITION BASED ON: (1) ADDITION OF AP-5 WATER AT A RATE OF 50,000 GALLONS PER WEEK UNTIL 1.6 MILLION GALLONS HAVE BEEN TRANSFERRED; (2) MAINTAINING AN APPROXIMATE GW-11 VOLUME OF 25 MILLION GALLONS VIA STABILIZED LAKE MEAD WATER ADDITION.

- FLOW DURING TRANSFER ASSUMES DILUTION OF 1 PART AP-5 WATER WITH 2 PARTS STABILIZED LAKE MEAD WATER.
- AS NEEDED TO MAINTAIN GW-11 VOLUME.

REV	DATE	DESCRIPTION OF REVISION	DESIGNED BY/DATE	CHECKED BY/DATE
Δ	11-14-13	RECORD DRAWING - REVISION FOR 2013 CURRENT OPERATIONS & REVISION DATA MANUAL	DL	DL
Δ	9-26-06	RECORD DRAWING	DL	DL
Δ	5-23-06	ADD GW-11 REFL FROM LAKE MEAD WATER, REV 8A, ADD 8B NOTES 7 & 8	RL	RL
Δ	12-27-05	ISSUED FOR CONSTRUCTION	RL	RL

THIS IS A COMPUTER GENERATED DRAWING AND ONLY EDITS CONSISTENT WITH ENVIROGEN'S ORIGINAL CAD FORMAT SHALL BE CONSIDERED VALID COPIES.

U.S. PATENTS 5750028, 5788842, 6706521 AND PATENTS PENDING.


ENVIROGEN
TECHNOLOGIES
250 PHILLIPS BLVD SUITE 255
EVINGTON, NJ 08018

A Lifecycle Performance Company
A member of the Amec Group

PROCESS FLOW DIAGRAM
EXISTING WELL & EQUALIZATION SYSTEM


PROJECT # HENDERSON, NV
SHEET 1 OF 1
1373-PFD02

PIPING SYMBOLS

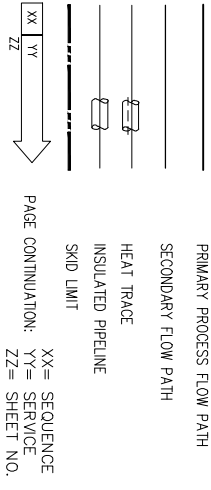


XX = SEQUENCE
 YY = SERVICE
 ZZ = SHEET NO.






INSTRUMENT LINE SYMBOLS

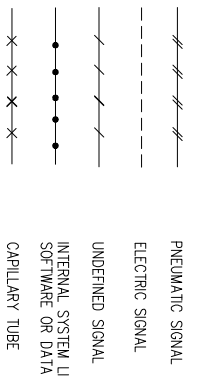



VALVE ACTUATOR SYMBOLS

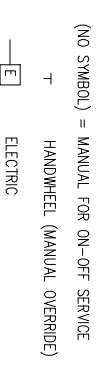


(NO SYMBOL) = MANUAL FOR ON-OFF SERVICE

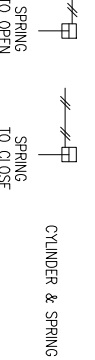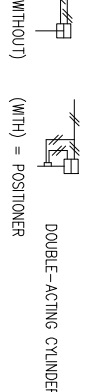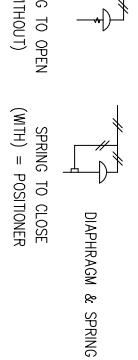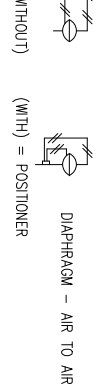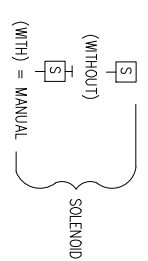





SYMBOLS FOR VALVE ACTION IN THE EVENT OF ACTUATOR POWER FAILURE.

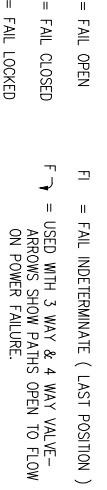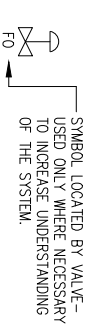


PRIME MOVERS FOR MOTOR DRIVEN EQUIPMENT

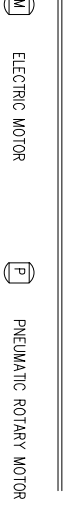





SYMBOLS FOR SELF-ACTUATED REGULATORS

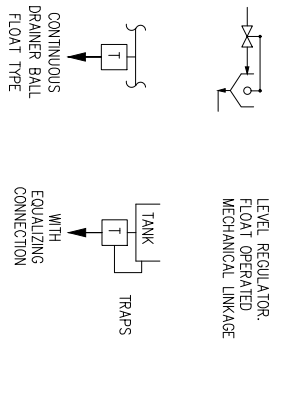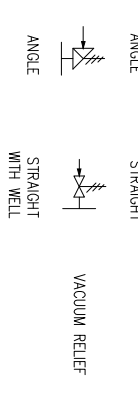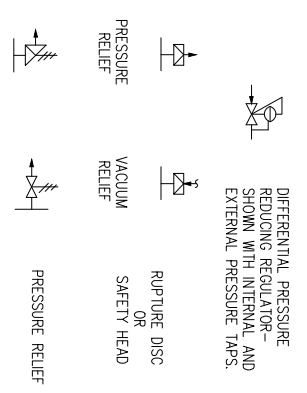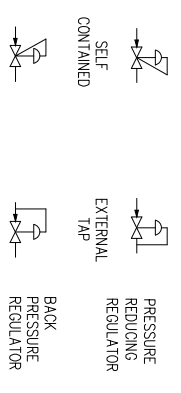


HEAT EXCHANGER SYMBOLS

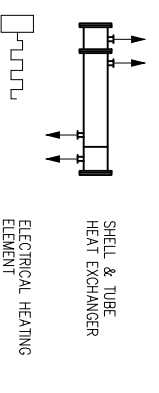






MOTOR DRIVEN EQUIPMENT

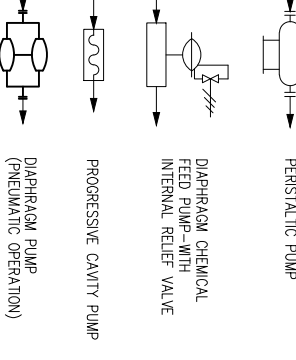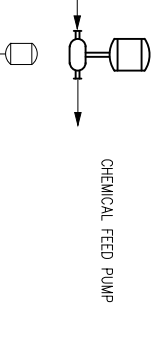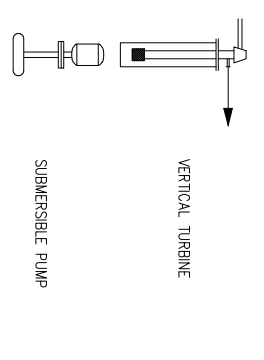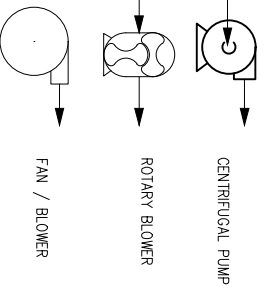


PIPE LINE DESIGNATION

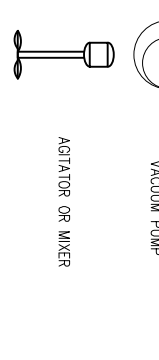


PIPING ACCESSORIES AND DETAILS

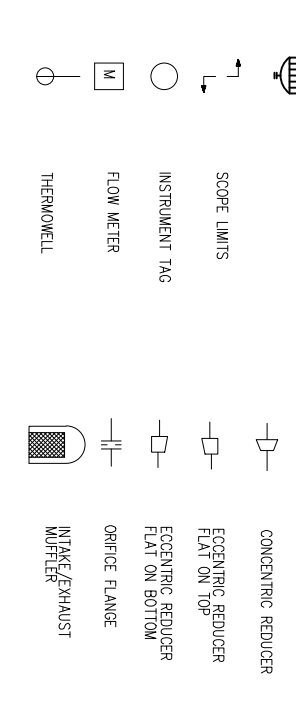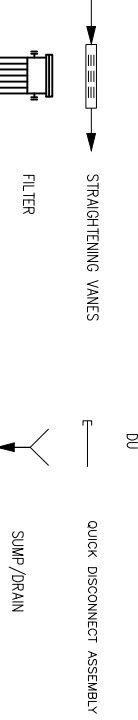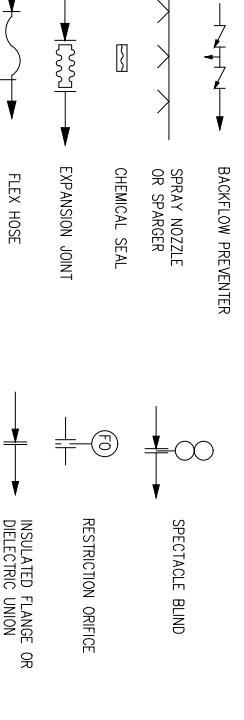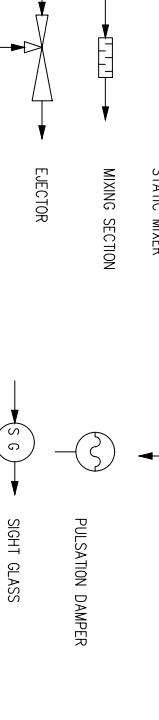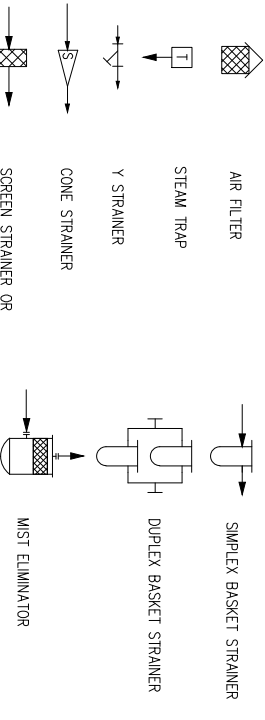

VALVE SYMBOLS

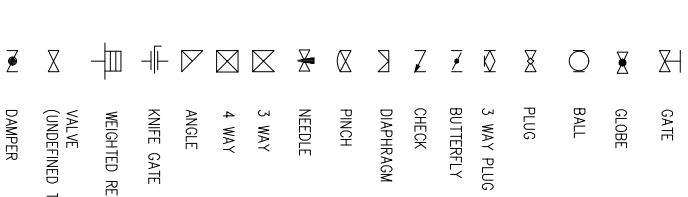

TANK ACCESSORIES

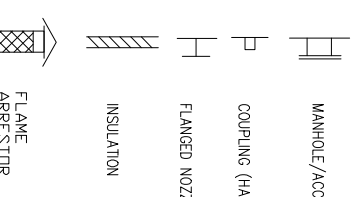

PIPING SERVICE MATERIAL DESIGNATIONS


SERVICE	SERVICE DESIGNATION	PIPING MATERIAL SPECIFICATION	MATERIAL OF CONSTRUCTION
BLOWER AIR	BA	SQ4P10	304 ST STL
SERVICE AIR	CA	CS1P40	CARBON STEEL
ELECTRON DONOR	ED	SQ4P10	304 ST STL
FERRIC CHLORIDE	FC	CVCP90	GPVC
INSTRUMENT AIR	IA	CS1P40	CARBON STEEL
NUTRIENT	NIJ	CVCP90/PPPT	GPVC/POLYPRO
POLYMER	P	CVCP90	GPVC
SODIUM HYDROXIDE (CAUSTIC)	SH	CVCP90/PPPT	GPVC/POLYPRO
SLUDGE	SL	CVCP90	GPVC
SERVICE WATER	SW	CVCP90	GPVC
TREATED WATER	TW	CVCP90	GPVC
WASTE WATER	WW	CVCP90/CPVCP40/FRPP	GPVC/FRP
PROCESS AIR	PA	CVCP90	GPVC
OXYGEN	OZ	SQ4P90 / SQ4T	304 ST STL

GENERAL NOTES:


1. FOR INSTRUMENTATION SYMBOLS, AND LIST OF RELAY FUNCTIONS, SEE SHAW DRAWING NO. PID-1B (SHEET 2 OF 2).
 THIS IS A STANDARD PROCEDURE DRAWING, AND MAY NOT BE REVISED TO SUIT ANY PARTICULAR PROJECT OR CUSTOMER.
 THIS DRAWING IS PROVIDED FOR INFORMATION ONLY.

REV	DATE	DESCRIPTION OF REVISION	REVISION
1	11-15-13	RECORD DRAWING - REVISION FOR 2013 CURRENT OPERATIONS & REVISION DATA MANUAL	DL
2	9-26-06	RECORD DRAWING	DL
3	12-27-05	ISSUE FOR CONSTRUCTION	DL

SYMBOLS FOR FLOW MEASUREMENT

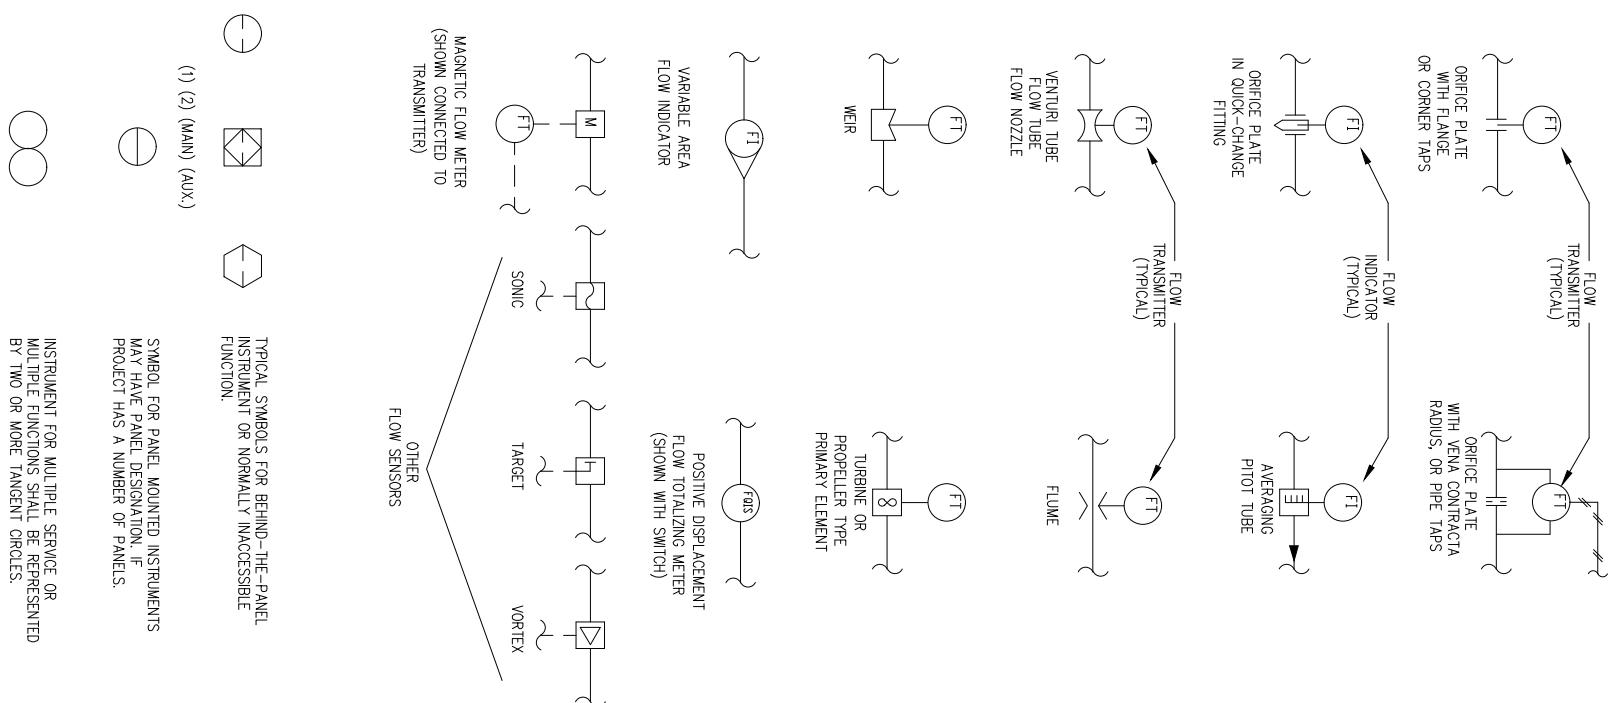

MISCELLANEOUS SYMBOLS

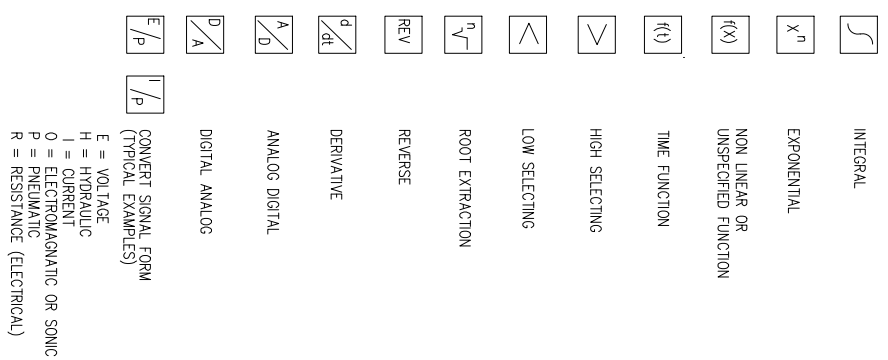

INSTRUMENT IDENTIFICATION LETTERS

MEASURE OR INAIING VARIABLE	FIRST LETTER	MODIFIER	READOUT OR PASSIVE FUNCTION	SUCCEEDING LETTERS	OUTPUT FUNCTION	MODIFIER
A = ANALYSIS			ALARM			
B = BURNER, COMBUSTION			USER'S CHOICE			USER'S CHOICE
C = USER'S CHOICE			CONTROL			USER'S CHOICE
D = USER'S CHOICE			SENSOR (PRIMARY ELEMENT)			USER'S CHOICE
E = VOLTAGE			RATIO (FRACTION)			HIGH
F = FLOW RATE			GLASS, VIEWING DEVICE			
G = USER'S CHOICE			INDICATE			
H = HAND			SCAN			
I = CURRENT (ELECTRICAL)			TIME RATE OF CHANGE			LOW
J = POWER			MOMENTARY			MIDDLE, INTERMEDIATE
K = TIME, TIME SCHEDULE			USER'S CHOICE			USER'S CHOICE
L = LEVEL			POINT (TEST) CONNECTION			
M = USER'S CHOICE			RECORD			
N = USER'S CHOICE			SWITCH			
O = USER'S CHOICE			TRANSMIT			
P = PRESSURE, VACUUM			MULTIFUNCTION			MULTIFUNCTION
Q = QUANTITY			VALVE, DAMPER, LOUVER			
R = RADIATION			UNCLASSIFIED			UNCLASSIFIED
S = SPEED, FREQUENCY			RELAY, COMPUTE, CONVERT			
T = TEMPERATURE			DRIVE, ACTUATOR, UNCLASSIFIED			
U = MULTIVARIABLE			FINAL CONTROL ELEMENT			
V = VIBRATION, MECH. ANALYSIS						
W = WEIGHT, FORCE						
X = UNCLASSIFIED						
Y = EVENT, STATE OR PRESENCE						
Z = POSITION, DIMENSION						

INSTRUMENT SYMBOLS

PRIMARY CONTROL PANEL NORMALLY ACCESSIBLE TO OPERATOR	FIELD MOUNTED	AUXILIARY PANEL OR RACK NORMALLY ACCESSIBLE TO OPERATOR

- NOTES:
 1. ANY FIRST LETTER COMBINED WITH MODIFIER REPRESENTS A NEW AND SEPARATE MEASURED VARIABLE.
 EXAMPLES: PD = DIFFERENTIAL PRESSURE, FO = TOTALIZED OR INTEGRATED FLOW.
 EXCEPTION IS THE MODIFIER "J" FOR MULTIPPOINT SCANNING.
 2. FOR ANALYSIS NOT IDENTIFIED BY A SPECIFIC LETTER IN THE TABLE, USE FIRST LETTER "A".
 3. NEAR THE INSTRUMENT SYMBOL, SPECIFY THE NATURE OF THE ANALYSIS. EXAMPLE: PH
 MEANING OF A "USER CHOICE" LETTER SHALL BE CONSISTENT THROUGHOUT A PROJECT.
 4. UNCLASSIFIED LETTER MAY HAVE A FEW DIFFERENT MEANINGS ON A PROJECT.
 THE MEANING SHALL BE SPECIFIED NEAR EACH INSTRUMENT SYMBOL USING THE UNCLASSIFIED LETTER.
 5. THE MODIFIER "SCAN" APPLIES TO MULTIPPOINT RECORDING INSTRUMENTS.
 SUCH AS CARS (MULTIPPOINT CONDUCTIVITY RECORDER WITH ALARM SWITCHES).

GENERAL NOTES:

1. FOR MECHANICAL SYMBOLS AND ADDITIONAL NOTES.
 SEE SHAW DRAWING NO. PID-LA (SHEET 1 OF 2)

THIS IS A STANDARD PROCEDURE DRAWING, AND MAY NOT BE REVISED TO SUIT ANY PARTICULAR PROJECT OR CUSTOMER.

THIS DRAWING IS PROVIDED FOR INFORMATION ONLY.

REV	DATE	DESCRIPTION OF REVISION	DESIGNED BY/DATE	CHECKED BY/DATE	SCALE
1	11-15-13	RECORD DRAWING - REVISED FOR 2013 CURRENT OPERATIONS & REVISED O&M MANUAL	DM	DM	N/A
2	9-26-06	RECORD DRAWING	DM	DM	RL/12-27-05
3	12-27-05	ISSUED FOR CONSTRUCTION	DM	DM	STD

U.S. PATENTS 5750028, 5788842, 6706521 AND PATENTS PENDING.

ENVIROGEN TECHNOLOGIES
 250 PHILLIPS BLVD, SUITE 255
 EVINGTON, NJ 08018

A Lifecycle Performance Company
 A member of The Ametek Group


PIPING & INSTRUMENTATION DIAGRAM
 LEGEND SHEET
 SHEET 2 OF 2

1373-PID-LB
 REV 1373-PID-LA-2

FLUID BED PERCHLORATE TREATMENT SYSTEM PROCESS & INSTRUMENTATION DIAGRAM NOTES

GENERAL NOTES:

1. ALL PRESSURE GAUGES IN PROCESS WATER LINES INCLUDE CPVC ISOLATION DIAGRAMS W/ SILICONE FILL BETWEEN GAUGE AND PROCESS CONNECTION.
- 2A. FRP PUMPS (OTHER THAN FRP FLUIDIZATION PUMPS) INCLUDE DOUBLE MECHANICAL SEAL WITH SELF-CONTAINED SEAL FLUID SYSTEM.

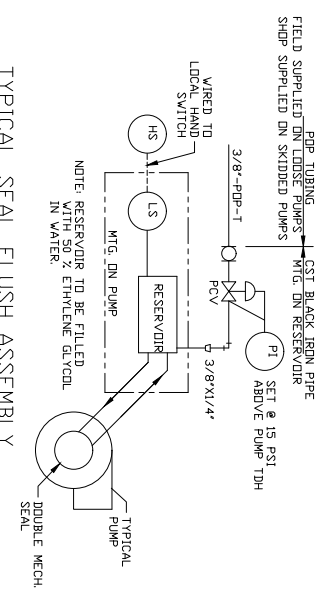

2B. FRP FLUIDIZATION PUMPS ARE PROVIDED WITH SINGLE MECHANICAL SEALS WITH SERVICE WATER FLUSH.

3. ALL OUTDOOR PIPING THAT IS 2" OR SMALLER AND SUSCEPTIBLE TO FREEZING SHALL BE INSULATED. INSULATION SHALL NOT BE APPLIED TO SELF DRAINING LINES. PIPE LINES SMALLER THAN 2" AND SUSCEPTIBLE TO FREEZING SHALL BE HEAT TRACED AND INSULATED. CONTRACT DRAWINGS TAKE PRECEDENCE OVER THESE GUIDE LINES.

4. FRP PRESSURE SWITCHES ARE SET AT STATIC PRESSURE +2.0 PSI.

5. AN "FRP SYSTEM SHUTDOWN" CONDITION CAUSES THE FOLLOWING ACTION IN THE CORRESPONDING FRP:
 - FEED VALVE CLOSES AND FLOW PROPORTIONALITY FACTOR REVERTS TO ZERO.
 - FLUIDIZATION VALVE CLOSES
 - FLUIDIZATION PUMP SHUTS DOWN
 - ALL CHEMICAL FEEDS TO CORRESPONDING FRP ARE SHUTDOWN
 - SIGNAL EQUALIZATION CONTROLS TO STOP EQUALIZED FEED FLOW
 - SYSTEM DIAL OUT TO OPERATOR (TELEPHONE/BEEPER)

6. AN "FRP FEED SHUTDOWN" CONDITION CAUSES THE FOLLOWING ACTION IN THE CORRESPONDING FRP:
 - FRP FEED SHUTDOWN
 - ELECTRON DONOR AND NUTRIENT FEED TO THE CORRESPONDING FRP ARE SHUTDOWN (PH SOLUTION FEED IS MAINTAINED)
 - FLOW IS BALANCED AMONG REMAINING OPERATING FRBS. AN "FRP FEED SHUTDOWN" CONDITION FOR MORE THAN 1 FRP CAUSES A "SYSTEM FEED SHUTDOWN"
 - SYSTEM DIAL OUT TO OPERATOR (TELEPHONE/BEEPER)

7. IN A "SYSTEM FEED SHUTDOWN" CONDITION THE FEED FLOW CONTROL VALVES IN THE 1ST STAGE FRBS ARE CLOSED. AND THE 1ST STAGE FEED PROPORTIONALITY FACTORS REVERT TO ZERO.

8. HIGH POINT (H.P.) VENTS AND LOW POINT (L.P.) DRAINS FOR PIPING WILL BE SHOWN AS REQUIRED ON PIPE ROUTING DRAWINGS.

INTERLOCK NOTES

111, 131, 407	LOW FRP FLUIDIZATION PRESSURE ALARM CAUSES A CORRESPONDING FRP SYSTEM SHUTDOWN. AT STARTUP, FRP FEED FLOW VALVE (FV-1011, 1012, ETC.) OPENS AFTER ASSOCIATED PRESSURE SWITCH DETECTS SUFFICIENT POSITIVE PRESSURE AT INLET TO CORRESPONDING FRP.	174	SOLENOID VALVE ENERGIZES TO OPEN IF EITHER ELECTRON DONOR BOOSTER PUMP IS ON.
112	IN AUTO MODE, FIRST STAGE FRB* FLOW CONTROL SET POINT IS CALCULATED BY THE SYSTEM AS FOLLOWS: 1. TOTAL SYSTEM FLOW MAY BE MANUALLY SET OR MAY BE CALCULATED BASED ON THE FEED EQUALIZATION TANK LEVEL. TOTAL SYSTEM FLOW = FT = FMIN + [(MAX - FMIN)(L - LL)] (LH - LL) WHERE FMIN = MINIMUM SYSTEM FLOW - 200 GPM DEFAULT FMAX = MAXIMUM SYSTEM FLOW - 1000 GPM DEFAULT L = ACTUAL EQUALIZATION TANK LEVEL (%) LL = EQUALIZATION TANK LOW CONTROL LEVEL SET POINT LH = EQUALIZATION TANK HIGH CONTROL LEVEL SET POINT 2. EACH 1ST STAGE FRB(1, 2, 3, 4 & A) IS ASSIGNED AN OPERATOR ADJUSTED FLOW PROPORTION FACTOR (0-100). THE FEED FLOW CONTROL SET POINT IS CALCULATED. $F_i = FT * (PPF_i / \sum PPF)$ WHERE F _i = FRP FEED FLOW CONTROL SET POINT FOR FRB _i , i = 1, 2, 3, 4, or A. $\sum PPF = \sum \text{FLOW PROPORTION FACTOR FOR FRB}_i$ ALL OPERATING 1ST STAGE FRBS. A FEED SHUTDOWN IN ANY FIRST STAGE FRB WILL CAUSE THE ASSOCIATED FLOW PROPORTION FACTOR TO REVERT TO 0.	175	LOSS OF FERRIC CHLORIDE FLOW ALARMS, CAUSES A SYSTEM DIAL OUT ALARM AND STARTS THE ALTERNATE PUMP.
113, 133, 405	HIGH OR LOW PH CAUSES A FRP FEED SHUTDOWN.	176	LOSS OF PEROXIDE FLOW (IF CALLED FOR) ALARMS, CAUSES A SYSTEM DIAL OUT ALARM AND STARTS THE ALTERNATE PUMP.
114, 134, 406	LOW FRP FLUIDIZATION FLOW ALARM CAUSES A CORRESPONDING FRP SYSTEM SHUTDOWN. AT STARTUP CORRESPONDING FLUIDIZATION PUMP LOW FLOW ALARM IS DELAYED BY AN APPROPRIATE TIME VALUE.	177	LOSS OF DEFOAM FLOW ALARMS, CAUSES A SYSTEM DIAL OUT ALARM AND STARTS THE ALTERNATE PUMP.
115, 135	HIGH ORP CAUSES A FEED SHUTDOWN IN THE CORRESPONDING FRP.	181	LOW INSTRUMENT AIR PRESSURE CAUSES A SYSTEM SHUTDOWN.
116, 136	LOW FEED FLOW CAUSES A FEED SHUTDOWN IN CORRESPONDING FRP.	191	CONDITIONING TANK MIXER IS DISABLED WHEN TANK LEVEL IS BELOW LOW LEVEL.
117	HIGH CONDUCTIVITY STOP P-103 IF RUNNING.	192	LOW LEVEL IN FILTRATE TANK DISABLES AUTOMATIC OPERATION OF FILTRATE RECYCLE PUMP.
121, 137	HIGH LEVEL IN SEPARATOR CAUSES A FEED SHUTDOWN IN CORRESPONDING FRBS. SEPARATOR MEDIA RETURN CYCLE INCLUDES OPERATOR ADJUSTABLE FREQUENCY AND BACKFLUSH, FORWARD FLUSH AND TRANSFER TIME DURATIONS.	193	HIGH HIGH LEVEL IN FILTRATE TANK DISABLES PRESS FEED PUMPS.
122, 130	SEPARATOR TANKS' LEVEL CONTROLLERS SET TANK OUTLET CONTROL VALVES' POSITIONS PROPORTIONATELY BASED ON ASSOCIATED TANK LEVEL.	194	HIGH CONDITIONING TANK LEVEL SHUTS DOWN SLUDGE PUMP P-1601.
123, 138	FRP PUMP SEAL WATER SOLENOIDS ARE INTERLOCKED WITH CORRESPONDING PUMP MOTOR STARTER.	195	DISABLE OXYGEN FLOW TO EFFLUENT WHEN BOOSTER PUMP SPEED IS BELOW AN OPERATOR ADJUSTABLE SET POINT.
124, 139, 404	AUTOMATIC FLOW CONTROL MAY BE USED TO CONTROL THE RELATIVE FLOWS TO FRBS 5, 6, 7 AND 8 IN AUTOMATIC FLOW CONTROL MODE. THE RELATIVE FLOWS TO THE FRBS WILL BE SET BY OPERATOR ADJUSTABLE FLOW PROPORTIONAL FACTORS (0-100).	196	LOW LEVEL IN UV EFFLUENT TANK CAUSES SHUTDOWN OF OPERATING EFFLUENT BOOSTER PUMP.
141	HIGH LEVEL IN AERATION TANK CAUSES A SYSTEM FEED SHUTDOWN.	197	HIGH LEVEL IN UV EFFLUENT TANK CAUSES A SYSTEM FEED SHUT DOWN.
142	HIGH H ₂ S ALARM OR AERATION BLOWER LOW DISCHARGE PRESSURE ALARM A FRP SYSTEM FEED SHUTDOWN.	408	HIGH HIGH PRESSURE IN THE CONTINUOUS SAND FILTER CAUSES A SYSTEM SHUTDOWN.
143	STOP FERRIC CHLORIDE FEED ON HIGH SULFIDE.	413	OXYGEN FEED TO THE SLUDGE STORAGE TANK IS ENABLED WHEN THE SLUDGE PUMP IS RUNNING.
144	DIAL OUT ALARM ON HIGH-HIGH SULFIDE.	414	A LOW FILTER BASIN LEVEL SIGNAL IS GENERATED WHEN LSL-1702 IS DE-ENERGIZED. A LOW FILTER BASIN LEVEL CAUSES FILTER AIR FLOW TO STOP.
151	LOW LEVEL IN DAF PRESSURE TANKS CAUSES CORRESPONDING PRESSURE TANK VENT SOLENOID VALVE TO OPEN FOR OPERATOR ADJUSTABLE DURATION.	415	LOW LEVEL IN THE FILTER REJECT SUMP CAUSES SHUTDOWN OF P-1701 A/B.
152	HIGH LEVEL IN DAF FLOAT COMPARTMENT CAUSES THE DAF FLOAT PUMP TO START TIMED SEQUENCE.	416	HIGH LEVEL IN THE FILTER REJECT SUMP CAUSES A SYSTEM FEED SHUTDOWN.
153	LOW FLOW IN DAF RECYCLE STOPS CORRESPONDING DAF PRESSURE PUMP.	419	LOW PHOSPHORIC ACID FLOW ALARM SIGNAL CAUSES AN FRP FEED SHUTDOWN, WHEN TREATING WATER FROM AP-5.
161	LOW LEVEL IN EFFLUENT TANK CAUSES SHUTDOWN OF OPERATING EFFLUENT PUMP.	421	A HIGH FILTER FEED PRESSURE IS AN INDICATION THAT THE FILTER IS DIRTY. WHEN PS-1702 IS ACTIVATED, THE FILTER AIR BURST LINES WILL OPEN TO INCREASE THE FILTER CLEANING OPERATION.
162	HIGH LEVEL IN EFFLUENT TANK CAUSES A SYSTEM FEED SHUTDOWN.	422	A LOW-LOW LEVEL IN THE SLUDGE STORAGE TANK CAUSES SHUTDOWN OF THE SLUDGE PUMP P-1601.
163	HIGH-HIGH THICKENER SCRAPER TORQUE CAUSES THE SCRAPER DRIVE TO SHUTDOWN.	423	A HIGH FLOW ALARM IS CAUSED WHEN THE OUTPUT TO THE PH FEED PUMP P-71A IS GREATER THAN THE OPERATOR ADJUSTABLE HIGH FLOW SET POINT FOR A LONGER DURATION THEN THE OPERATOR ADJUSTABLE TIME SET POINT.
164	EFFLUENT BOOSTER PUMPS START, STOP AND VARY SPEED BASED ON UV EFFLUENT TANK LEVEL LC-621.	424	A LOW LEVEL IN THE SLUDGE STORAGE TANK CLOSSES THE OXYGEN FEED VALVE, FV-1602.
171	LOW NUTRIENT FLOW ALARM SIGNAL CAUSES A FEED SHUTDOWN IN THE CORRESPONDING FRP.	425	A HIGH LEVEL IN THE SLUDGE STORAGE TANK CAUSES THE THICKNER UNDERFLOW PUMP SHUTDOWN.
172	CONDITIONING TANK SEQUENCE CONTROLLER, KC-751 CONTROLS FERRIC CHLORIDE FEED VALVE OPEN DURATION TIME, AND INITIATES LIME FEED SEQUENCE.	426	A FLOW DISCORDANCE ALARM IS CAUSED BY A FLOW OR NON-FLOW CONDITION THAT IS INCORRECT FOR THE APPLICABLE OPERATING MODE.
173	TANK T-703 CONTAMINANT LEAK DETECTION CAUSES ELECTRON DONOR BOOSTER PUMP TO SHUTDOWN AND CAUSES A SYSTEM FEED SHUTDOWN.		


NOTES:

1. INTERLOCKS SHOWN IN GREY ARE NO LONGER USED BUT ARE PHYSICALLY IN PLACE.
2. A REVISION CLOUD INDICATES NEW/NON-EXISTENT EQUIPMENT.
3. PID SHEETS 10A, 10B & 10C HAVE ADDITIONAL INTERLOCK NOTES LISTED ON THEM.


REV	DATE	DESCRIPTION OF REVISION	REVISION
1	11-16-13	RECORD DRAWING - REVISED FOR 2013 CURRENT OPERATIONS & RECORDED O&M MANUAL	DN
2	9-26-06	RECORD DRAWING	DN
3	02-28-06	RECORDED PER CUSTOMER COMMENTS	EX
4	12-27-06	ISSUED FOR CONSTRUCTION	SM
5			ST
6			AB
7			AB

THIS IS A COMPUTER GENERATED DRAWING AND ONLY EDITS CONSISTENT WITH ENVIROGEN'S ORIGINAL CAD FORMAT SHALL BE CONSIDERED VALID COPIES.

DESIGNED BY/DATE	DN	11/14/13
CHECKED BY/DATE	DN	11/14/13
DRAWN BY/DATE	DN	11/14/13
SCALE	AS SHOWN	
SHEET #	1	OF 1
PROJECT #	1373-PID-N1	
PROJECT NAME	FLUIDIZED BED PERCHLORATE TREATMENT SYSTEM	
CLIENT	NEPT	
LOCATION	HENDERSON, NV	
DATE	11/14/13	

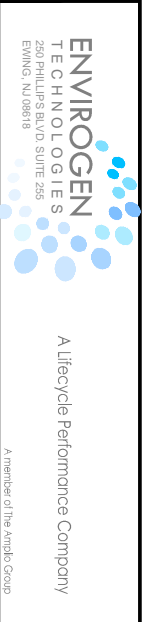

ALL INFORMATION CONTAINED ON THIS DOCUMENT IS THE PROPERTY OF ENVIROGEN TECHNOLOGIES, INC. (ENVIROGEN) AND/OR ITS AFFILIATES. THE DESIGN CONCEPTS AND INFORMATION CONTAINED HEREIN ARE PROPRIETARY TO ENVIROGEN AND ARE SUBMITTED IN CONFIDENCE. THEY ARE NOT TO BE REPRODUCED OR USED IN ANY MANNER WITHOUT THE EXPRESS WRITTEN CONSENT OF ENVIROGEN. ENVIROGEN ASSUMES NO RESPONSIBILITY OR LIABILITY FOR THE USE OF THIS DOCUMENT OR THE DESIGN CONCEPTS CONTAINED HEREIN. THE USER OF THIS DOCUMENT SHALL BE RESPONSIBLE FOR OBTAINING ALL NECESSARY PERMITS AND REGULATIONS OF AGENCIES AND ITS CUSTOMER AND OBTAINING ACCEPTANCE OF THE DELIVERY OF THIS DOCUMENT. CONSIDERS AGREEMENT TO THESE TERMS AND CONDITIONS.

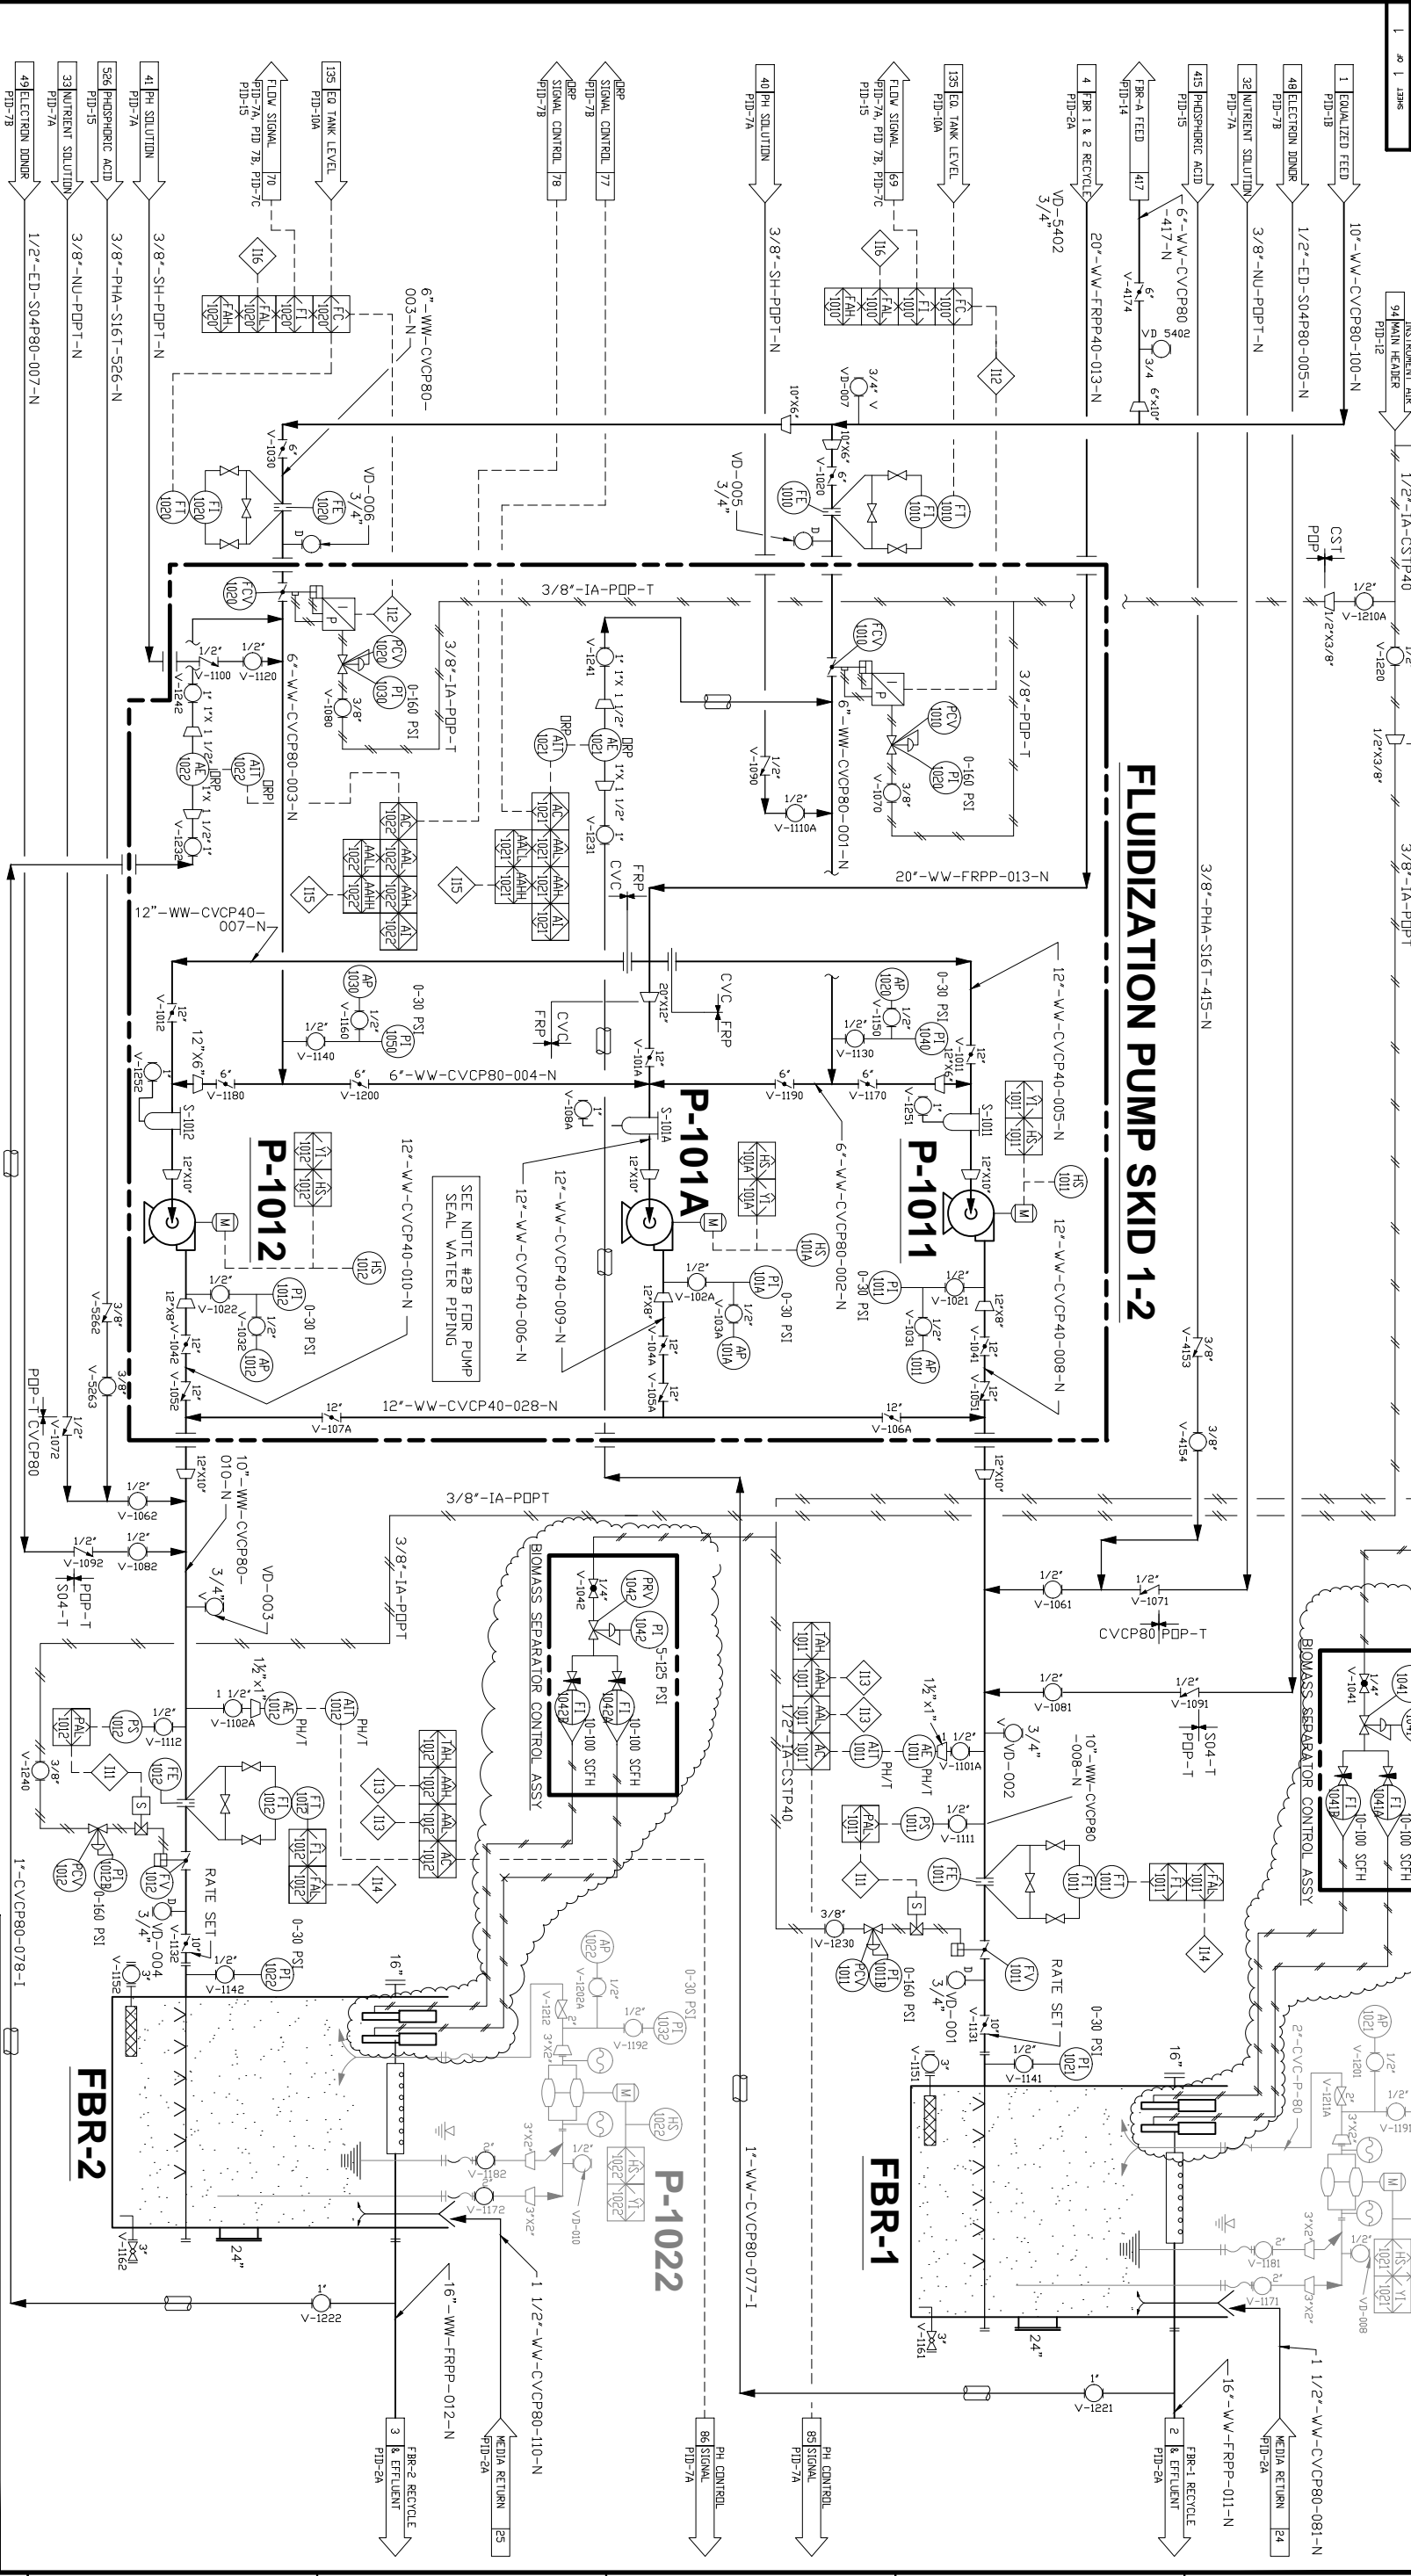

FBR-1

1ST STAGE FLUIDIZED BED REACTORS

SIZE: 14' DIA. X 30' STR.

MAT'L: S.FRP

CAPACITY: 33,000 GAL.

MEDIA TYPE: SAND

MEDIA VOLUME: 2,000 CU. FT.

TYPE: CENTRIFUGAL

CAPACITY: 40 GPM @ 40' TDH

MOTOR: 30 HP, 460 VAC, 3PH

MODEL: FEIN VALVE 3

DOUBLE DISC.

P-1021

BED HEIGHT CONTROL PUMPS

TYPE: ELECTRIC DIAPHRAGM

CAPACITY: 40 GPM @ 40' TDH

MOTOR: 2 HP, 460 VAC, 3 PH

MODEL: FEIN VALVE 3

DOUBLE DISC.

P-1011

FLUIDIZATION PUMPS

TYPE: ELECTRIC DIAPHRAGM

CAPACITY: 40 GPM @ 40' TDH

MOTOR: 2 HP, 460 VAC, 3 PH

MODEL: FEIN VALVE 3

DOUBLE DISC.

P-1012

FLUIDIZATION PUMPS

TYPE: ELECTRIC DIAPHRAGM

CAPACITY: 40 GPM @ 40' TDH

MOTOR: 2 HP, 460 VAC, 3 PH

MODEL: FEIN VALVE 3

DOUBLE DISC.

P-1022

BED HEIGHT CONTROL PUMPS

TYPE: ELECTRIC DIAPHRAGM

CAPACITY: 40 GPM @ 40' TDH

MOTOR: 2 HP, 460 VAC, 3 PH

MODEL: FEIN VALVE 3

DOUBLE DISC.

FBR-2

2ND STAGE FLUIDIZED BED REACTORS

SIZE: 14' DIA. X 30' STR.

MAT'L: S.FRP

CAPACITY: 33,000 GAL.

MEDIA TYPE: SAND

MEDIA VOLUME: 2,000 CU. FT.

TYPE: CENTRIFUGAL

CAPACITY: 40 GPM @ 40' TDH

MOTOR: 30 HP, 460 VAC, 3PH

MODEL: FEIN VALVE 3

DOUBLE DISC.

P-1021

BED HEIGHT CONTROL PUMPS

TYPE: ELECTRIC DIAPHRAGM

CAPACITY: 40 GPM @ 40' TDH

MOTOR: 2 HP, 460 VAC, 3 PH

MODEL: FEIN VALVE 3

DOUBLE DISC.

U.S. PATENTS 5750028, 5788842, 6706521 AND PATENTS PENDING.

ENVIROGEN TECHNOLOGIES
250 PHILLIPS BLVD SUITE 255
EVINGTON, NJ 08018

A Lifecycle Performance Company

ALL INFORMATION CONTAINED ON THIS DOCUMENT IS THE PROPERTY OF ENVIROGEN TECHNOLOGIES, INC. (ENVIROGEN) AND/OR ITS AFFILIATES. THE DESIGN CONCEPTS AND INFORMATION CONTAINED HEREIN ARE PROPERTY OF ENVIROGEN AND ARE SUBMITTED IN CONFIDENCE. THEY ARE NOT TRANSFERABLE AND MUST BE USED ONLY FOR THE PROJECT AND/OR SYSTEM FOR WHICH THEY WERE DEVELOPED. ANY REPRODUCTION, DISTRIBUTION, OR REPRODUCTION, LOANED OR USED IN ANY OTHER MANNER WITHOUT THE EXPRESS WRITTEN CONSENT OF ENVIROGEN IS STRICTLY PROHIBITED. ENVIROGEN ASSUMES NO RESPONSIBILITY OR LIABILITY FOR THE USE OF THIS DOCUMENT OR THE DESIGN CONCEPTS CONTAINED HEREIN. THE USER OF THIS DOCUMENT SHALL BE RESPONSIBLE FOR OBTAINING ALL NECESSARY PERMITS, APPROVALS, AND REGULATIONS OF AGENCIES AND OTHERS. ENVIROGEN AND ITS CUSTOMER SHALL BE SOLELY RESPONSIBLE FOR THE DESIGN OF THIS PROJECT. ALL PATENT AND OTHER RIGHTS ARE RESERVED. ACCEPTANCE OF THE DELIVERY OF THIS DOCUMENT CONSTITUTES AGREEMENT TO THESE TERMS AND CONDITIONS.

REVISIONS

NO.	DATE	DESCRIPTION OF REVISION	BY	CHK
1	11-15-13	RECORD DRAWING - REVISED FOR 2013 CURRENT OPERATIONS & REVISED DATA MANUAL	DM	DM
2	9-26-06	RECORD DRAWING	DM	DM
3	4-26-06	ISSUED FOR CONSTRUCTION	DM	DM
4	12-27-05	REVISION FOR CONSTRUCTION	DM	DM

THIS IS A COMPUTER GENERATED DRAWING AND ONLY V EDITS CONSISTENT WITH ENVIROGEN'S ORIGINAL CAD FORMAT SHALL BE CONSIDERED VALID COPIES.


PIPING & INSTRUMENTATION DIAGRAM
FLUIDIZED BED PERCHLORATE TREATMENT SYSTEM

HENDERSON, NV

PROJECT NO: 1373-PID01A

SHEET 1 OF 26

REVISION: 3

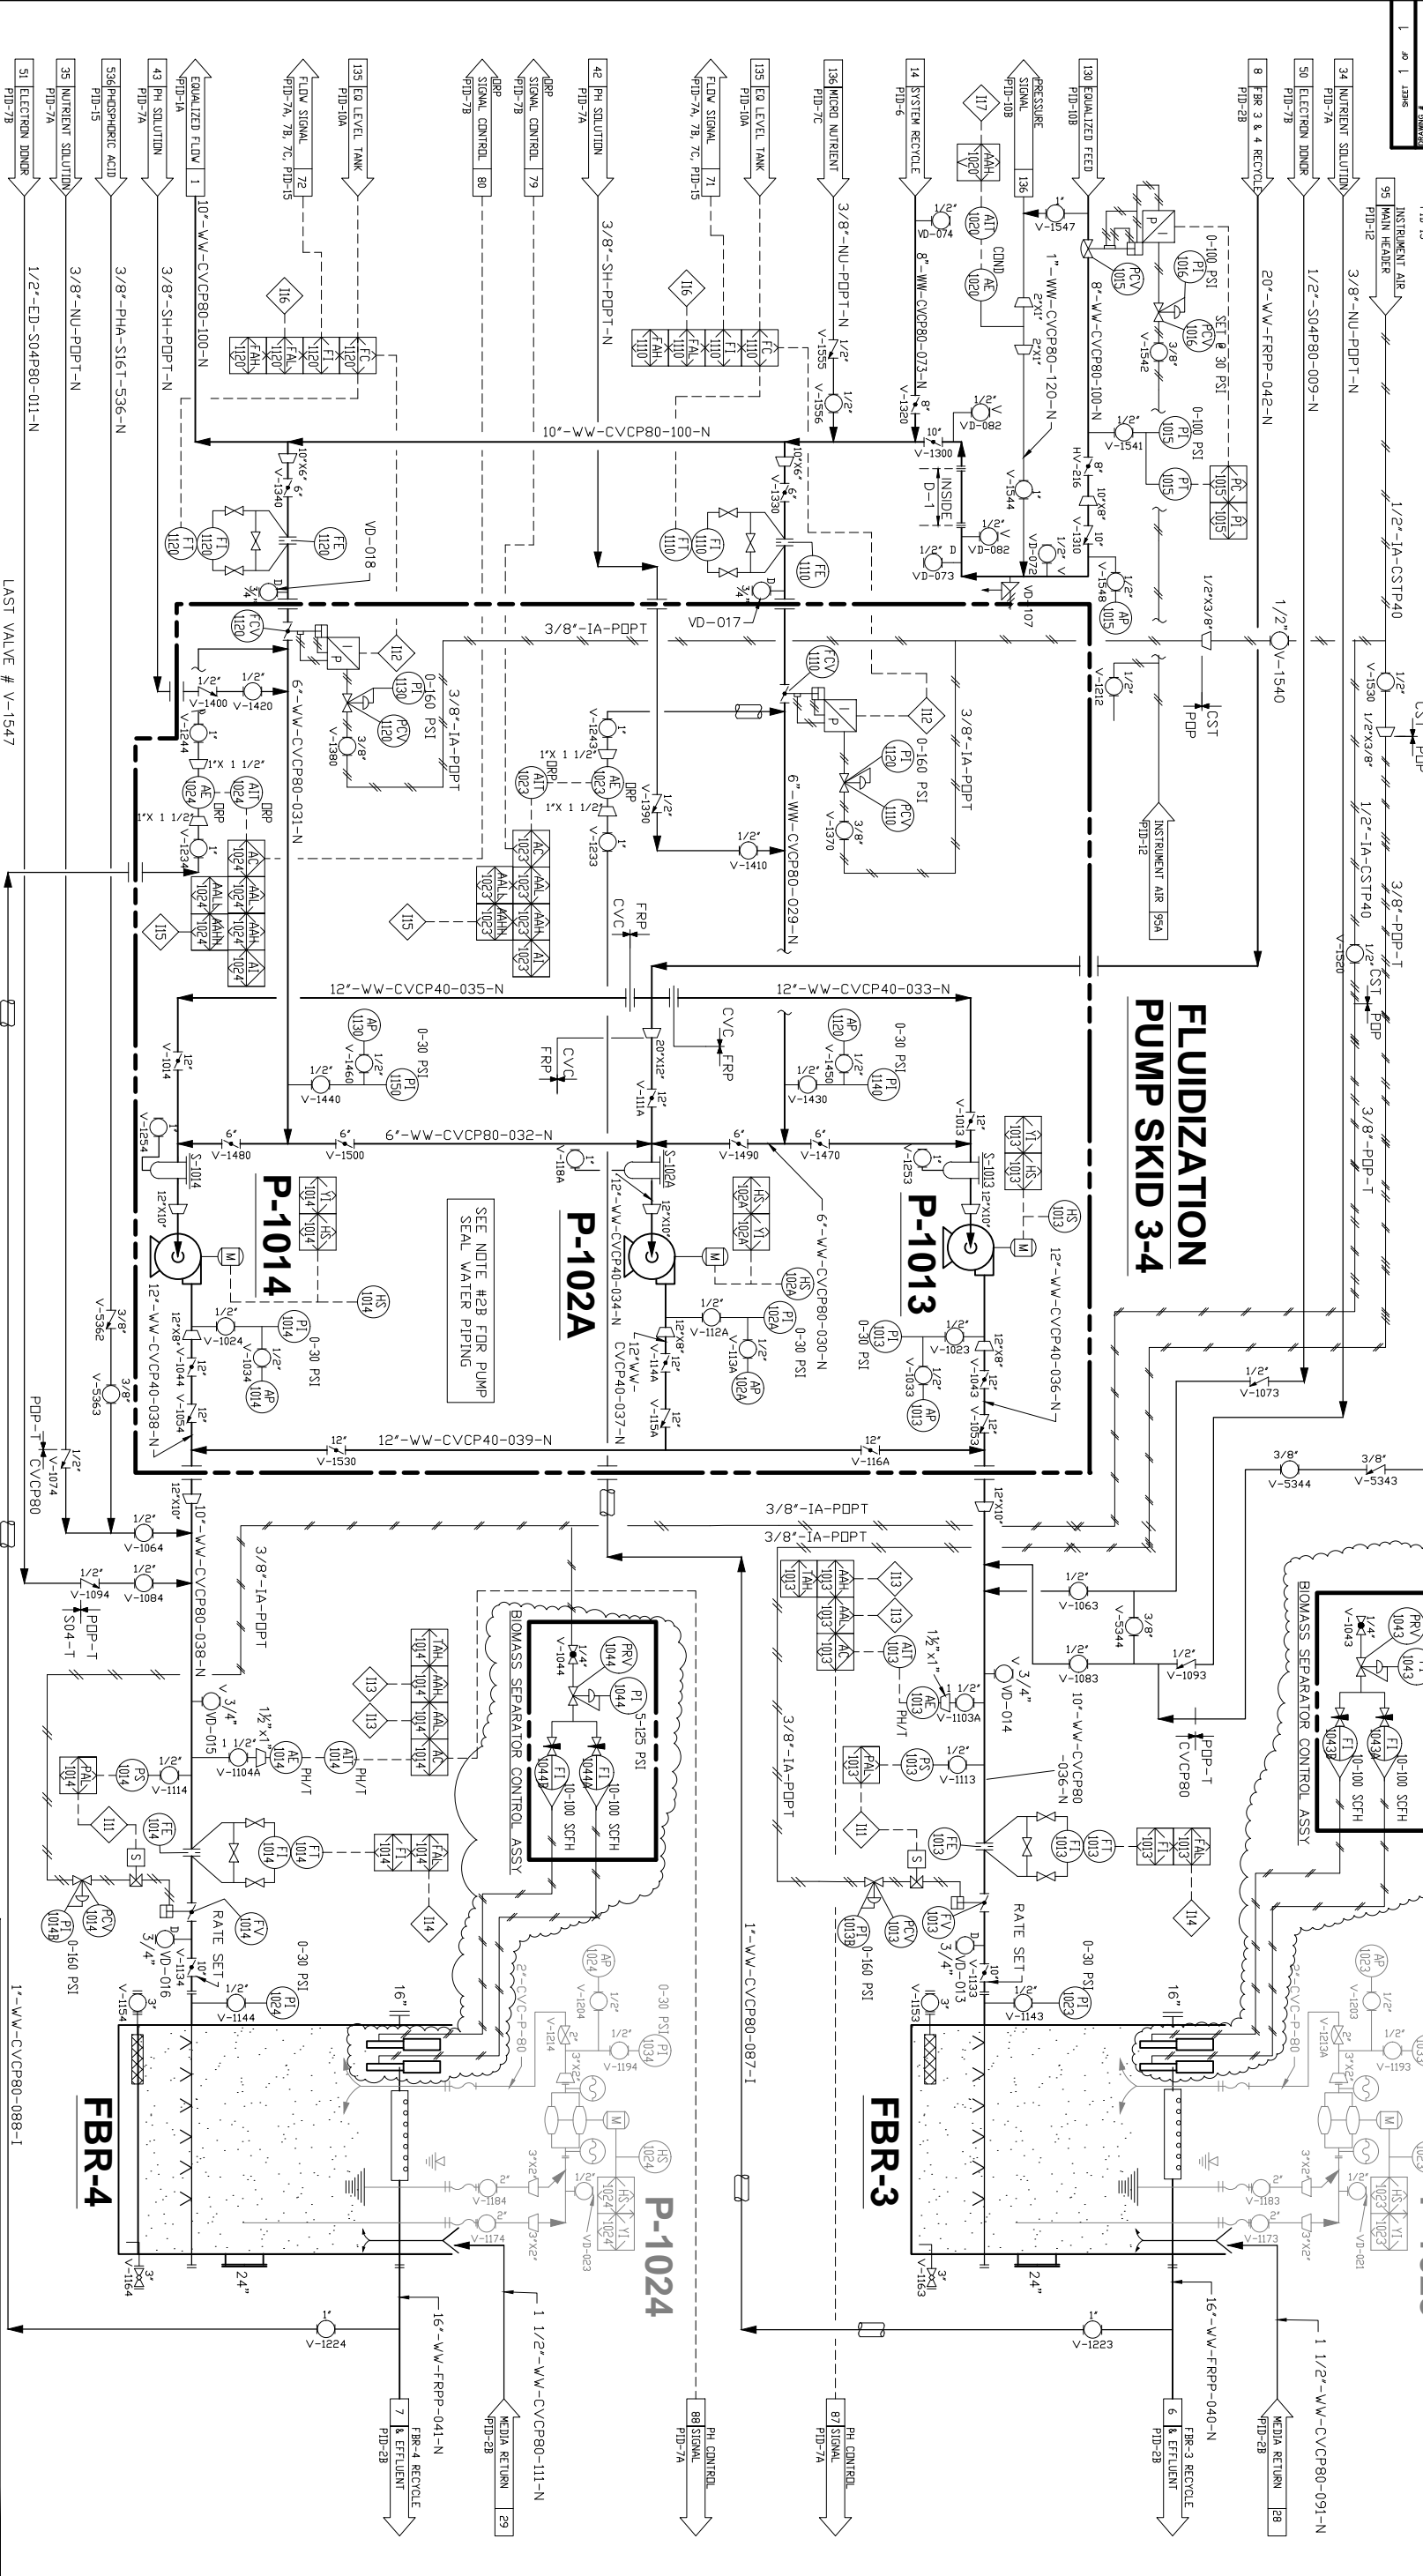


REACTORS FBR-3 & 4 FIRST STAGE FLUIDIZED BED REACTORS SIZE: 14'-DIA. X 30'-STR. MAT'L: S.FRP CAPACITY: 33,000 GAL. MEDIA TYPE: SAND MEDIA VOLUME: 2,000 CU. FT.		FLUIDIZATION PUMPS P-1013, P-1024, P-1014 FIRST STAGE FBR FLUIDIZATION PUMPS TYPE: CENTRIFUGAL CAPACITY: 2,000 GPM @ 40' TDH WETTED MAT'L: FRP MOTOR: 30 HP, 460 VAC, 3 PH MODEL: 3 DOUBLE DISC	
CONTROL SYSTEMS P-1013, P-1024, P-1014 FIRST STAGE FBR CONTROL SYSTEMS TYPE: ELECTRIC CAPACITY: 40 GPM @ 40' TDH WETTED MAT'L: PVC, NEPRENE MOTOR: 2 HP, 460 VAC, 3 PH MODEL: PENN. VALLEY 3 DOUBLE DISC		BIOMASS SEPARATOR CONTROL ASSY TYPE: ELECTRIC CAPACITY: 40 GPM @ 40' TDH WETTED MAT'L: PVC, NEPRENE MOTOR: 2 HP, 460 VAC, 3 PH MODEL: PENN. VALLEY 3 DOUBLE DISC	

ALL INFORMATION CONTAINED ON THIS DOCUMENT IS THE PROPERTY OF ENVIROGEN TECHNOLOGIES, INC. (ENVIROGEN) AND/OR ITS AFFILIATES. THE DESIGN CONCEPTS AND INFORMATION CONTAINED HEREIN ARE PROPERTY OF ENVIROGEN AND ARE SUBMITTED IN CONFIDENCE. THEY ARE NOT TO BE REPRODUCED OR USED IN ANY MANNER WITHOUT THE EXPRESS WRITTEN CONSENT OF ENVIROGEN. ENVIROGEN ASSUMES NO RESPONSIBILITY OR LIABILITY FOR THE USE OF THIS DOCUMENT OR THE DESIGN CONCEPTS OR INFORMATION CONTAINED HEREIN. THE USER OF THIS DOCUMENT SHALL BE RESPONSIBLE FOR OBTAINING ALL NECESSARY PERMITS AND APPROVALS FROM THE APPROPRIATE AGENCIES AND AUTHORITY. THE USER SHALL BE RESPONSIBLE FOR OBTAINING ALL NECESSARY PERMITS AND APPROVALS FROM THE APPROPRIATE AGENCIES AND AUTHORITY. THE USER SHALL BE RESPONSIBLE FOR OBTAINING ALL NECESSARY PERMITS AND APPROVALS FROM THE APPROPRIATE AGENCIES AND AUTHORITY.


REV.	DATE	DESCRIPTION OF REVISION	BY	CHK	APP
1	11-15-13	RECORD DRAWING - REVISED FOR 2013 CONCRETE OPERATIONS & REVISED CABLE MANUFACTURE	DM	DM	DM
2	9-28-16	RECORD DRAWING	DM	DM	DM
3	12-27-16	ISSUED FOR CONSTRUCTION	DM	DM	DM

THIS IS A COMPUTER GENERATED DRAWING AND ONLY EDITS CONSISTENT WITH ENVIROGEN'S ORIGINAL CAD FORMAT SHALL BE CONSIDERED VALID COPIES.


PIPING & INSTRUMENTATION DIAGRAM FLUIDIZED BED PERCHLORATE TREATMENT SYSTEM	HENDERSON, NV NERT
SHEET 2 OF 26 1373-PID01B	REVISION: 2

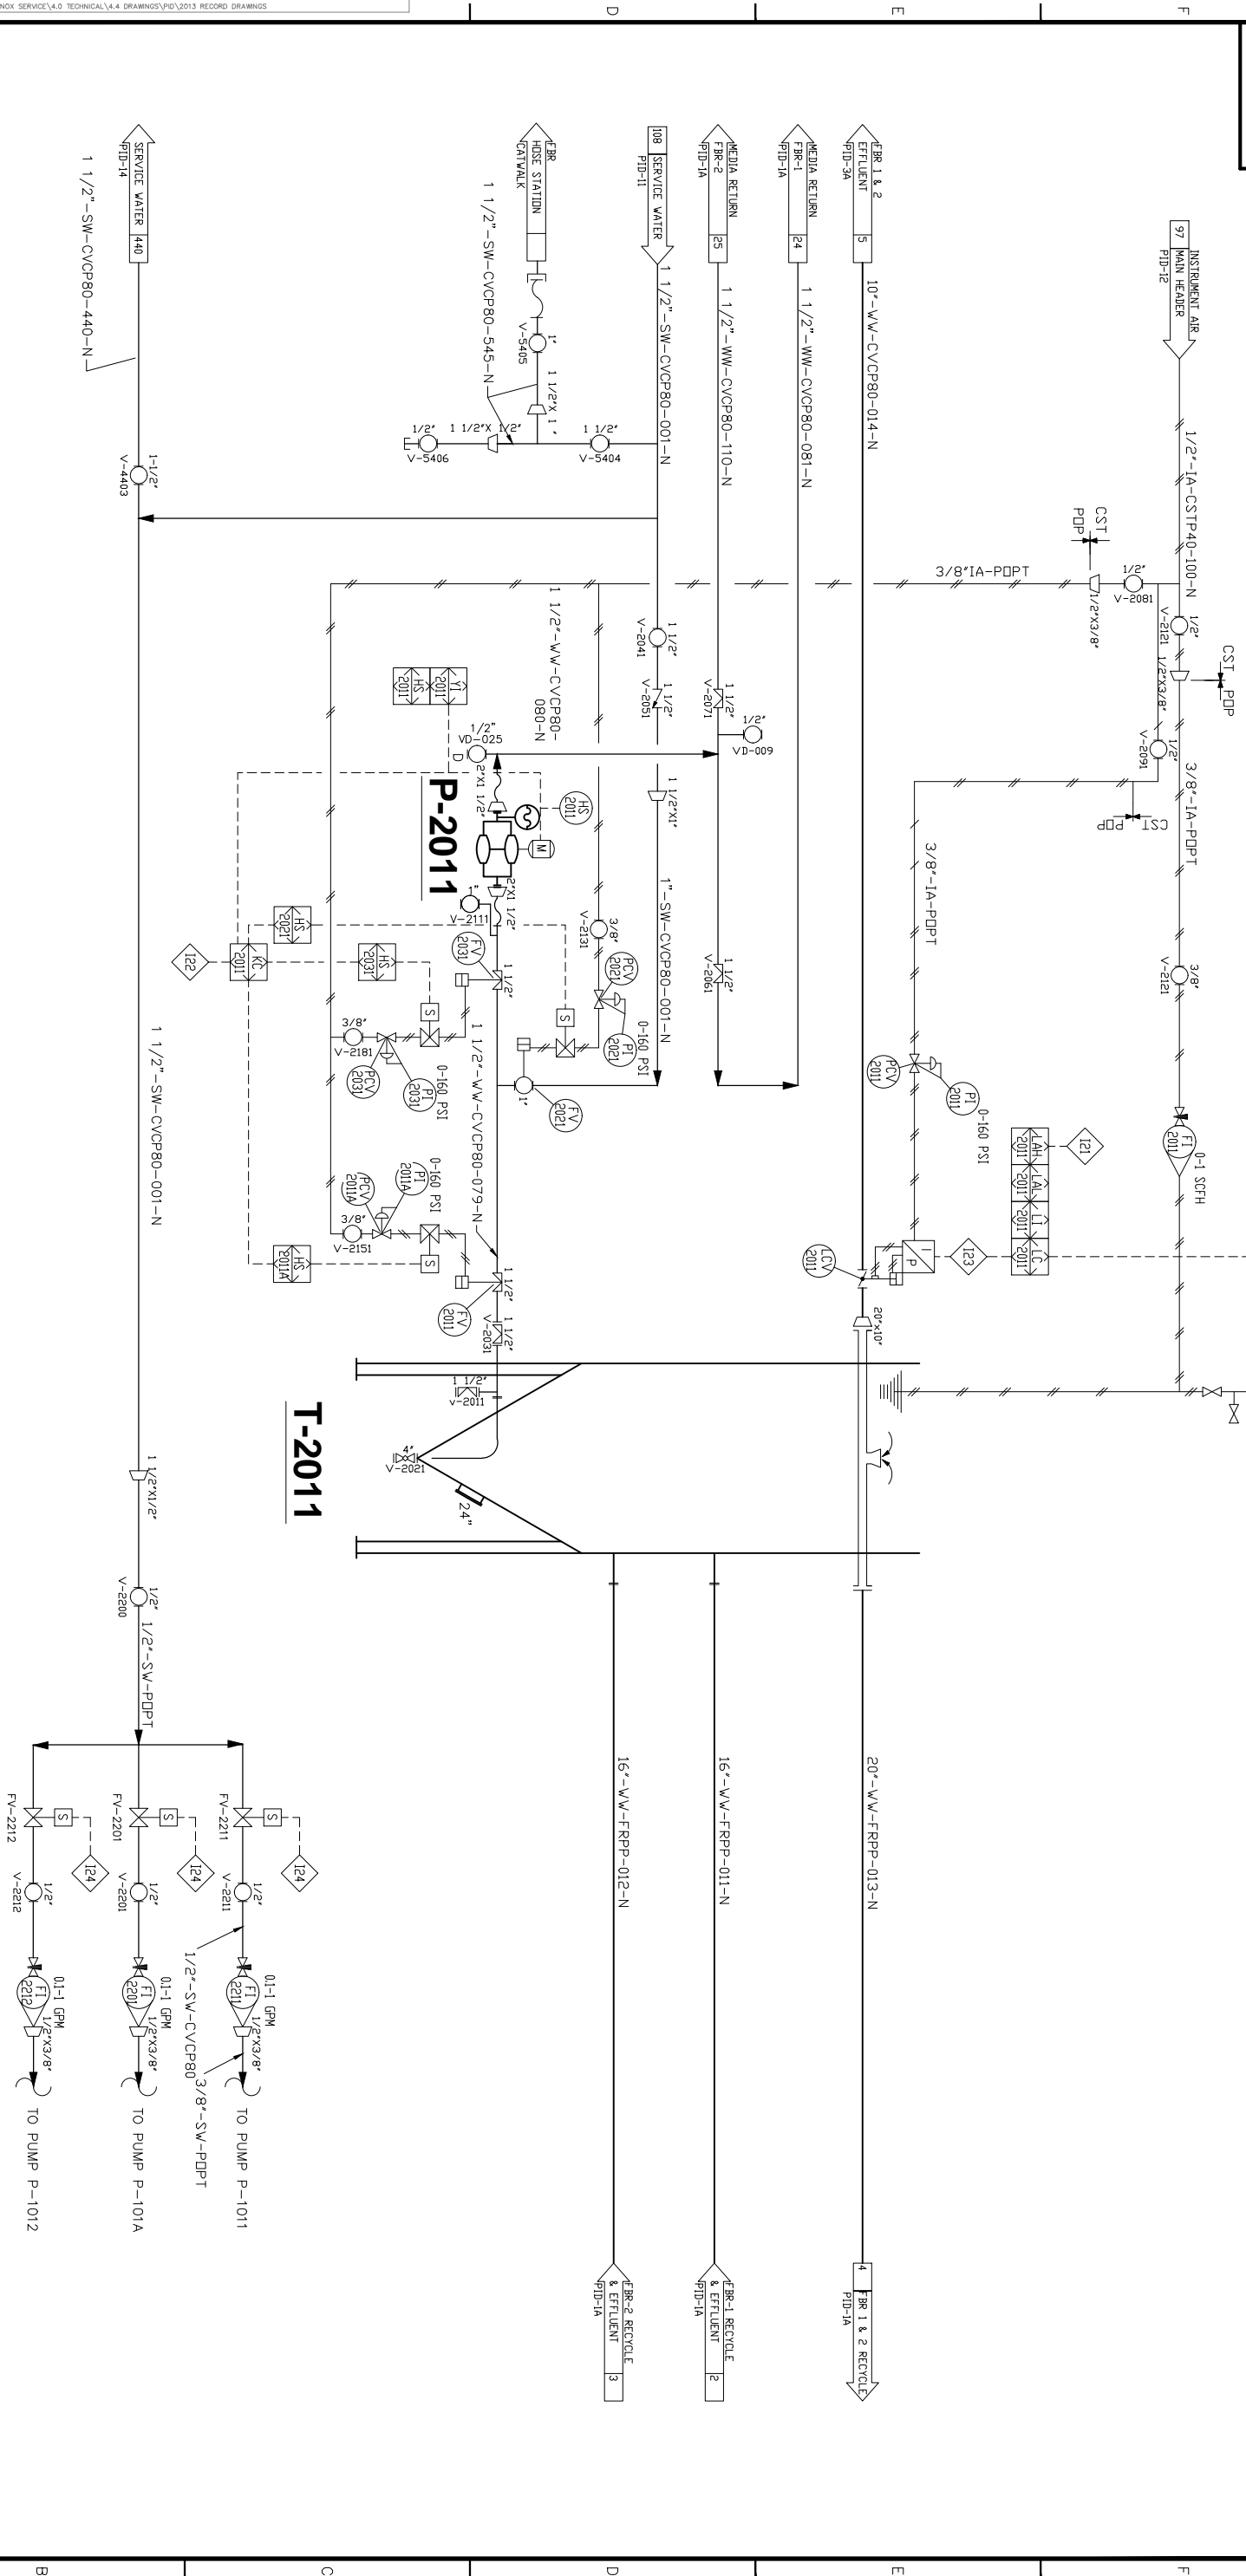

T-2011 FIRST STAGE SEPARATOR TANK	P-2011 MEDIA RETURN PUMP
SIZE: 34" DIA X 30' HI. MATERIAL: 304 SS CAPACITY: 21,500 GAL	TYPE: ELECTRIC DIAPHRAGM CAPACITY: 30 GPM @ 40 TDH MATERIAL: METAL MODEL: PENN VALLEY 2" DOUBLE DISC

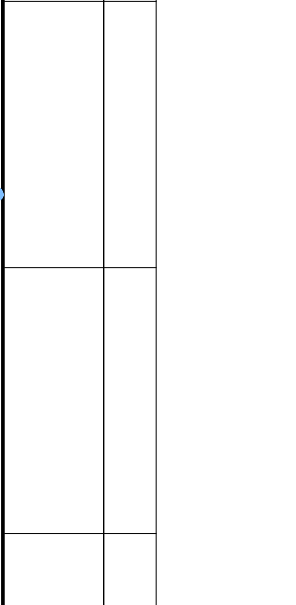

ALL INFORMATION CONTAINED ON THIS DOCUMENT IS THE PROPERTY OF ENVIROGEN TECHNOLOGIES, INC. (ENVIROGEN) AND/OR ITS AFFILIATES. THE DESIGN CONCEPTS AND INFORMATION CONTAINED HEREIN ARE PROPERTY OF ENVIROGEN AND ARE SUBMITTED IN CONFIDENCE. THEY ARE NOT TO BE REPRODUCED OR TRANSMITTED IN ANY FORM OR BY ANY MEANS, ELECTRONIC OR MECHANICAL, INCLUDING PHOTOCOPYING, RECORDING, OR BY ANY INFORMATION STORAGE AND RETRIEVAL SYSTEM, WITHOUT THE EXPRESS WRITTEN CONSENT OF ENVIROGEN. ENVIROGEN ASSUMES NO RESPONSIBILITY OR LIABILITY FOR THE USE OF THIS DOCUMENT OR THE DESIGN CONCEPTS CONTAINED HEREIN IN ANY MANNER. THE USER OF THIS DOCUMENT SHALL BE RESPONSIBLE FOR OBTAINING ALL NECESSARY PERMITS AND APPROVALS FROM THE APPROPRIATE AGENCIES. ENVIROGEN'S ORIGINAL INTENTED USE OF THIS DOCUMENT IS IN NO EVENT SHALL THIS DOCUMENT OR THE DESIGN CONCEPTS CONTAINED HEREIN BE REPRODUCED OR TRANSMITTED IN ANY FORM OR BY ANY MEANS, ELECTRONIC OR MECHANICAL, INCLUDING PHOTOCOPYING, RECORDING, OR BY ANY INFORMATION STORAGE AND RETRIEVAL SYSTEM, WITHOUT THE EXPRESS WRITTEN CONSENT OF ENVIROGEN. ENVIROGEN ASSUMES NO RESPONSIBILITY OR LIABILITY FOR THE USE OF THIS DOCUMENT OR THE DESIGN CONCEPTS CONTAINED HEREIN IN ANY MANNER. THE USER OF THIS DOCUMENT SHALL BE RESPONSIBLE FOR OBTAINING ALL NECESSARY PERMITS AND APPROVALS FROM THE APPROPRIATE AGENCIES. ENVIROGEN'S ORIGINAL INTENTED USE OF THIS DOCUMENT IS IN NO EVENT SHALL THIS DOCUMENT OR THE DESIGN CONCEPTS CONTAINED HEREIN BE REPRODUCED OR TRANSMITTED IN ANY FORM OR BY ANY MEANS, ELECTRONIC OR MECHANICAL, INCLUDING PHOTOCOPYING, RECORDING, OR BY ANY INFORMATION STORAGE AND RETRIEVAL SYSTEM, WITHOUT THE EXPRESS WRITTEN CONSENT OF ENVIROGEN.

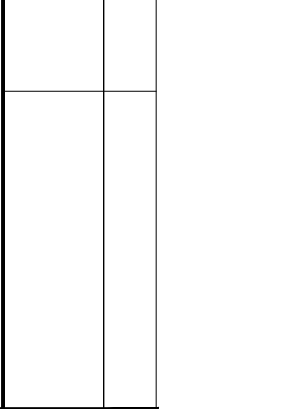

11-15-13	RECORD DRAWING - REVISION FOR 2013 CURRENT OPERATIONS & REVISION DAM WALK	DL	DN
9-28-06	RECORD DRAWING	DM	RE
4-28-06	ISSUED FOR CONSTRUCTION	DF	RE
12-27-05	ISSUED FOR CONSTRUCTION	DM	RE


DATE	DESCRIPTION OF REVISION	REVISION BY	REVISION DATE

THIS IS A COMPUTER GENERATED DRAWING AND ONLY EDITS CONSISTENT WITH ENVIROGEN'S ORIGINAL CAD FORMAT SHALL BE CONSIDERED VALID COPIES.


PIPING & INSTRUMENTATION DIAGRAM
 FLUIDIZED BED PERCHLORATE
 TREATMENT SYSTEM

HENDERSON, NV
 NERT

SHEET 3 OF 26
 1373-PID02A

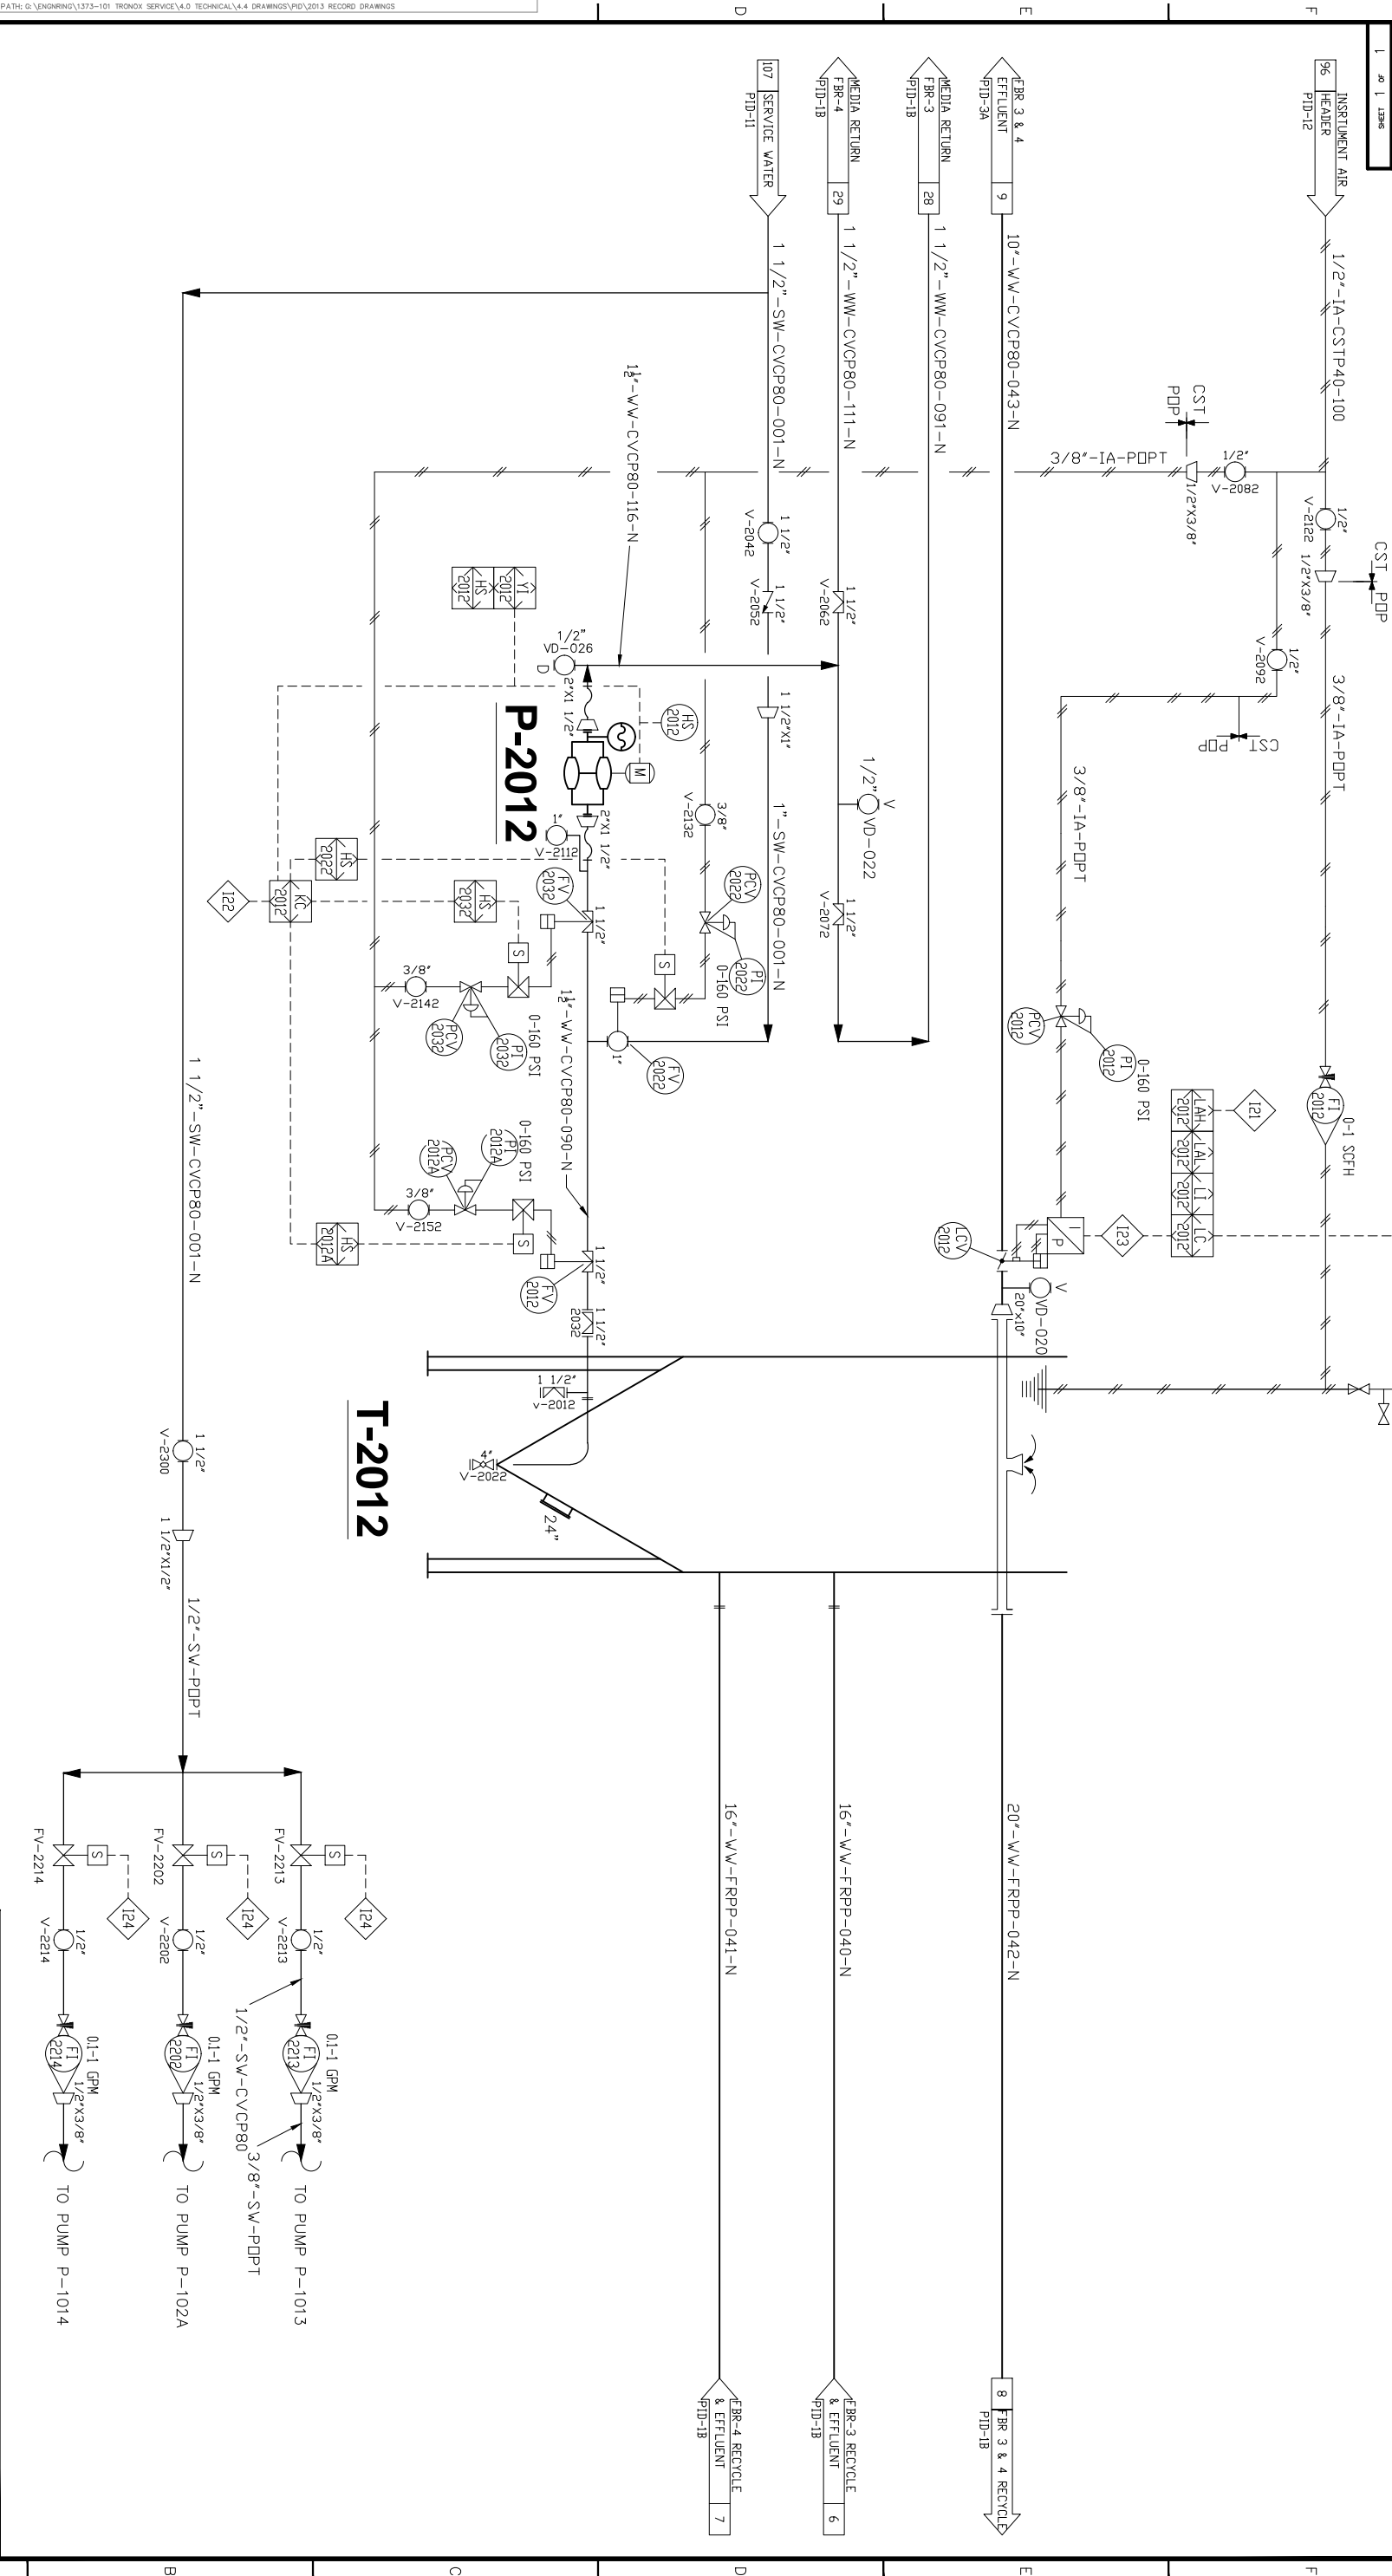

1-2012 FIRST STAGE SEPARATOR TANK	P-2012 MEDIA RETURN PUMP
SIZE: 14' DIA. X 30' HT. MATERIAL: FRP	TYPE: ELECTRIC DRIVEN CAPACITY: 30 GPM @ 40' TDH MATERIAL: PVC, NEOPRENE MOTOR: 10 HP 460 VAC 3 PH MODEL: PENN VALLEY 2" DOUBLE DISC

 


ALL INFORMATION CONTAINED ON THIS DOCUMENT IS THE PROPERTY OF ENVIROGEN TECHNOLOGIES, INC. ("ENVIROGEN") AND/OR ITS AFFILIATES. THE DESIGN CONCEPTS AND INFORMATION CONTAINED HEREIN ARE PROPERTY OF ENVIROGEN AND ARE SUBMITTED IN CONFIDENCE. THEY ARE NOT TO BE REPRODUCED OR USED IN ANY MANNER WITHOUT THE EXPRESS WRITTEN CONSENT OF ENVIROGEN. ENVIROGEN ASSUMES NO RESPONSIBILITY OR LIABILITY FOR THE USE OF THIS DOCUMENT OR THE DESIGN CONCEPTS CONTAINED HEREIN FOR ANY PURPOSES OTHER THAN THAT SPECIFICALLY INTENDED BY ENVIROGEN. ENVIROGEN'S ORIGINAL INTENTED USE OF THIS DOCUMENT OR THE DESIGN CONCEPTS CONTAINED HEREIN IS LIMITED TO THE PROJECT AND OBLIGATIONS OF ENVIROGEN AND OTHER RIGHTS ARE RESERVED. ACCEPTANCE OF THE DELIVERY OF THIS DOCUMENT CONSTITUTES AGREEMENT TO THESE TERMS AND CONDITIONS.

11-14-13	RECORD DRAWING - REVISED FOR 2013 CURRENT OPERATIONS & REVISED O&M MANUAL	DL	DL	N/A
9-28-06	RECORD DRAWING	DL	DL	SF / 01-13-03
12-27-06	ISSUED FOR CONSTRUCTION (NO CHANGE TO EXISTING)	DL	DL	LD / 01-13-03
DATE	DESCRIPTION OF REVISION	REQUESTED BY	APPROVED BY	DATE

THIS IS A COMPUTER GENERATED DRAWING AND ONLY EDITS CONSISTENT WITH ENVIROGEN'S ORIGINAL CAD FORMAT SHALL BE CONSIDERED VALID COPIES.	
DESIGNED BY/DATE	N/A
SCALE	SF / 01-13-03
SHEET #	4 OF 26
PROJECT #	1373-PID02B
REVISION	2

PIPING & INSTRUMENTATION DIAGRAM
FLUIDIZED BED PERCHLORATE
TREATMENT SYSTEM

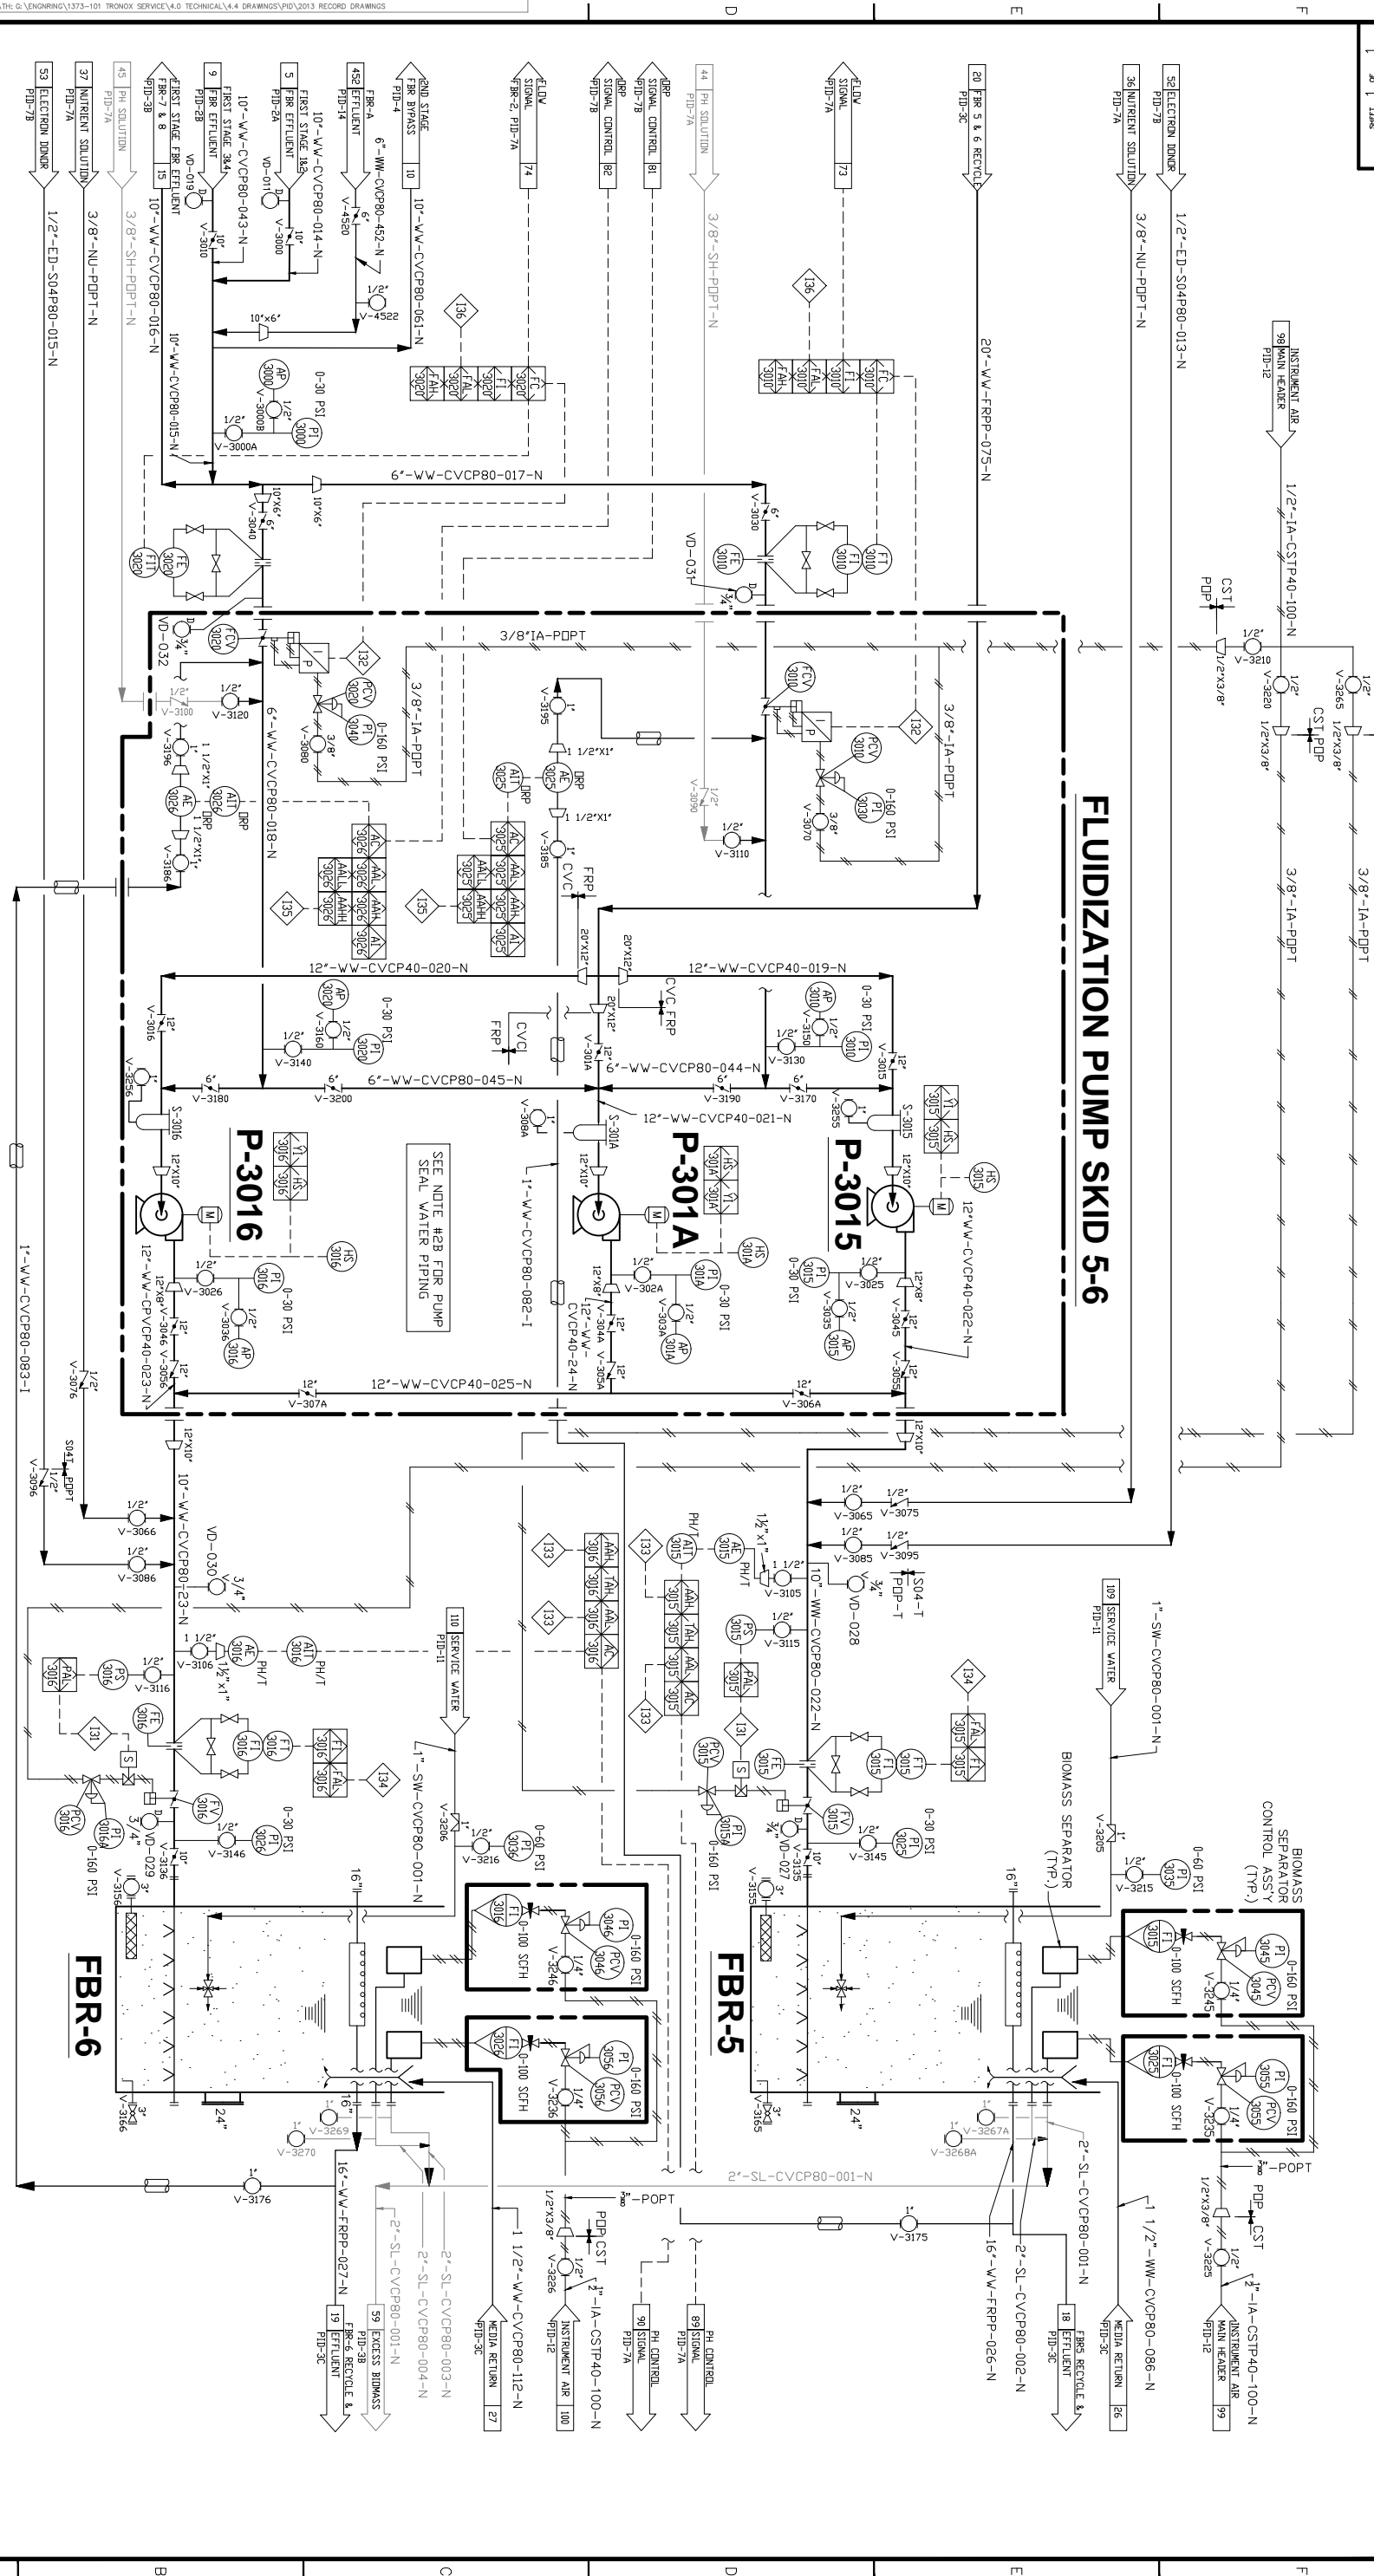

FBR-5, 6
SECOND STAGE FLUIDIZED BED REACTORS

SIZE: 1400A X 6000	TYPE: CENTRIFUGAL
CAPACITY: 2000 GPM	WETTED MAT'L: FRP
MEDIA TYPE: CARBON	MOTOR: 30 HP, 460 VAC, 3 PH
MEDIA VOLUME: 1730 CU. FT.	MODEL:

P-3015, 3016
SECOND STAGE FLUIDIZATION PUMPS

TYPE: CENTRIFUGAL	CAPACITY: 2000 GPM @ 40' TDH
MEDIA TYPE: CARBON	MOTOR: 30 HP, 460 VAC, 3 PH
MODEL:	

SEE NOTE #2B FOR PUMP SEAL WATER PIPING

REVISIONS

NO.	DATE	DESCRIPTION OF REVISION	BY	CHK	APP
1	11-15-13	RECORD DRAWING - REVISION FOR 2013 CURRENT OPERATIONS & REVISION DRAWING	DM	RE	DM
2	9-26-06	ISSUED FOR CONSTRUCTION	DM	RE	DM
3	4-26-06	ISSUED FOR CONSTRUCTION	DM	RE	DM
4	12-27-05	ISSUED FOR CONSTRUCTION	DM	RE	DM

THIS IS A COMPUTER GENERATED DRAWING AND ONLY EDITS CONSISTENT WITH ENVIROGEN'S ORIGINAL CAD FORMAT SHALL BE CONSIDERED VALID COPIES.

DESIGNER: NERT, HENDERSON, NV
CHECKER: NERT, HENDERSON, NV
DATE: 01-01-03
SCALE: 1/8" = 1'-0"

FORMING SCALE

SCALE	N/A
DATE	01-02-03
BY	01-02-03
CHK	01-14-03
APP	


U.S. PATENTS 5750028, 5788842, 6706521 AND PATENTS PENDING.

ENVIROGEN TECHNOLOGIES
250 PHILLIPS BLVD. SUITE 255
EVINGTON, NJ 08018

A Lifecycle Performance Company
A member of the Amgen Group

PIPING INSTRUMENTATION DIAGRAM
FLUIDIZED BED PERCHLORATE TREATMENT SYSTEM

1373-PID03A
SHEET 5 OF 26
REVISION: 3

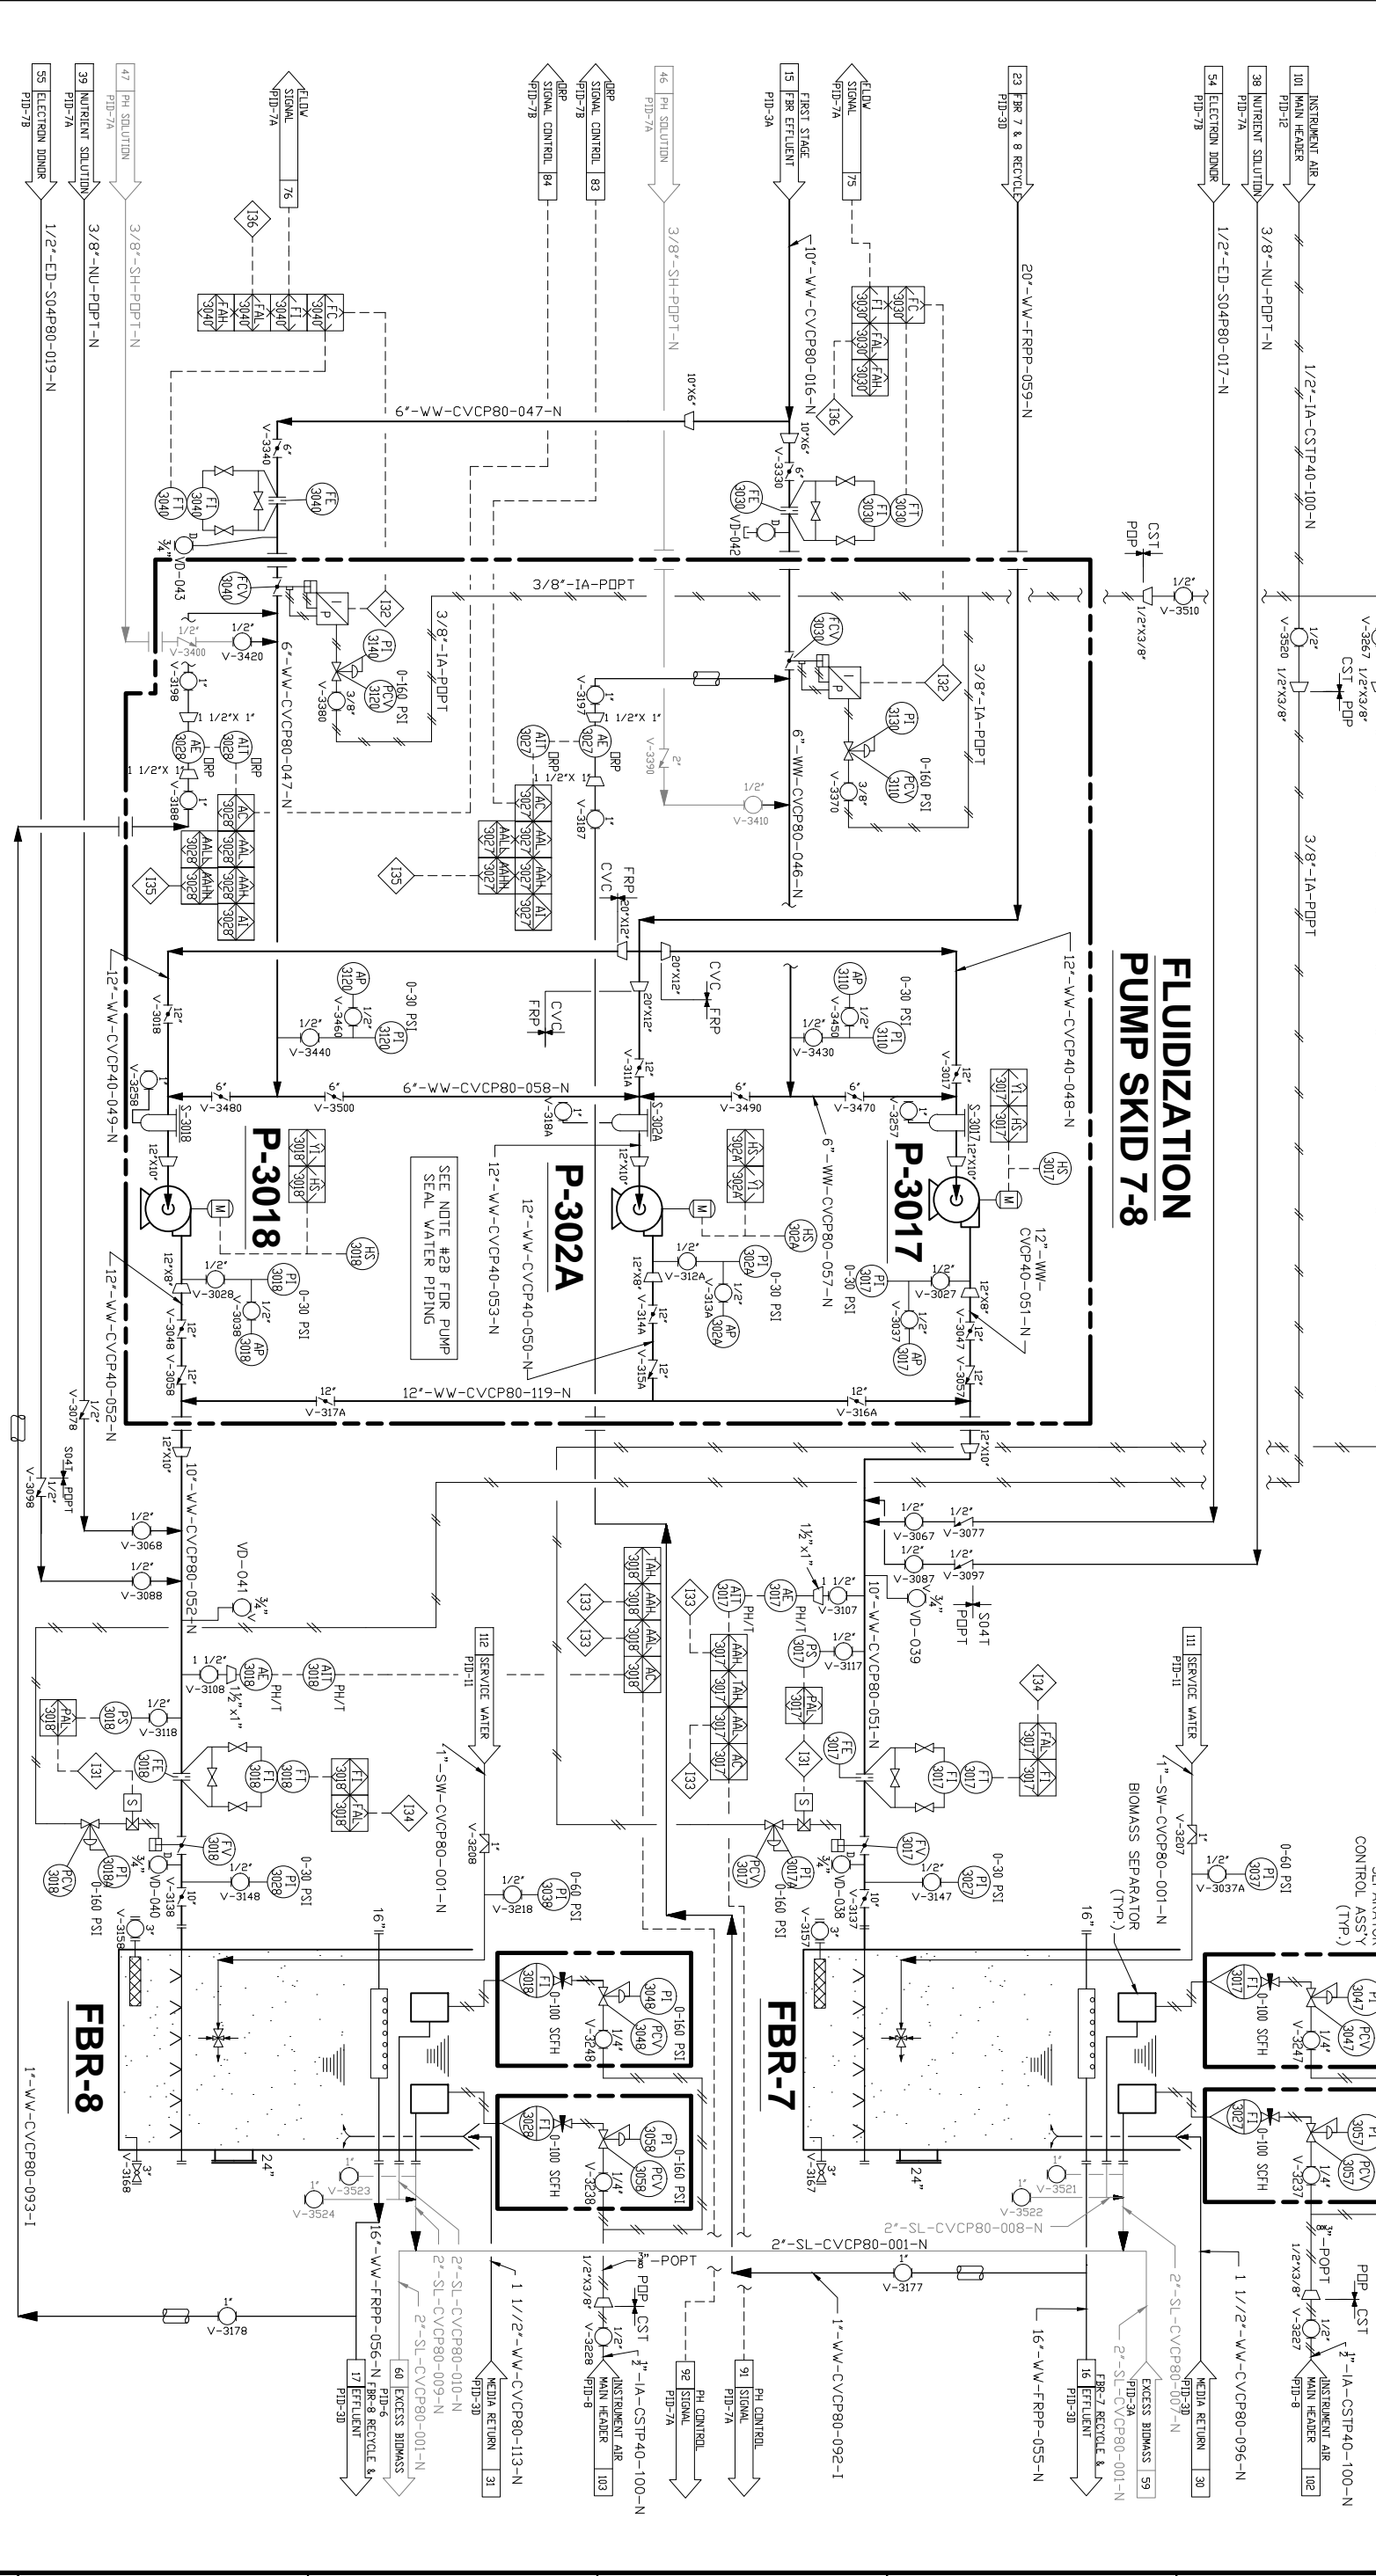

FLUIDIZATION PUMP SKID 7-8

<p>FBR-78 SECOND STAGE FLUIDIZED BED REACTORS</p>	<p>P-3017, 302A, 3018 SECOND STAGE FLUIDIZATION PUMPS</p>
<p>SIZE: 1400A X 60STR MATERIALS: FRP CAPACITY: 28,800 GAL. MEDIA TYPE: CARBON MEDIA VOLUME: 11730 CU. FT.</p>	<p>TYPE: CENTRIFUGAL CAPACITY: 2,000 GPM @ 40' TDH WETTED MATERIAL: FRP MOTOR: 30 HP, 460 VAC, 3 PH MODEL:</p>

ALL INFORMATION CONTAINED ON THIS DOCUMENT IS THE PROPERTY OF ENVIROGEN TECHNOLOGIES, INC. ("ENVIROGEN") AND/OR ITS AFFILIATES. THE DESIGN CONCEPTS AND INFORMATION CONTAINED HEREIN ARE PROPERTY OF ENVIROGEN AND ARE SUBMITTED IN CONFIDENCE. THEY ARE NOT TRANSFERABLE AND MUST BE USED ONLY FOR THE PROJECT AND SITE SPECIFICALLY IDENTIFIED IN THIS DOCUMENT. ANY REPRODUCTION, DISTRIBUTION, OR USE OF THIS DOCUMENT IN ANY MANNER WITHOUT THE EXPRESS WRITTEN CONSENT OF ENVIROGEN IS STRICTLY PROHIBITED. ENVIROGEN ASSUMES NO RESPONSIBILITY OR LIABILITY FOR THE USE OF THIS DOCUMENT OR THE DESIGN CONCEPTS AND INFORMATION CONTAINED HEREIN FOR ANY OTHER PROJECT OR SITE. ENVIROGEN'S ORIGINAL INTENTED USE OF THIS DOCUMENT IS IN NO EVENT SHALL THIS DOCUMENT OR THE DESIGN CONCEPTS AND INFORMATION CONTAINED HEREIN BE REPRODUCED, TRANSMITTED, OR USED IN ANY MANNER WITHOUT THE EXPRESS WRITTEN CONSENT OF ENVIROGEN. ENVIROGEN'S ORIGINAL INTENTED USE OF THIS DOCUMENT IS IN NO EVENT SHALL THIS DOCUMENT OR THE DESIGN CONCEPTS AND INFORMATION CONTAINED HEREIN BE REPRODUCED, TRANSMITTED, OR USED IN ANY MANNER WITHOUT THE EXPRESS WRITTEN CONSENT OF ENVIROGEN. ENVIROGEN'S ORIGINAL INTENTED USE OF THIS DOCUMENT IS IN NO EVENT SHALL THIS DOCUMENT OR THE DESIGN CONCEPTS AND INFORMATION CONTAINED HEREIN BE REPRODUCED, TRANSMITTED, OR USED IN ANY MANNER WITHOUT THE EXPRESS WRITTEN CONSENT OF ENVIROGEN.

<p>RECORD DRAWING - REVISED FOR 2013 CURRENT OPERATIONS & REVISED O&M MANUAL</p>	<p>REVISIONS</p>
<p>9-28-06</p>	<p>1</p>
<p>12-27-06</p>	<p>2</p>
<p>11-15-13</p>	<p>3</p>


U.S. PATENTS 5750028, 5788842, 6706521 AND PATENTS PENDING.

ENVIROGEN
TECHNOLOGIES
250 PHILLIPS BLVD. SUITE 255
EMERYVILLE, OHIO 44009


A Lifecycle Performance Company

PIPING & INSTRUMENTATION DIAGRAM
FLUIDIZED BED PERCOLATOR
TREATMENT SYSTEM

1373-PID03B
REVISED 11/14/13

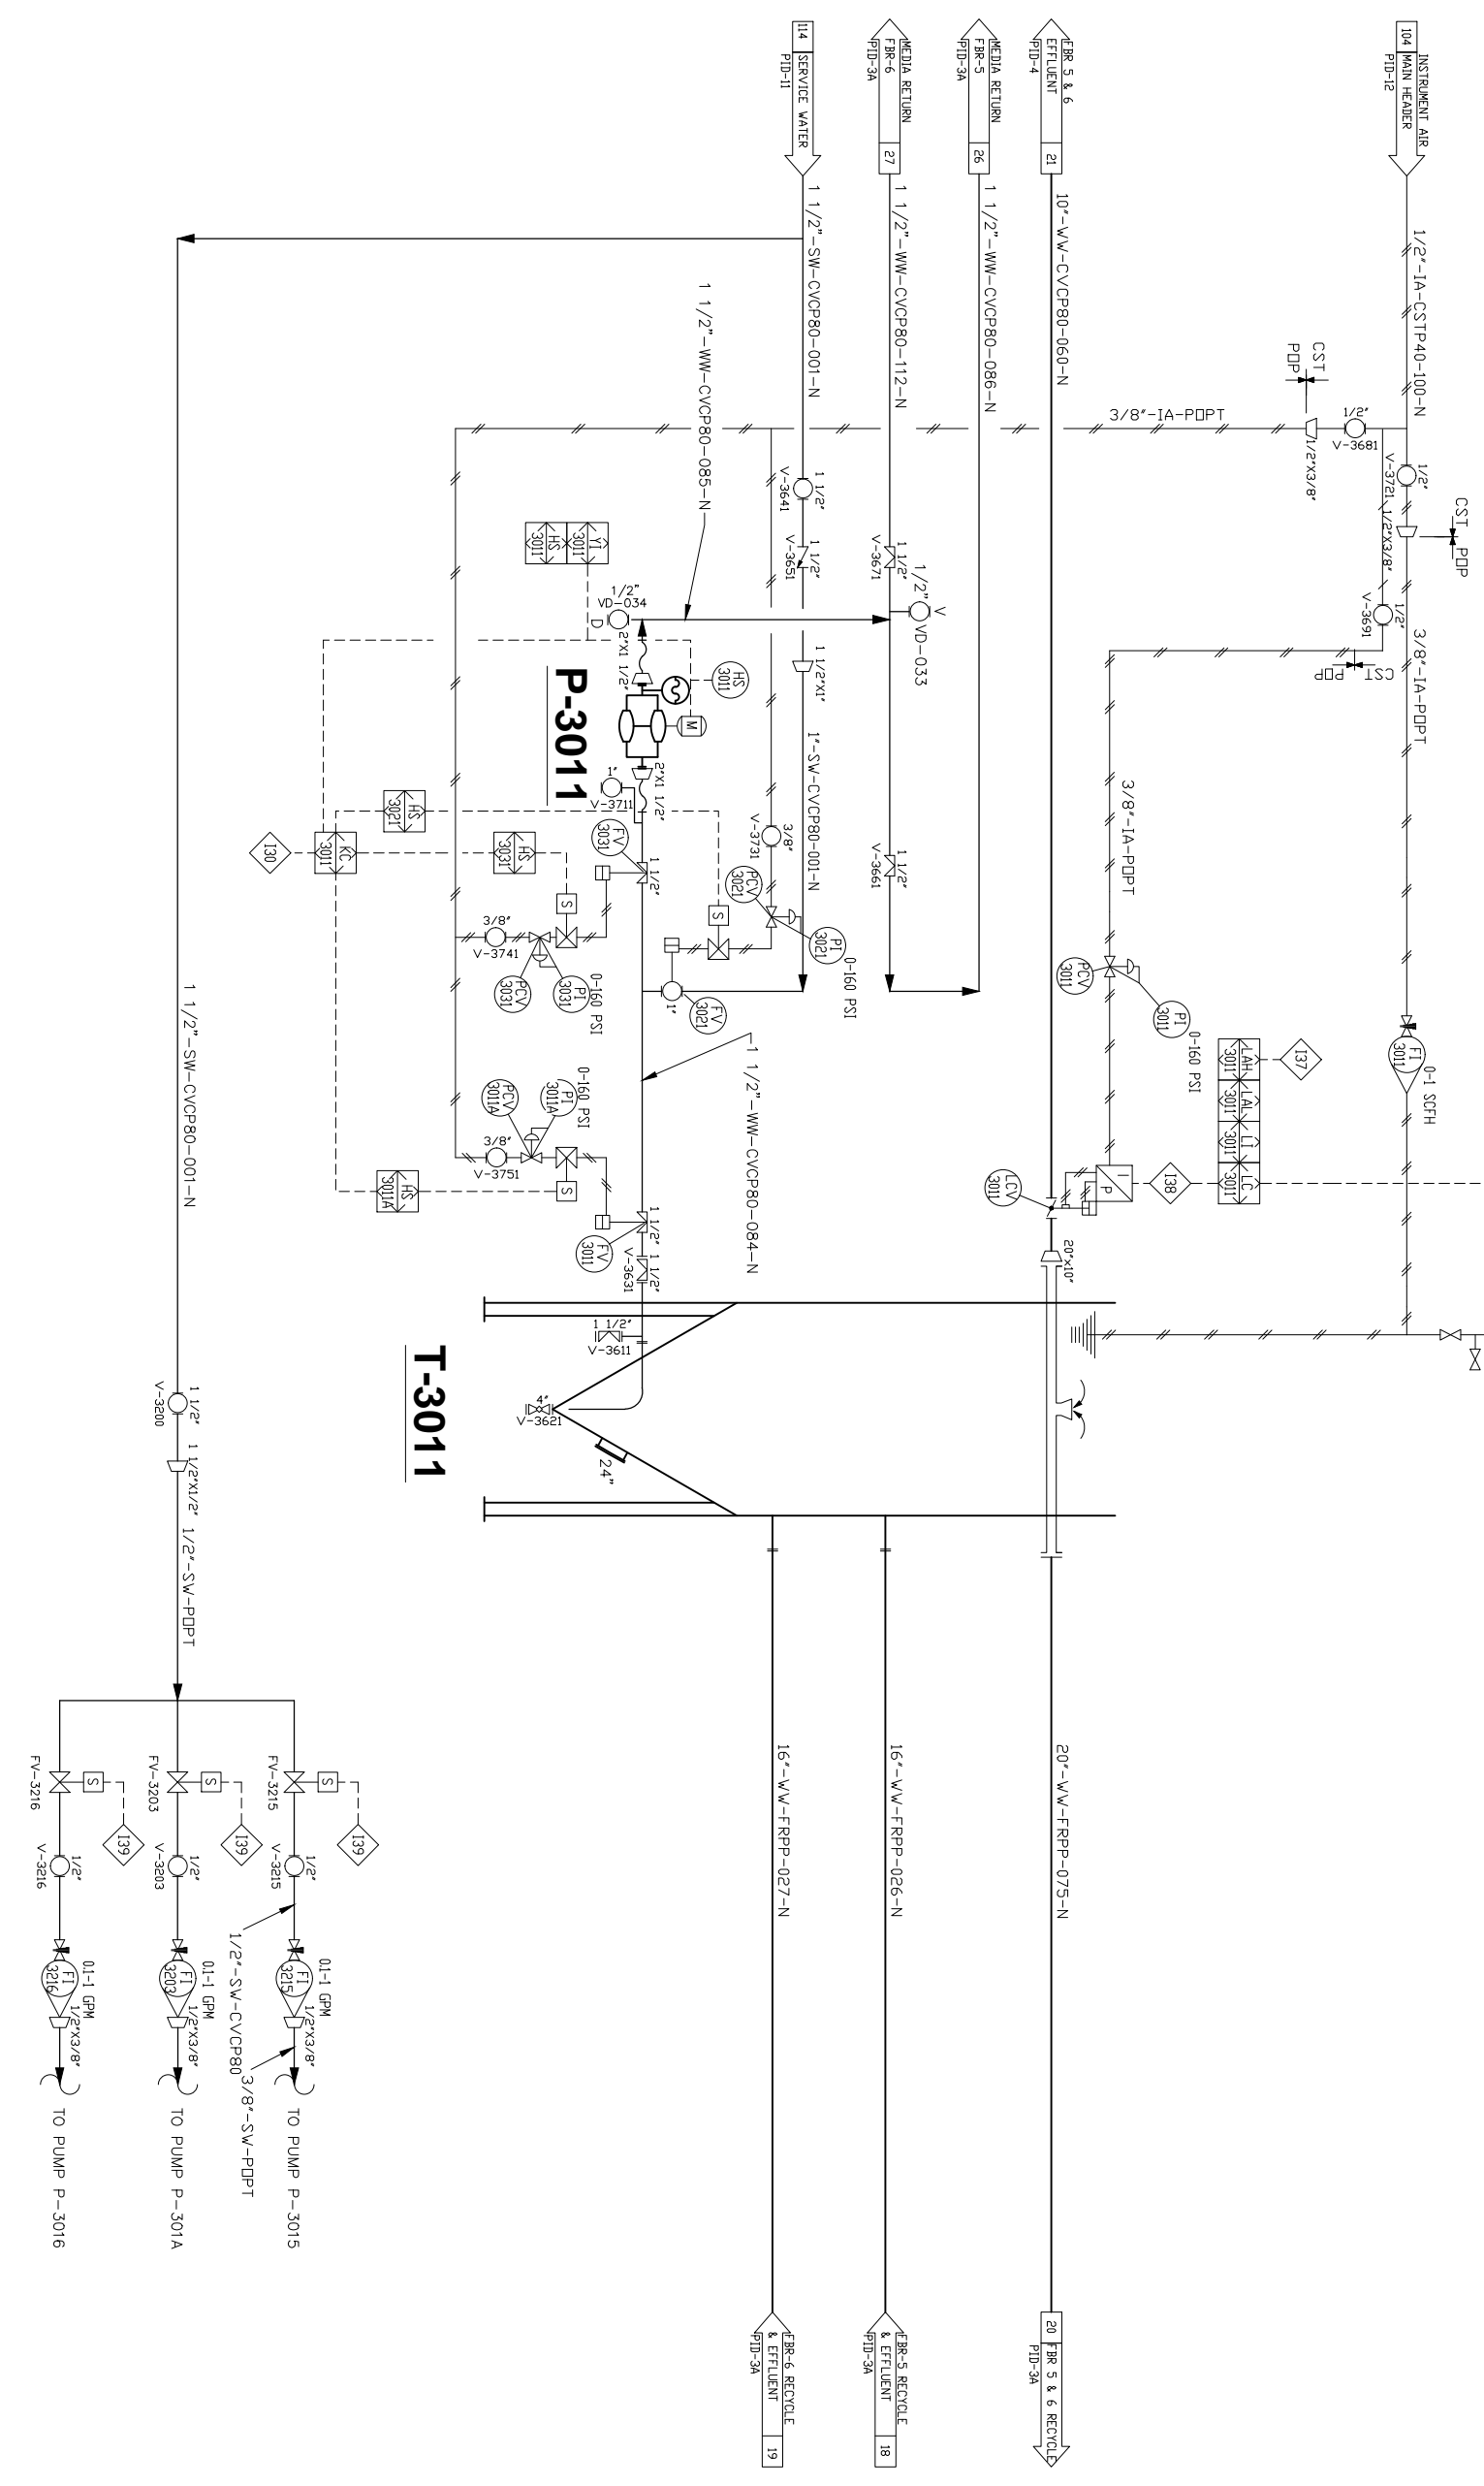

T-3011 SEPARATOR TANK	P-3011 MEDIA RETURN PUMP
SIZE: 14' DIA X 26' HI. MATERIAL: 304 SS CAPACITY: 18,400 GAL	TYPE: ELECTRIC DIAPHRAGM CAPACITY: 30 GPM @ 40' H ₂ O MATERIAL: PVC, NEOPRENE MODEL: 10 HP 460 VAC 3 PH MODEL: 10 HP VALLEY 2" DOUBLE END

 


ALL INFORMATION CONTAINED ON THIS DOCUMENT IS THE PROPERTY OF ENVIROGEN TECHNOLOGIES, INC. (ENVIROGEN) AND/OR ITS AFFILIATES. THE DESIGN CONCEPTS AND INFORMATION CONTAINED HEREIN ARE PROPERTY OF ENVIROGEN AND ARE SUBMITTED IN CONFIDENCE. THEY ARE NOT TRANSFERABLE AND MUST BE USED ONLY FOR THE PROJECT AND SITE SPECIFICALLY IDENTIFIED IN THIS DOCUMENT. ANY REPRODUCTION, REUSE, OR DISSEMINATION OF THIS DOCUMENT, IN ANY MANNER, WITHOUT THE EXPRESS WRITTEN CONSENT OF ENVIROGEN IS STRICTLY PROHIBITED. ENVIROGEN ASSUMES NO RESPONSIBILITY OR LIABILITY FOR THE USE OF THIS DOCUMENT OR THE DESIGN CONCEPTS CONTAINED HEREIN FOR ANY PROJECT OTHER THAN THAT SPECIFICALLY IDENTIFIED IN THIS DOCUMENT. ENVIROGEN'S ORIGINAL INTENTED USE OF THIS DOCUMENT IS IN NO EVENT SHALL THIS DOCUMENT OR THE DESIGN CONCEPTS CONTAINED HEREIN BE USED FOR ANY OTHER PROJECT WITHOUT THE EXPRESS WRITTEN CONSENT OF ENVIROGEN. THE DESIGN CONCEPTS AND INFORMATION CONTAINED ON THIS DOCUMENT ARE THE PROPERTY OF ENVIROGEN AND ITS CUSTOMER. ALL RIGHTS ARE RESERVED. ACCEPTANCE OF THIS DOCUMENT CONSTITUTES AGREEMENT TO THESE TERMS AND CONDITIONS.


11-15-13	RECORD DRAWING - REVISED FOR 2013 CURRENT OPERATIONS & REVISED O&M MANUAL	DL	DL
9-26-06	RECORD DRAWING	DL	DL
12-27-06	ISSUED FOR CONSTRUCTION (NO CHANGE TO EXISTING)	DM	RE
	DESCRIPTION OF REVISION	REVISED PROJECT	SR
	ENVIROGEN'S ORIGINAL CAD FORMAT SHALL BE CONSIDERED VALID COPIES		

DRAWING SCALE		N/A
REVISIONS		SF / 01-13-03
DRAWN BY/DATE		LJ / 01-13-13
CHECKED BY/DATE		MD / 01-14-03
SHEET SIZE		D
REVISION		2

PIPING & INSTRUMENTATION DIAGRAM
FLUIDIZED BED PERCHLORATE
TREATMENT SYSTEM

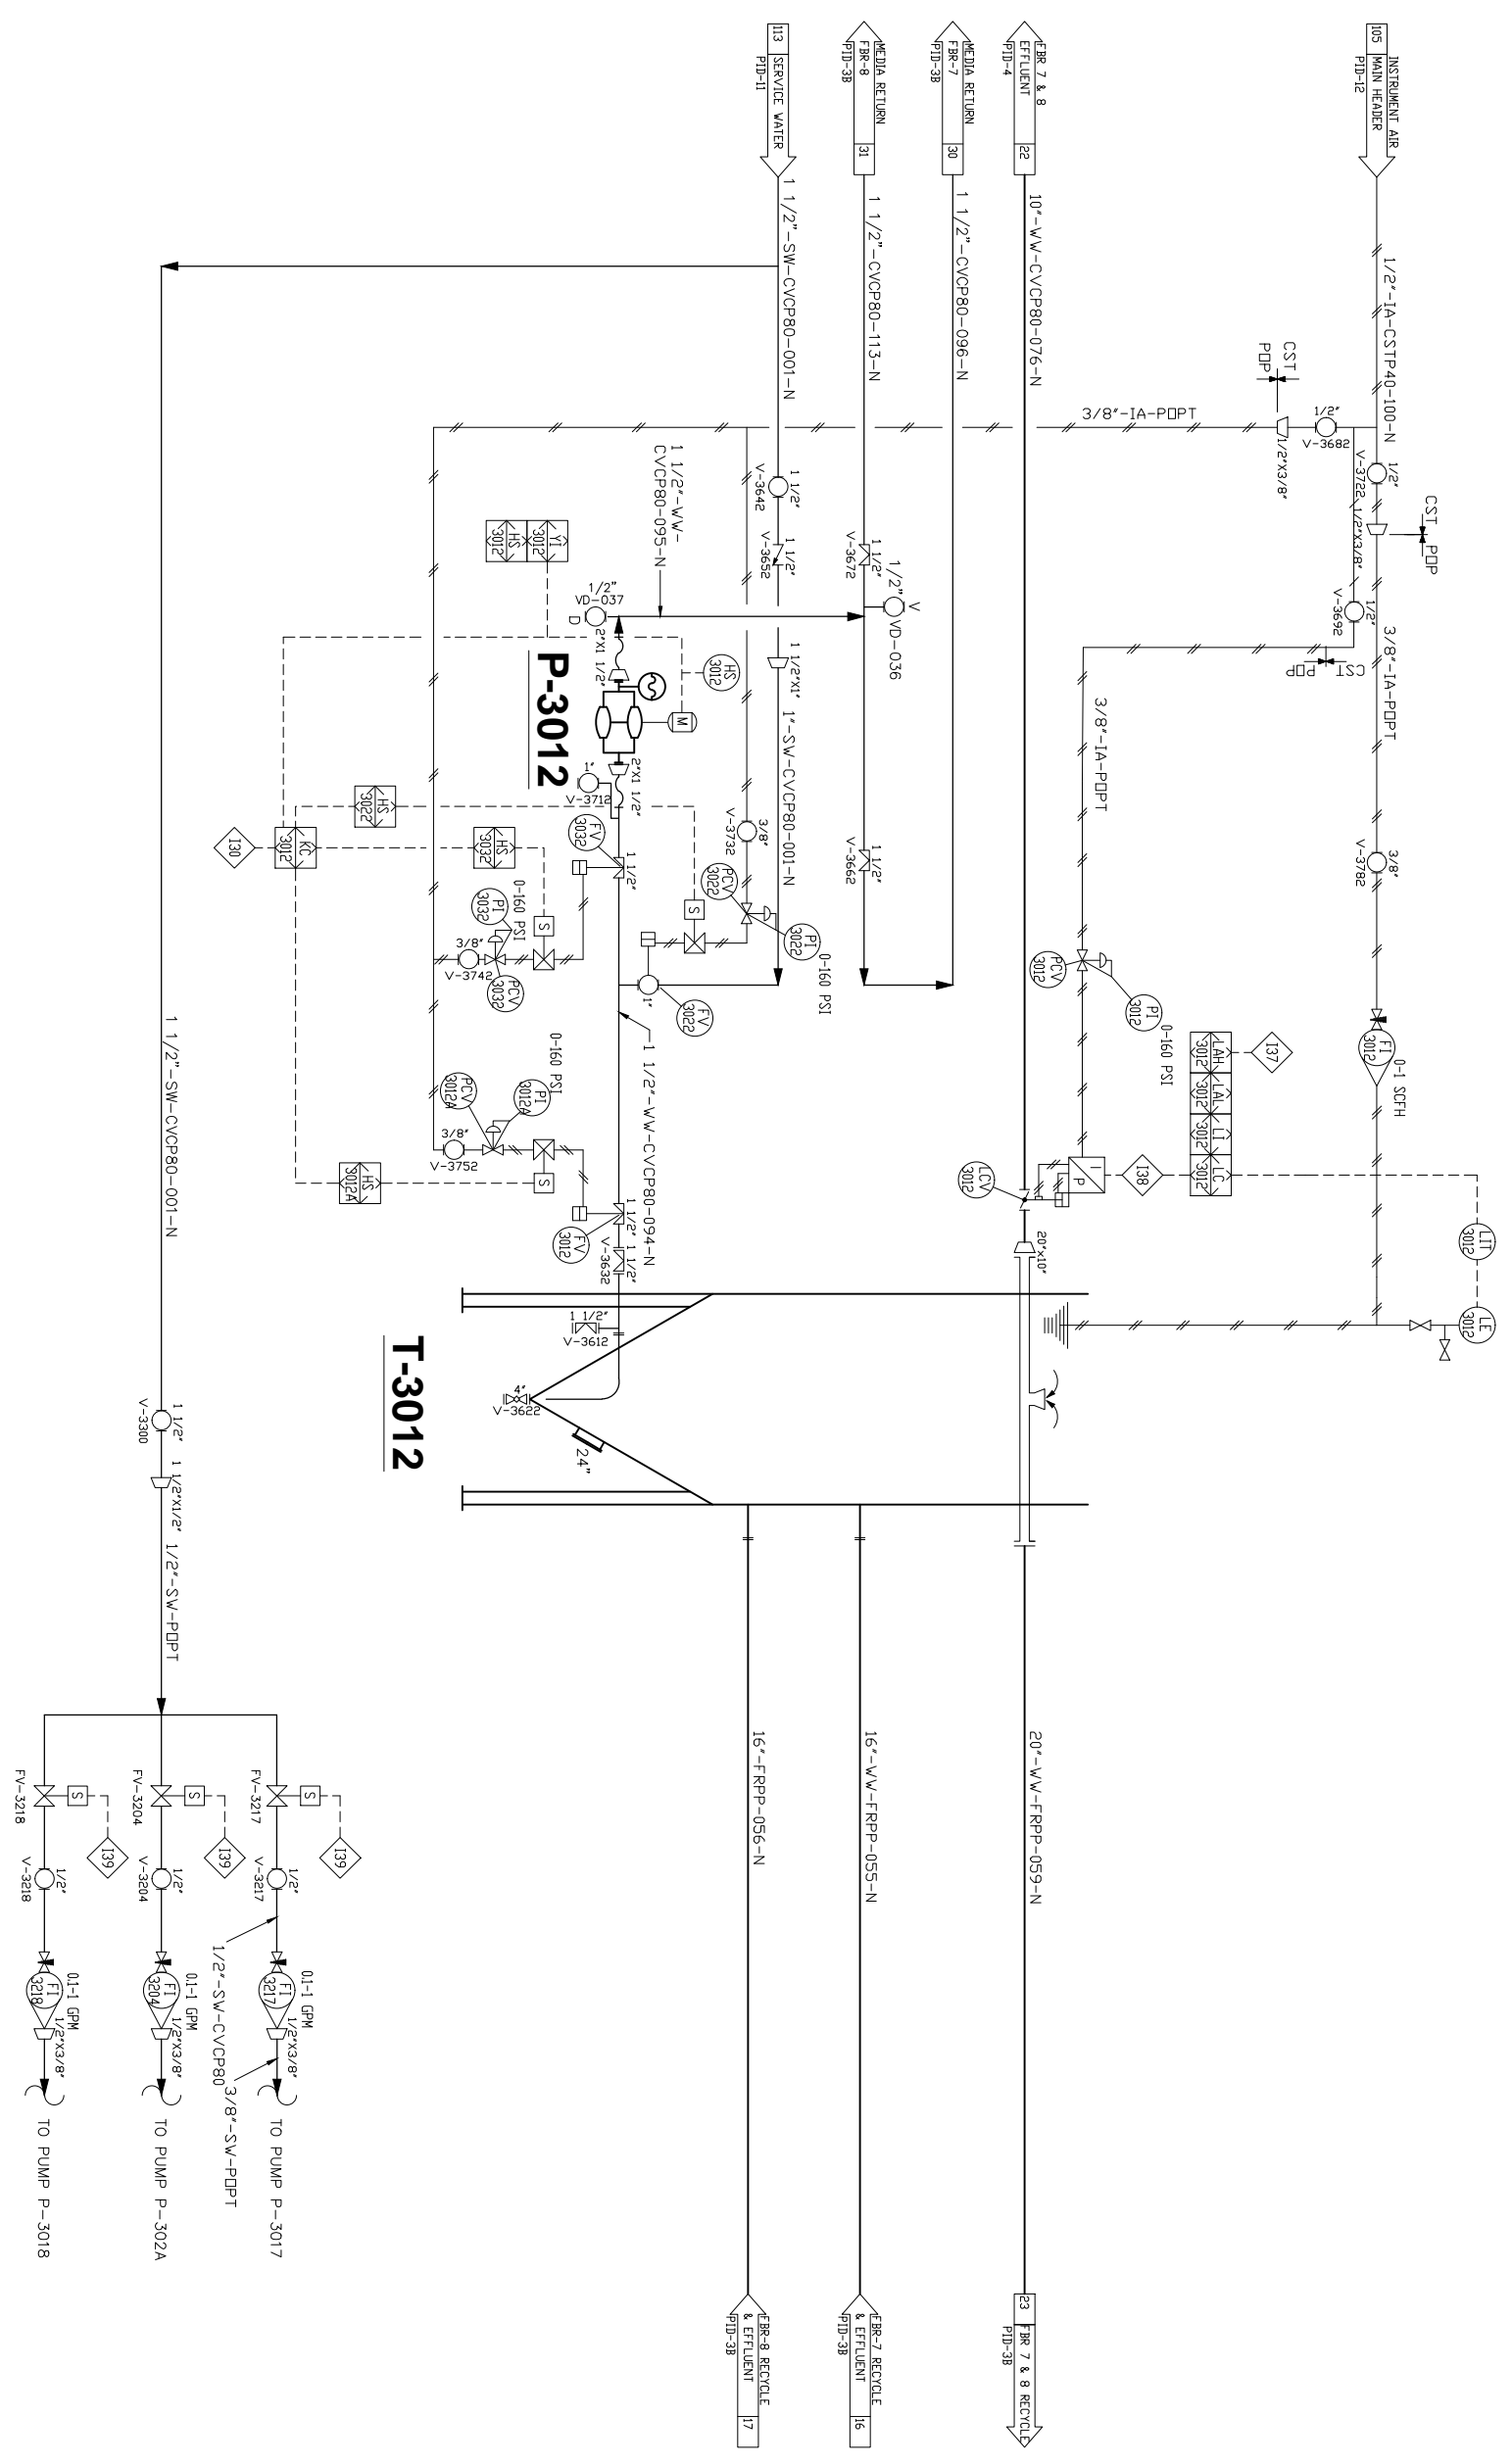

P-3012 2ND STAGE SEPARATOR TANK SIZE: 14' DIA. X 26' HT. MATEL: S.F.P.P. CAPACITY: 18,400 GAL.	P-3012 MEDIA RETURN PUMP TYPE: ELECTRIC DRIVEN CAPACITY: 30 GPM @ 40' TDH MATEL: S.F.P.P. MOTOR: 10 HP 460 VAC, 3 PH MODEL: PENN VALLEY 2" DOUBLE DISC
--	---

 


ALL INFORMATION CONTAINED ON THIS DOCUMENT IS THE PROPERTY OF ENVIROGEN TECHNOLOGIES, INC. PROPERTY OF ENVIROGEN AND/OR ITS AFFILIATES. THE DESIGN CONCEPTS AND INFORMATION CONTAINED HEREIN ARE FOR YOUR USE ONLY AND ARE NOT TO BE REPRODUCED, COPIED, REPRODUCED, LOANED OR USED IN ANY OTHER MANNER WITHOUT THE EXPRESS WRITTEN CONSENT OF ENVIROGEN. ENVIROGEN ASSUMES NO RESPONSIBILITY OR LIABILITY FOR THE USE OF THIS DOCUMENT OR THE DESIGN CONCEPTS CONTAINED HEREIN FOR ANY PURPOSES OTHER THAN THAT SPECIFICALLY INTENDED BY ENVIROGEN. ENVIROGEN MAKES NO WARRANTY, REPRESENTATION OR GUARANTEE, EXPRESS OR IMPLIED, REGARDING THE ACCURACY, COMPLETENESS, OR QUALITY OF THE INFORMATION CONTAINED HEREIN. THE USER OF THIS DOCUMENT SHALL BE RESPONSIBLE FOR OBTAINING ALL NECESSARY PERMITS AND APPROVALS FROM THE APPROPRIATE AGENCIES AND AGENCIES. ENVIROGEN AND OTHER RIGHTS ARE RESERVED. ACCEPTANCE OF THE DELIVERY OF THIS DOCUMENT CONSTITUTES AGREEMENT TO THESE TERMS AND CONDITIONS.

U.S. PATENTS 5750028, 5788842, 6706521 AND PATENTS PENDING.	HENDERSON, NV
---	---------------

PIPING & INSTRUMENTATION DIAGRAM FLUIDIZED BED PERCHLORATE TREATMENT SYSTEM	SHEET 8 OF 26 1373-PID03D
---	------------------------------

REVISIONS NO. DATE DESCRIPTION 1 11-15-13 RECORD DRAWING - REVISED FOR 2013 COMMENT OPERATIONS & REVISED DATA MANUAL 2 9-28-06 RECORD DRAWING 3 12-27-06 ISSUED FOR CONSTRUCTION (NO CHANGE TO EXISTING) 4 12-27-06 REVISION OF REVISION 5 01-13-03 REVISION 6 01-14-03 REVISION	DRAWING SCALE N/A
---	----------------------

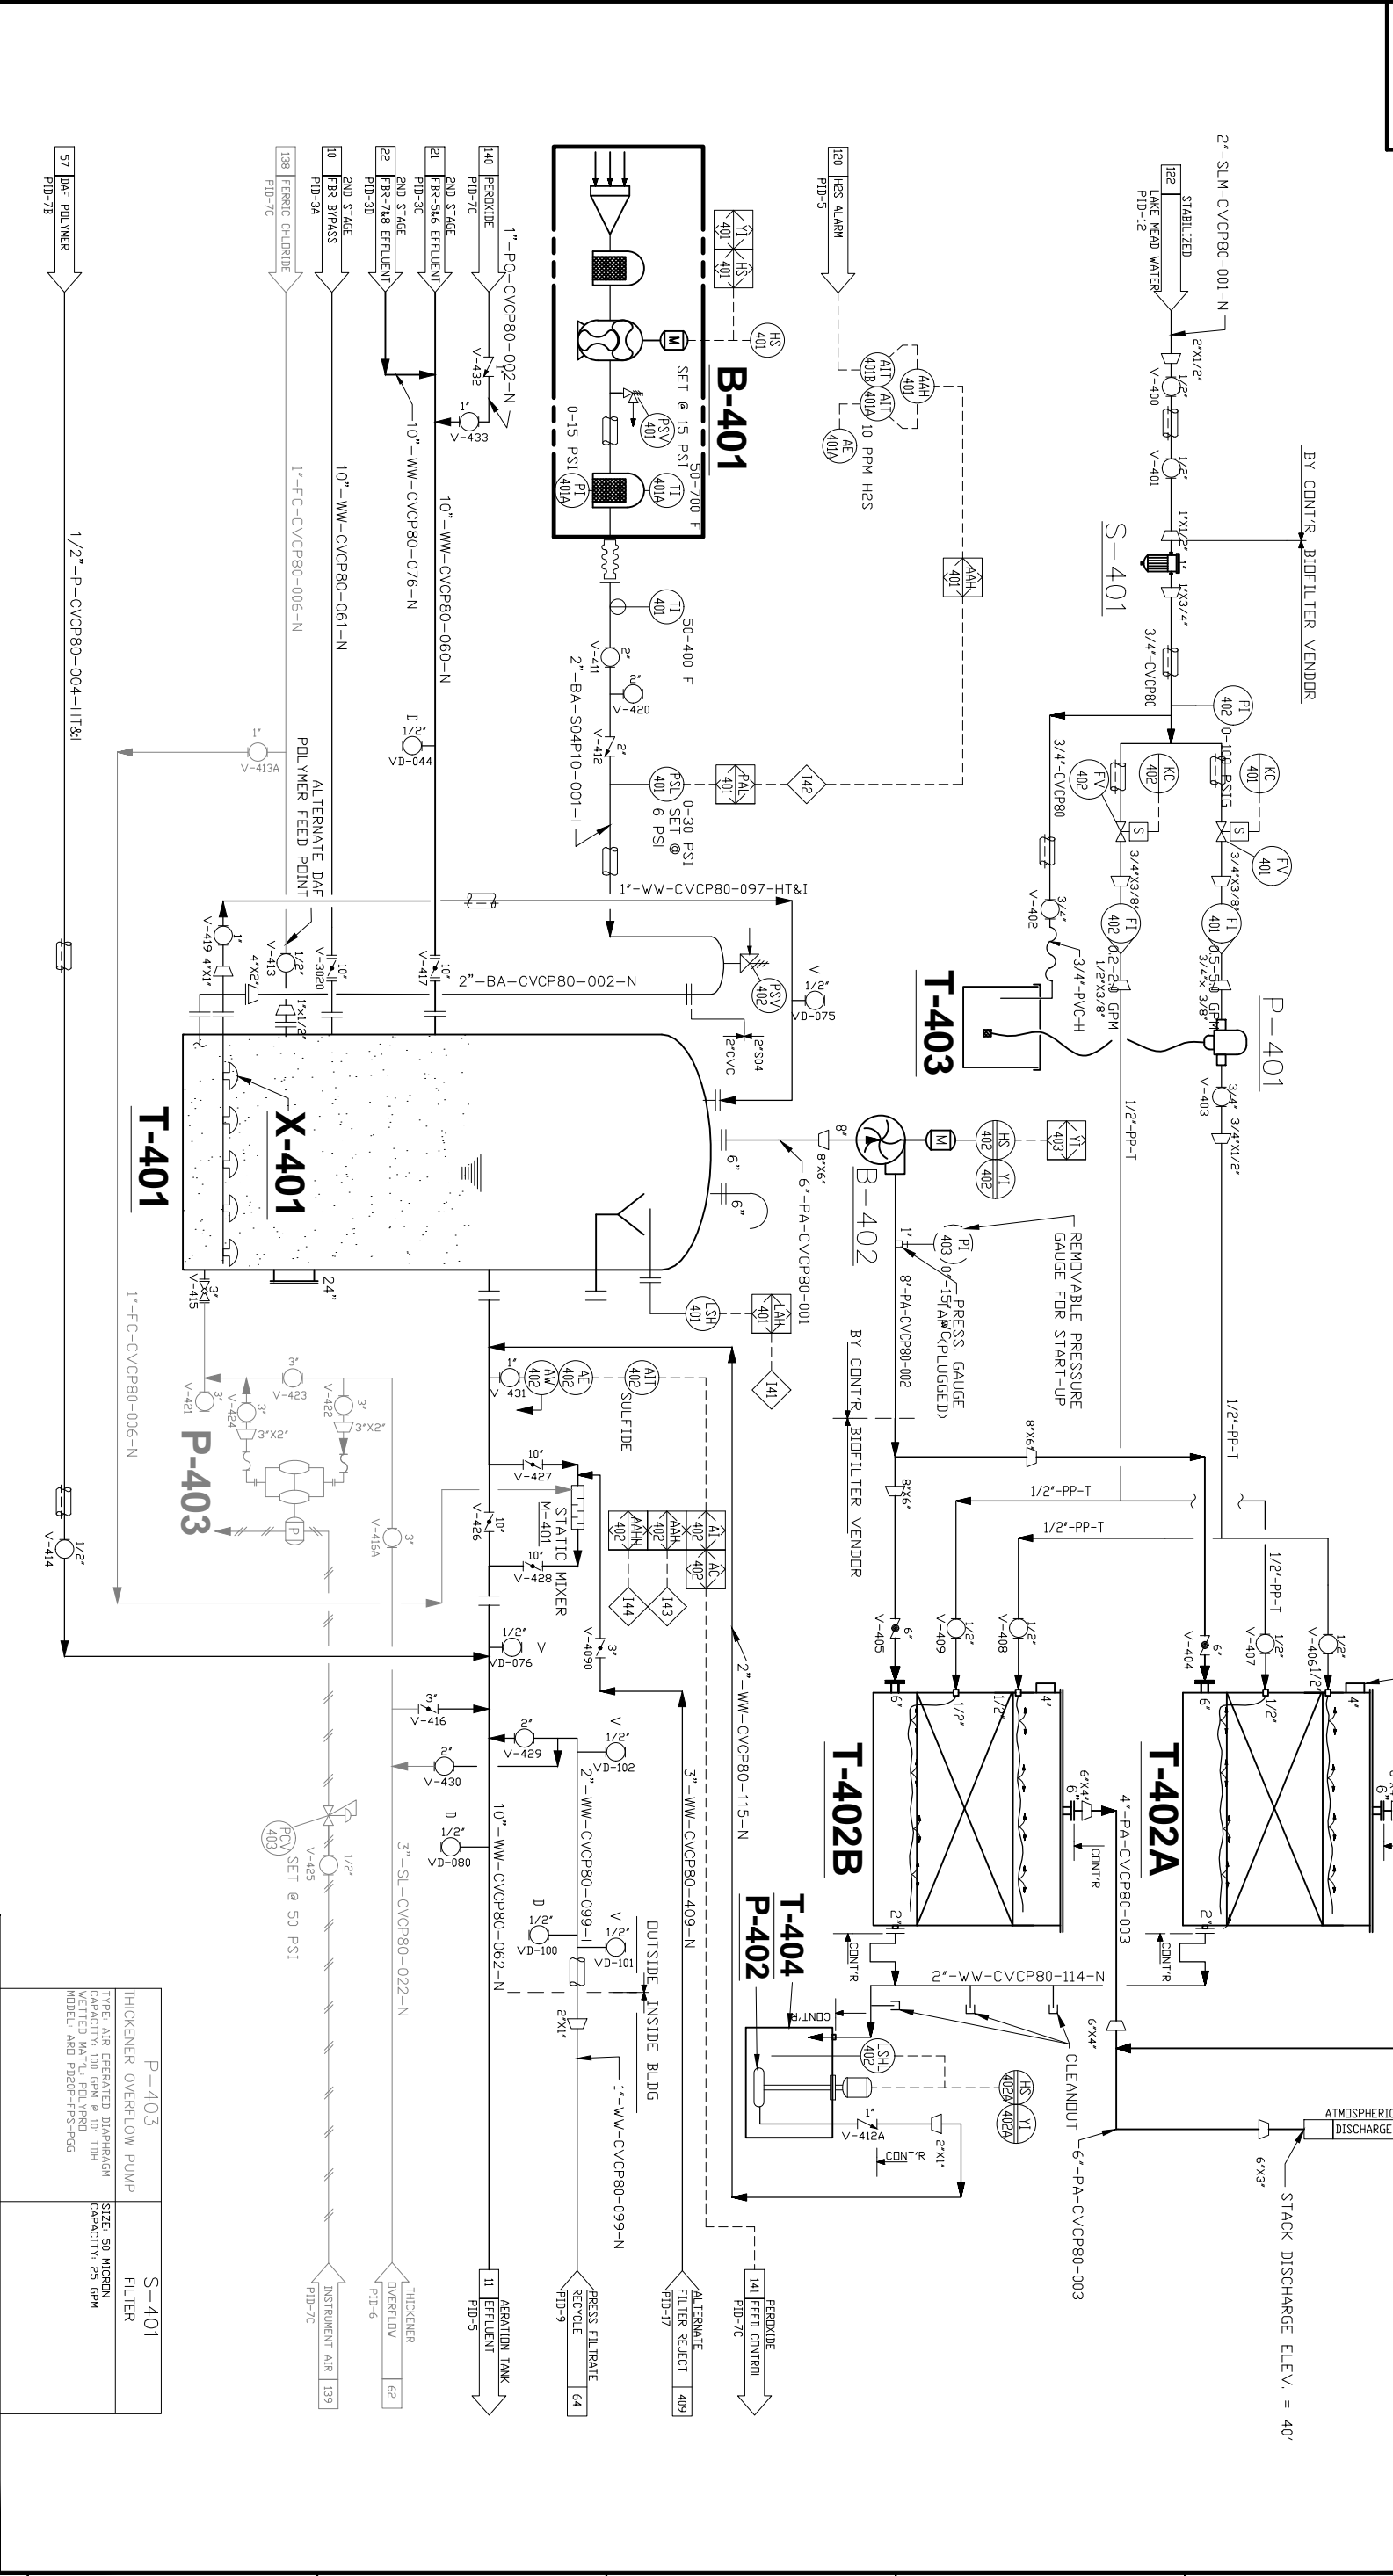

Equipment ID	Equipment Name	Model / Description	Capacity / Performance
T-401	AERATION TANK	TYPE: 14' DIA. X 24'-6" STR MAT'L: FRP CAPACITY: 28,000 GAL.	
T-402 A/B	BIOFILTER	TYPE: 22' DIA. X 36'-6" MAT'L: POLYPROPYLENE CAPACITY: 55 GAL.	
T-403	NUTRIENT SOLUTION	TYPE: 22' DIA. X 36'-6" MAT'L: POLYPROPYLENE CAPACITY: 55 GAL.	
T-404	BIOFILTER SUMP	MODEL: 103A30RN DI-16HG MAT'L: POLYPROPYLENE CAPACITY: 11 GPM	
P-401	NUTRIENT PUMP	MODEL: 103A30RN DI-16HG MAT'L: POLYPROPYLENE CAPACITY: 11 GPM	
P-402	BIOFILTER SUMP PUMP	MODEL: 1 HP, 460/23/60 CAPACITY: 10 GPM @ 32' TDH	
P-403	BIOFILTER SUMP PUMP	MODEL: 1 HP, 460/23/60 CAPACITY: 10 GPM @ 32' TDH	
B-401	AERATION BLOWER	TYPE: ROTARY LUBE CAPACITY: 50 SCFM @ 13 PSIG MOTOR: SHP, 460VAC, 3Ø	
B-402	BIOFILTER BLOWER	MODEL: NEW YORK BLOWER RT-F-200(S) SIZE: 9" DIA. MAT'L: PVC PIPE & DIFFUSER BODY CAPACITY: 200 CFM @ 5" VC MOTOR: SHP, 460/3/60	
X-401	AERATION DIFFUSERS	TYPE: 14' DIA. X 24'-6" STR MAT'L: FRP CAPACITY: 28,000 GAL.	
S-401	THICKENER OVERFLOW PUMP	TYPE: AIR OPERATED DIAPHRAGM CAPACITY: 100 GPM @ 10' TDH	
S-403	THICKENER OVERFLOW PUMP	TYPE: AIR OPERATED DIAPHRAGM CAPACITY: 100 GPM @ 10' TDH	

U.S. PATENTS 5750028, 5788842, 6706521 AND PATENTS PENDING.

ENVIROGEN TECHNOLOGIES
250 PHILLIPS BLVD, SUITE 255
EVINGTON, NJ 08018

A Lifecycle Performance Company

ALL INFORMATION CONTAINED ON THIS DOCUMENT IS THE PROPERTY OF ENVIROGEN TECHNOLOGIES, INC. ANY REPRODUCTION OR TRANSMISSION OF THIS DOCUMENT WITHOUT THE EXPRESS WRITTEN CONSENT OF ENVIROGEN TECHNOLOGIES IS STRICTLY PROHIBITED. ENVIROGEN TECHNOLOGIES ASSUMES NO RESPONSIBILITY OR LIABILITY FOR THE USE OF THIS DOCUMENT OR THE DESIGN CONCEPTS OR INFORMATION CONTAINED HEREIN FOR ANY PROJECT. ENVIROGEN TECHNOLOGIES SHALL NOT BE HELD RESPONSIBLE FOR ANY ORIGINAL INTENTED USE OF THIS DOCUMENT IN NO EVENT SHALL THIS DOCUMENT OR THE DESIGN CONCEPTS OR INFORMATION CONTAINED HEREIN BE REPRODUCED, TRANSMITTED, OR OTHERWISE DISCLOSED TO ANY OTHER PARTY WITHOUT THE EXPRESS WRITTEN CONSENT OF ENVIROGEN TECHNOLOGIES. ENVIROGEN TECHNOLOGIES AND OTHER RIGHTS ARE RESERVED. ACCEPTANCE OF THE DELIVERY OF THIS DOCUMENT CONSTITUTES AGREEMENT TO THESE TERMS AND CONDITIONS.

REVISIONS:


NO.	DATE	DESCRIPTION OF REVISION
1	11-15-13	RECORD DRAWING - REVISED FOR 2013 CURRENT OPERATIONS & RECORD DATA ANALYSIS
2	4-26-16	ISSUED FOR CONSTRUCTION
3	12-27-16	ISSUED FOR CONSTRUCTION

THIS IS A COMPUTER GENERATED DRAWING AND ONLY EDITS CONSISTENT WITH ENVIROGEN'S ORIGINAL CAD FORMAT SHALL BE CONSIDERED VALID COPIES.

PIPING & INSTRUMENTATION DIAGRAM
FLUIDIZED BED PERCOLATOR
TREATMENT SYSTEM

HENDERSON, NV
NEERT

SHEET 9 OF 26
1373-PID04

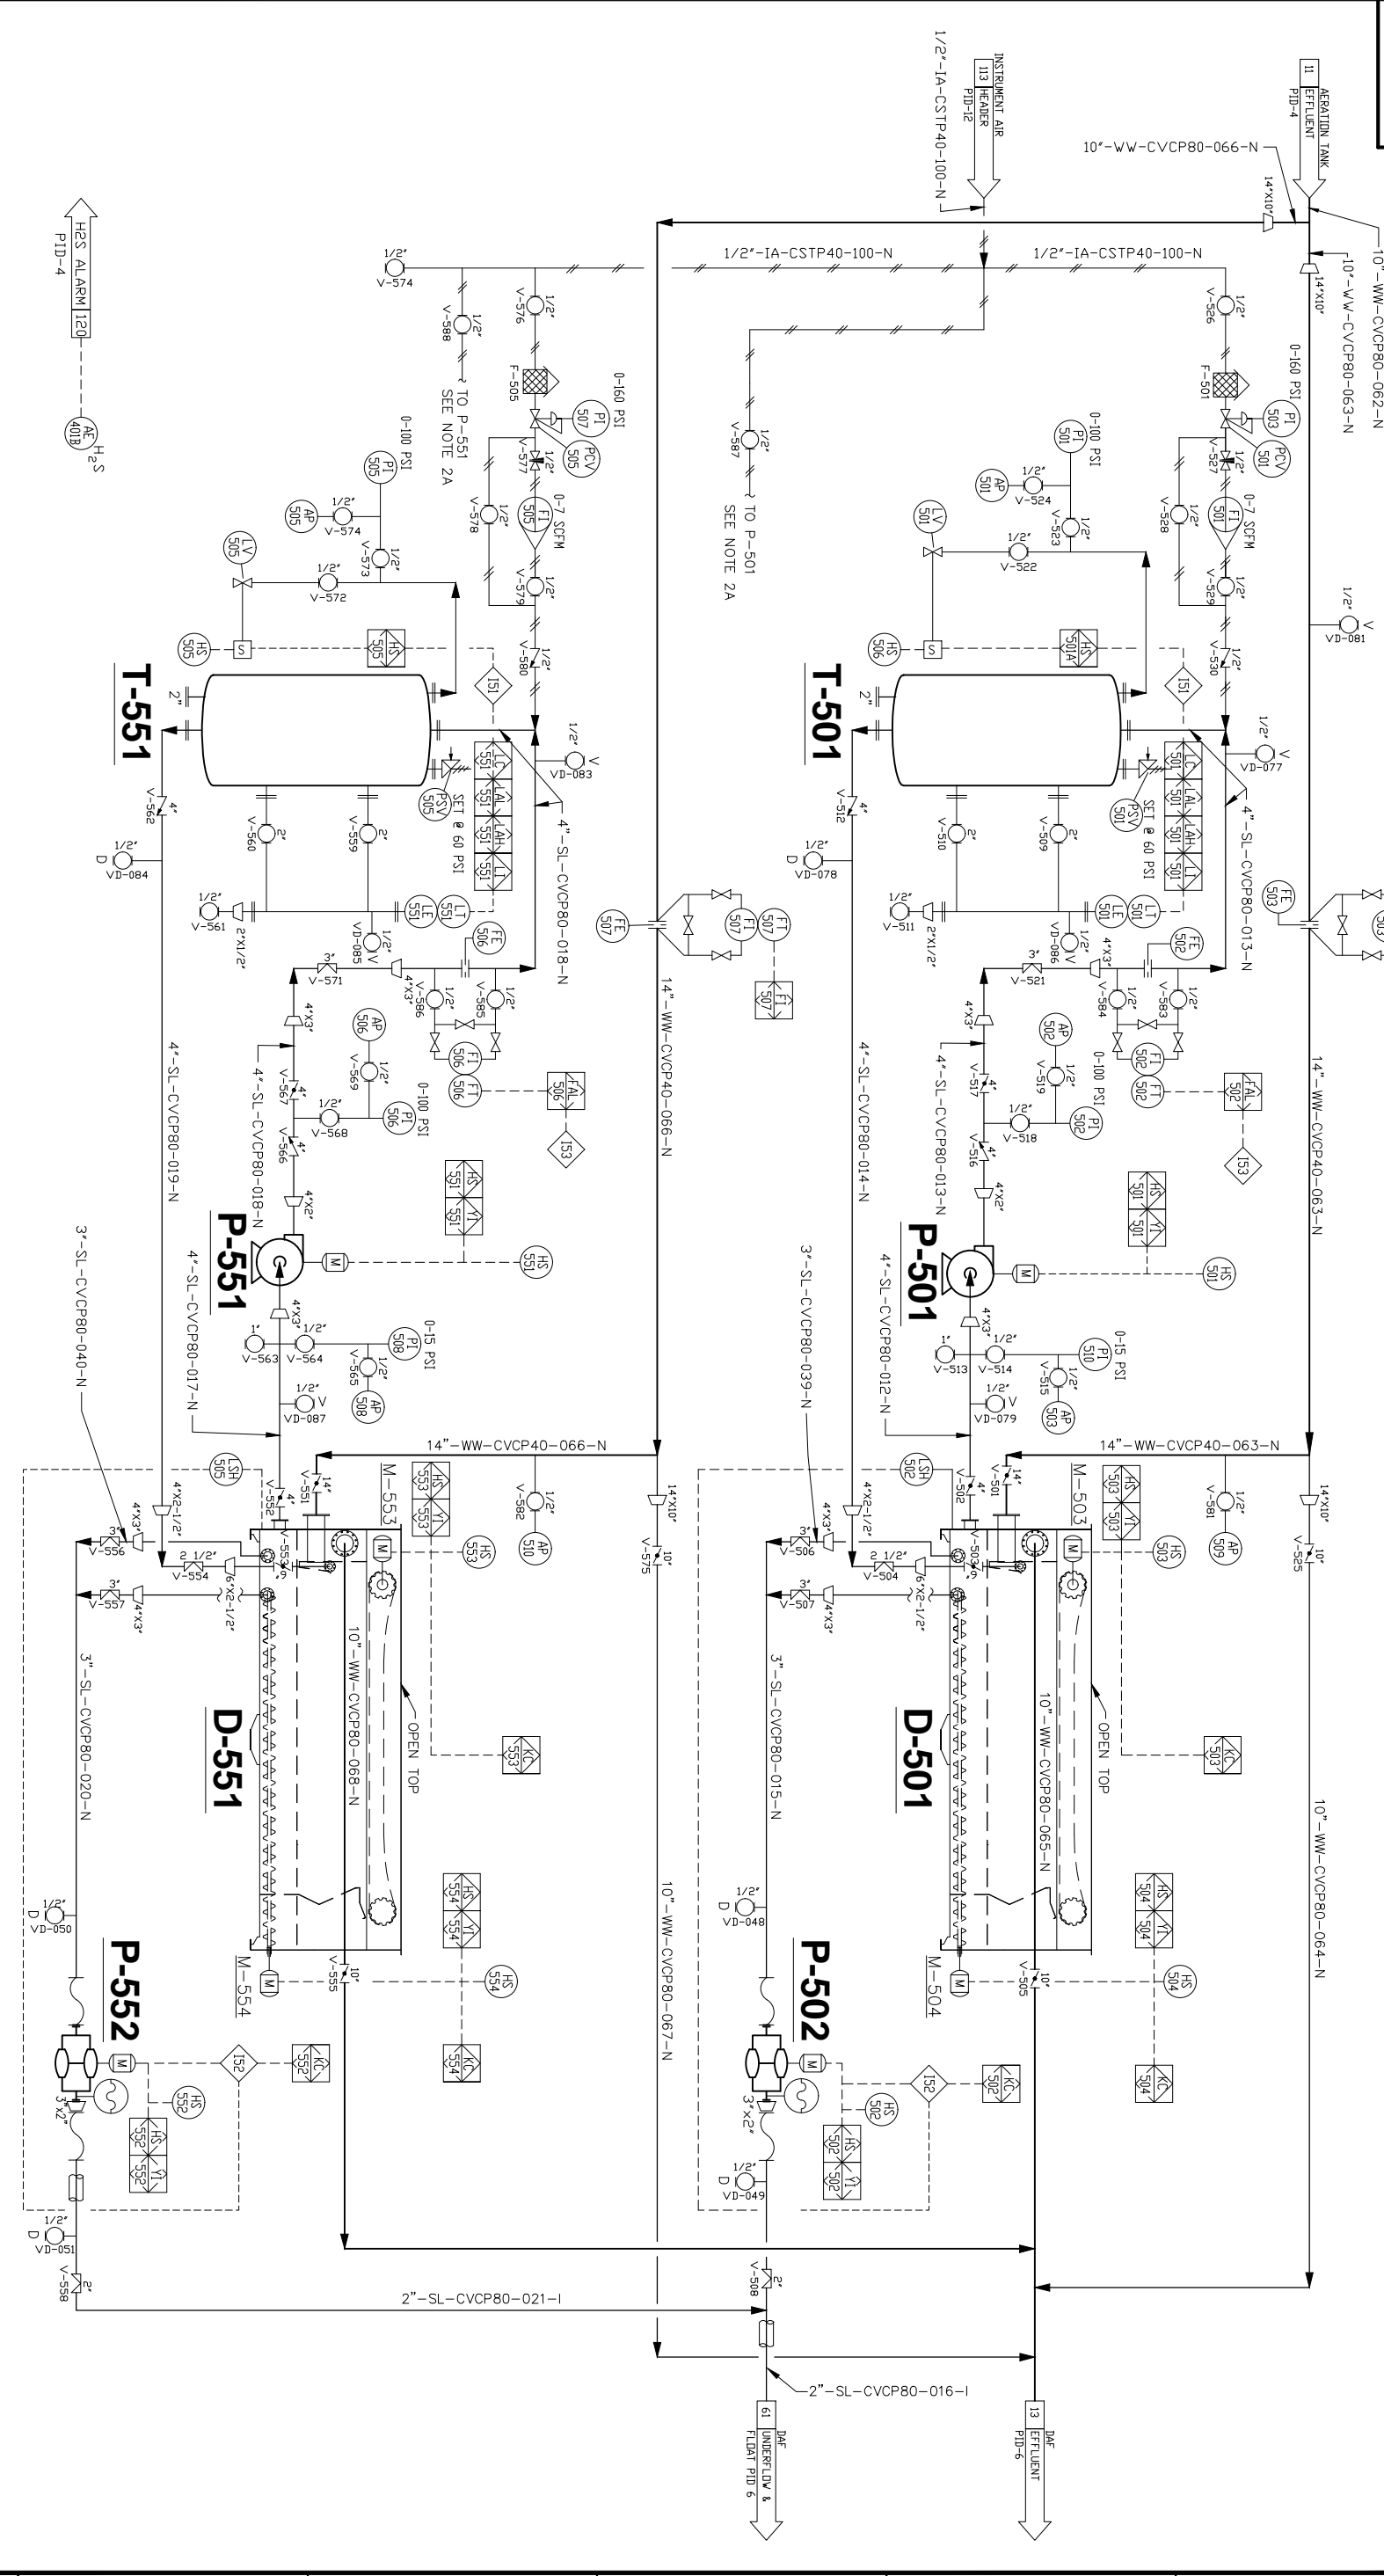

U.S. PATENTS 5750028, 5788842, 6706521 AND PATENTS PENDING.	T-501/551	P-501/551	D-501/551	P-502/552	M-504/554	M-503/553
DAF PRESSURE TANKS	DAF PRESSURE PUMPS	DAF VESSELS	DAF FLOAT PUMPS	DAF ELECTRIC DIAPHRAGM WETTED MATS. PVC & NEOPRENE	SCREW CONVEYER DRIVE	SKIMMER DRIVE
SIZE: 24' DIA X 10'-4" HT MATERIAL: LINED CS CAPACITY: 230 GAL DESIGN PRESS: 100 PSI	TYPE: CENTRIFUGAL WETTED MATS. FRP CAPACITY: 206 GPM @ 140' TDH MOTOR: 25 HP 460 VAC 3 PH	TYPE: CENTRIFUGAL WETTED MATS. FRP CAPACITY: 206 GPM @ 140' TDH MOTOR: 25 HP 460 VAC 3 PH	TYPE: 105' X 10.5' X 40' L MATERIAL: LINED CS CAPACITY: 1000 GPM	TYPE: ELECTRIC DIAPHRAGM WETTED MATS. PVC & NEOPRENE CAPACITY: 20 GPM @ 46 FT TDH MOTOR: 2HP, 460VAC, 3 PH	TYPE: DRIVE V/GEAR REDUCTION MOTOR: 0.75 HP 460 VAC 3 PH	TYPE: SKIMMER DRIVE MOTOR: 0.5 HP 460 VAC 3 PH

ENVIROGEN TECHNOLOGIES
250 PHILLIPS BLVD SUITE 255
EVINGTON, NJ 08018

A Lifecycle Performance Company
A member of the Aradigm Group

RECORD DRAWING - REVISED FOR 2013 CURRENT OPERATIONS & REVISED O&M MANUAL
RECORD DRAWING
BASED FOR CONSTRUCTION (NO CHANGE TO EXISTING)
DATE: 12-27-16
DESCRIPTION OF REVISION:
THIS IS A COMPUTER GENERATED DRAWING AND ONLY EDITS CONSISTENT WITH ENVIROGEN'S ORIGINAL CAD FORMAT SHALL BE CONSIDERED VALID COPIES.

NEERT HENDERSON, NV
PIPING & INSTRUMENTATION DIAGRAM
FLUIDIZED BED PERCHLORATE TREATMENT SYSTEM


REVISIONS:

NO.	DATE	BY	REASON
1	11-15-13	RECORD	RECORD DRAWING - REVISED FOR 2013 CURRENT OPERATIONS & REVISED O&M MANUAL
2	9-28-16	RECORD	RECORD DRAWING
3	12-27-16	RECORD	BASED FOR CONSTRUCTION (NO CHANGE TO EXISTING)

SCALE: SF / 01-02-03
RECORD BY/DATE
DRAWN BY/DATE
CHECKED BY/DATE
LJ / 01-02-03
MD / 01-14-03

SHEET SIZE: 2
SHEET NO.: 26
PROJECT NO.: 1373-PID05-2

EFFLUENT PUMP SKID

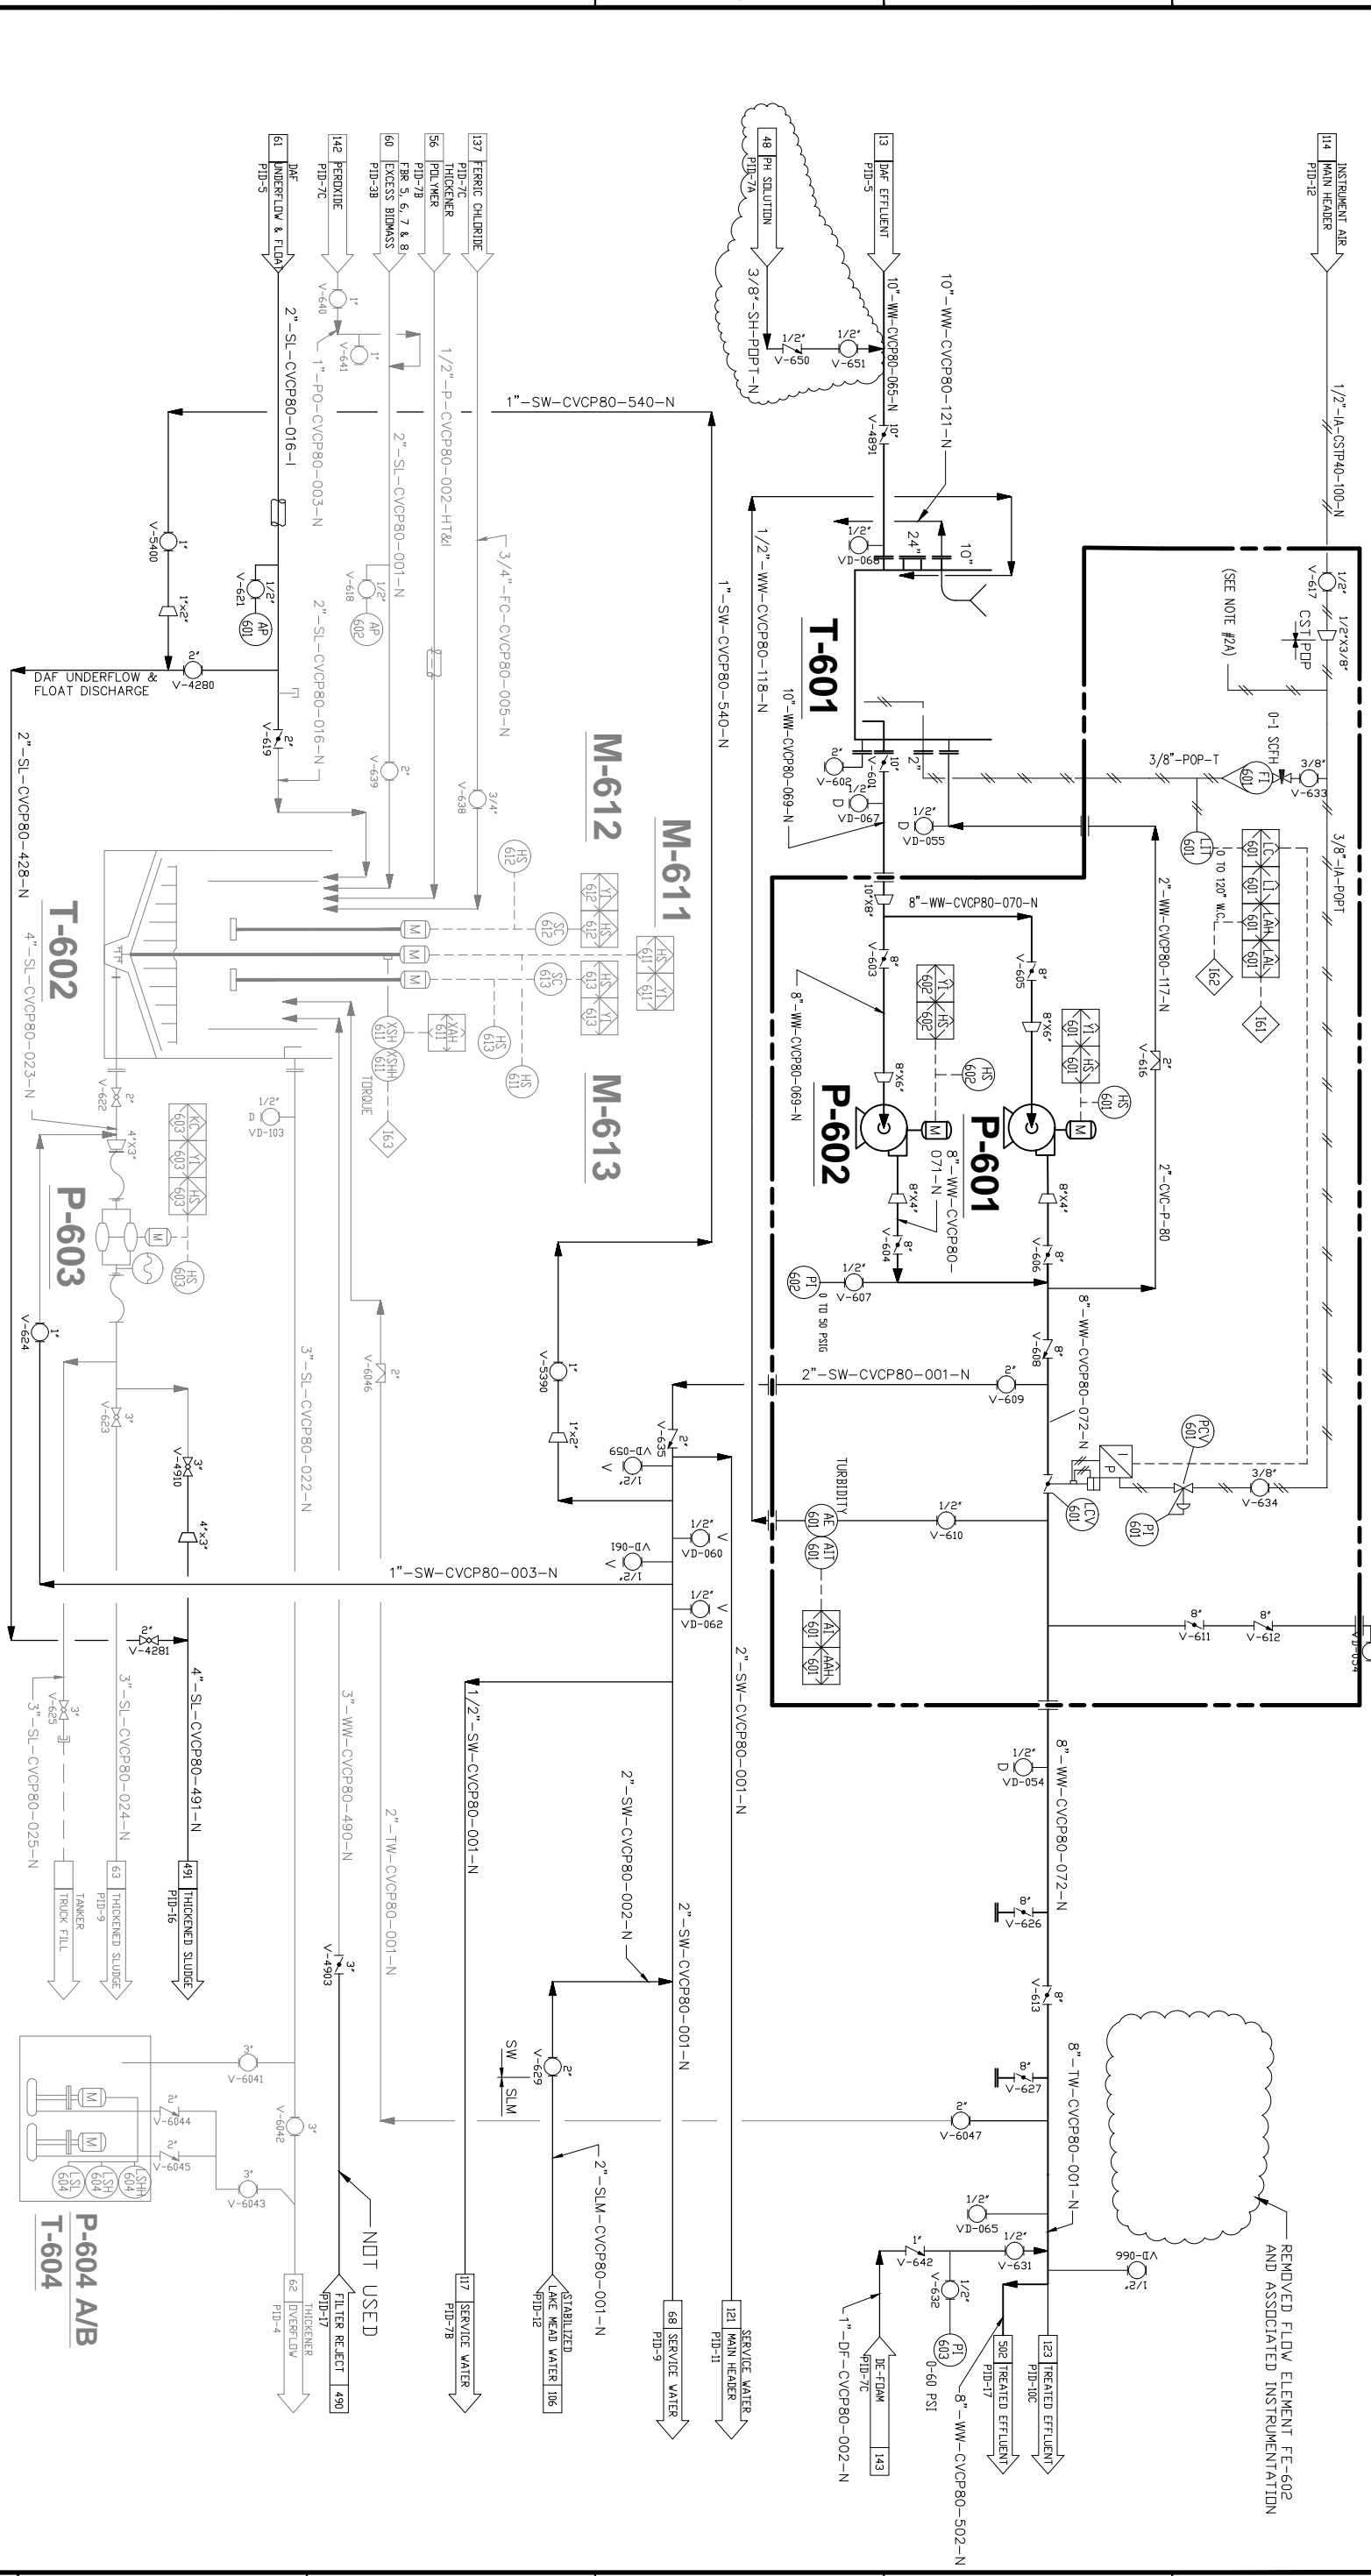

ITEM	DESCRIPTION	SIZE	MATERIAL	MANUFACTURER	MODEL	NOTES
T-601	EFFLUENT TANK	14' DIA x 13' STR	316 SS	WETTED MAT'L	NEPRENE	
T-602	THICKENER	30' DIA x 13' STR	316 SS	WETTED MAT'L	NEPRENE	
P-601/602	EFFLUENT PUMPS	TYPE: HORIZONTAL CENTRIFUGAL	316 SS	WETTED MAT'L	NEPRENE	
P-603	THICKENER UNDERFLOW PUMP	TYPE: ELECTRIC DIAPHRAGM	316 SS	WETTED MAT'L	NEPRENE	
M-611	SCRAPER/RAKE	TYPE: HORIZONTAL CENTRIFUGAL	316 SS	WETTED MAT'L	NEPRENE	
M-612/613	FLOCCULATION MIXERS	TYPE: SUBMERGIBLE	316 SS	WETTED MAT'L	NEPRENE	
P-604 A/B	SUMP PUMP	TYPE: SUBMERGIBLE	316 SS	WETTED MAT'L	NEPRENE	

U.S. PATENTS 5750028, 5788842, 6706521 AND PATENTS PENDING.

ENVIROGEN
 TECHNOLOGIES
 250 PHILLIPS BLVD SUITE 255
 ERINGEN, ND 58818

A Lifecycle Performance Company
 A member of The French Group


REVISIONS:

NO.	DATE	DESCRIPTION OF REVISION
1	11-15-13	RECORD DRAWING - REVISED FOR 2013 CONCRETE OPERATIONS & REVISIONS
2	3-28-16	ADDED NOTE TO DISABLE FT-402
3	4-28-16	REVISED FOR CONSTRUCTION
4	12-27-16	REVISED FOR CONSTRUCTION

DESIGNED BY: NERT
 CHECKED BY: NERT
 DRAWN BY: NERT
 DATE: 01-04-03

PROJECT: 1373-PID06

M-753A MICRONUTRIENT TANK AGITATOR MOTOR: 1/3 HP, 120V	M-757 AGITATOR MOTOR MOTOR: 1/5 HP, 0.5 AMP	P-758A/B FERRIC CHLORIDE PUMP TYPE: PERISTALTIC PUMP WETTED MAT'L: PTFE, PVDF, CS3X PEROXIDE CAPACITY: 3-65 GPD @ 25 PSI MOTOR: 1/50 HP, 1/60 MFR: MASTERFLEX	P-754 PEROXIDE TANK	P-754A/B PEROXIDE PUMP TYPE: PERISTALTIC PUMP WETTED MAT'L: PTFE, PVDF, CS3X PEROXIDE CAPACITY: 3-65 GPD @ 25 PSI MOTOR: 1/50 HP, 1/60 MFR: MASTERFLEX	T-755 A/B DE-FOAM TANK TYPE: BRJM CAPACITY: 55 GAL. EST USE: 6 GPD AVG.	M-756 DUST FILTER	M-753 BIN ACTIVATOR	M-754 VOLUMETRIC FEEDER	M-755 SCREW CONVEYOR
T-751 FERRIC CHLORIDE STORAGE TANK SIZE: 10'-2" DIA. X 9'-10" STR. MATS.: CROSS LINKED POLYETHYLENE CAPACITY: 4400 GAL (INNER) TYPE: DBL. WALL CONFINEMENT MODEL: FBLVAD0351N0	T-752 HYDRATED LIME STORAGE SILO SIZE: 12' DIA. X 28' H CAPACITY: 1500 CU. FT. MATS.: PAINTED STEEL	T-753 MICRO NUTRIENT TANK TYPE: TOTE CAPACITY: 400 GAL. MATS.: S.S. MOTOR: 110 V	T-754 PEROXIDE TANK	P-754A/B PEROXIDE PUMP TYPE: PERISTALTIC PUMP WETTED MAT'L: CERAMIC, PVC CAPACITY: 167 GAL./HR MOTOR: 1/30 HP, 1/40 MFR: STEINER	M-755A/B DE-FOAM PUMP TYPE: PERISTALTIC PUMP WETTED MAT'L: CERAMIC, PVC CAPACITY: 3-65 GPD @ 25 PSI MOTOR: 1/50 HP, 1/60 MFR: MASTERFLEX	M-753 BIN ACTIVATOR MATS.: STEEL MOTOR: 1.5 HP, 460V, 3 PH	M-754 VOLUMETRIC FEEDER CAPACITY: 48 CU. FT./HR MATS.: S.S. TERLON MOTOR: 1.0 HP, 90V MFR: FLEXIDON HOPPER CAPACITY: 28 CU. FT.	M-755 SCREW CONVEYOR TYPE: FLEXIBLE SREW CAPACITY: 40-50 CU. FT./HR MOTOR: 3.0 HP, 460V, 3 PH	

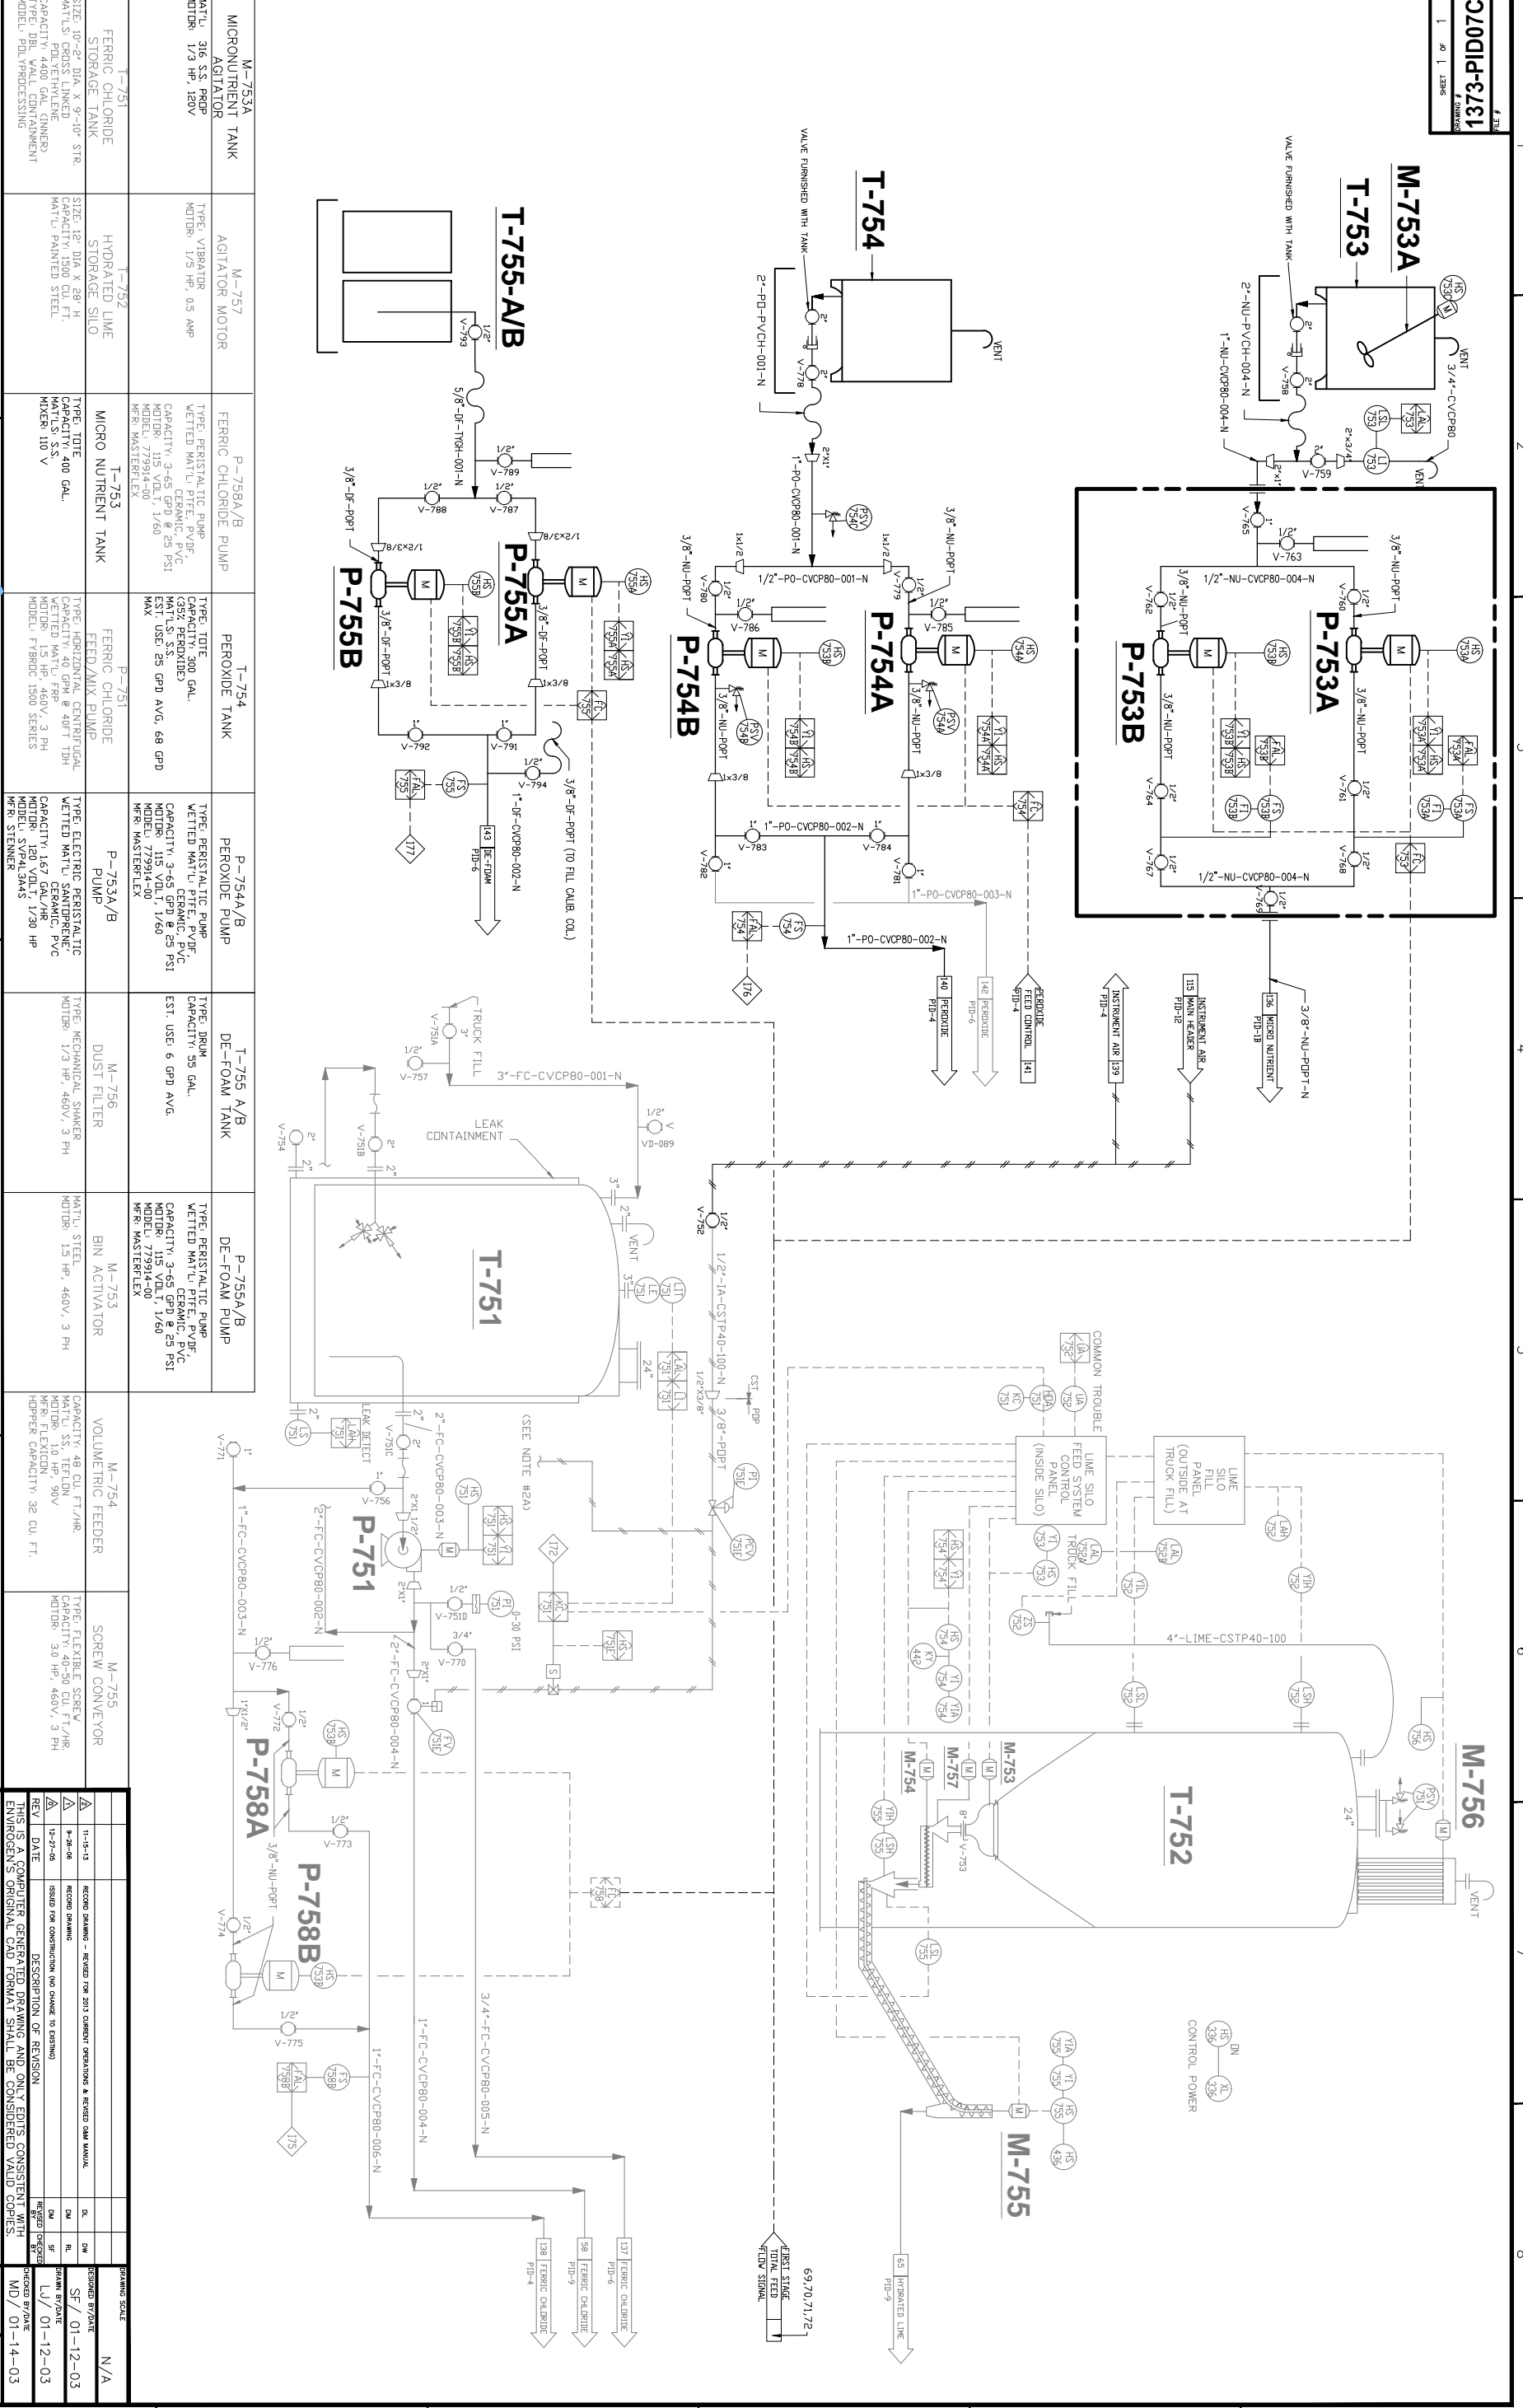


REVISIONS	DATE	DESCRIPTION OF REVISION	BY	CHKD
1	11-15-13	RECORD DRAWING - REVISION FOR 2013 CURRENT OPERATIONS & REVISION O&M MANUAL	D	D
2	9-26-06	ISSUED FOR CONSTRUCTION (NO CHANGE TO EXISTING)	DM	DM
3	12-27-05	ISSUED FOR CONSTRUCTION (NO CHANGE TO EXISTING)	DM	DM
4				
5				
6				
7				
8				

DATE	11/14/13
BY	DLEZCH
CHKD	DM
APPV	DM
SCALE	N/A
SHEET NO.	2
TITLE	PIPING & INSTRUMENTATION DIAGRAM FLUIDIZED BED PERCHLORATE TREATMENT SYSTEM
PROJECT NO.	1373-PID07C
REVISIONS	2

U.S. PATENTS 5750028, 5788842, 6706521 AND PATENTS PENDING.
 ENVIROGEN TECHNOLOGIES
 250 PHILLIPS BLVD. SUITE 255
 EVINGTON, NJ 08018
 A Lifecycle Performance Company
 Member of The American Group

COMPRESSOR 801

COMPRESSOR 802

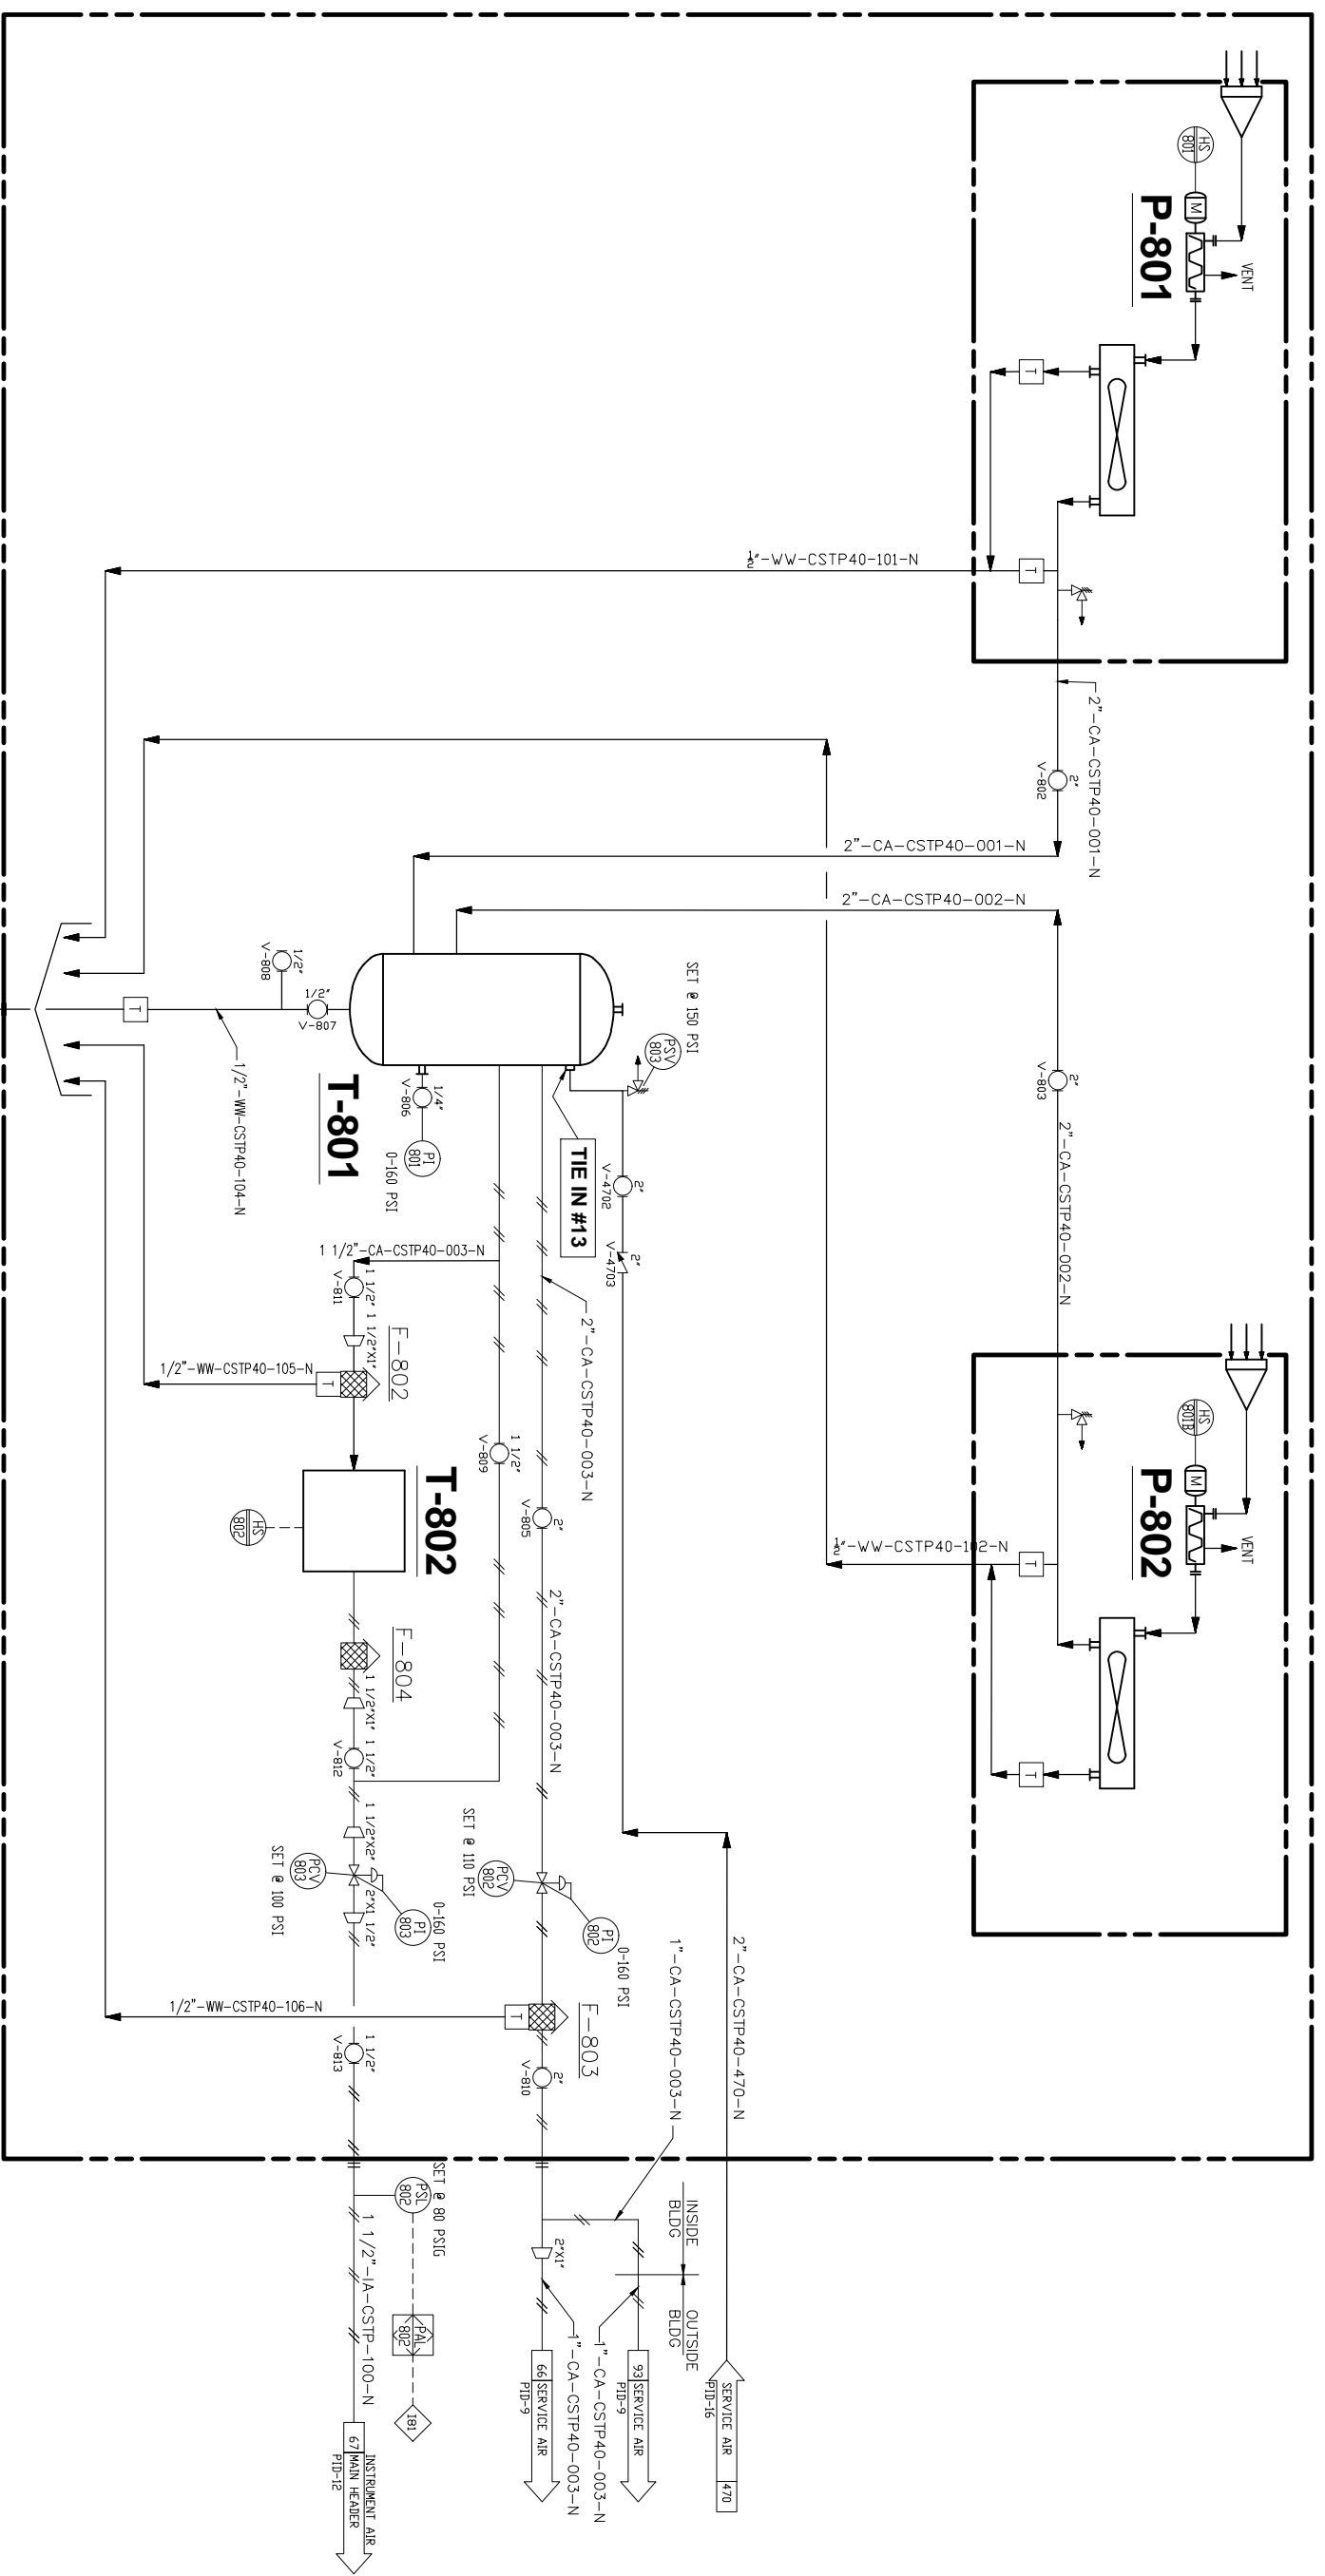


COMPRESSED AIR ASSEMBLY

COMPRESSOR 801	COMPRESSOR 802	COMPRESSOR 801	COMPRESSOR 802	COMPRESSOR 801	COMPRESSOR 802
T-801	T-802	P-801	P-802	F-802 & F-803	F-804
COMPRESSED AIR RECEIVER TANK	INSTRUMENT AIR DRYER	AIR COMPRESSORS	AIR COMPRESSORS	OIL REMOVAL FILTER	PARTICULATE FILTER
SIZE: 36"OD X 120"HT MATERIALS: PAINTED STEEL CAPACITY: 430 GAL MAX. PRESS: 137 PSIG	TYPE: REGEN. DESICCANT DRYER INLET FLOW: 160 SCFM PURGE RATE: 238 SCFM POWER: 15VAC, 1Ø	CAPACITY: 215 CFM @ 125 PSIG TYPE: ROTARY SCREW MOTOR: 50HP, 460VAC, 3Ø MODEL: INFRASULT R4ND	CAPACITY: 215 CFM @ 125 PSIG TYPE: ROTARY SCREW MOTOR: 50HP, 460VAC, 3Ø MODEL: INFRASULT R4ND	LIQUID REMOVAL: 99.99% DIL. MAX. LIQ. LOAD: 100 PPM W/W SOLID PARTICLE: .01 MICRONS PRESS. DROP: 2 PSIG (VFD) CAPACITY: 275 CFM @ 100 PSIG MODEL: IR6P275	LIQUID REMOVAL: 100% WATER MAX. LIQ. LOAD: 2,000 PPM W/W SOLID PARTICLE: 1 MICRONS PRESS. DROP: 2 PSIG (VFD) CAPACITY: 275 CFM @ 100 PSIG MODEL: IR6P275

U.S. PATENTS 5750028, 5788842, 6706521 AND PATENTS PENDING.	ENVIROGEN TECHNOLOGIES 250 PHILLIPS BLVD. SUITE 255 EVING, IN 46018	A Lifecycle Performance Company
---	---	---------------------------------

REV.	DATE	DESCRIPTION OF REVISION	REVISION
1	11-15-13	RECORD DRAWING - REVISED FOR 2013 CURRENT OPERATIONS & RECORD DATA MANUAL	DM
2	9-26-06	RECORD DRAWING	DM
3	4-26-06	ISSUED FOR CONSTRUCTION	EX
4	12-27-05	ISSUED FOR CONSTRUCTION	DM

THIS IS A COMPUTER GENERATED DRAWING AND ONLY EDITS CONSISTENT WITH ENVIROGEN'S ORIGINAL CAD FORMAT SHALL BE CONSIDERED VALID COPIES.	NEPT HENDERSON, NV
PIPING & INSTRUMENTATION DIAGRAM FLUIDIZED BED PERCHLORATE TREATMENT SYSTEM	PIPING & INSTRUMENTATION DIAGRAM FLUIDIZED BED PERCHLORATE TREATMENT SYSTEM
FORMING SCALE N/A	FORMING SCALE N/A
SHEET # 1373-PID08	SHEET # 1373-PID08
SHEET SIZE 15" x 26"	SHEET SIZE 15" x 26"
REVISION 3	REVISION 3

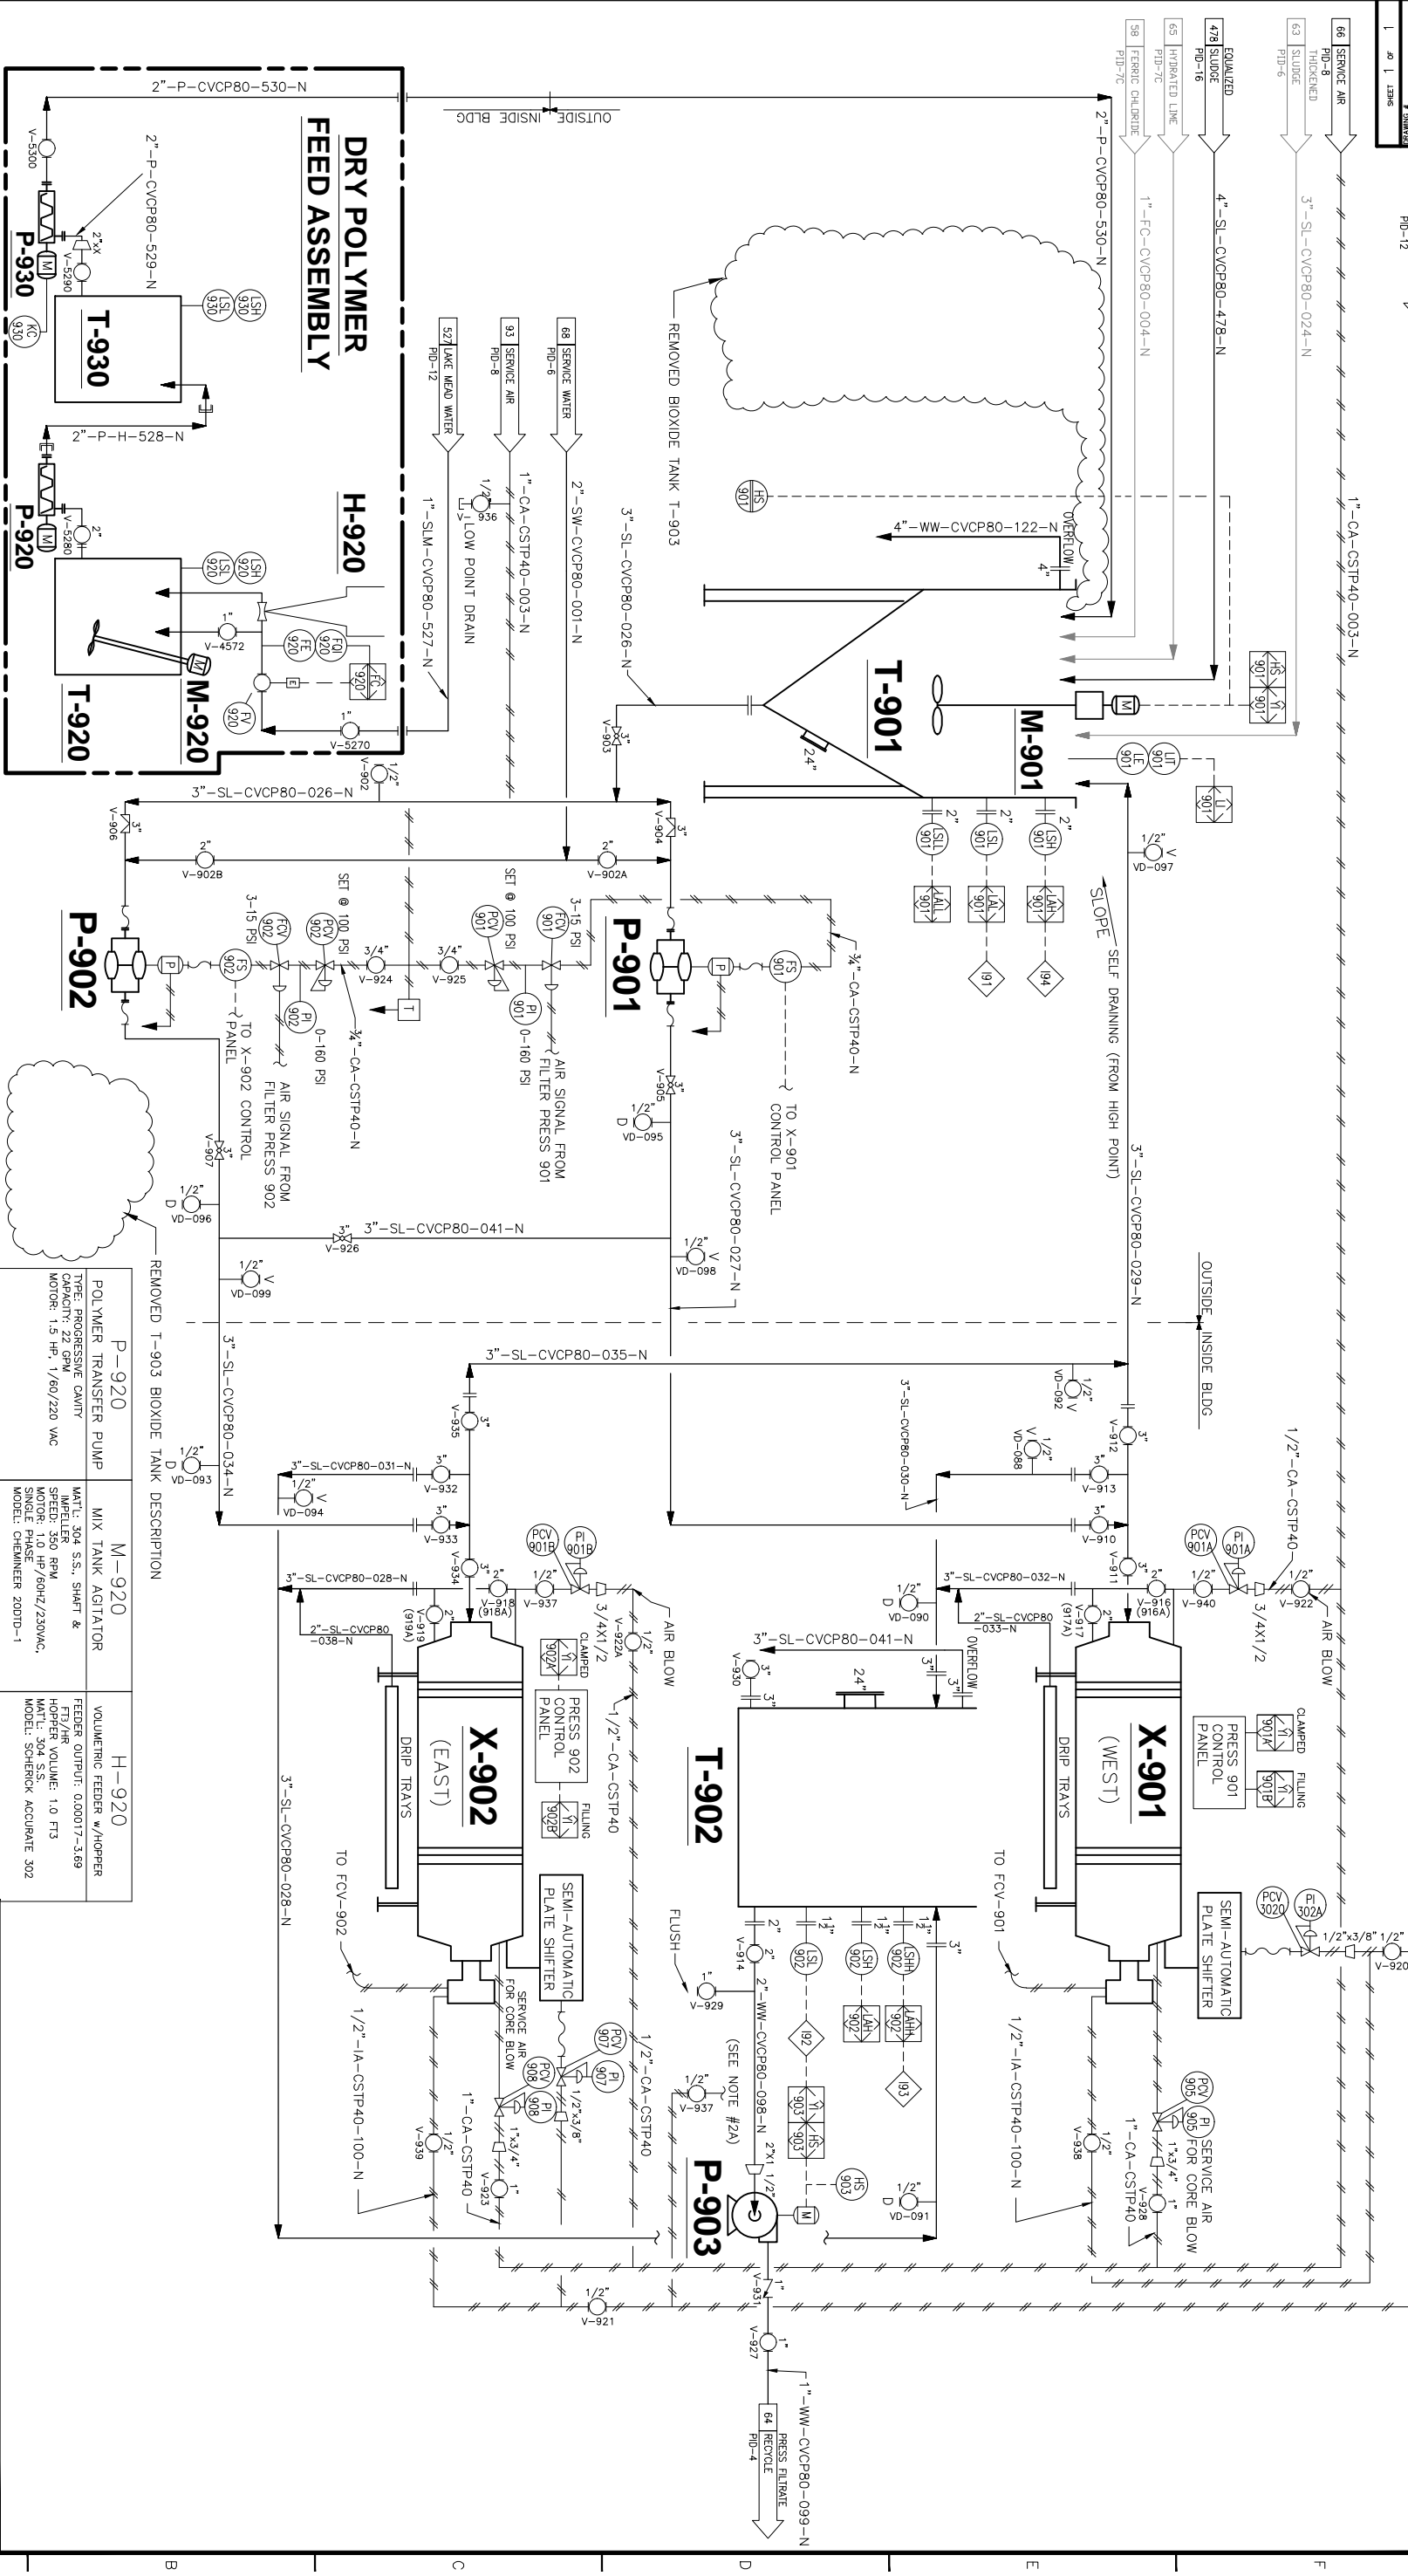

Equipment	Model	Type	Capacity	Material	Notes
Conditioning Tank	T-901	Conditioning Tank	14' DIA. X 9.5' STR.	FRP	
Conditioning Tank Agitator	M-901	Axial Flow Impeller	45 RPM	FRP	
Press Feed Pumps	P-901, 902	Air Operated Diaphragm	150 GPM @ 40 PSI	FRP	
Filtrate Tank	T-902	Filtrate Tank	14' DIA. X 8' STR.	FRP	
Filtrate Recycle Pump	P-903	Centrifugal	20 GPM @ 48 TH	FRP	
Filter Press	X-901, 902	Plate & Frame	80 CU. FT.	FRP	
Polymer Mix Tank	T-920	Polyethylene	275 GAL	FRP	
Polymer Application Tank	T-930	Polyethylene	275 GAL	FRP	
Polymer Feed Pump	P-930	Progressive Cavity	0.5-5 GPM	FRP	
Mix Tank Agitator	M-920	Volumetric Feeder w/Hopper	350 RPM	FRP	
Feeders	H-920	Progressive Cavity	0.00017-3.69 FT ³ /HR	FRP	

U.S. PATENTS 5750028, 5788842, 6706521 AND PATENTS PENDING.

ENVIROGEN TECHNOLOGIES
250 PHILLIPS BLVD. SUITE 255
ENHNS, NJ 08818

A Lifecycle Performance Company

ALL INFORMATION CONTAINED ON THIS DOCUMENT IS THE PROPERTY OF ENVIROGEN TECHNOLOGIES, INC. (ENVIROGEN) AND/OR ITS AFFILIATES. THE DESIGN CONCEPTS AND INFORMATION CONTAINED HEREIN ARE PROPERTY OF ENVIROGEN AND ARE SUBMITTED IN CONFIDENCE. THEY ARE NOT TO BE REPRODUCED OR TRANSMITTED IN ANY FORM OR BY ANY MEANS, ELECTRONIC OR MECHANICAL, INCLUDING PHOTOCOPYING, RECORDING, OR BY ANY INFORMATION STORAGE AND RETRIEVAL SYSTEM, WITHOUT THE EXPRESS WRITTEN CONSENT OF ENVIROGEN. ENVIROGEN ASSUMES NO RESPONSIBILITY OR LIABILITY FOR THE USE OF THIS DOCUMENT OR THE DESIGN CONCEPTS CONTAINED HEREIN. THE USER OF THIS DOCUMENT SHALL BE RESPONSIBLE FOR OBTAINING ALL NECESSARY PERMITS AND APPROVALS FROM THE APPROPRIATE AGENCIES AND AGENCIES OF THE USER. THE USER SHALL BE RESPONSIBLE FOR OBTAINING ALL NECESSARY PERMITS AND APPROVALS FROM THE APPROPRIATE AGENCIES AND AGENCIES OF THE USER. THE USER SHALL BE RESPONSIBLE FOR OBTAINING ALL NECESSARY PERMITS AND APPROVALS FROM THE APPROPRIATE AGENCIES AND AGENCIES OF THE USER. THE USER SHALL BE RESPONSIBLE FOR OBTAINING ALL NECESSARY PERMITS AND APPROVALS FROM THE APPROPRIATE AGENCIES AND AGENCIES OF THE USER.


REV.	DATE	DESCRIPTION OF REVISION	BY	CHK
1	11-14-13	RECORD DRAWING	DM	DM
2	6-14-16	ADDED PIPE INFORMATION	DM	DM
3	4-26-16	REVISED FOR CONSTRUCTION	DM	DM
4	12-27-16	ISSUED FOR CONSTRUCTION	DM	DM

THIS IS A COMPUTER GENERATED DRAWING AND ONLY EDITS CONSISTENT WITH ENVIROGEN'S ORIGINAL CAD FORMAT SHALL BE CONSIDERED VALID COPIES.

PIPING & INSTRUMENTATION DIAGRAM
FLUIDIZED BED PERCHLORATE
TREATMENT SYSTEM

HENDERSON, NJ

Sheet 16 of 26
1373-PID09

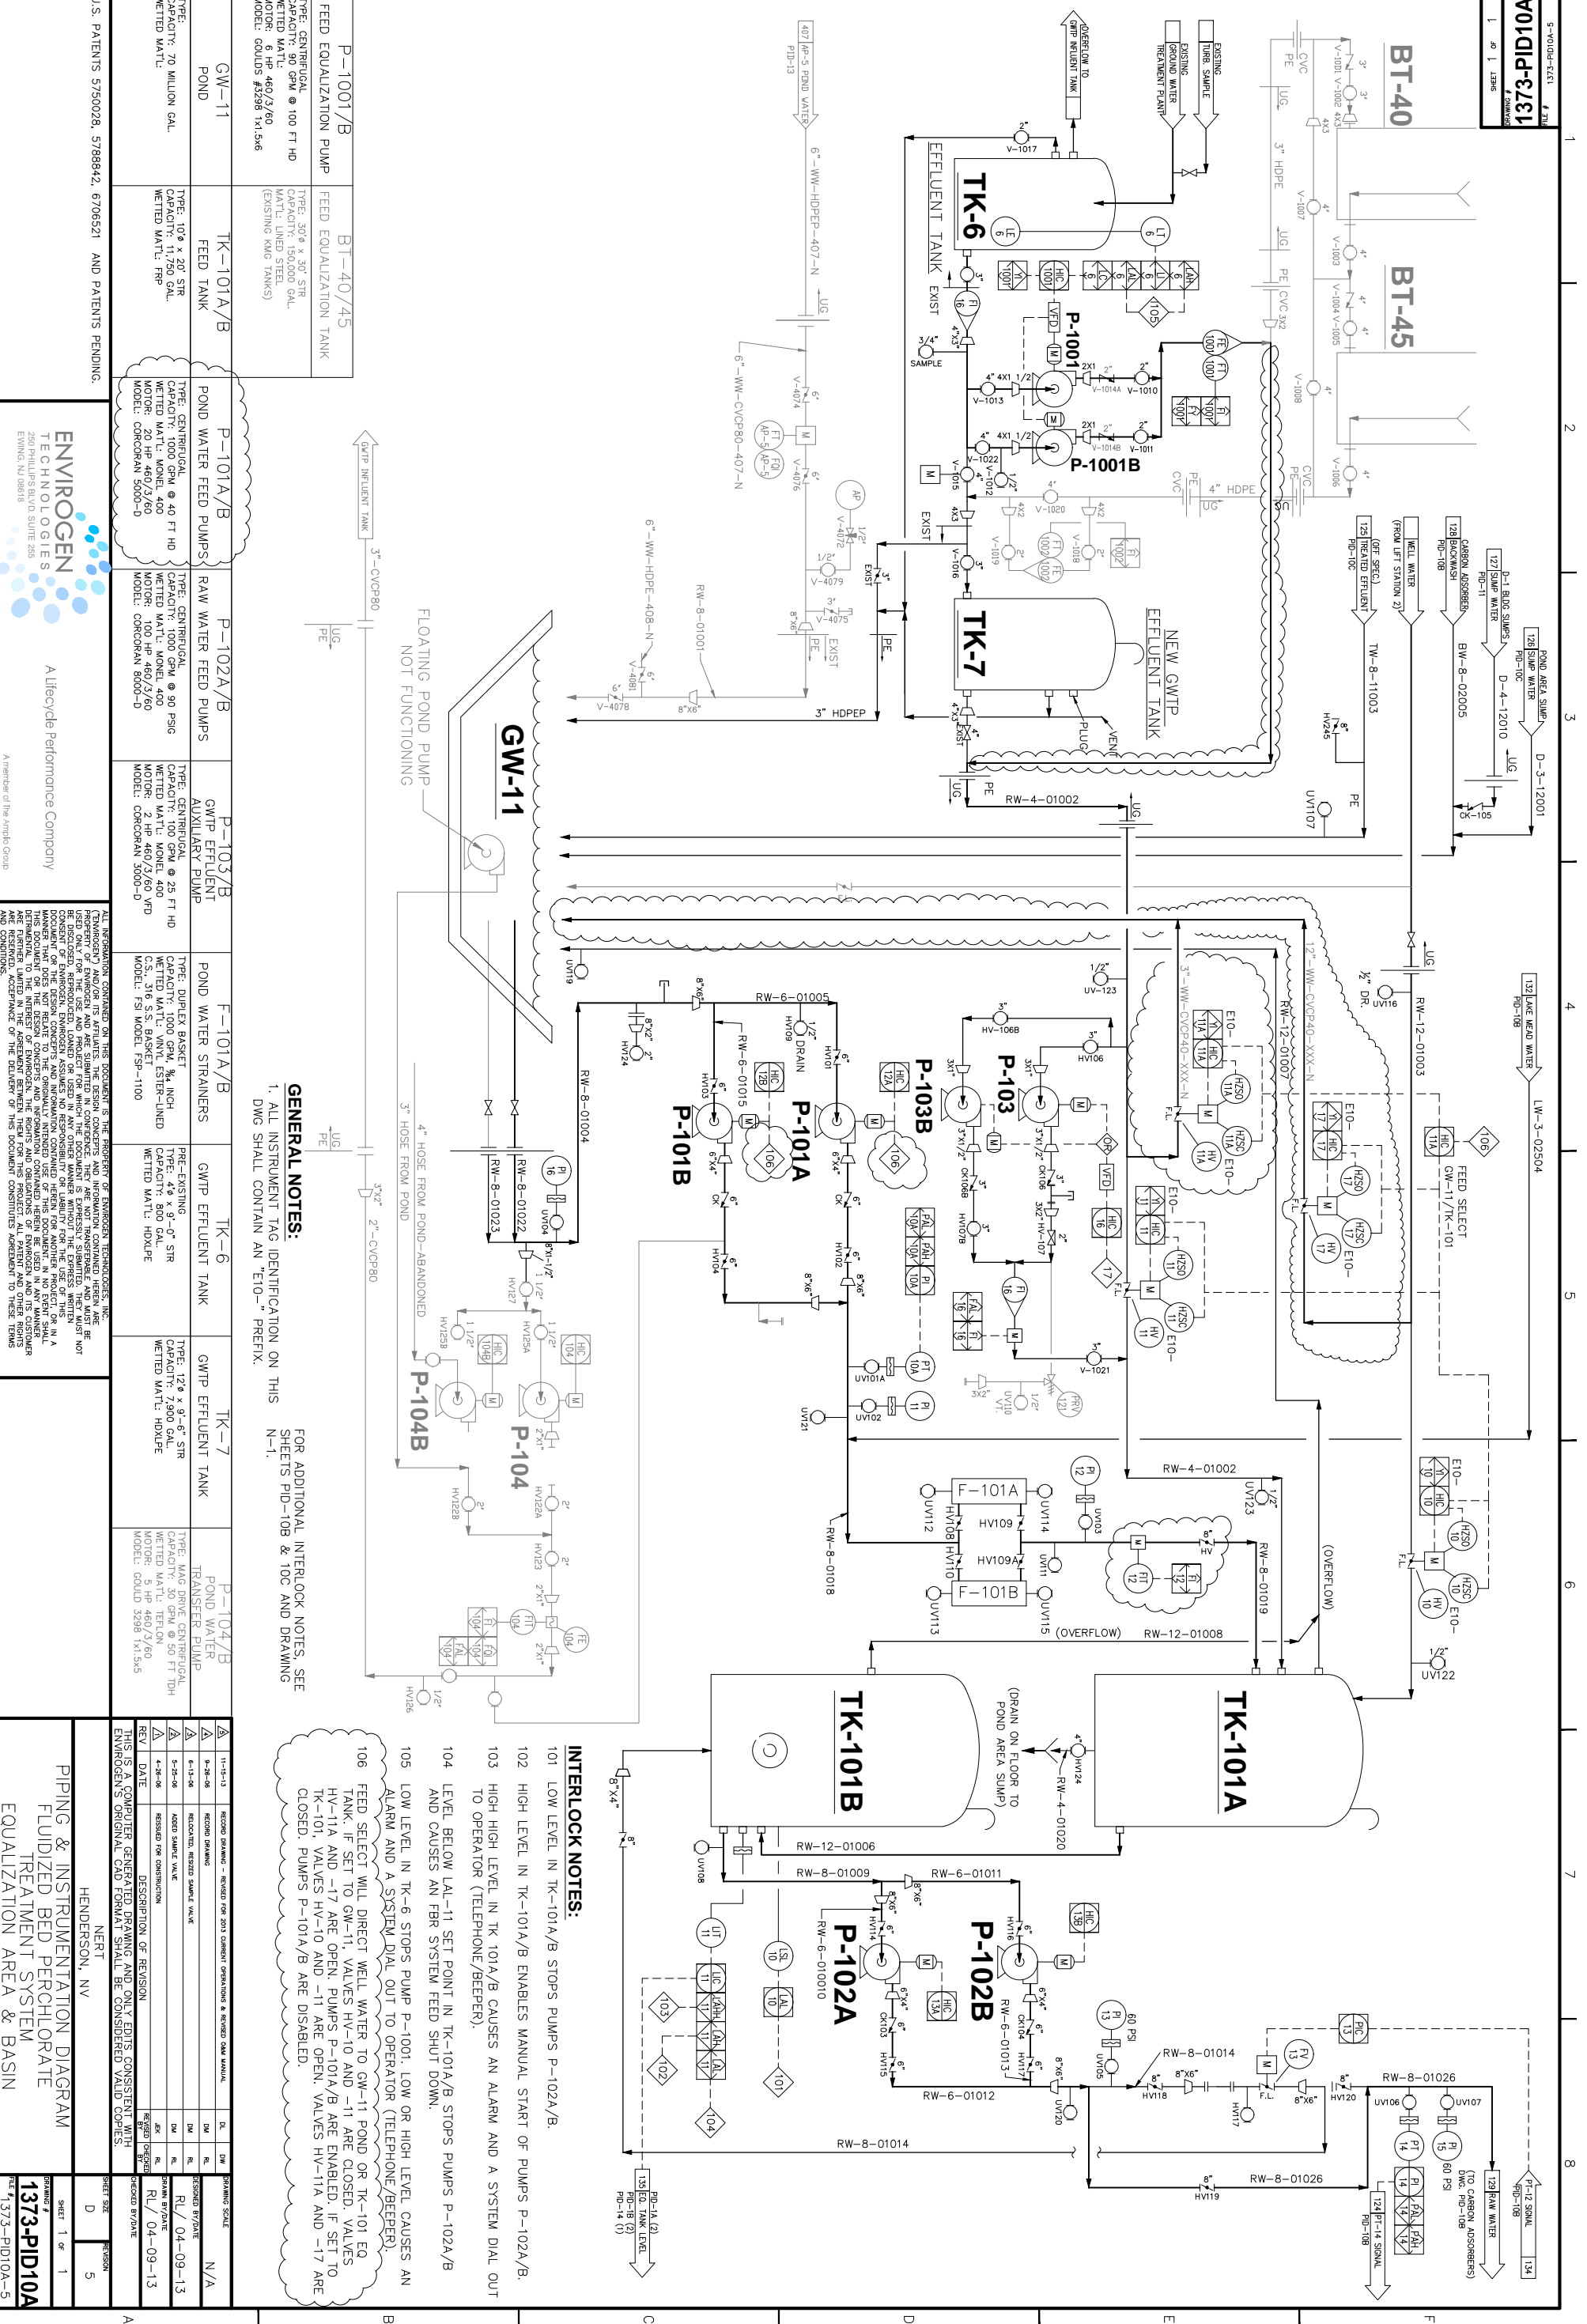

GENERAL NOTES:
 1. ALL INSTRUMENT TAG IDENTIFICATION ON THIS SHEET SHALL CONTAIN AN E10- PREFIX.

FOR ADDITIONAL INTERLOCK NOTES, SEE SHEETS PID-108 & 10C AND DRAWING N-1.

INTERLOCK NOTES:

- 101 LOW LEVEL IN TK-101A/B STOPS PUMPS P-102A/B.
- 102 HIGH LEVEL IN TK-101A/B ENABLES MANUAL START OF PUMPS P-102A/B.
- 103 HIGH LEVEL IN TK-101A/B CAUSES AN ALARM AND A SYSTEM DIAL OUT TO OPERATOR (TELEPHONE/BEEPER).
- 104 LEVEL BELOW LAI-11 SET POINT IN TK-101A/B STOPS PUMPS P-102A/B AND CAUSES AN FBR SYSTEM FEED SHUT DOWN.
- 105 LOW LEVEL IN TK-6 STOPS PUMP P-1001. LOW OR HIGH LEVEL CAUSES AN ALARM AND A SYSTEM DIAL OUT TO OPERATOR (TELEPHONE/BEEPER).
- 106 FEED SELECT WILL DIRECT WELL WATER TO GW-11 POND OR TK-101 EQ TANK. IF SET TO GW-11, VALVES HV-10 AND -11 ARE CLOSED. VALVES HV-11A AND -17 ARE OPEN. PUMPS P-101A/B ARE ENABLED. IF SET TO TK-101, VALVES HV-10 AND -11 ARE OPEN. VALVES HV-11A AND -17 ARE CLOSED. PUMPS P-101A/B ARE DISABLED.

TYPE:	DESCRIPTION	TYPE:	DESCRIPTION
P-1001/B	FEED EQUALIZATION PUMP	BT-40/45	FEED EQUALIZATION TANK
TYPE: CENTRIFUGAL	CAPACITY: 90 GPM @ 100 FT HD	TYPE: 30" x 30" STR	CAPACITY: 156,000 GAL (EXISTING KMG TANKS)
WETTED MATL: WETTED MATL	MOTOR: 6 HP 460/3/60	MODEL: G00LDS #5298 1x1.5x6	
GW-11	POND	TK-101A/B	FEED TANK
TYPE: CENTRIFUGAL	CAPACITY: 1000 GPM @ 40 FT HD	TYPE: CENTRIFUGAL	CAPACITY: 11,750 GAL
WETTED MATL: WETTED MATL	MOTOR: 20 HP 460/3/60	MODEL: CORCORAN 5000-D	
P-101A/B	RAW WATER FEED PUMPS	P-102A/B	RAW WATER FEED PUMPS
TYPE: CENTRIFUGAL	CAPACITY: 1000 GPM @ 90 PSIG	TYPE: CENTRIFUGAL	CAPACITY: 1000 GPM @ 90 PSIG
WETTED MATL: WETTED MATL	MOTOR: 100 HP 460/3/60	MODEL: CORCORAN 8000-D	
P-103/B	GWTP EFFLUENT AUXILIARY PUMP	F-101A/B	POND WATER STRAINERS
TYPE: CENTRIFUGAL	CAPACITY: 100 GPM @ 25 FT HD	TYPE: DUPLEX BASKET	CAPACITY: 1000 GPM, 3/4" INCH
WETTED MATL: WETTED MATL	MOTOR: 2 HP 460/3/60	MODEL: FSI MODEL FSP-1100	
TK-6	GWTP EFFLUENT TANK	TK-7	GWTP EFFLUENT TANK
TYPE: EXISTING	CAPACITY: 4.9 x 9'-0" STR	TYPE: 12'4" x 9'-6" STR	CAPACITY: 7900 GAL
WETTED MATL: HDLIFE		WETTED MATL: HDLIFE	
P-104/B	POND WATER TRANSFER PUMP	P-104	POND WATER TRANSFER PUMP
TYPE: MAG DRIVE CENTRIFUGAL	CAPACITY: 30 GPM @ 50 FT TDH	TYPE: MAG DRIVE CENTRIFUGAL	CAPACITY: 30 GPM @ 50 FT TDH
WETTED MATL: WETTED MATL	MOTOR: 5 HP 460/3/60	MODEL: G00LD 3298 1x1.5x5	

REV	DATE	DESCRIPTION OF REVISION	BY	CHK	APP
1	11-15-13	RECORD DRAWING - REVISION FOR 2013 CURRENT OPERATIONS & REVISED DATA VALUES			
2	6-13-10	RECALCULATED, REVISED SOURCE VALUE			
3	5-25-06	ADDED SOURCE VALUE			
4	4-28-06	REVISION FOR CONSTRUCTION			

THIS IS A COMPUTER GENERATED DRAWING AND ONLY V EDITS CONSISTENT WITH ENVIROGEN'S ORIGINAL CAD FORMAT SHALL BE CONSIDERED VALID COPIES.


NEPT
 HENDERSON, NV

PIPING & INSTRUMENTATION DIAGRAM
 FLUIDIZED BED PERCOLATE
 TREATMENT SYSTEM
 EQUALIZATION AREA & BASIN

SHEET SIZE: D
 SHEET: 1 OF 1
 REVISION: 5

1373-PID10A
 1373-PID10A-5



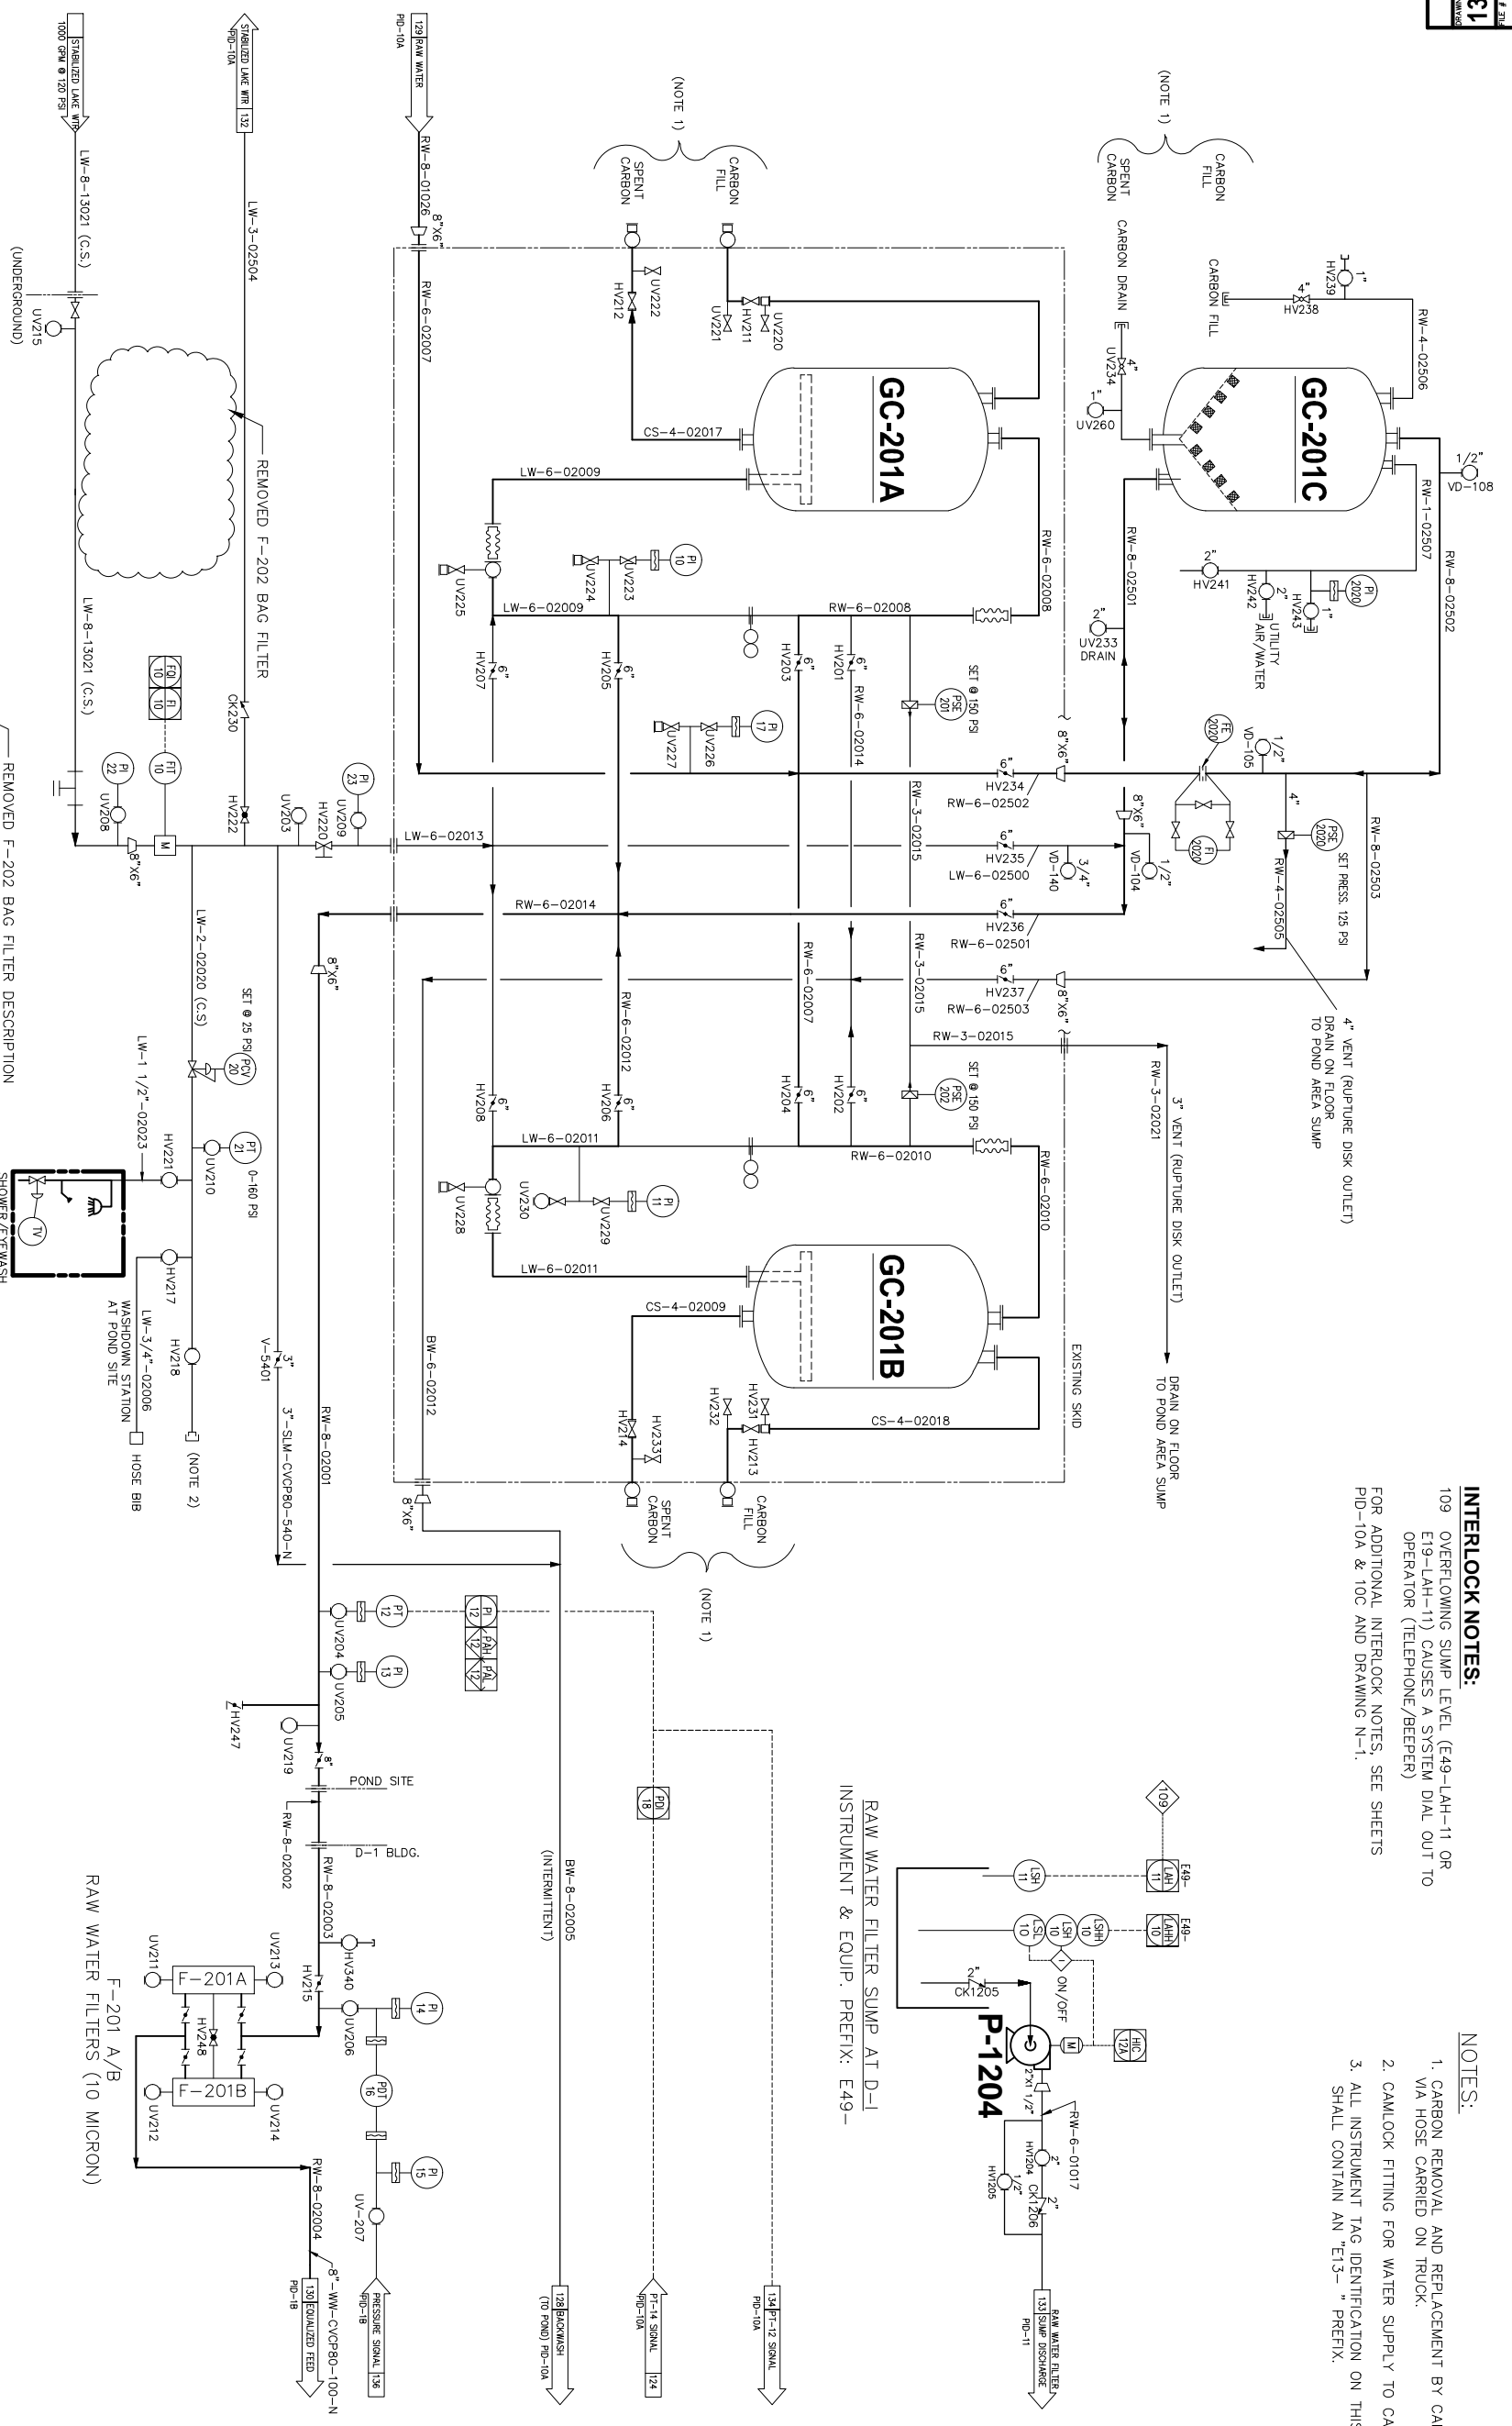

INTERLOCK NOTES:
 109 OVERFLOWING SUMP LEVEL (E49-LAH-11 OR E19-LAH-11) CAUSES A SYSTEM DIAL OUT TO OPERATOR (TELEPHONE/BEEPER)
 FOR ADDITIONAL INTERLOCK NOTES, SEE SHEETS PID-10A & 10C AND DRAWING N-1.

NOTES:
 1. CARBON REMOVAL AND REPLACEMENT BY CARBON TRUCK VIA HOSE CARRIED ON TRUCK.
 2. CAMLOCK FITTING FOR WATER SUPPLY TO CARBON TRUCK.
 3. ALL INSTRUMENT TAG IDENTIFICATION ON THIS DWG SHALL CONTAIN AN "E13-" PREFIX.

EXISTING CARBON FILTERS	NEW CARBON FILTER	RAW WATER FILTERS
GC-201A/B TYPE: 10" CAPACITY: 20,000 LB GAC WETTED MAT'L: CS WITH PLASTIC LINING MODEL: CALORON MODEL: 10	GC-201C TYPE: GAC CAPACITY: 1,500 GPM @ 125 PSIG WETTED MAT'L: PLASTIC LINED C.S. POLYPROPYLENE LINED DRAIN MODEL: PARKER/MESSTAS HP1020	F-201A/B TYPE: RUPREX CAPACITY: 1,000 GPM WETTED MAT'L: 316SS W/ POLYPROPYLENE CARTRIDGES MODEL: PARKER MODEL: 6SS2-3-8 FN-1A

U.S. PATENTS 5750028, 5788842, 6706521 AND PATENTS PENDING.
 THIS DRAWING IS A VISUAL REPRESENTATION OF THE EQUIPMENT AND/OR SYSTEM PROPOSED. IT IS NOT INTENDED FOR CONSTRUCTION PURPOSES.

ALL INFORMATION CONTAINED ON THIS DOCUMENT IS THE PROPERTY OF ENVROGEN TECHNOLOGIES, INC. ("ENVROGEN") AND/OR ITS AFFILIATES. THE DESIGN CONCEPTS AND INFORMATION CONTAINED HEREIN ARE HEREBY REPRODUCED, LOANED OR USED IN ANY OTHER MANNER WITHOUT THE EXPRESS WRITTEN CONSENT OF ENVROGEN. ENVROGEN ASSUMES NO RESPONSIBILITY OR LIABILITY FOR THE USE OF THIS DOCUMENT OR THE DESIGN CONCEPTS OR INFORMATION CONTAINED HEREIN. THE USER OF THIS DOCUMENT IN NO EVENT SHALL BE HELD LIABLE FOR THE RESULTS AND OPERATIONS OF ANY DESIGN OR OPERATION OF ANY EQUIPMENT OR SYSTEM WHICH IS THE RESULT OF THE DESIGN CONCEPTS OR INFORMATION CONTAINED HEREIN. THE USER OF THIS DOCUMENT AGREES TO HOLD ENVROGEN HARMLESS FROM AND AGAINST ALL CLAIMS, DAMAGES, LOSSES AND EXPENSES, INCLUDING REASONABLE ATTORNEY'S FEES, THAT MAY BE ASSERTED AGAINST ENVROGEN OR ITS AFFILIATES BY ANY PARTY AS A RESULT OF THE USER'S USE OF THIS DOCUMENT OR THE DESIGN CONCEPTS OR INFORMATION CONTAINED HEREIN.

RAW WATER FILTERS (10 MICRON)
 F-201 A/B
 WASHDOWN STATION AT POND SITE
 SHOWER/REWASH


REVISION	DATE	DESCRIPTION OF REVISION	BY	CHK	APP
1	11-14-13	RECORD DRAWING - REVISION FOR 2013 CAMLOCK OPERATIONS & REVISION DRAIN MANUAL	DM	RE	DM
2	9-26-06		DM	RE	DM
3	4-21-06	ISSUED FOR CONSTRUCTION, LINE 3"-SJM-540 WIPED FROM PID-10A	DM	RE	DM
4	12-27-05	ISSUED FOR CONSTRUCTION, NO CHANGE FROM DESIGN	DM	RE	DM

FORMING SCALE	REVISION
N/A	3

ENVROGEN TECHNOLOGIES
 250 PHILLIPS BLVD SUITE 255
 ENVIRO, NY 08818
 A Lifecycle Performance Company
 An American Company

PIPING & INSTRUMENTATION DIAGRAM
 EQUALIZATION AREA PIPING REVISIONS
 INCORPORATING GW-11
 AS EQUALIZATION BASIN

1373-PID10B
 SHEET 1 OF 1
 11/14/13

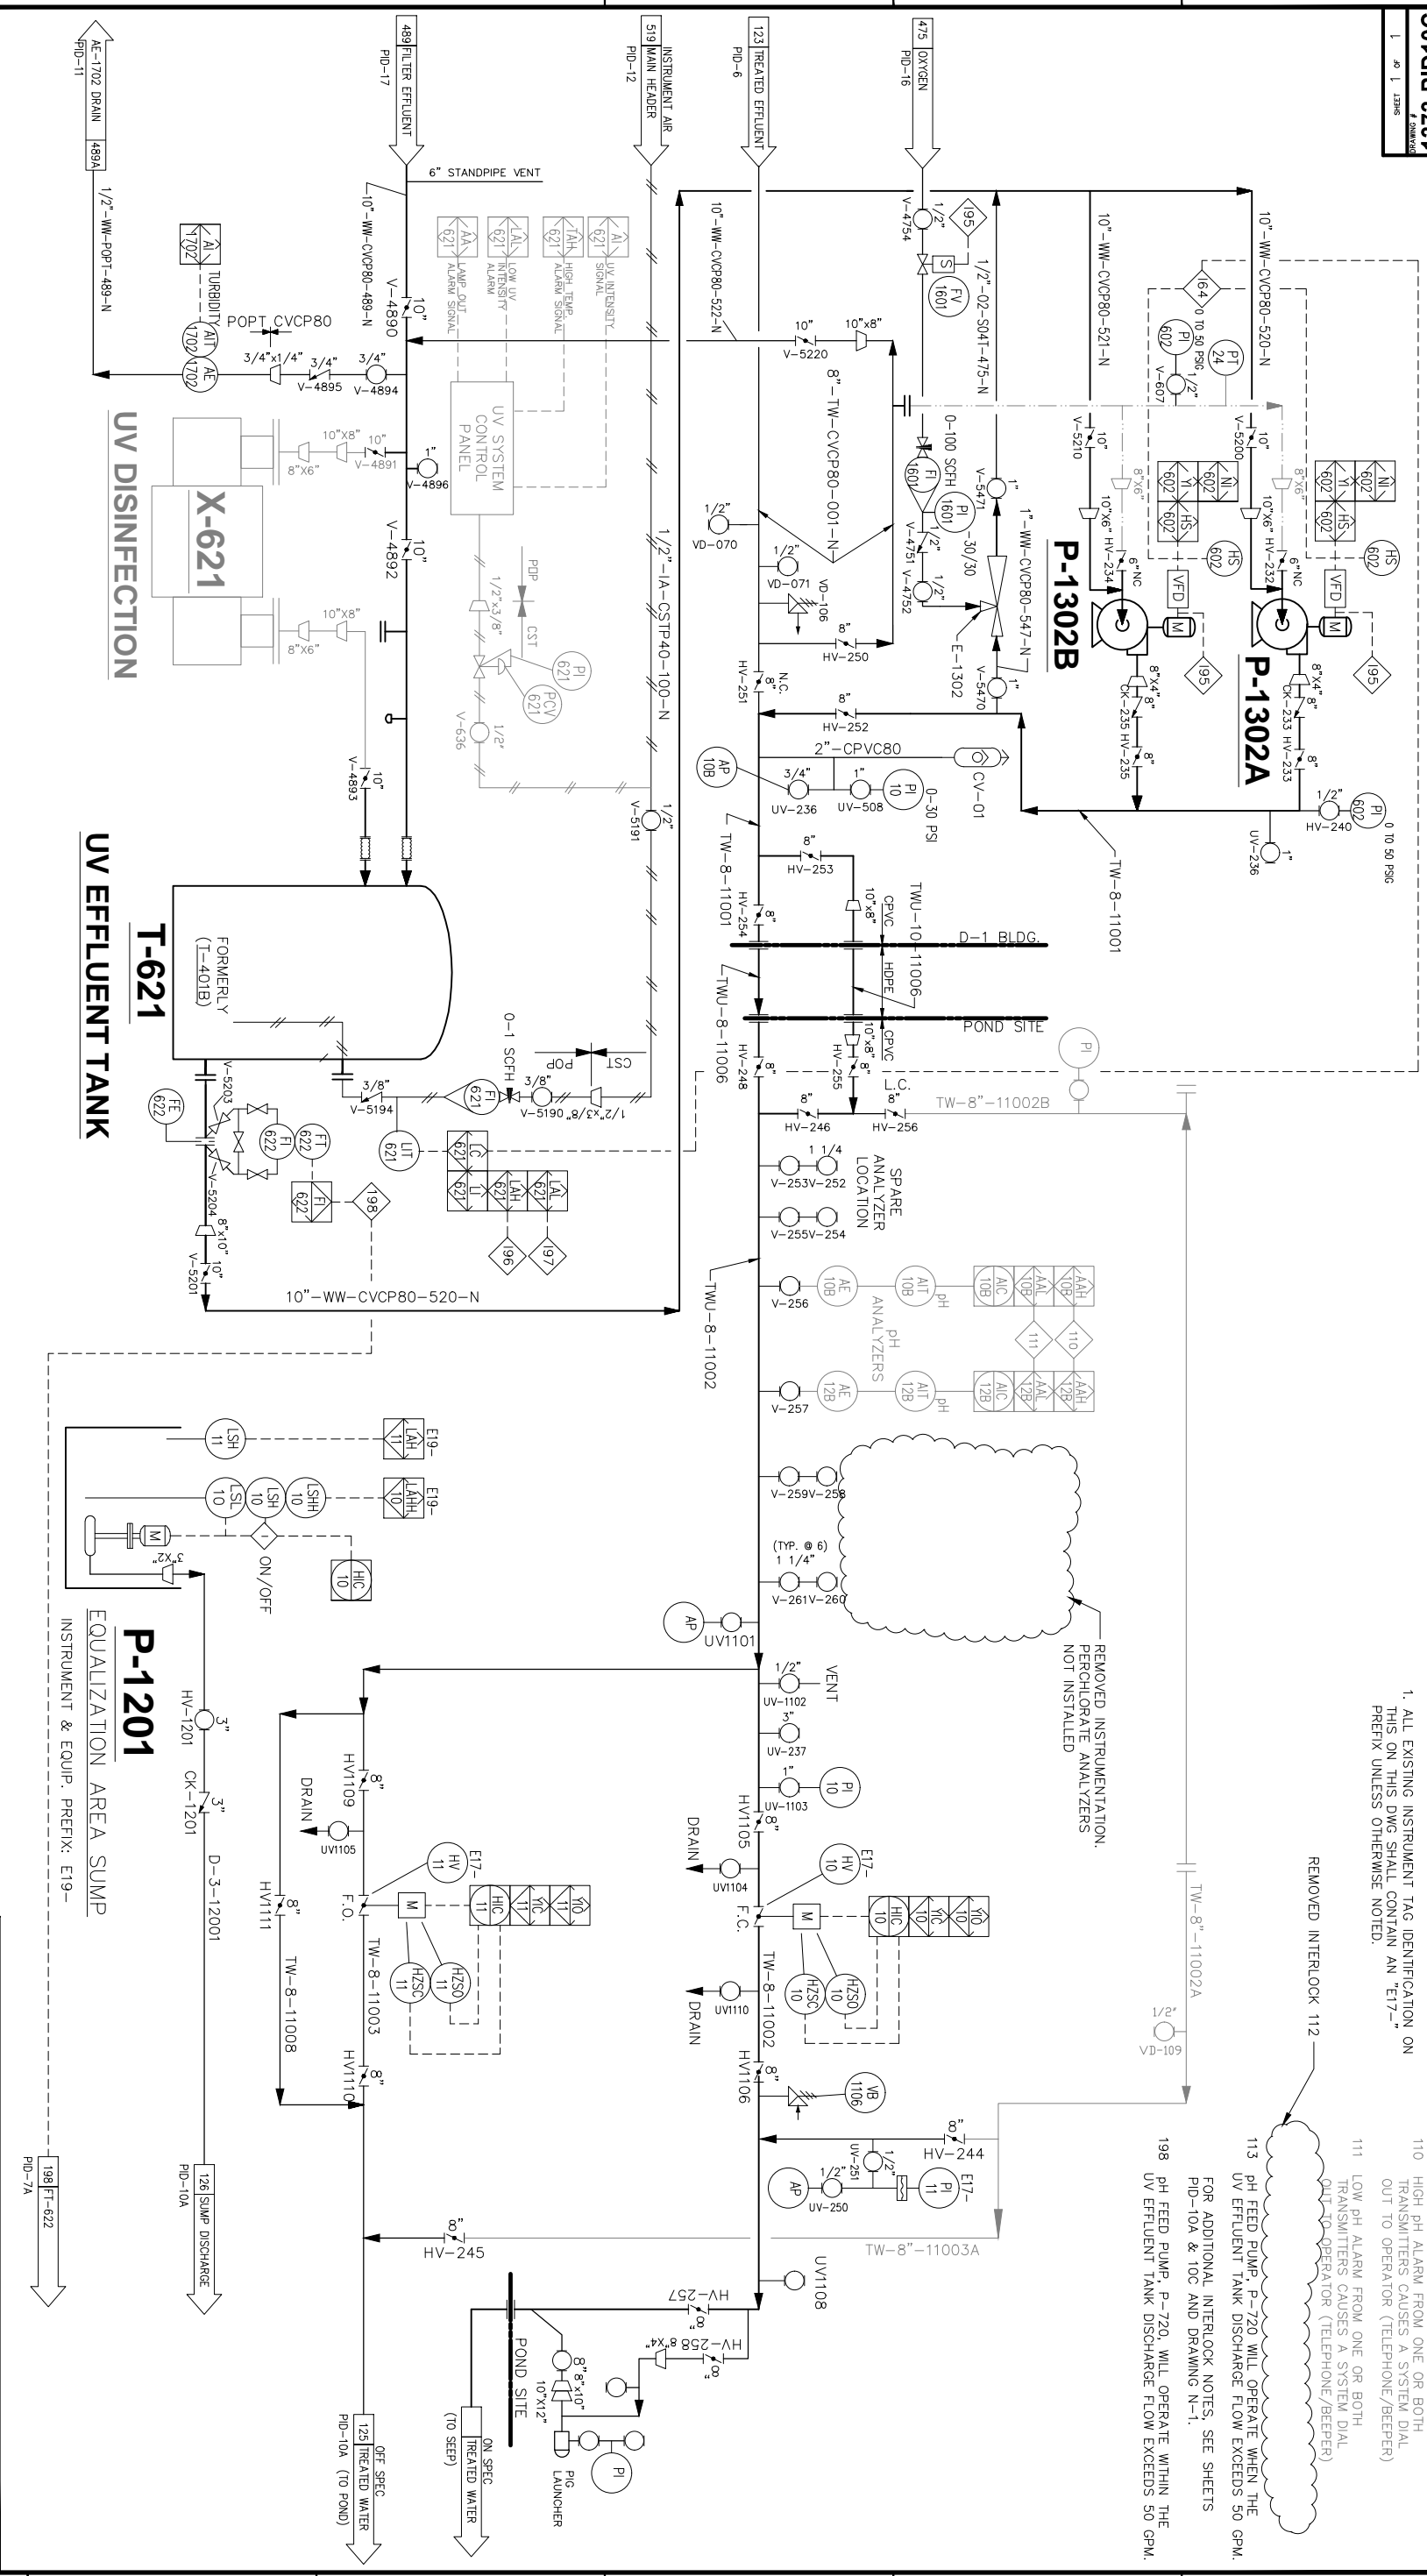

GENERAL NOTES:

- 1. ALL EXISTING INSTRUMENT TAG IDENTIFICATION ON THIS ON THIS DWG SHALL CONTAIN AN 'E17-' PREFIX UNLESS OTHERWISE NOTED.

INTERLOCK NOTES:

- 110 HIGH PH ALARM FROM ONE OR BOTH TRANSMITTERS CAUSES A SYSTEM DIAL OUT TO OPERATOR (TELEPHONE/SEPER)
- 111 LOW PH ALARM FROM ONE OR BOTH TRANSMITTERS CAUSES A SYSTEM DIAL OUT TO OPERATOR (TELEPHONE/SEPER)
- 113 PH FEED PUMP P-720 WILL OPERATE WHEN THE UV EFFLUENT TANK DISCHARGE FLOW EXCEEDS 50 GPM. FOR ADDITIONAL INTERLOCK NOTES, SEE SHEETS PID-10A & 10C AND DRAWING N-1.
- 198 PH FEED PUMP P-720 WILL OPERATE WITHIN THE UV EFFLUENT TANK DISCHARGE FLOW EXCEEDS 50 GPM.

P-1201 EQUAL AREA SUMP PUMP	P-1302A/B EFFLUENT BOOSTER PUMP	X-621 UV DISINFECTION SYSTEM	T-621 UV EFFLUENT TANK
TYPE: SUBMERSIBLE CAPACITY: 150 GPM @ 20 PSIG NETTED MAT'L: 316 SS/INCON MOTOR: 7.5 HP 460V/3/60 MODEL: CORCORAN 4000-VE-1	TYPE: CENTRIFUGAL CAPACITY: 1000 GPM @ 90 PSIG NETTED MAT'L: 316 SS/INCON MOTOR: 100 HP 460V/3/60 MODEL: CORCORAN 8000-D (EXISTING RANG PUMPS: P-1302A/B)	CAPACITY: 1000 gallons @ 50 psig DUTY: 99.9% BACTERIAL REDUCTION UV TRANSMITTANCE: 95% UV DOSAGE: 30,000 mWs/cm POWER: 318kW	SIZE: 10'-0" DIA. 16'-5" STR. MATERIAL: HDPE CAPACITY: 9200 GAL.
U.S. PATENTS 5750028, 5788842, 6706521 AND PATENTS PENDING.			

ENVIROGEN TECHNOLOGIES
 250 PHILLIPS BLVD SUITE 255
 EVINGTON, NJ 08018


A Lifecycle Performance Company
 A member of The Amtek Group

REVISIONS:


NO.	DATE	DESCRIPTION OF REVISION	BY	CHKD	APP'D
1	11-15-13	RECORD DRAWING - REVISED FOR 2013 COMPANY OPERATIONS & REVISED O&M MANUAL	DL	RL	RL
2	10-16-06	RECORD DRAWING - AS NOTED	DL	RL	RL
3	9-26-06	RECORD DRAWING	DL	RL	RL
4	6-25-06	ADDED FLOW TRANSMITTER FI-422	DL	RL	RL
5	4-26-06	REVISED FOR CONSTRUCTION	DL	RL	RL

THIS IS A COMPUTER GENERATED DRAWING AND ONLY EDITS CONSISTENT WITH THE ENVIROGEN'S ORIGINAL CAD FORMAT SHALL BE CONSIDERED VALID COPIES.

DESIGNED BY/DRAWN BY: HENDERSON, NV
 SHEET: 1 OF 1
1373-PID10C
 PIPING & INSTRUMENTATION DIAGRAM
 EQUALIZATION AREA PIPING REVISIONS
 INCORPORATING GW-11
 AS EQUALIZATION BASIN

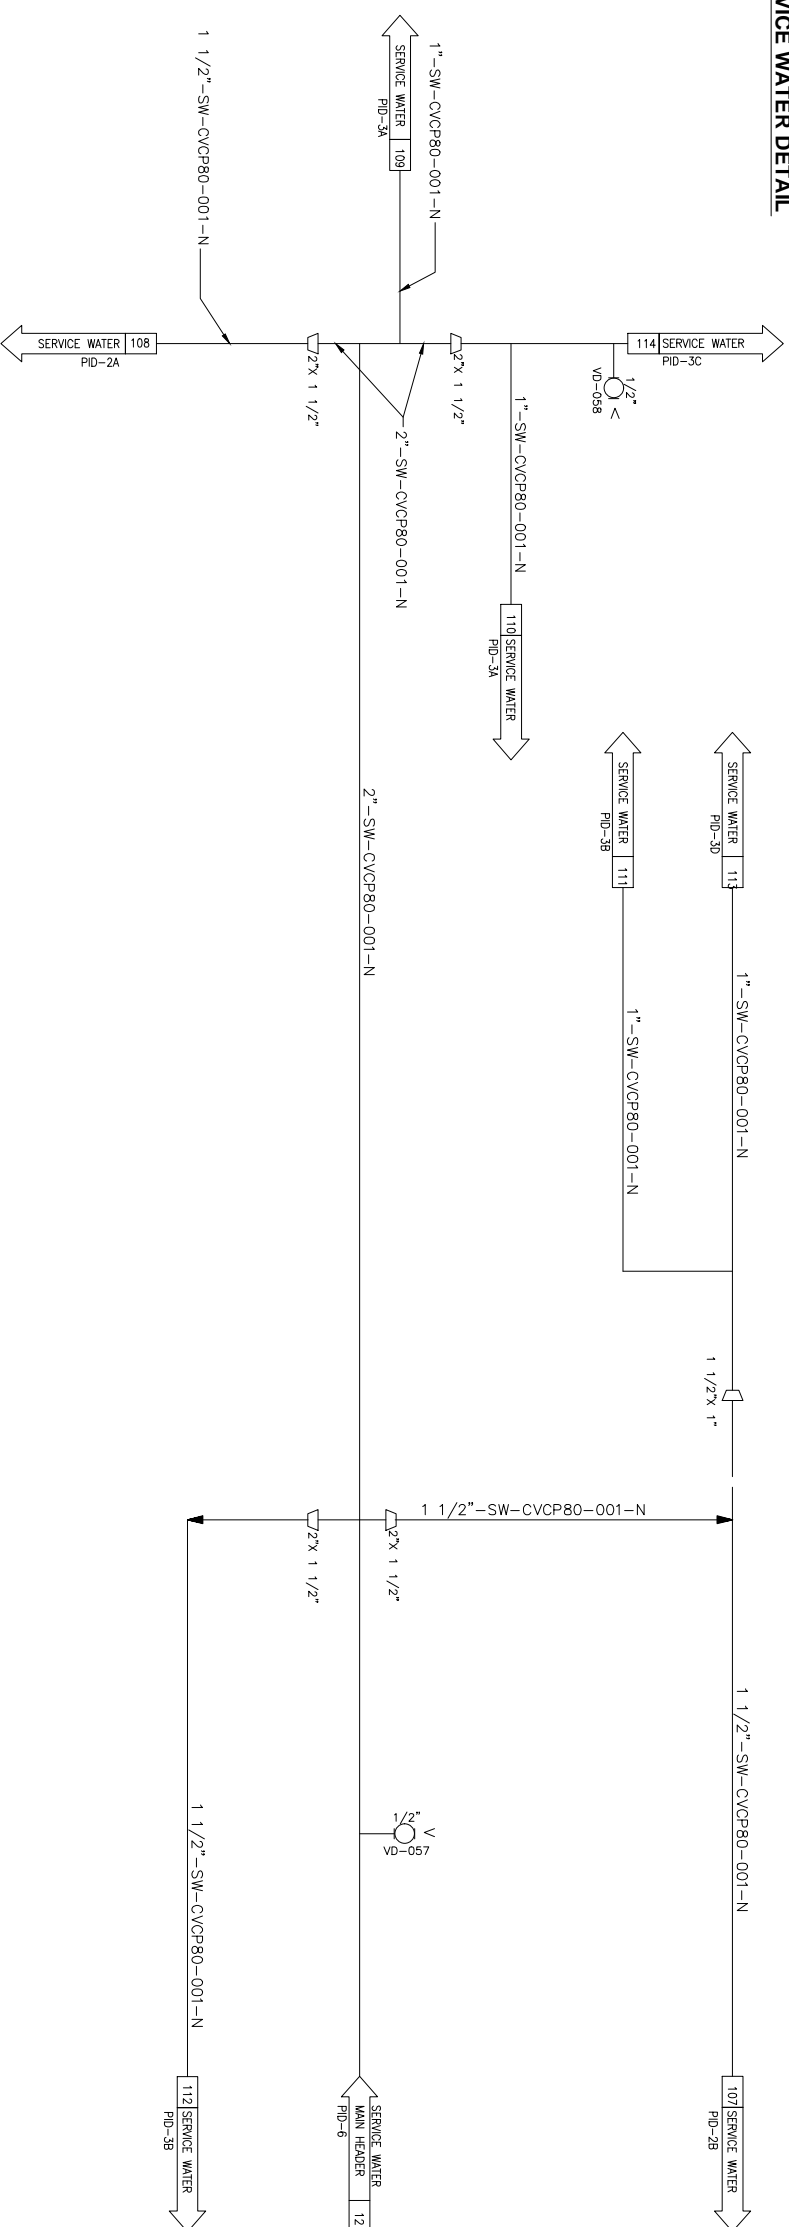

SUMP PUMP DETAIL

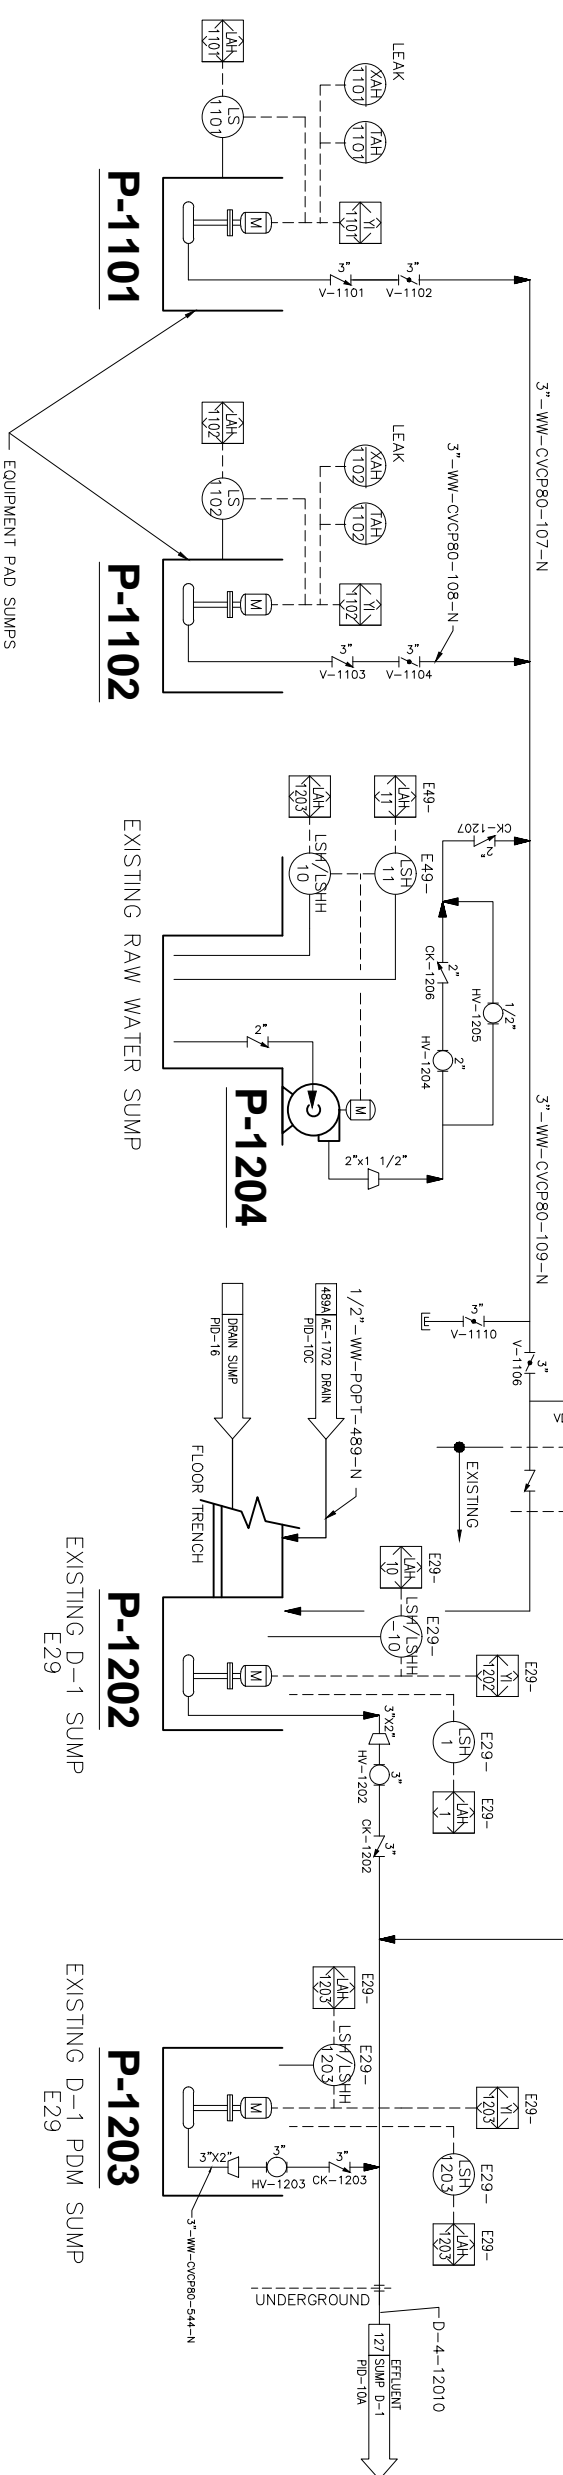

P-1101/1102	P-1202/1203	P-1204
PAD SUMP PUMPS	EXISTING D-1 SUMP PUMPS	RAW WATER SUMP PUMP
TYPE: SUBMERSIBLE CENTRIFUGAL	TYPE: SUBMERSIBLE CENTRIFUGAL	TYPE: CENTRIFUGAL
CAPACITY: 85 GPM @ 27' TDH	CAPACITY: 85 GPM @ 27' TDH	CAPACITY: 3HP, 460/3/60
MOTOR: 1 HP, 460/3/60	MOTOR: 1 HP, 460/3/60	MOTOR: 3HP, 460/3/60 1750RPM
MODEL: BARNES 3SEV-05	MODEL: BARNES 3SEV-05	MODEL:

U.S. PATENTS 5750028, 5788842, 6706521 AND PATENTS PENDING.		
---	--	--

ENVIROGEN
TECHNOLOGIES
250 PHILLIPS BLVD. SUITE 255
EVING, NJ 08018



A Lifecycle Performance Company

ALL INFORMATION CONTAINED ON THIS DOCUMENT IS THE PROPERTY OF ENVIROGEN TECHNOLOGIES, INC. ("ENVIROGEN") AND/OR ITS AFFILIATES. THE DESIGN CONCEPTS AND INFORMATION CONTAINED HEREIN ARE PROPERTY OF ENVIROGEN AND ARE SUBMITTED IN CONFIDENCE. THEY ARE NOT TRANSFERABLE AND MUST BE USED ONLY FOR THE PROJECT AND SITE SPECIFICALLY IDENTIFIED IN THE TITLE OF THIS DOCUMENT. NO PART OF THIS DOCUMENT IS TO BE REPRODUCED, LOANED OR USED IN ANY OTHER MANNER WITHOUT THE EXPRESS WRITTEN CONSENT OF ENVIROGEN. ENVIROGEN ASSUMES NO RESPONSIBILITY OR LIABILITY FOR THE USE OF THIS DOCUMENT OR THE DESIGN CONCEPTS CONTAINED HEREIN FOR ANY PURPOSES OTHER THAN THAT SPECIFICALLY IDENTIFIED IN THE TITLE OF THIS DOCUMENT. ORIGINAL INTENDED USE OF THIS DOCUMENT IN NO EVENT SHALL THIS DOCUMENT OR THE DESIGN CONCEPTS CONTAINED HEREIN BE USED FOR ANY PURPOSES OTHER THAN THAT SPECIFICALLY IDENTIFIED IN THE TITLE OF THIS DOCUMENT. THE RIGHTS AND OBLIGATIONS OF ENVIROGEN AND ITS CUSTOMER ARE RESERVED AND ACCEPTANCE OF THE DELIVERY OF THIS DOCUMENT CONSTITUTES AGREEMENT TO THESE TERMS AND CONDITIONS.

RECORD DATE	REVISION	DESCRIPTION OF REVISION
11-15-13	1	RECORD DRAWING - REVISION PER 2013 CURRENT OPERATIONS & REVISIONS (S&M) WORK
5-30-06	2	RECORD DRAWING
02-28-06	3	LINE LABEL REFERENCES PER-17 INSTEAD OF PD-10C
12-27-05	4	REVISED PER CUSTOMER COMMENTS
	5	ISSUED FOR CONSTRUCTION

DESIGNER	HECKERT, NERT
CHECKED BY	HECKERT, NERT
DATE	06-02-03
SCALE	AS SHOWN
PROJECT NO.	1373-PID11
SHEET NO.	26
TOTAL SHEETS	4


THIS IS A COMPUTER GENERATED DRAWING AND ONLY EDITS CONSISTENT WITH THE ENVIROGEN'S ORIGINAL CAD FORMAT SHALL BE CONSIDERED VALID COPIES.

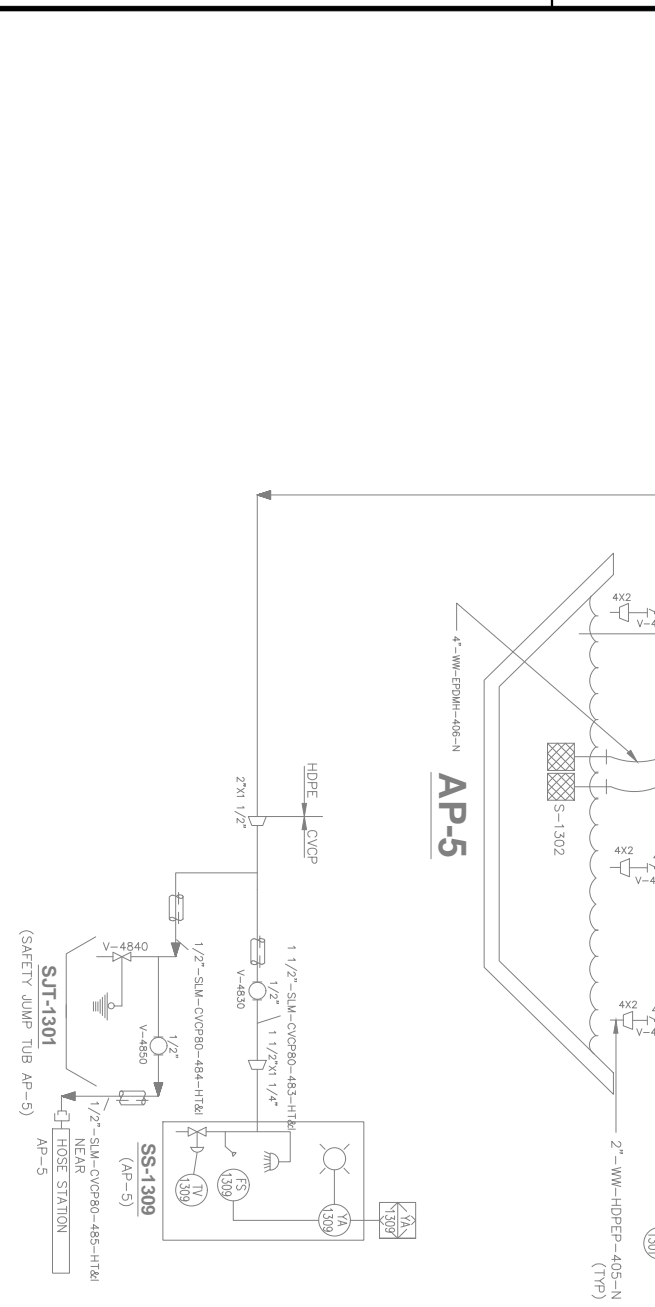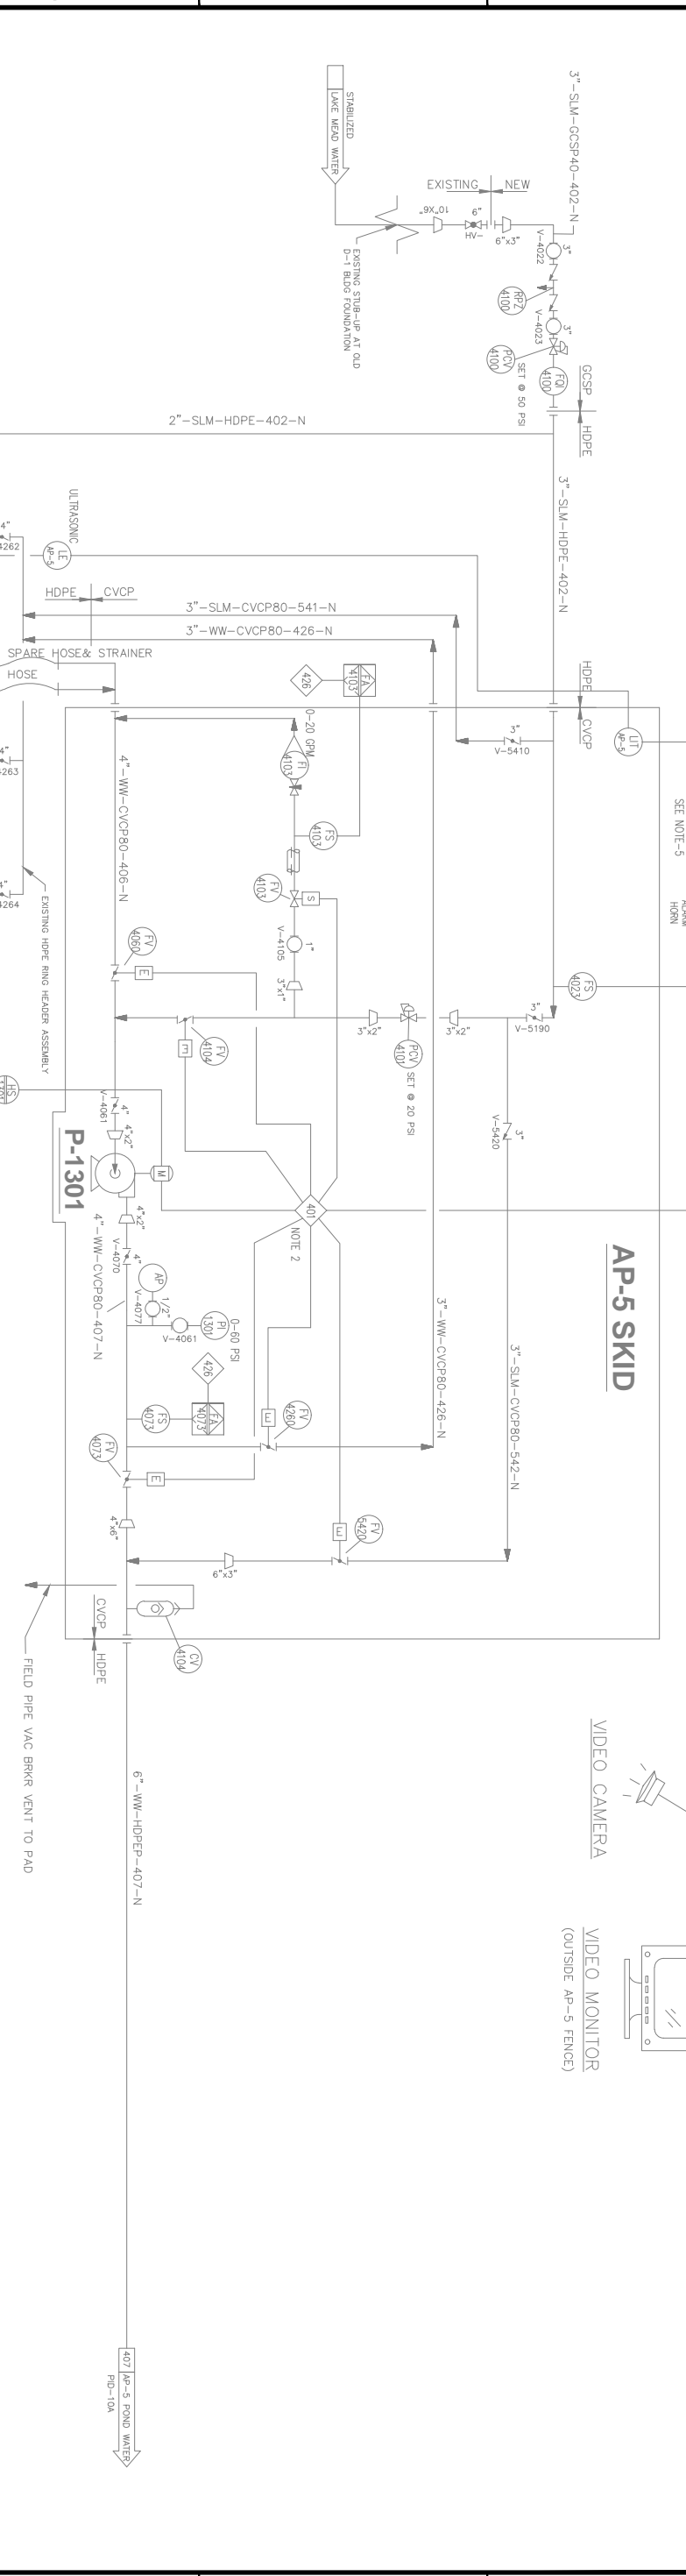

- NOTES:
1. ALL EQUIPMENT SHOWN IS WITHIN A CONTAINED AREA THAT DRAINS INTO AP-5.
 2. SEE MODE TABLE IN PROCESS DESCRIPTION.
 3. ALL ALARMS AT AP-5 PROVIDE AN AUDIBLE SIGNAL AT AP-5.
 4. WATER ADDITION TO AP-5 POND BASED ON LEVEL AND MIX TIME.
 5. ALL PLC CONTROLS ON THIS DRAWING SHEET ARE HANDLED BY A LOCAL PLC PANEL.

NOTE:
 THIS DRAWING CONTAINS ALL
 NEW/NOV-EXISTENT EQUIPMENT EXCEPT AS
 NOTED.


AP-5 POND	P-1301 AP-5 SUCTION PUMP
TYPE: CENTRIFUGAL CAPACITY: 1.5 MILLION GAL	TYPE: CENTRIFUGAL WETTED MAT'L: POLYESTER/EPDM CAPACITY: 150 gpm @ 55' TDH MOTOR: 3 HP 60VAC, 3PH MFR: WESTINGHOUSE MFR. PACER

 

ALL INFORMATION CONTAINED ON THIS DOCUMENT IS THE PROPERTY OF ENVIROGEN TECHNOLOGIES, INC. (ENVIROGEN) AND/OR ITS AFFILIATES. THE DESIGN CONCEPTS AND INFORMATION CONTAINED HEREIN ARE PROPERTY OF ENVIROGEN AND ARE SUBMITTED IN CONFIDENCE. THEY ARE NOT TO BE REPRODUCED OR USED IN ANY MANNER WITHOUT THE EXPRESS WRITTEN CONSENT OF ENVIROGEN. ENVIROGEN ASSUMES NO RESPONSIBILITY OR LIABILITY FOR THE USE OF THIS DOCUMENT OR THE DESIGN CONCEPTS CONTAINED HEREIN FOR ANY PURPOSES OTHER THAN THAT SPECIFICALLY STATED ON THE DRAWING. THE ORIGINAL INTENDED USE OF THIS DOCUMENT IS NO EVENT SHALL THIS DOCUMENT OR THE DESIGN CONCEPTS CONTAINED HEREIN BE REPRODUCED OR USED IN ANY MANNER WITHOUT THE EXPRESS WRITTEN CONSENT OF ENVIROGEN. THE RIGHTS AND OBLIGATIONS OF ENVIROGEN AND ITS CUSTOMER ARE RESERVED AND SHALL BE GOVERNED BY THE TERMS AND CONDITIONS OF THE LICENSE AGREEMENT TO THESE TERMS AND CONDITIONS.

REVISION	DATE	DESCRIPTION OF REVISION	BY	CHK	APP
1	11-15-13	RECORD DRAWING - REVISED FOR 2013 CURRENT OPERATIONS & REVISED O&M MANUAL	DM	RL	DM
2	9-26-06	RECORD DRAWING	DM	RL	DM
3	4-26-06	REVISED LINE LABEL WATER SUMP 'A'	DM	RL	DM
4	12-27-05	ISSUED FOR CONSTRUCTION	DM	RL	DM

DESIGNED BY/DATE	MD / 03-15-05
DRAWN BY/DATE	DM / 03-18-05
CHECKED BY/DATE	SF / 03-18-05
SHEET SIZE	D
REVISION	3

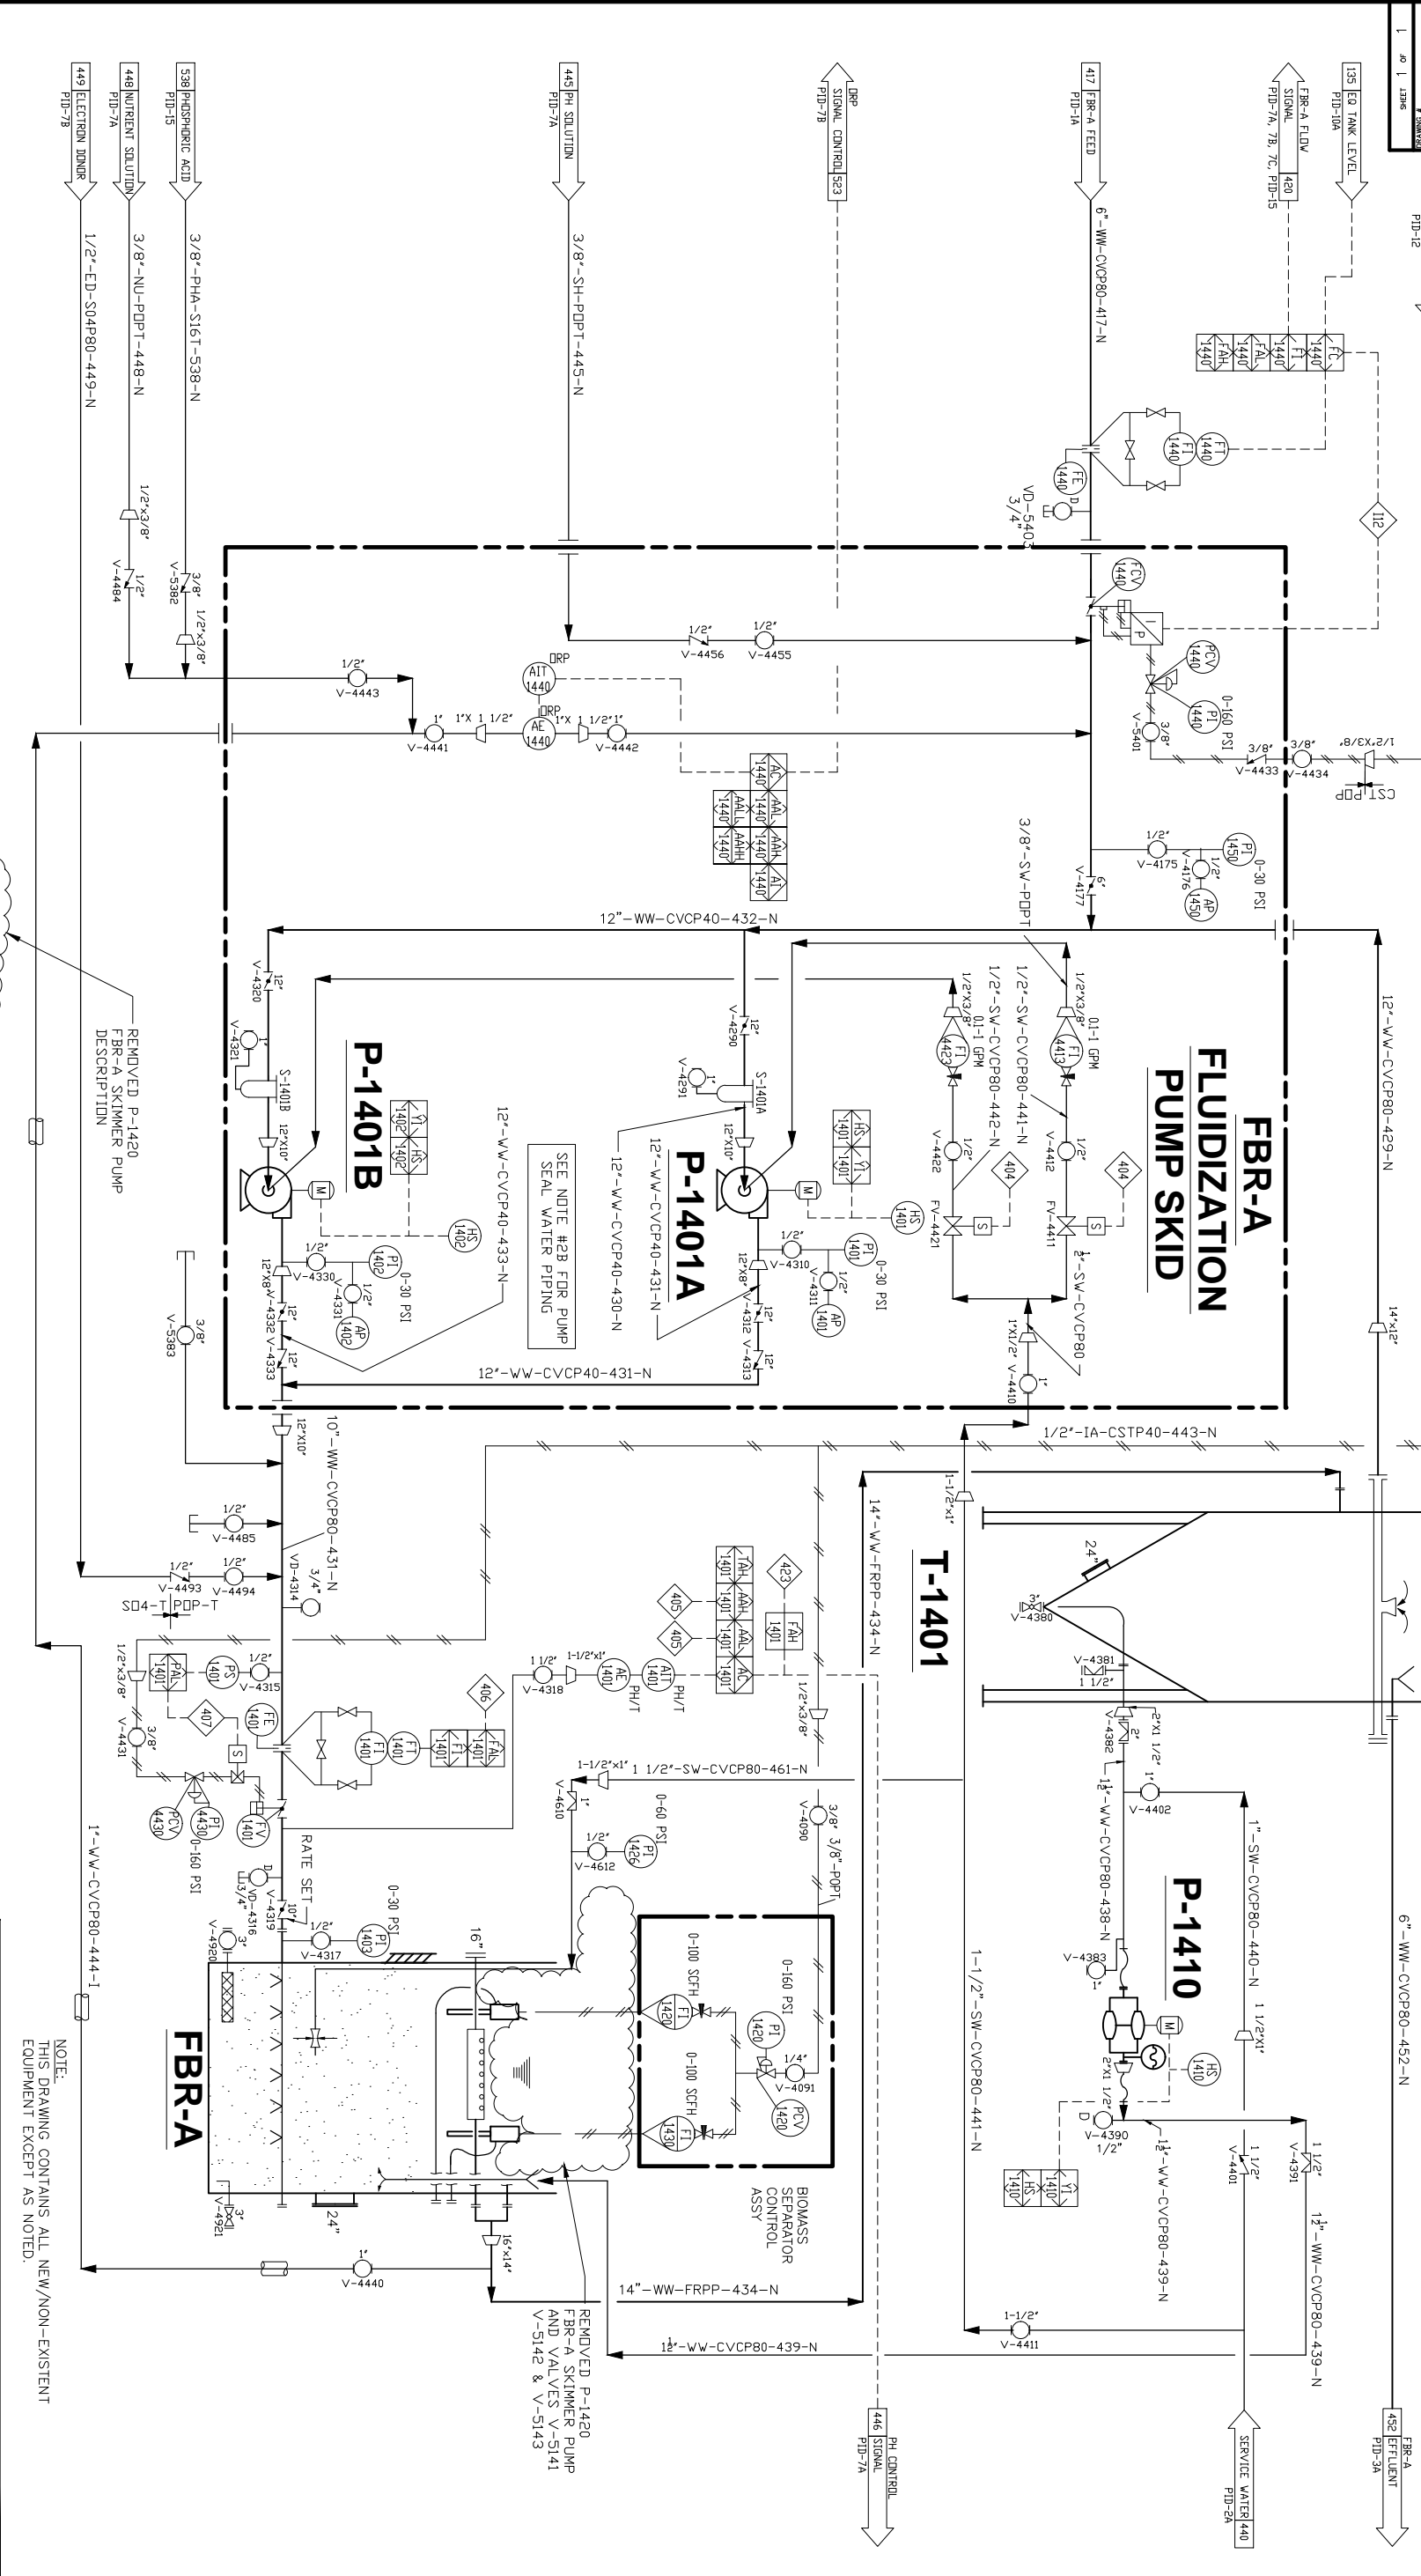

NOTE:
THIS DRAWING CONTAINS ALL NEW/ NON-EXISTENT
EQUIPMENT EXCEPT AS NOTED.

FBR-A FLUIDIZED BED REACTOR SIZE: 14' DIA. X 90' STR. MAT'L: FRP CAPACITY: 33,000 GAL MEDIA TYPE: SAND MEDIA VOLUME: 2,000 CU. FT.	P-1401A, 1401B FLUIDIZATION PUMPS TYPE: CENTRIFUGAL CAPACITY: 2,000 GPM @ 40' TDH MAT'L: FRP MOTOR: 30 HP, 460 VAC, 3PH MODEL: F18BDC SERIES 1500, 18K5K15	T-1401 SEPARATOR TANK SIZE: 10' DIA. X 30' HT. MAT'L: FRP CAPACITY: 8,500 GAL	P-1410 MEDIA RETURN PUMP TYPE: ELECTRIC DIAPHRAGM CAPACITY: 30 GPM @ 40' TDH MAT'L: PVDF MOTOR: 10 HP, 460 VAC, 3PH MODEL: PENN VALLEY 2" DOUBLE DISC
---	---	--	--

U.S. PATENTS 5750028, 5788842, 6706521 AND PATENTS PENDING.

ENVIROGEN
TECHNOLOGIES

250 PHILLIPS BLVD. SUITE 255
EVINGTON, NJ 08018

A Lifecycle Performance Company


REVISION	DATE	DESCRIPTION OF REVISION
1	11-16-13	RECORD DRAWING - REVISED FOR 2013 CURRENT OPERATIONS & RECORDED DATA MANUAL
2	9-28-06	RECORDED DRAWING
3	4-28-06	REVISED PER CUSTOMER COMMENTS
4	12-27-05	ISSUED FOR CONSTRUCTION

PIPING & INSTRUMENTATION DIAGRAM
FBR-A SYSTEM

HELDENSON, NV
NERT


1333-PID14
REV 1373-PID14-3

PHOSPHORIC ACID ASSEMBLY

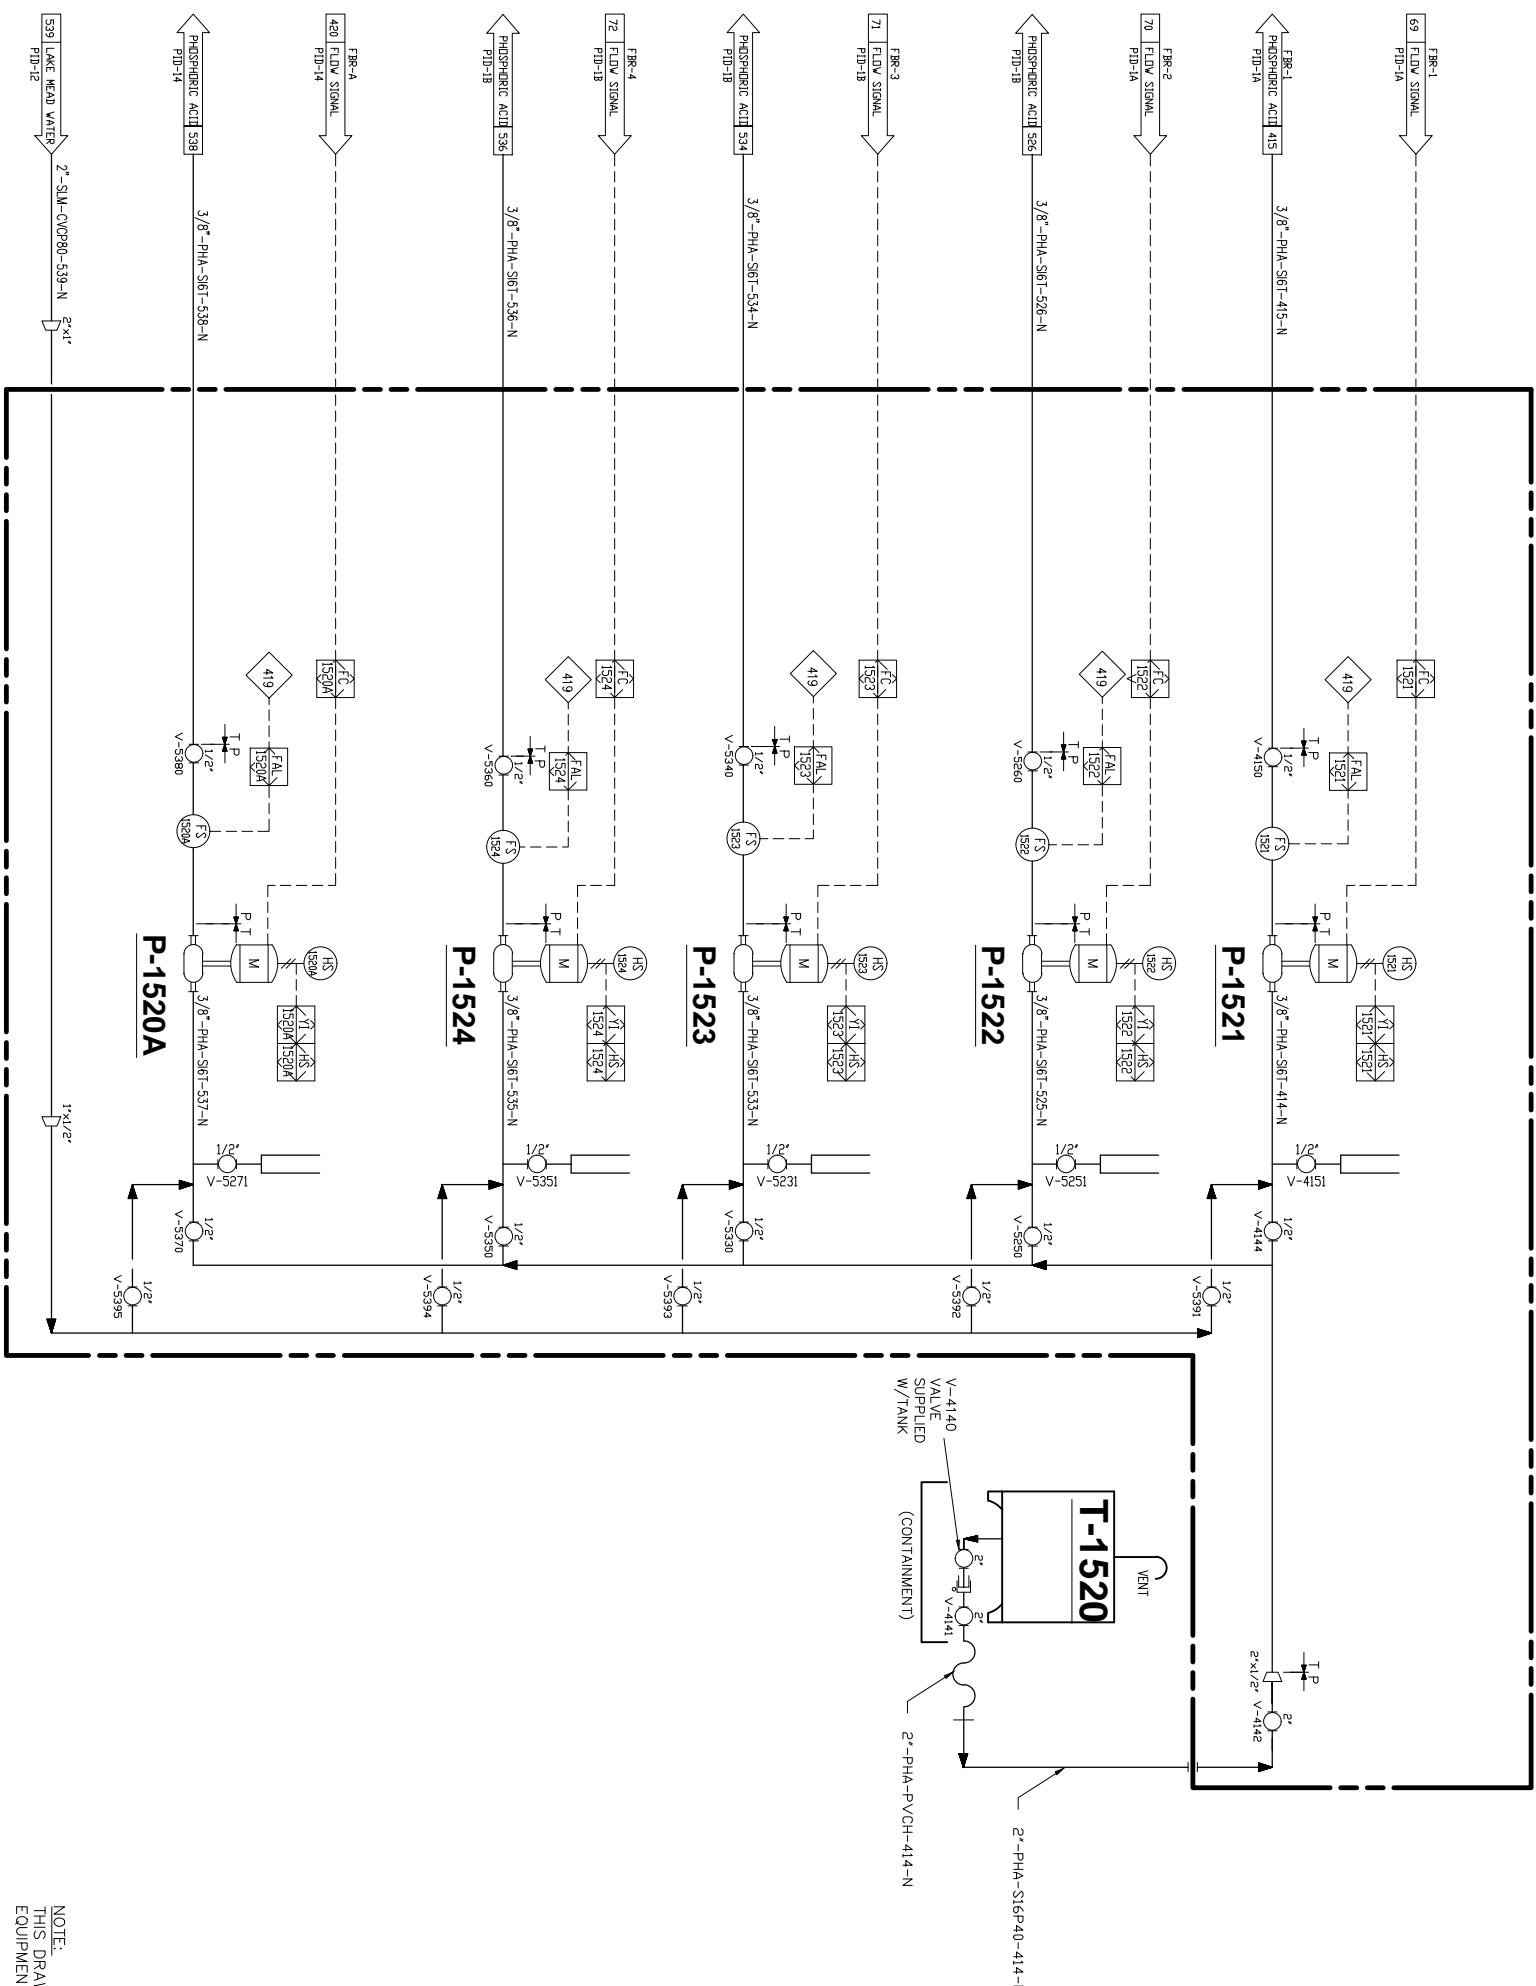

NOTE:
THIS DRAWING CONTAINS ALL NEW/NON-EXISTENT
EQUIPMENT EXCEPT AS NOTED.


T-1520 PHOSPHORIC ACID TOTE	P-1520A/1521/1522 /1523/1524 PHOSPHORIC ACID PUMP
TOTE TOTE MATERIALS PUMP CAPACITY: 320 GAL.	TYPE: PERISTALTIC NETTED MATERIALS CAPACITY: 0.08-0.54 GPH MODEL: VA-975-3000 L/S 13 MFR: MASTER FLEX

 

ALL INFORMATION CONTAINED ON THIS DOCUMENT IS THE PROPERTY OF ENVIROGEN TECHNOLOGIES, INC. (ENVIROGEN) AND/OR ITS AFFILIATES. THE DESIGN CONCEPTS AND INFORMATION CONTAINED HEREIN ARE PROPERTY OF ENVIROGEN AND ARE SUBMITTED IN CONFIDENCE. THEY ARE NOT TRANSFERABLE AND MUST BE USED ONLY FOR THE PROJECT AND/OR FACILITY FOR WHICH THEY WERE DEVELOPED. ANY REPRODUCTION, DISTRIBUTION, OR USE OF THIS DOCUMENT IN ANY MANNER WITHOUT THE EXPRESS WRITTEN CONSENT OF ENVIROGEN IS STRICTLY PROHIBITED. ENVIROGEN ASSUMES NO RESPONSIBILITY OR LIABILITY FOR THE USE OF THIS DOCUMENT OR THE DESIGN CONCEPTS CONTAINED HEREIN FOR ANY OTHER PROJECT OR FACILITY. THE USER OF THIS DOCUMENT OR THE DESIGN CONCEPTS CONTAINED HEREIN SHALL BE RESPONSIBLE FOR OBTAINING ALL NECESSARY PERMITS AND APPROVALS FROM THE APPROPRIATE AGENCIES AND REGULATORY AGENCIES. ENVIROGEN AND ITS AFFILIATES SHALL NOT BE LIABLE FOR ANY DAMAGES, INCLUDING REASONABLE ATTORNEY'S FEES, ARISING FROM THE USE OF THIS DOCUMENT OR THE DESIGN CONCEPTS CONTAINED HEREIN. THE USER OF THIS DOCUMENT OR THE DESIGN CONCEPTS CONTAINED HEREIN SHALL BE RESPONSIBLE FOR OBTAINING ALL NECESSARY PERMITS AND APPROVALS FROM THE APPROPRIATE AGENCIES AND REGULATORY AGENCIES. ENVIROGEN AND ITS AFFILIATES SHALL NOT BE LIABLE FOR ANY DAMAGES, INCLUDING REASONABLE ATTORNEY'S FEES, ARISING FROM THE USE OF THIS DOCUMENT OR THE DESIGN CONCEPTS CONTAINED HEREIN.

REV.	DATE	DESCRIPTION OF REVISION	DESIGNED BY	CHECKED BY
1	11-15-13	RECORD DRAWING - REVISED FOR 2013 CONCRETE CONSTRUCTION & REVISED SUMP MATERIALS	DM	RL
2	9-26-06	RECORD DRAWING	DM	RL
3	5-10-06	DELETED DUPLICATE VALVES	DM	RL
4	4-28-06	REVISED FOR CONSTRUCTION	DK	RL
5	12-27-06	REVISED FOR CONSTRUCTION	DM	RL

DESIGNED BY	DM
CHECKED BY	DM
DATE	03-15-05
SCALE	N/A
SHEET NO.	4
TOTAL SHEETS	26
PROJECT NO.	1373-PID-15

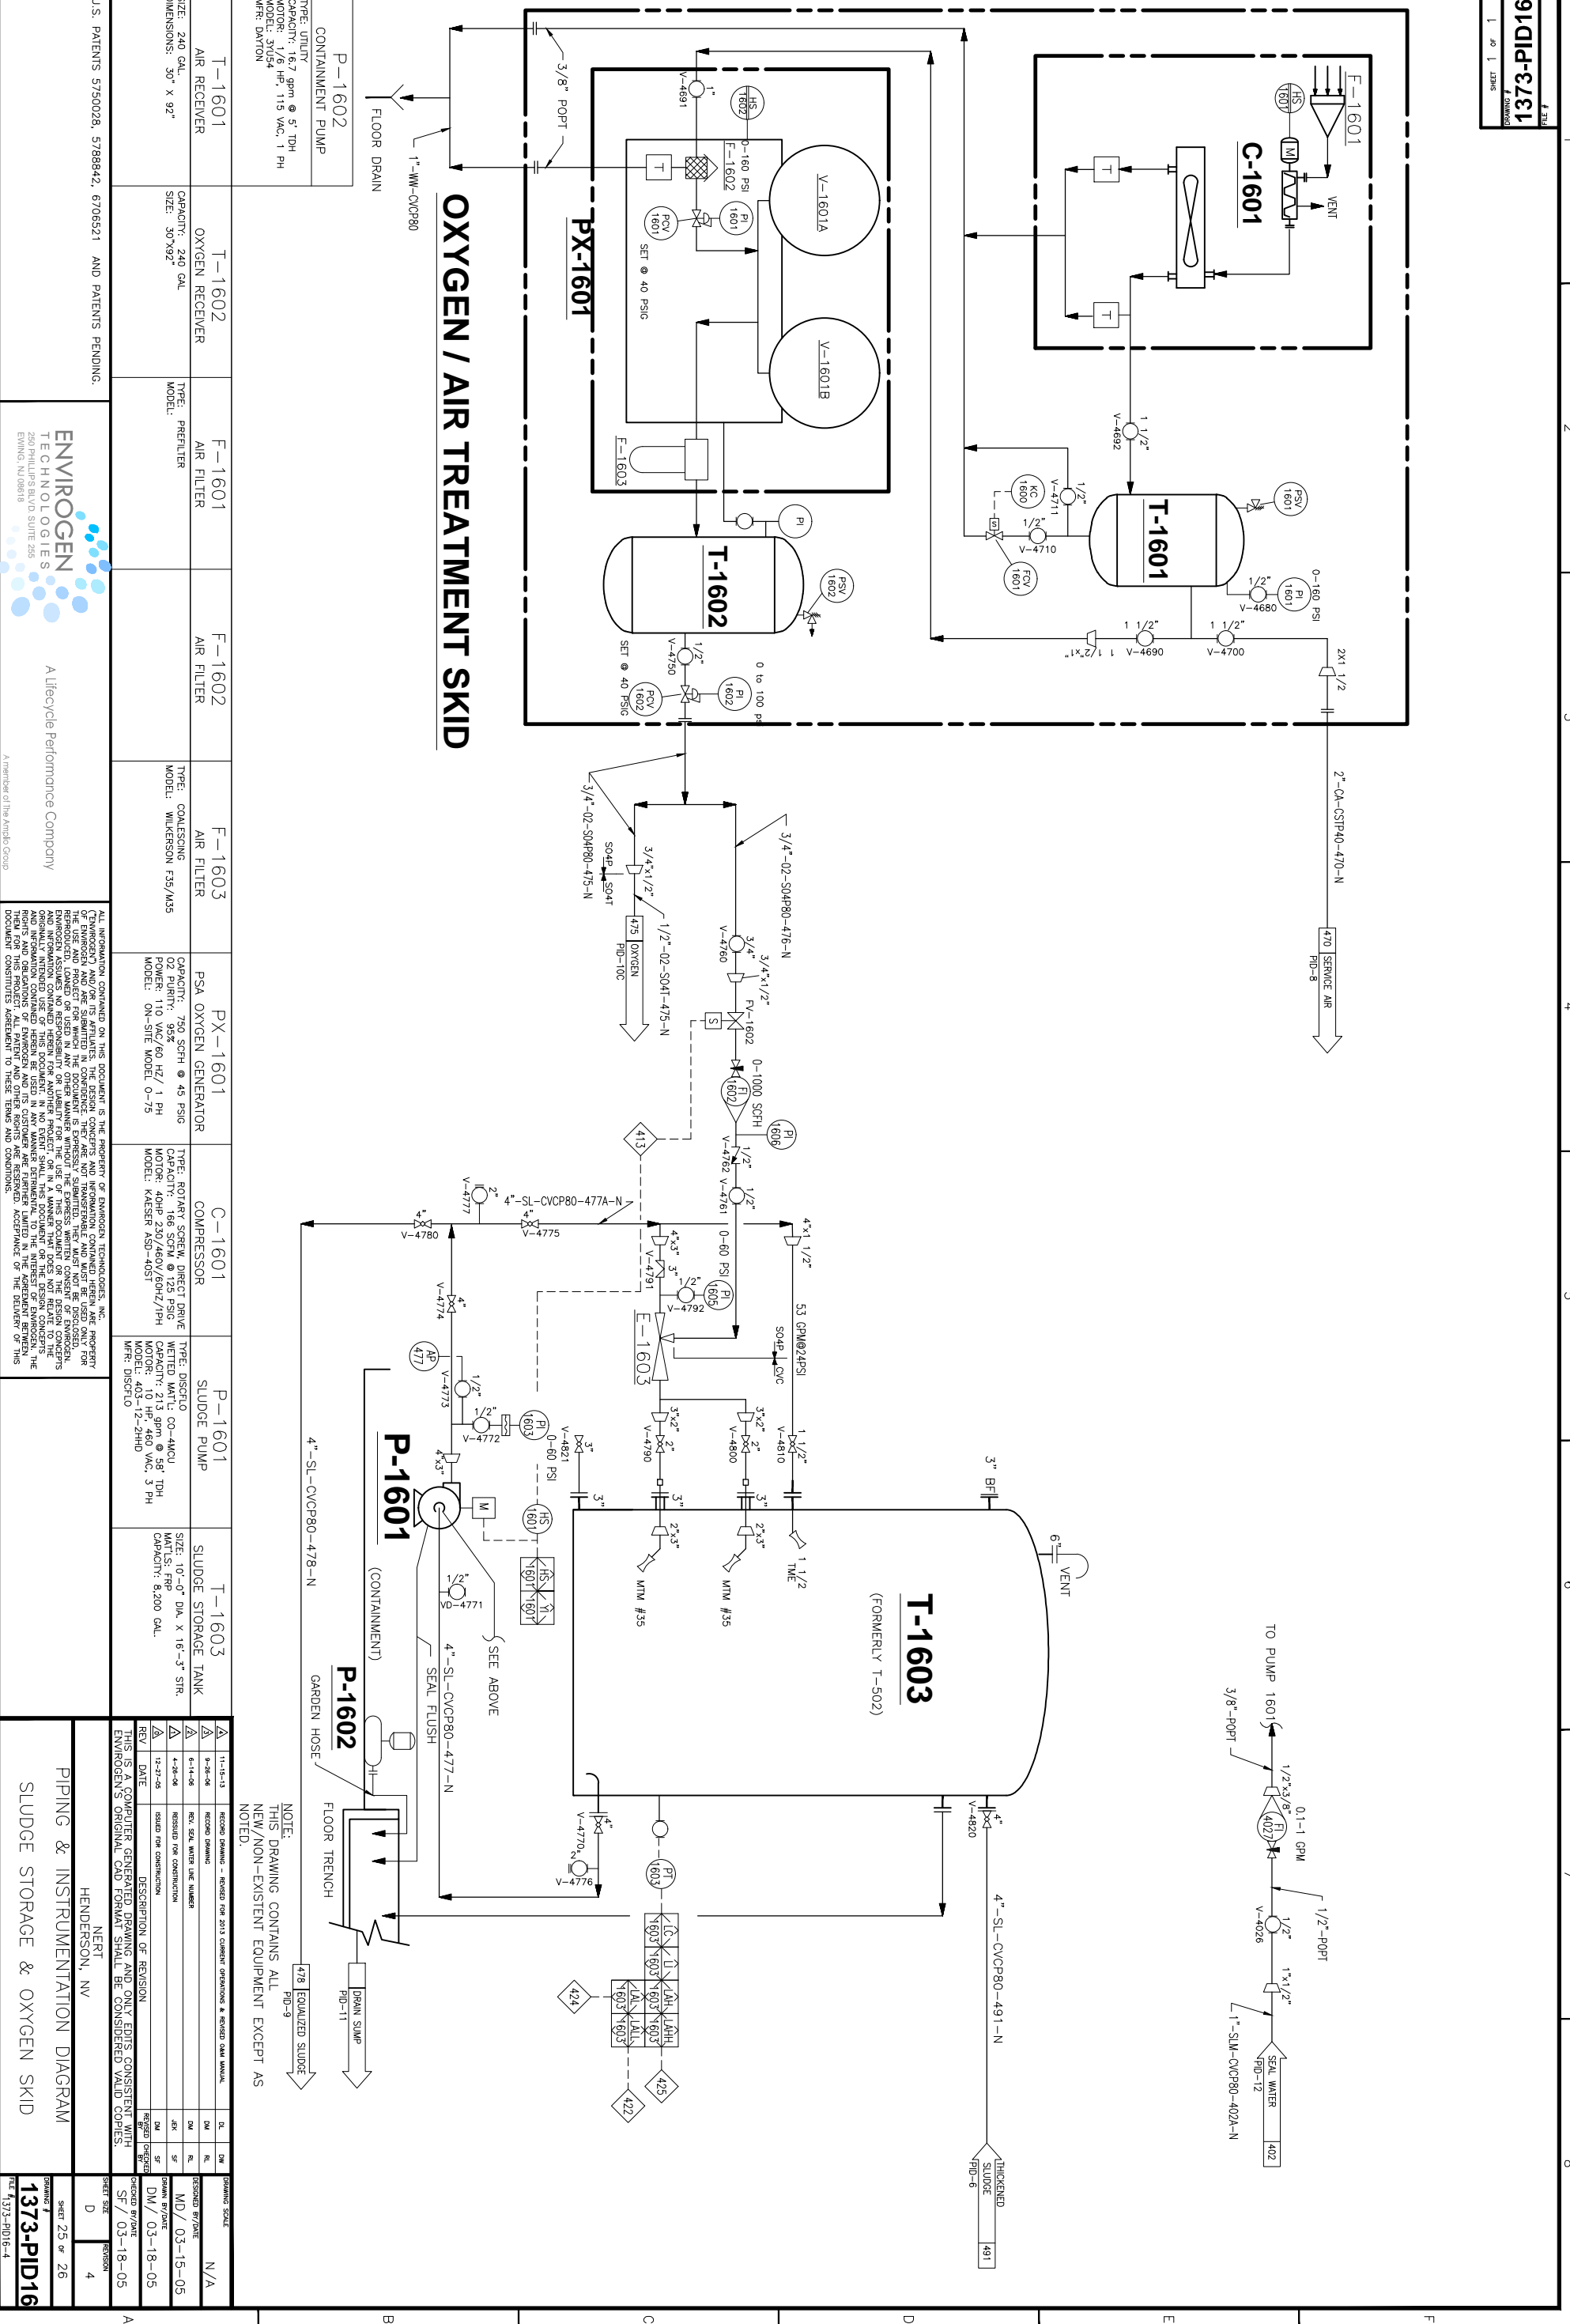

OXYGEN / AIR TREATMENT SKID

P-1602 CONTAINMENT PUMP TYPE: UTILITY CAPACITY: 16.7 gpm @ 5' TDH MOTOR: 1/6 HP, 115 VAC, 1 PH MFR: DAYTON	T-1601 AIR RECEIVER CAPACITY: 240 GAL SIZE: 30" X 92"	T-1602 OXYGEN RECEIVER CAPACITY: 240 GAL SIZE: 30" X 92"	F-1601 AIR FILTER TYPE: PREFILTER	F-1602 AIR FILTER TYPE: COALESCING MODEL: WILKERSON F35/M35	F-1603 AIR FILTER TYPE: PSA OXYGEN GENERATOR CAPACITY: 750 SCFH @ 45 PSIG O2 PURTY: 92% POWER: 110 VAC/60 HZ/ 1 PH MODEL: ON-SITE MODEL O-75	PX-1601 OXYGEN GENERATOR TYPE: ROTARY SCREW DIRECT DRIVE CAPACITY: 166 SCFH @ 125 PSIG MOTOR: 40HP 230/460V/60HZ/3PH MODEL: KAESER ASD-40ST	C-1601 COMPRESSOR TYPE: DISPHO CAPACITY: 166 SCFH @ 58 TDH MOTOR: 10 HP, 460 VAC, 3 PH MODEL: DISPHO	P-1601 SLUDGE PUMP TYPE: DISPHO CAPACITY: 213 gpm @ 58 TDH MOTOR: 10 HP, 460 VAC, 3 PH MODEL: DISPHO	T-1603 SLUDGE STORAGE TANK SIZE: 10'-0" DIA. X 16'-3" STR. VOLUME: 1000 GAL CAPACITY: 8,200 GAL
--	---	--	--	---	---	---	--	--	--


U.S. PATENTS 5750028, 5788842, 6706521 AND PATENTS PENDING.	ENVIROGEN TECHNOLOGIES 250 PHILLIPS BLVD SUITE 255 EVANS, IN 46318	A Lifecycle Performance Company A member of the Arco Group
---	--	---

ALL INFORMATION CONTAINED ON THIS DOCUMENT IS THE PROPERTY OF ENVIROGEN TECHNOLOGIES, INC. PROPERTY OF ENVIROGEN AND/OR ITS AFFILIATES. THE DESIGN CONCEPTS AND INFORMATION CONTAINED HEREIN ARE REPRODUCED, LOANED OR USED IN ANY OTHER MANNER WITHOUT THE EXPRESS WRITTEN CONSENT OF ENVIROGEN. ENVIROGEN ASSUMES NO RESPONSIBILITY OR LIABILITY FOR THE USE OF THIS DOCUMENT OR THE DESIGN CONCEPTS OR INFORMATION CONTAINED HEREIN. THE USER OF THIS DOCUMENT IN NO EVENT SHALL BE HELD LIABLE FOR THE ORIGINAL INTENDED USE OF THIS DOCUMENT. IN NO EVENT SHALL THIS DOCUMENT OR THE DESIGN CONCEPTS OR INFORMATION CONTAINED HEREIN BE USED IN ANY MANNER THAT COULD BE CONSIDERED A VIOLATION OF THE RIGHTS AND OBLIGATIONS OF ENVIROGEN AND ITS CUSTOMER OR PARTNER UNLESS THE USER HAS OBTAINED THE EXPRESS WRITTEN CONSENT OF ENVIROGEN. ENVIROGEN DISCLAIMS ALL WARRANTIES, INCLUDING BUT NOT LIMITED TO THE IMPLIED WARRANTIES OF MERCHANTABILITY AND FITNESS FOR THIS PROJECT. ALL PATENT AND OTHER RIGHTS ARE RESERVED. ACCEPTANCE OF THIS DOCUMENT CONSTITUTES AGREEMENT TO THESE TERMS AND CONDITIONS.
--

REVISIONS	REVISION	DATE	DESCRIPTION OF REVISION
1	AS SHOWN	11-15-13	ISSUED FOR CONSTRUCTION
2	REV. 25	9-26-04	REVISION FOR CONSTRUCTION
3	REV. 26	4-28-04	ISSUED FOR CONSTRUCTION
4	REV. 27	12-27-04	REVISION FOR CONSTRUCTION

DESIGNED BY/DATE HENDERSON, NV 1373-PID16 SHEET 25 OF 26 REF: 1373-PID16-4	CHECKED BY/DATE HENDERSON, NV 1373-PID16 SHEET 25 OF 26 REF: 1373-PID16-4
---	--

NOTE: THIS DRAWING CONTAINS ALL NEW/NON-EXISTENT EQUIPMENT EXCEPT AS NOTED.

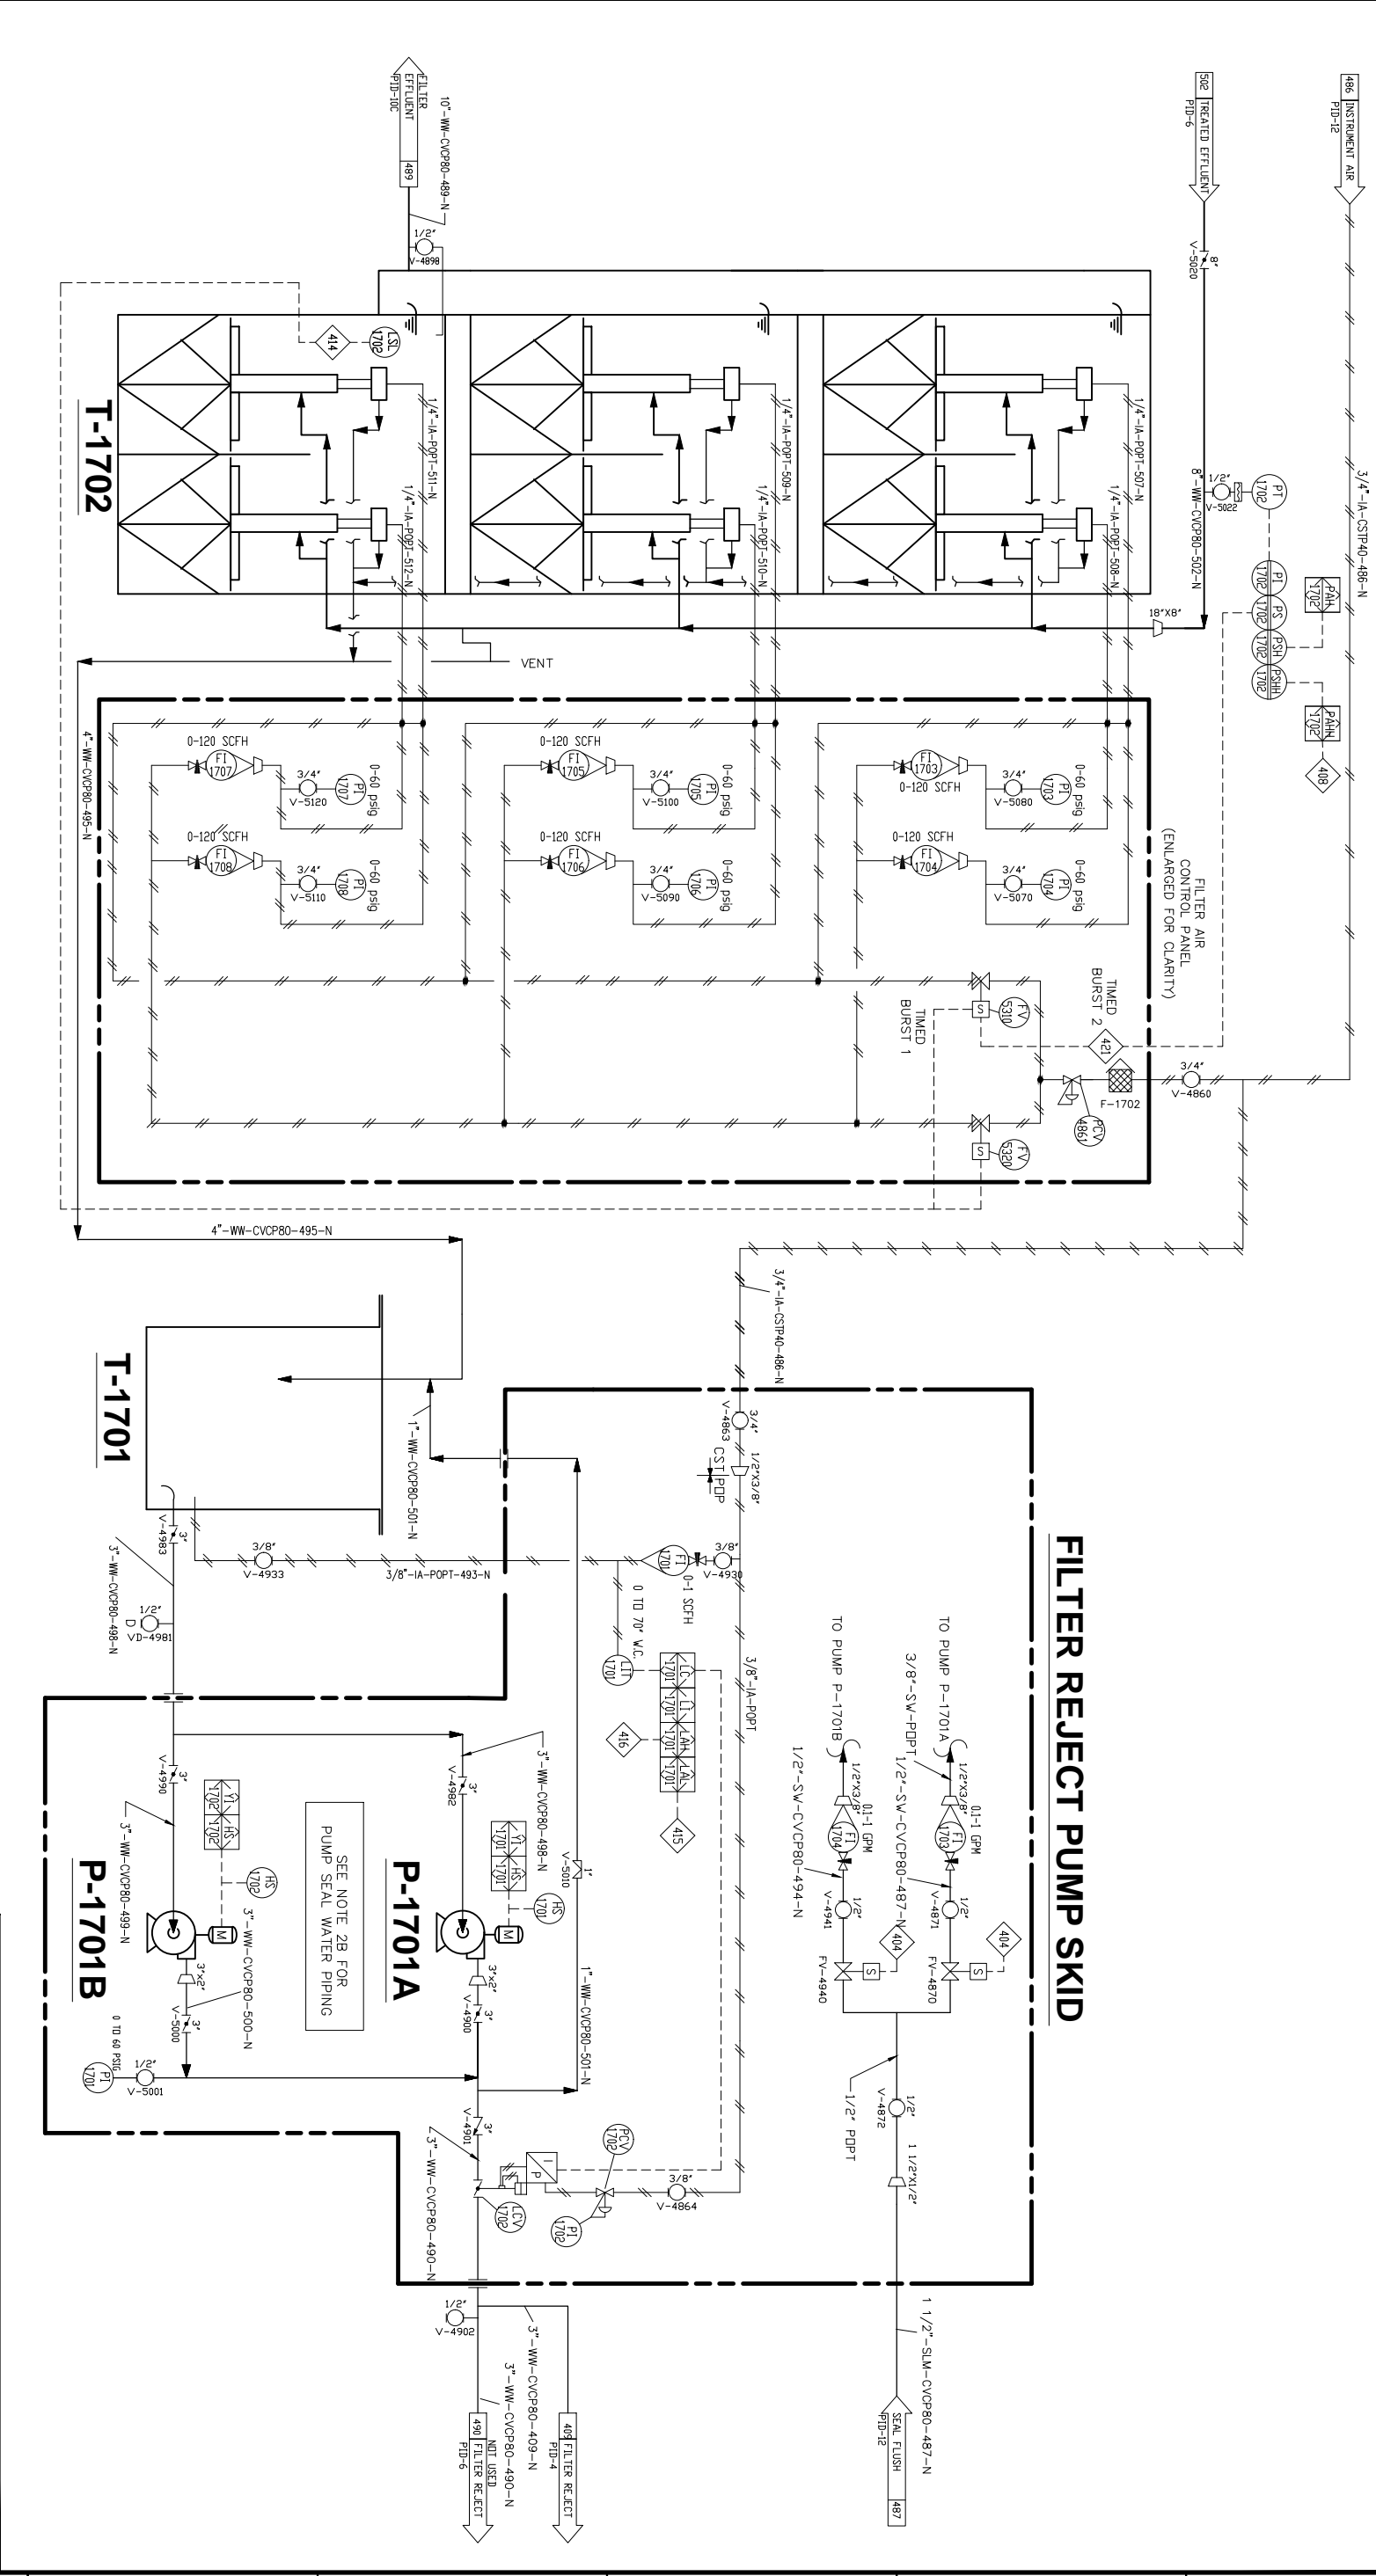

T-1701 FILTER REJECT TANK	P-1701A, 1701B FILTER REJECT PUMPS	T-1702 CONTINUOUS SAND FILTER	F-1702 AIR FILTER
SIZE: 6'-2" DIA. x 4'-9" STR. MATEL: HPPE CAPACITY: 1,000 GAL.	TYPE: HORIZONTAL CENTRIFUGAL MATEL: FRP CAPACITY: 150 GPM @ 50 FT MOTOR: 5 HP, 460 VAC, 3 PH MODEL: FBRC0 1500 (2X3X8)	TYPE: PARKSON DRY SAND MATEL: CONCRETE BASIN, FRP, CPVC, TITANIUM HARDWARE MEDIA: SAND SURFACE AREA: 300 FT ² NO. OF DELTS: 6	LIQUID REJECT VALVE MAX. LID. L/D: 10 SOLID PARTICLE PRESSION PREC. STRIP MODEL:

U.S. PATENTS 5750028, 5788842, 6706521 AND PATENTS PENDING.	ENVIROGEN TECHNOLOGIES 250 PHILLIPS BLVD SUITE 255 EVINGTON, NJ 08018	A Lifecycle Performance Company
---	---	---------------------------------

ALL INFORMATION CONTAINED ON THIS DOCUMENT IS THE PROPERTY OF ENVIROGEN TECHNOLOGIES, INC. ("ENVIROGEN") AND/OR ITS AFFILIATES. THE DESIGN CONCEPTS AND INFORMATION CONTAINED HEREIN ARE PROPERTY OF ENVIROGEN AND ARE SUBMITTED IN CONFIDENCE. THEY ARE NOT TO BE REPRODUCED OR TRANSMITTED IN ANY FORM OR BY ANY MEANS, ELECTRONIC OR MECHANICAL, INCLUDING PHOTOCOPYING, RECORDING, OR BY ANY INFORMATION STORAGE AND RETRIEVAL SYSTEM, WITHOUT THE EXPRESS WRITTEN CONSENT OF ENVIROGEN. ENVIROGEN ASSUMES NO RESPONSIBILITY OR LIABILITY FOR THE USE OF THIS DOCUMENT OR THE DESIGN CONCEPTS CONTAINED HEREIN FOR ANY PURPOSES OTHER THAN THAT FOR WHICH IT WAS ORIGINALLY INTENDED. USE OF THIS DOCUMENT IN NO EVENT SHALL THIS DOCUMENT OR THE DESIGN CONCEPTS CONTAINED HEREIN BE CONSIDERED AS A WARRANTY, REPRESENTATION, OR AGREEMENT OF ANY KIND. THE DESIGNER'S OBLIGATION OF PERFORMANCE AND OTHER RIGHTS ARE RESERVED. ACCEPTANCE OF THE DELIVERY OF THIS DOCUMENT CONSTITUTES AGREEMENT TO THESE TERMS AND CONDITIONS.


NOTE:
THIS DRAWING CONTAINS ALL NEW/NON-EXISTENT EQUIPMENT EXCEPT AS NOTED.

REV.	DATE	DESCRIPTION OF REVISION	DESIGNED BY	CHECKED BY	DATE
1	11-15-13	RECORD DRAWING - REFER FOR 2013 CURRENT OPERATIONS & REFER DEM MANUAL	DM	RE	DM
2	3-28-16	RECORD DRAWING	DM	RE	DM
3	4-28-16	ISSUED FOR CONSTRUCTION (UNDER MODIFICATIONS)	K	RE	DM
4	12-27-16	ISSUED FOR CONSTRUCTION	DM	RE	DM

THIS IS A COMPUTER GENERATED DRAWING AND ONLY EDITS CONSISTENT WITH ENVIROGEN'S ORIGINAL CAD FORMAT SHALL BE CONSIDERED VALID COPIES.

DESIGNED BY/DATE	DM / 03-15-05
CHECKED BY/DATE	DM / 03-18-05
SCALE	AS SHOWN
SHEET NO.	3

PIPING & INSTRUMENTATION DIAGRAM	HENDERSON, NV
SAND FILTER	1373-PID17

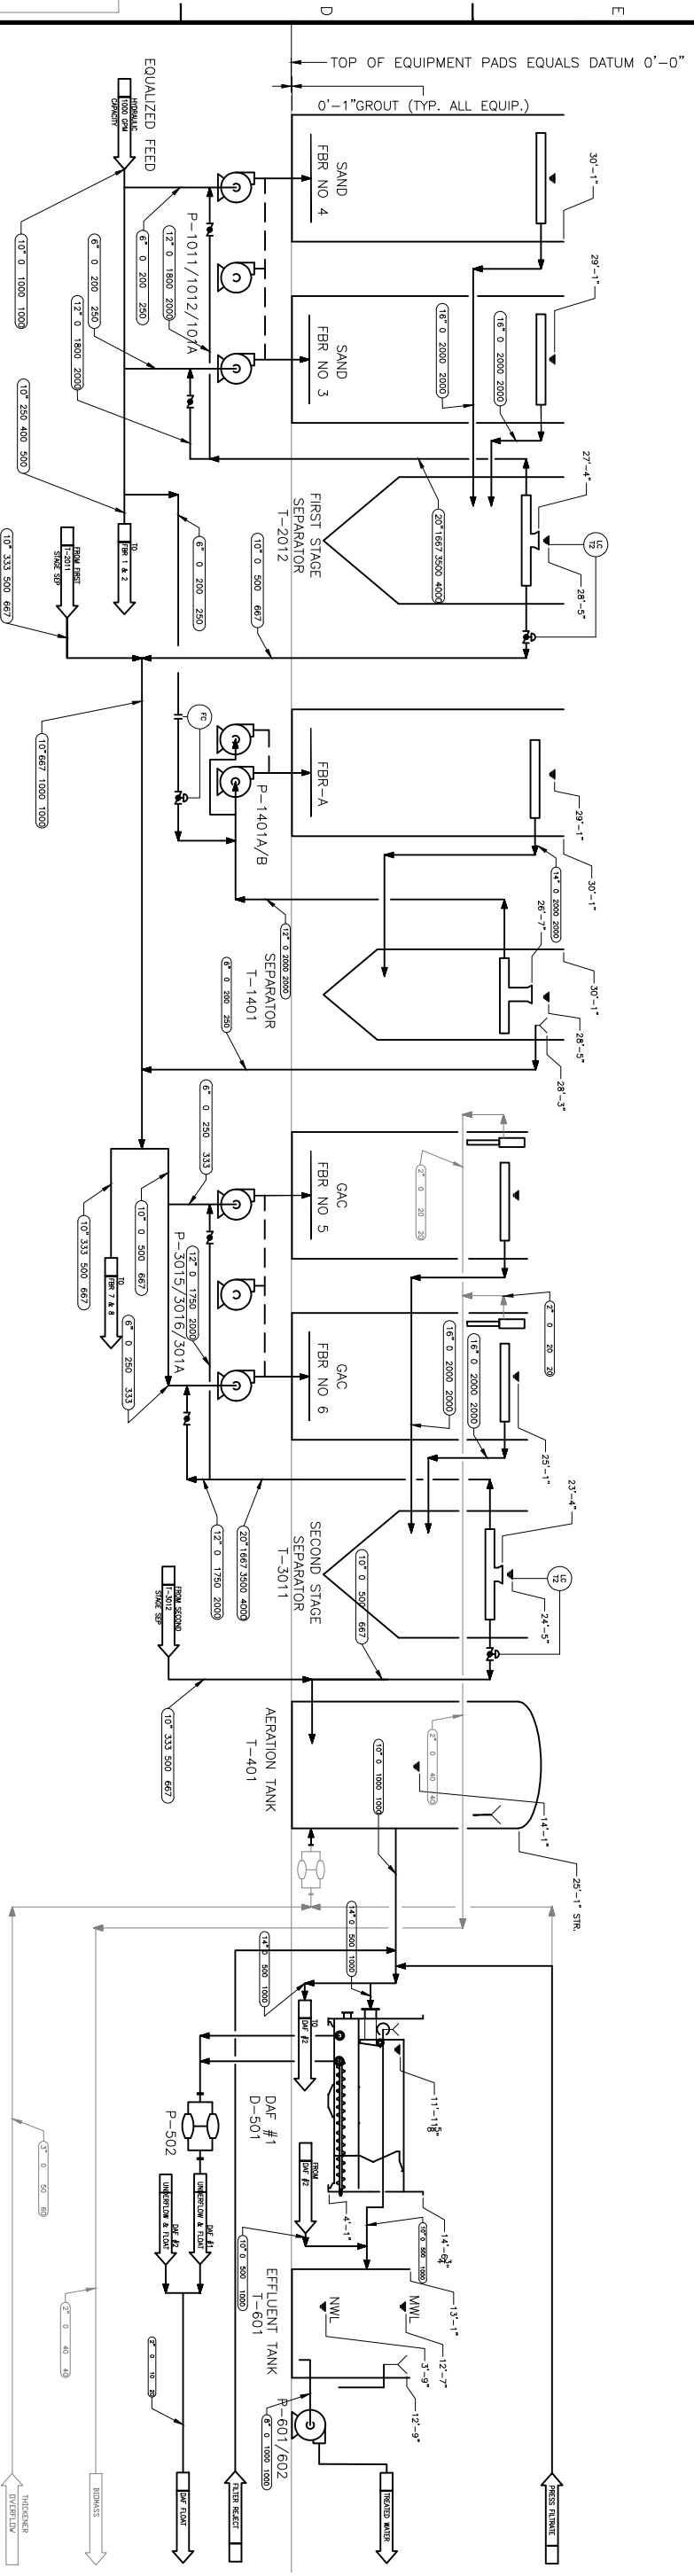


GENERAL NOTE:

- 1. (10" 0 500 1000)
- PIPE SIZE
- MIN FLOW
- DESIGN FLOW
- MAX FLOW

REV#	DATE	DESCRIPTION OF REVISION	DESIGNED BY/DATE	CHECKED BY/DATE
1	11-16-13	RECORD DRAWING - REVISED FOR 2013 CURRENT REGULATIONS & REVISED O&M MANUAL	RL	DW
2	10-14-14	RECORD DRAWING - AS NOTED	DW	RL
3	5-28-16	RECORD DRAWING	DW	RL
4	4-12-16	ISSUED FOR CONSTRUCTION, REVISE DRAWING SHEET 2	RL	RL
5	12-27-16	ISSUED FOR CONSTRUCTION	DW	RL
			DESIGNED BY/DATE	CHECKED BY/DATE
			RL / 1-7-03	DW / 1-7-03
			RL / 12-20-05	DW / 12-20-05

U.S. PATENTS 5750028, 5788842, 6706521 AND PATENTS PENDING.

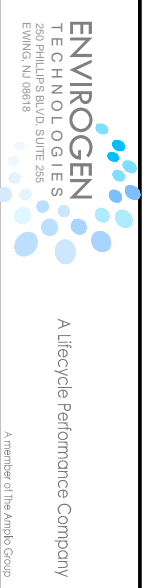

ALL INFORMATION CONTAINED ON THIS DOCUMENT IS THE PROPERTY OF ENVIROGEN TECHNOLOGIES, INC. (ENVIROGEN) AND/OR ITS AFFILIATES. THE DESIGN CONCEPTS AND INFORMATION CONTAINED HEREIN ARE PROPERTY OF ENVIROGEN AND ARE SUBMITTED IN CONFIDENCE. THEY ARE NOT TRANSFERABLE AND MUST BE USED ONLY FOR THE PROJECT AND SITE SPECIFICALLY IDENTIFIED HEREIN. NO PART OF THIS DOCUMENT IS TO BE REPRODUCED, COPIED, LOANED OR USED IN ANY OTHER MANNER WITHOUT THE EXPRESS WRITTEN CONSENT OF ENVIROGEN. ENVIROGEN ASSUMES NO RESPONSIBILITY OR LIABILITY FOR THE USE OF THIS DOCUMENT OR THE DESIGN CONCEPTS CONTAINED HEREIN FOR ANY PROJECT OTHER THAN THAT SPECIFICALLY IDENTIFIED HEREIN. ENVIROGEN'S ORIGINAL INTENDED USE OF THIS DOCUMENT IN NO EVENT SHALL THIS DOCUMENT OR THE DESIGN CONCEPTS CONTAINED HEREIN BE USED FOR ANY OTHER PROJECT OR SITE. ENVIROGEN'S CUSTOMER SHALL BE RESPONSIBLE FOR THE PROTECTION OF THE RIGHTS AND OBLIGATIONS OF ENVIROGEN AND ITS CUSTOMER AND OTHER RIGHTS ARE RESERVED. ACCEPTANCE OF THIS DOCUMENT CONSTITUTES AGREEMENT TO THESE TERMS AND CONDITIONS.

HYDRAULIC PROFILE
 FLUIDIZED BED PERCHLORATE
 TREATMENT SYSTEM
 SHEET 1 OF 2

APPENDIX I

ENGINEERING LISTS

- Valve List
- Line List
- Instrument List

VALVE LIST

Nevada Environmental Response Trust (NERT)
Perchlorate Treatment System
Henderson, NV

	Valve No.	Valve size (in.)	Valve Type	Valve Spec.	Comment
1A	V-LATER	6"	BUTTERFLY	BUV1	FEED LINE B
1A	V-1020	6"	BUTTERFLY	BUV1	FEED LINE A
1A	V-1050	1/4"	BALL		COPLANAR, FE-1010
1A	V-1060	1/4"	BALL		COPLANAR, FE-1020
1A	FCV-1010	6"	ACTUATED	BUV1	FEED LINE A
1A	PCV-1010	1/4"	REGULATOR		FCV-1010
1A	V-1070	3/8"	BALL	BAV2	AIR FEED TO PCV-1010
1A	FCV-1020	6"	ACTUATED	BUV1	FEED LINE B
1A	PCV-1020	1"	REGULATOR		FCV-1020
1A	V-1080	3/8"	BALL	BAV2	AIR FEED TO PCV-1020
1A	V-1090	1/2"	CHECK	CHV3	PH FEED TO FEED LINE A
1A	V-1100	1/2"	CHECK	CHV3	PH FEED TO FEED LINE B
1A	V-1110	1/2"	BALL	BAV1	PH FEED TO FEED LINE A
1A	V-1120	1/2"	BALL	BAV1	PH FEED TO FEED LINE B
1A	V-1130	1/2"	BALL	BAV1	PI-1040
1A	V-1140	1/2"	BALL	BAV1	PI-1050
1A	V-1150	1/2"	BALL	BAV1	AP-1020
1A	V-1160	1/2"	BALL	BAV1	AP-1030
1A	V-1170	6"	BUTTERFLY	BUV1	FEED PUMP P-1011
1A	V-1180	6"	BUTTERFLY	BUV1	FEED PUMP P-1012
1A	V-1190	6"	BUTTERFLY	BUV1	FEED PUMP P-101A (ALT)
1A	V-1200	6"	BUTTERFLY	BUV1	FEED PUMP P-101A (ALT)
1A	V-1210	1/2"	BALL	BAV2	AIR FEED TO PUMP SKID
1A	V-1220	1/2"	BALL	BAV2	AIR FEED TO FBR-1 & 2
1A	V-1251	1"	BALL	BAV1	S-1011
1A	V-108A	1"	BALL	BAV1	S-101A
1A	V-1252	1"	BALL	BAV1	S-1012
P-101A	V-101A	12"	BUTTERFLY	BUV2	FEED TO PUMP P-101A(ALT)
P-101A	V-102A	1/2"	BALL	BAV1	PI-101A
P-101A	V-103A	1/2"	BALL	BAV1	AP-101A
P-101A	V-104A	12"	BUTTERFLY	BUV2	DISCH PUMP P-101A(ALT)
P-101A	V-105A	12"	CHECK	CHV1	DISCH PUMP P-101A(ALT)
P-101A	V-106A	12"	BUTTERFLY	BUV2	DISCH PUMP P-101A(ALT) TO FBR-1
P-101A	V-107A	12"	BUTTERFLY	BUV2	DISCH PUMP P-101A (ALT) TO FBR-2
P-1011	V-1011	12"	BUTTERFLY	BUV2	FEED TO PUMP P-1011
P-1011	V-1021	1/2"	BALL	BAV2	PI-1011
P-1011	V-1031	1/2"	BALL	BAV2	AP-1011
P-1011	V-1041	12"	BUTTERFLY	BUV2	DISCH PUMP P-1011
P-1011	V-1051	12"	CHECK	CHV1	DISCH PUMP P-1011
P-1011	V-1061	1/2"	BALL	BAV2	NUTRIENT FEED TO FBR-1
P-1011	V-1071	1/2"	CHECK	CHV3	NUTRIENT FEED TO FBR-1
P-1011	V-1081	1/2"	BALL	BAV2	ELECT DONOR FEED TO FBR-1
P-1011	V-1091	1/2"	CHECK	CHV3	ELECT DONOR FEED TO FBR-1
P-1011	V-1101	1/2"	BALL	BAV2	AE-1011
P-1011	V-1111	1/2"	BALL	BAV2	PS-1011
P-1011	V-1121	1/4"	BALL		COPLANAR
P-1011	FV-1011	10"	ACTUATED	BUV2	FBR-1 INLET
P-1011	V-1131	10"	BUTTERFLY	BUV2	RATE SET FOR FBR-1
P-1011	V-1141	1/2"	BALL	BAV2	PI-1021
P-1011	V-1230	3/8"	BALL	BAV2	FC-1011
FBR-1	V-1151	3"	BALL	BAV1	FBR-1 NOZZLE W/STRAINER
FBR-1	V-1161	3"	PLUG	PGV2	FBR-1 DRAIN
FBR-1	V-1171	2"	BALL	BAV1	P-1021 INTAKE
FBR-1	V-1181	2"	BALL	BAV1	P-1021 INTAKE
FBR-1	V-1191	1/2"	BALL	BAV1	PI-1031
FBR-1	V-1201	1/2"	BALL	BAV1	AP-1021
FBR-1	V-1211	2"	PINCH	PIV1	P-1021 DISCH
FBR-1	V-1221	1"	BALL	BAV1	FBR-1 DISCH TO ORP FEED
FBR-1	V-1231	1"	BALL	BAV1	INLET TO AE-1021
FBR-1	V-1241	1"	BALL	BAV1	OUTLET FROM AE-1021
P-1012	V-1012	12"	BUTTERFLY	BUV2	FEED TO PUMP P-1012
P-1012	V-1022	1/2"	BALL	BAV1	PI-1012
P-1012	V-1032	1/2"	BALL	BAV1	AP-1012
P-1012	V-1042	12"	BUTTERFLY	BUV2	DISCH PUMP P-1012
P-1012	V-1052	12"	CHECK	CHV1	DISCH PUMP P-1012
P-1012	V-1062	1/2"	BALL	BAV1	NUTRIENT FEED TO FBR-2

Nevada Environmental Response Trust (NERT)
Perchlorate Treatment System
Henderson, NV

	Valve No.	Valve size (in.)	Valve Type	Valve Spec.	Comment
P-1012	V-1072	1/2"	CHECK	CHV3	NUTRIENT FEED TO FBR-2
P-1012	V-1082	1/2"	BALL	BAV1	ELECT DONOR FEED TO FBR-2
P-1012	V-1092	1/2"	CHECK	CHV3	ELECT DONOR FEED TO FBR-2
P-1012	V-1102	1/2"	BALL	BAV1	AE-1012
P-1012	V-1112	1/2"	BALL	BAV1	PS-1012
P-1012	V-1122	1/4"	BALL		COPLANAR
P-1012	FV-1012	10"	ACTUATED	BUV2	FBR-2 INLET
P-1012	V-1132	10"	BUTTERFLY	BUV2	RATE SET FOR FBR-2
P-1012	V-1142	1/2"	BALL	BAV1	PI-1022
P-1012	V-1240	3/8"	BALL	BAV2	FC-1012
FBR-2	V-1152	3"	BALL	BAV1	FBR-2 NOZZLE W/STRAINER
FBR-2	V-1162	3"	PLUG	PGV2	FBR-2 DRAIN
FBR-2	V-1172	2"	BALL	BAV1	P-1022 INTAKE
FBR-2	V-1182	2"	BALL	BAV1	P-1022 INTAKE
FBR-2	V-1192	1/2"	BALL	BAV1	PI-1032
FBR-2	V-1202	1/2"	BALL	BAV1	AP-1022
FBR-2	V-1212	2"	PINCH	PIV1	P-1022 DISCH
FBR-2	V-1222	1"	BALL	BAV1	FBR-2 DISCH TO ORP FEED
FBR-2	V-1232	1"	BALL	BAV1	INLET TO AE-1022
FBR-2	V-1242	1"	BALL	BAV1	OUTLET FROM AE-1022
1B	V-1340	6"	BUTTERFLY	BUV1	FEED LINE D
1B	V-1330	6"	BUTTERFLY	BUV1	FEED LINE C
1B	V-1350	1/4"	BALL		COPLANAR
1B	V-1360	1/4"	BALL		COPLANAR
1B	FCV-1110	6"	ACTUATED	BUV1	FEED LINE C
1B	PCV-1110	1/4"	REGULATOR		FCV-1110
1B	V-1370	3/8"	BALL	BAV2	AIR FEED TO PCV-1110
1B	FCV-1120	6"	ACTUATED	BUV1	FEED LINE D
1B	PCV-1120	1/4"	REGULATOR		FCV-1120
1B	V-1370	3/8"	BALL	BAV2	AIR FEED TO PCV-1120
1B	V-1390	1/2"	CHECK	CHV3	PH FEED TO FEED LINE C
1B	V-1400	1/2"	CHECK	CHV3	PH FEED TO FEED LINE D
1B	V-1410	1/2"	BALL	BAV1	PH FEED TO FEED LINE C
1B	V-1420	1/2"	BALL	BAV1	PH FEED TO FEED LINE D
1B	V-1430	1/2"	BALL	BAV1	PI-1140
1B	V-1440	1/2"	BALL	BAV1	PI-1150
1B	V-1450	1/2"	BALL	BAV1	AP-1120
1B	V-1460	1/2"	BALL	BAV1	AP-1130
1B	V-1470	6"	BUTTERFLY	BUV1	FEED PUMP P-1013
1B	V-1480	6"	BUTTERFLY	BUV1	FEED PUMP P-1014
1B	V-1490	6"	BUTTERFLY	BUV1	FEED PUMP P-102A (ALT)
1B	V-1500	6"	BUTTERFLY	BUV1	FEED PUMP P-102A (ALT)
1B	V-1510	1/2"	BALL	BAV2	AIR FEED TO PUMP SKID
1B	V-1520	1/2"	BALL	BAV2	AIR FEED TO FBR-3 & 4
1B	V-1253	1"	BALL	BAV1	S-1013
1B	V-108A	1"	BALL	BAV1	S-102A
1B	V-1254	1"	BALL	BAV1	S-1014
P-102A	V-111A	12"	BUTTERFLY	BUV2	FEED TO PUMP P-102A (ALT)
P-102A	V-112A	1/2"	BALL	BAV1	PI-102A
P-102A	V-113A	1/2"	BALL	BAV1	AP-102A
P-102A	V-114A	12"	BUTTERFLY	BUV2	DISCH PUMP P-102A (ALT)
P-102A	V-115A	12"	CHECK	CHV1	DISCH PUMP P-102A (ALT)
P-102A	V-116A	12"	BUTTERFLY	BUV2	DISCH PUMP P-102A(ALT) TO FBR-3
P-102A	V-1530	12"	BUTTERFLY	BUV2	DISCH PUMP P-102A (ALT) TO FBR-4
P-1013	V-1013	12"	BUTTERFLY	BUV2	FEED TO PUMP P-1013
P-1013	V-1023	1/2"	BALL	BAV2	PI-1013
P-1013	V-1033	1/2"	BALL	BAV2	AP-1013
P-1013	V-1043	12"	BUTTERFLY	BUV2	DISCH PUMP P-1013
P-1013	V-1053	12"	CHECK	CHV1	DISCH PUMP P-1013
P-1013	V-1063	1/2"	BALL	BAV2	NUTRIENT FEED TO FBR-3
P-1013	V-1073	1/2"	CHECK	CHV3	NUTRIENT FEED TO FBR-3
P-1013	V-1083	1/2"	BALL	BAV2	ELECT DONOR FEED TO FBR-3
P-1013	V-1093	1/2"	CHECK	CHV3	ELECT DONOR FEED TO FBR-3
P-1013	V-1103	1/2"	BALL	BAV2	AE-1013
P-1013	V-1113	1/2"	BALL	BAV2	PS-1013
P-1013	V-1123	1/4"	BALL		COPLANAR

Nevada Environmental Response Trust (NERT)
Perchlorate Treatment System
Henderson, NV

	Valve No.	Valve size (in.)	Valve Type	Valve Spec.	Comment
P-1013	FV-1013	10"	ACTUATED	BUV2	FBR-3 INLET
P-1013	V-1133	10"	BUTTERFLY	BUV2	RATE SET FOR FBR-3
P-1013	V-1143	1/2"	BALL	BAV2	PI-1023
P-1013	V-1530	3/8"	BALL	BAV2	AIR FEED TO FV-1013
FBR-3	V-1153	3"	BALL	BAV1	FBR-3 NOZZLE W/STRAINER
FBR-3	V-1163	3"	PLUG	PGV2	FBR-3 DRAIN
FBR-3	V-1173	2"	BALL	BAV1	P-1023 INTAKE
FBR-3	V-1183	2"	BALL	BAV1	P-1023 INTAKE
FBR-3	V-1193	1/2"	BALL	BAV1	PI-1033
FBR-3	V-1203	1/2"	BALL	BAV1	AP-1023
FBR-3	V-1213	2"	PINCH	PIV1	P-1023 DISCH
FBR-3	V-1223	1"	BALL	BAV1	FBR-3 DISCH TO ORP FEED
FBR-3	V-1233	1"	BALL	BAV1	INLET TO AE-1023
FBR-3	V-1243	1"	BALL	BAV1	OUTLET FROM AE-1023
P-1014	V-1014	12"	BUTTERFLY	BUV2	FEED TO PUMP P-1014
P-1014	V-1024	1/2"	BALL	BAV2	PI-1014
P-1014	V-1034	1/2"	BALL	BAV2	AP-1014
P-1014	V-1044	12"	BUTTERFLY	BUV2	DISCH PUMP P-1014
P-1014	V-1054	12"	CHECK	CHV1	DISCH PUMP P-1014
P-1014	V-1064	1/2"	BALL	BAV2	NUTRIENT FEED TO FBR-4
P-1014	V-1074	1/2"	CHECK	CHV3	NUTRIENT FEED TO FBR-4
P-1014	V-1084	1/2"	BALL	BAV2	ELECT DONOR FEED TO FBR-4
P-1014	V-1094	1/2"	CHECK	CHV3	ELECT DONOR FEED TO FBR-4
P-1014	V-1104	1/2"	BALL	BAV2	AE-1014
P-1014	V-1114	1/2"	BALL	BAV2	PS-1014
P-1014	V-1124	1/4"	BALL		COPLANAR
P-1014	FV-1014	10"	ACTUATED	BUV2	FBR-4INLET
P-1014	V-1134	10"	BUTTERFLY	BUV2	RATE SET FOR FBR-4
P-1014	V-1144	1/2"	BALL	BAV2	PI-1024
P-1014	V-1540	3/8"	BALL	BAV2	AIR FEED TO FV-1014
FBR-4	V-1154	3"	BALL	BAV1	FBR-4 NOZZLE W/STRAINER
FBR-4	V-1164	3"	PLUG	PGV2	FBR-4 DRAIN
FBR-4	V-1174	2"	BALL	BAV1	P-1024 INTAKE
FBR-4	V-1184	2"	BALL	BAV1	P-1024INTAKE
FBR-4	V-1194	1/2"	BALL	BAV1	PI-1034
FBR-4	V-1204	1/2"	BALL	BAV1	AP-1024
FBR-4	V-1214	2"	PINCH	PIV1	P-1024 DISCH
FBR-4	V-1224	1"	BALL	BAV1	FBR-4 DISCH TO ORP FEED
FBR-4	V-1234	1"	BALL	BAV1	INLET TO AE-1024
FBR-4	V-1244	1"	BALL	BAV1	OUTLET FROM AE-1024
2A	V-2011	1 1/2"	DIAPHRAGM	DIV4	T-2011 SIDE DRAIN
2A	V-2021	4"	PLUG	PGV2	T-2011 CONE DRAIN
2A	V-2031	1 1/2"	DIAPHRAGM	DIV4	T-2011 DISCH
2A	FV-2011	1 1/2"	ACTUATED	DIV4	T-2011 DISCH
2A	FV-2021	1"	ACTUATED	BAV1	SERVICE WATER INLET
2A	FV-2031	1 1/2"	ACTUATED	DIV4	P-2011 INLET
2A	V-2041	1 1/2"	BALL	BAV1	SERVICE WATER INLET
2A	V-2051	1 1/2"	CHECK	CHV2	SERVICE WATER INLET
2A	V-2061	1 1/2"	DIAPHRAGM	DIV4	P-2011 DISCH TO FBR-1
2A	V-2071	1 1/2"	DIAPHRAGM	DIV4	P-2011 DISCH TO FBR-2
2A	LCV-2011	10"	ACTUATED	BUV2	T-2011 FBR EFFLUENT
2A	PCV-2011	3/8"	REGULATOR		AIR FEED TO LCV-2011
2A	V-2081	1/2"	BALL	BAV2	AIR FEED TO FV-2011
2A	V-2091	1/2"	BALL	BAV2	AIR FEED TO BUBLER & LCV-2011
2A	V-2101	3/8"	BALL	BAV2	AIR FEED TO LCV-2011
2A	V-2111	1"	BALL	BAV1	CPVC, P-2011 INLET DRAIN
2A	V-2151	3/8"	BALL	BAV2	AIR FEED TO FV-2011
2A	V-2131	3/8"	BALL	BAV2	AIR FEED TO FV-2021
2A	V-2141	3/8"	BALL	BAV2	AIR FEED TO FV-2031
2A	V-2121	3/8"	BALL	BAV2	AIR FEED TO FI-2011
2A	V-2161	3/8"	BALL	BAV2	FROM FI-2011
2A	V-2171	3/8"	BALL	BAV2	FROM FI-2011
2B	V-2012	1 1/2"	DIAPHRAGM	DIV4	T-2012 SIDE DRAIN
2B	V-2022	4"	PLUG	PGV2	T-2012 CONE DRAIN
2B	V-2032	1 1/2"	DIAPHRAGM	DIV4	T-2012 DISCH
2B	FV-2012	1 1/2"	ACTUATED	DIV4	T-2012 DISCH

Nevada Environmental Response Trust (NERT)
Perchlorate Treatment System
Henderson, NV

	Valve No.	Valve size (in.)	Valve Type	Valve Spec.	Comment
2B	FV-2022	1"	ACTUATED	BAV1	SERVICE WATER INLET
2B	FV-2032	1 1/2"	ACTUATED	DIV4	P-2012 INLET
2B	V-2042	1 1/2"	BALL	BAV1	SERVICE WATER INLET
2B	V-2052	1 1/2"	CHECK	CHV2	SERVICE WATER INLET
2B	V-2062	1 1/2"	DIAPHRAGM	DIV4	P-2012 DISCH TO FBR-3
2B	V-2072	1 1/2"	DIAPHRAGM	DIV4	P-2012 DISCH TO FBR-4
2B	LCV-2012	10"	ACTUATED	BUV2	T-2012 FBR EFFLUENT
2B	PCV-2012	3/8"	REGULATOR		AIR FEED TO LCV-2012
2B	V-2082	1/2"	BALL	BAV2	AIR FEED TO FV-2012
2B	V-2092	1/2"	BALL	BAV2	AIR FEED TO BUBLER & LCV-2012
2B	V-2102	3/8"	BALL	BAV2	AIR FEED TO LCV-2012
2B	V-2122	3/8"	BALL	BAV2	AIR FEED TO FI-2012
2B	V-2132	3/8"	BALL	BAV2	AIR FEED TO FV-2022
2B	V-2142	3/8"	BALL	BAV2	AIR FEED TO FV-2032
2B	V-2152	3/8"	BALL	BAV2	AIR FEED TO FV-2012
2B	V-2112	1"	BALL	BAV1	CPVC, P-2012 INLET DRAIN
2B	V-2162	3/8"	BALL	BAV2	FROM FI-2012
2B	V-2172	3/8"	BALL	BAV2	FROM FI-2012
3A	V-3000	10"	BUTTERFLY	BUV2	1 ST. STAGE 1&2 EFFLUENT
3A	V-3020	10"	BUTTERFLY	BUV2	2 ND. STAGE BY-PASS
3A	V-3010	10"	BUTTERFLY	BUV2	1 ST. STAGE 3 & 4 EFFLUENT
3A	V-3030	1/2"	BALL	BAV1	PI-3000
3A	V-3050	1/4"	BALL		COPLANAR, FE3020
3A	V-3060	1/4"	BALL		COPLANAR, FE3010
3A	V-3040	1/2"	BALL	BAV1	AP-3000
3A	FCV-3010	6"	ACTUATED	BUV1	FEED LINE A
3A	FCV-3020	6"	ACTUATED	BUV1	FEED LINE B
3A	V-3090	1/2"	CHECK	CHV3	PH FEED
3A	V-3100	1/2"	CHECK	CHV3	PH FEED
3A	V-3110	1/2"	BALL	BAV1	PH FEED
3A	V-3120	1/2"	BALL	BAV1	PH FEED
3A	V-3130	1/2"	BALL	BAV1	PI-3010
3A	V-3140	1/2"	BALL	BAV1	PI-3020
3A	V-3150	1/2"	BALL	BAV1	AP-3010
3A	V-3160	1/2"	BALL	BAV1	AP-3020
3A	V-3170	6"	BUTTERFLY	BUV1	FEED PUMP P-3015
3A	V-3180	6"	BUTTERFLY	BUV1	FEED PUMP P-3016
3A	V-3190	6"	BUTTERFLY	BUV1	FEED PUMP P-301A (ALT)
3A	V-3200	6"	BUTTERFLY	BUV1	FEED PUMP P-301A (ALT)
3A	V-3015	12"	BUTTERFLY	BUV2	FEED TO PUMP P-3015
3A	V-301A	12"	BUTTERFLY	BUV2	FEED TO PUMP P-301A
3A	V-3016	12"	BUTTERFLY	BUV2	FEED TO PUMP P-3016
3A	V-3210	1/2"	BALL	BAV2	AIR FEED TO FCV-3010 & 3020
3A	V-3220	1/2"	BALL	BAV2	AIR FEED TO FCV-3015 & 3016
3A	PCV-3010	1/4"	REGULATOR		FCV-3010
3A	V-3070	3/8"	BALL	BAV2	AIR FEED TO PCV-3010
3A	PCV-3020	1/4"	REGULATOR		FCV-3020
3A	V-3080	3/8"	BALL	BAV2	AIR FEED TO PCV-3020
3A	V-3255	1"	BALL	BAV1	S-3015
3A	V-308A	1"	BALL	BAV1	S-301A
3A	V-3256	1"	BALL	BAV1	S-3016
P-301A	V-302A	1/2"	BALL	BAV1	PI-301A
P-301A	V-303A	1/2"	BALL	BAV1	AP-301A
P-301A	V-304A	12"	BUTTERFLY	BUV2	P-301A DISCH
P-301A	V-305A	12"	CHECK	CHV1	P-301A DISCH
P-301A	V-306A	12"	BUTTERFLY	BUV2	DISCH P-301A TO FBR-5
P-301A	V-307A	12"	BUTTERFLY	BUV2	DISCH P-301A TO FBR-6
P-3015	V-3025	1/2"	BALL	BAV1	PI-3015
P-3015	V-3035	1/2"	BALL	BAV1	AP-3015
P-3015	V-3045	12"	BUTTERFLY	BUV2	P-3015 DISCH
P-3015	V-3055	12"	CHECK	CHV1	P-3015 DISCH
P-3015	V-3065	1/2"	BALL	BAV1	NUTRIENT FEED
P-3015	V-3075	1/2"	CHECK	CHV3	NUTRIENT FEED
P-3015	V-3085	1/2"	BALL	BAV1	ELECTR DONOR FEED
P-3015	V-3095	1/2"	CHECK	CHV3	ELECTR DONOR FEED
P-3015	V-3105	1/2"	BALL	BAV1	AE-3015

Nevada Environmental Response Trust (NERT)
Perchlorate Treatment System
Henderson, NV

	Valve No.	Valve size (in.)	Valve Type	Valve Spec.	Comment
P-3015	V-3115	1/2"	BALL	BAV1	PS-3015
P-3015	V-3125	1/4"	BALL		COPLANAR
P-3015	FV-3015	10"	ACTUATED	BUV2	FBR-5 INLET
P-3015	V-3135	10"	BUTTERFLY	BUV2	RATE SET FOR FBR-5
P-3015	V-3145	1/2"	BALL	BAV1	PI-3025
P-3015	V-3265	3/8"	BALL	BAV2	STEEL, AIR FEED TO FV-3015
FBR-5	V-3155	3"	BALL	BAV1	FBR-5 NOZZLE W/STRAINER
FBR-5	V-3165	3"	PLUG	PGV2	FBR-5 DRAIN
FBR-5	V-3175	1"	BALL	BAV1	ORP AE3025
FBR-5	V-3205	1"	DIAPHRAGM	DIV1	SERVICE WATER TO FBR-5
FBR-5	V-3215	1/2"	BALL	BAV1	PI-3035
FBR-5	V-3225	1/2"	BALL	BAV2	AIR FEED TO BIOMASS CNTRL PNLS
FBR-5	V-3235	1/4"	BALL	BAV3	AIR FEED TO BIOMASS CNTRL PNL A
FBR-5	PCV-3055	1/4"	REGULATOR		AIR FEED TO BIOMASS CNTRL PNL A
FBR-5	V-3245	1/4"	BALL	BAV3	AIR FEED TO BIOMASS CNTRL PNL B
FBR-5	PCV-3045	1/4"	REGULATOR		AIR FEED TO BIOMASS CNTRL PNL B
P-3016	V-3026	1/2"	BALL	BAV1	PI-3016
P-3016	V-3036	1/2"	BALL	BAV1	AP-3016
P-3016	V-3046	12"	BUTTERFLY	BUV2	P-3016 DISCH
P-3016	V-3056	12"	CHECK	CHV1	P-3016 DISCH
P-3016	V-3066	1/2"	BALL	BAV1	NUTRIENT FEED
P-3016	V-3076	1/2"	CHECK	CHV3	NUTRIENT FEED
P-3016	V-3086	1/2"	BALL	BAV1	ELECTR DONOR FEED
P-3016	V-3096	1/2"	CHECK	CHV3	ELECTR DONOR FEED
P-3016	V-3106	1/2"	BALL	BAV1	AE-3016
P-3016	V-3116	1/2"	BALL	BAV1	PS-3016
P-3016	V-3126	1/4"	BALL		COPLANAR
P-3016	FV-3016	10"	ACTUATED	BUV2	FBR-6 INLET
P-3016	V-3136	10"	BUTTERFLY	BUV2	RATE SET FOR FBR-6
P-3016	V-3146	1/2"	BALL	BAV1	PI-3026
P-3016	V-3266	3/8"	BALL	BAV2	STEEL, AIR FEED TO FV-3016
FBR-6	V-3156	3"	BALL	BAV1	FBR-6 NOZZLE W/STRAINER
FBR-6	V-3166	3"	PLUG	PGV2	FBR-6 DRAIN
FBR-6	V-3176	1"	BALL	BAV1	ORP AE3026
FBR-6	V-3206	1"	DIAPHRAGM	DIV1	SERVICE WATER TO FBR-6
FBR-6	V-3216	1/2"	BALL	BAV1	PI-3036
FBR-6	V-3226	1/2"	BALL	BAV2	AIR FEED TO BIOMASS CNTRL PNLS
FBR-6	V-3236	1/4"	BALL	BAV3	AIR FEED TO BIOMASS CNTRL PNL C
FBR-6	PCV-3026	1/4"	REGULATOR		AIR FEED TO BIOMASS CNTRL PNL C
FBR-6	V-3246	1/4"	BALL	BAV3	AIR FEED TO BIOMASS CNTRL PNL D
FBR-6	PCV-3046	1/4"	REGULATOR		AIR FEED TO BIOMASS CNTRL PNL D
P-3015	V-3185	1"	BALL	BAV1	AE-3025
P-3015	V-3195	1"	BALL	BAV1	AE-3025
P-3016	V-3186	1"	BALL	BAV1	AE-3026
P-3016	V-3196	1"	BALL	BAV1	AE-3026
3B	V-3330	1/2"	BALL	BAV1	PI-3100
3B	V-3340	1/2"	BALL	BAV1	AP-3100
3B	V-3320	10"	BUTTERFLY	BUV2	FBR- 7&8 EFFLUENT
3B	V-3350	1/4"	BALL		COPLANAR, FE3030
3B	V-3360	1/4"	BALL		COPLANAR, FE3040
3B	FCV-3040	6"	ACTUATED	BUV1	FEED LINE A
3B	FCV-3040	6"	ACTUATED	BUV1	FEED LINE B
3B	V-3390	1/2"	CHECK	CHV3	PH FEED
3B	V-3340	1/2"	CHECK	CHV3	PH FEED
3B	V-3410	1/2"	BALL	BAV1	PH FEED
3B	V-3420	1/2"	BALL	BAV1	PH FEED
3B	V-3430	1/2"	BALL	BAV1	PI-3110
3B	V-3440	1/2"	BALL	BAV1	PI-3120
3B	V-3450	1/2"	BALL	BAV1	AP-3110
3B	V-3460	1/2"	BALL	BAV1	AP-3120
3B	V-3470	6"	BUTTERFLY	BUV1	FEED PUMP P-3017
3B	V-3480	6"	BUTTERFLY	BUV1	FEED PUMP P-3018
3B	V-3490	6"	BUTTERFLY	BUV1	FEED PUMP P-302A (ALT)
3B	V-3500	6"	BUTTERFLY	BUV1	FEED PUMP P-302A (ALT)
3B	V-3017	12"	BUTTERFLY	BUV2	FEED TO PUMP P-3017
3B	V-3018	12"	BUTTERFLY	BUV2	FEED TO PUMP P-3018

Nevada Environmental Response Trust (NERT)
Perchlorate Treatment System
Henderson, NV

	Valve No.	Valve size (in.)	Valve Type	Valve Spec.	Comment
3B	V-311A	12"	BUTTERFLY	BUV2	FEED TO PUMP P-302A
3B	V-3510	1/2"	BALL	BAV2	AIR FEED TO FCV-3030 & 3040
3B	V-3520	1/2"	BALL	BAV2	AIR FEED TO FCV-3017 & 3018
3B	PCV-3110	1/4"	REGULATOR		FCV-3030
3B	V-3370	3/8"	BALL	BAV2	AIR FEED TO PCV-3030
3B	PCV-3120	1/4"	REGULATOR		FCV-3040
3B	V-3380	3/8"	BALL	BAV2	AIR FEED TO PCV-3040
3B	V-3257	1"	BALL	BAV1	S-3017
3B	V-318A	1"	BALL	BAV1	S-302A
3B	V-3258	1"	BALL	BAV1	S-3018
P-302A	V-312A	1/2"	BALL	BAV1	PI-302A
P-302A	V-313A	1/2"	BALL	BAV1	AP-302A
P-302A	V-314A	12"	BUTTERFLY	BUV2	P-302A DISCH
P-302A	V-315A	12"	CHECK	CHV1	P-302A DISCH
P-302A	V-316A	12"	BUTTERFLY	BUV2	DISCH P-302A TO FBR-7
P-302A	V-317A	12"	BUTTERFLY	BUV2	DISCH P-302A TO FBR-8
P-3017	V-3027	1/2"	BALL	BAV1	PI-3017
P-3017	V-3037	1/2"	BALL	BAV1	AP-3017
P-3017	V-3047	12"	BUTTERFLY	BUV2	P-3017 DISCH
P-3017	V-3057	12"	CHECK	CHV1	P-3017 DISCH
P-3017	V-3087	1/2"	BALL	BAV1	NUTRIENT FEED
P-3017	V-3097	1/2"	CHECK	CHV3	NUTRIENT FEED
P-3017	V-3067	1/2"	BALL	BAV1	ELECTR DONOR FEED
P-3017	V-3077	1/2"	CHECK	CHV3	ELECTR DONOR FEED
P-3017	V-3107	1/2"	BALL	BAV1	AE-3017
P-3017	V-3117	1/2"	BALL	BAV1	PS-3017
P-3017	V-3127	1/4"	BALL		COPLANAR
P-3017	FV-3017	10"	ACTUATED	BUV2	FBR-7 INLET
P-3017	V-3137	10"	BUTTERFLY	BUV2	RATE SET FOR FBR-7
P-3017	V-3147	1/2"	BALL	BAV1	PI-3027
P-3017	V-3267	3/8"	BALL	BAV2	STEEL, AIR FEED TO FV-3017
FBR-7	V-3157	3"	BALL	BAV1	FBR-7 NOZZLE W/STRAINER
FBR-7	V-3167	3"	PLUG	PGV2	FBR-5 DRAIN
FBR-7	V-3177	1"	BALL	BAV1	ORP-AE-3027, FBR-7 RECYCLE
FBR-7	V-3207	1"	DIAPHRAGM	DIV1	SERVICE WATER TO FBR-7
FBR-7	V-3037	1/2"	BALL	BAV1	PI-3037
FBR-7	V-3227	1/2"	BALL	BAV2	AIR FEED TO BIOMASS CNTRL PNLS
FBR-7	V-3237	1/4"	BALL	BAV3	AIR FEED TO BIOMASS CNTRL PNL A
FBR-7	PCV-3027	1/4"	REGULATOR		AIR FEED TO BIOMASS CNTRL PNL A
FBR-7	V-3247	1/4"	BALL	BAV3	AIR FEED TO BIOMASS CNTRL PNL B
FBR-7	PCV-3017	1/4"	REGULATOR		AIR FEED TO BIOMASS CNTRL PNL B
P-3018	V-3028	1/2"	BALL	BAV1	PI-3018
P-3018	V-3038	1/2"	BALL	BAV1	AP-3018
P-3018	V-3048	12"	BUTTERFLY	BUV2	P-3018 DISCH
P-3018	V-3058	12"	CHECK	CHV1	P-3018 DISCH
P-3018	V-3068	1/2"	BALL	BAV1	NUTRIENT FEED
P-3018	V-3078	1/2"	CHECK	CHV3	NUTRIENT FEED
P-3018	V-3088	1/2"	BALL	BAV1	ELECTR DONOR FEED
P-3018	V-3098	1/2"	CHECK	CHV3	ELECTR DONOR FEED
P-3018	V-3108	1/2"	BALL	BAV1	AE-3018
P-3018	V-3118	1/2"	BALL	BAV1	PS-3018
P-3018	V-3128	1/4"	BALL		COPLANAR
P-3018	FV-3018	10"	ACTUATED	BUV2	FBR-8 INLET
P-3018	V-3138	10"	BUTTERFLY	BUV2	RATE SET FOR FBR-8
P-3018	V-3148	1/2"	BALL	BAV1	PI-3028
P-3018	V-3268	3/8"	BALL	BAV2	STEEL, AIR FEED TO FV-3018
FBR-8	V-3158	3"	BALL	BAV1	FBR-8 NOZZLE W/STRAINER
FBR-8	V-3168	3"	PLUG	PGV2	FBR-8 DRAIN
FBR-8	V-3178	1"	BALL	BAV1	ORP-AE-3028, FBR-8 RECYCLE
FBR-8	V-3208	1"	DIAPHRAGM	DIV1	SERVICE WATER TO FBR-8
FBR-8	V-3218	1/2"	BALL	BAV1	PI-3038
FBR-8	V-3228	1/2"	BALL	BAV2	AIR FEED TO BIOMASS CNTRL PNLS
FBR-8	V-3238	1/4"	BALL	BAV3	AIR FEED TO BIOMASS CNTRL PNL C
FBR-8	PCV-3028	1/4"	REGULATOR		AIR FEED TO BIOMASS CNTRL PNL C
FBR-8	V-3248	1/4"	BALL	BAV3	AIR FEED TO BIOMASS CNTRL PNL D
FBR-8	PVC-3018	1/4"	REGULATOR		AIR FEED TO BIOMASS CNTRL PNL D

Nevada Environmental Response Trust (NERT)
Perchlorate Treatment System
Henderson, NV

	Valve No.	Valve size (in.)	Valve Type	Valve Spec.	Comment
FBR-8	V-3188	1"	BALL	BAV1	AE-3028
FBR-8	V-3198	1"	BALL	BAV1	AE-3028
FBR-8	V-3187	1"	BALL	BAV1	AE-3027
FBR-8	V-3197	1"	BALL	BAV1	AE-3027
3C	V-3611	1 1/2"	DIAPHRAGM	DIV4	T-3011 SIDE DRAIN
3C	V-3621	4"	PLUG	PGV2	T-3011 CONE DRAIN
3C	V-3631	1 1/2"	DIAPHRAGM	DIV4	T-3011 DISCH
3C	FV-3011	1 1/2"	ACTUATED	DIV4	T-3011 DISCH
3C	FV-3021	1"	ACTUATED	BAV1	SERVICE WATER INLET
3C	FV-3031	1 1/2"	ACTUATED	DIV4	P-3011 INLET
3C	V-3641	1 1/2"	BALL	BAV1	SERVICE WATER INLET
3C	V-3651	1 1/2"	CHECK	CHV2	SERVICE WATER INLET
3C	V-3671	1 1/2"	DIAPHRAGM	DIV4	P-3011 DISCH TO FBR-5
3C	V-3661	1 1/2"	DIAPHRAGM	DIV4	P-3011 DISCH TO FBR-6
3C	LCV-3011	10"	ACTUATED	BUV2	T-3011 FBR EFFLUENT
3C	PCV-3011	3/8"	REGULATOR		AIR FEED TO LCV-3011
3C	V-3691	1/2"	BALL	BAV2	AIR FEED TO FV-3011
3C	V-3681	1/2"	BALL	BAV2	AIR FEED TO BUBLER & LCV-3011
3C	V-3701	3/8"	BALL	BAV2	AIR FEED TO LCV-3011
3C	V-3721	3/8"	BALL	BAV2	AIR FEED TO FI-3011
3C	V-3731	3/8"	BALL	BAV2	AIR FEED TO FV-3021
3C	V-3741	3/8"	BALL	BAV2	AIR FEED TO FV-3031
3C	V-3751	3/8"	BALL	BAV2	AIR FEED TO FV-3011
3C	V-3711	1"	BALL	BAV1	CPVC, P-3011 INLET DRAIN
3C	V-3761	3/8"	BALL	BAV2	FROM FI-3011
3C	V-3771	3/8"	BALL	BAV2	FROM FI-3011
3D	V-3612	1 1/2"	DIAPHRAGM	DIV4	T-3012 SIDE DRAIN
3D	V-3622	4"	PLUG	PGV2	T-3012 CONE DRAIN
3D	V-3632	1 1/2"	DIAPHRAGM	DIV4	T-3012 DISCH
3D	FV-3012	1 1/2"	ACTUATED	DIV4	T-3012 DISCH
3D	FV-3022	1"	ACTUATED	BAV1	SERVICE WATER INLET
3D	FV-3032	1 1/2"	ACTUATED	DIV4	P-3012 INLET
3D	V-3642	1 1/2"	BALL	BAV1	SERVICE WATER INLET
3D	V-3652	1 1/2"	CHECK	CHV2	SERVICE WATER INLET
3D	V-3662	1 1/2"	DIAPHRAGM	DIV4	P-3012 DISCH TO FBR-7
3D	V-3672	1 1/2"	DIAPHRAGM	DIV4	P-3012 DISCH TO FBR-8
3D	LCV-3012	10"	ACTUATED	BUV2	T-3012 FBR EFFLUENT
3D	PCV-3012	3/8"	REGULATOR		AIR FEED TO LCV-3012
3D	V-3692	1/2"	BALL	BAV2	AIR FEED TO FV-3012
3D	V-3682	1/2"	BALL	BAV2	AIR FEED TO BUBLER & LCV-3012
3D	V-3702	3/8"	BALL	BAV2	AIR FEED TO LCV-3012
3D	V-3722	3/8"	BALL	BAV2	AIR FEED TO FI-3012
3D	V-3752	3/8"	BALL	BAV2	AIR FEED TO FV-3012
3D	V-3742	3/8"	BALL	BAV2	AIR FEED TO FV-3012
3D	V-3732	3/8"	BALL	BAV2	AIR FEED TO FV-3012
3D	V-3712	1"	BALL	BAV1	CPVC, P-3012 INLET DRAIN
3D	V-3762	3/8"	BALL	BAV2	FROM FI-3012
3D	V-3772	3/8"	BALL	BAV2	FROM FI-3012
4	V-411	2"	BALL	BAV1	CPVC, BLOWER DISCHARGE
4	V-412	2"	CHECK	CHV4	CPVC, BLOWER DISCHARGE
4	V-417	10"	BUTTERFLY	BUV2	CPVC, T-401 AERATION TANK INLET
4	V-415	3"	PLUG	PGV2	FRP, TANK T-401 DRAIN
4	V-414	3/8"	BALL	BAV1	POP, DAF POLYMER
4	V-413	3/8"	BALL	BAV1	T-401
4	V-416	3"	BUTTERFLY	BUV1	CPVC, THICKENER OVERFLOW
4	V-419	1"	BALL	BAV1	CPVC, AIR BLEED-OFF
4	V-420	2"	BALL	BAV1	CPVC, BLOWER DISCHARGE
5	V-500	1/4"	BALL		COPLANAR FOR FE-503
5	V-505	10"	BUTTERFLY	BUV2	CPVC, DAF D-501 BY-PASS
5	V-501	14"	BUTTERFLY	BUV2	CPVC, DAF D-501 INLET
5	V-502	4"	BUTTERFLY	BUV1	CPVC, SUCTION TO PUMP P-501
5	V-513	1"	BALL	BAV1	CPVC, SUCTION TO PUMP P-501
5	V-514	1/2"	BALL	BAV1	CPVC, PI-503
5	V-515	1/2"	BALL	BAV1	CPVC, PI-503
5	V-516	4"	CHECK	CHV1	CPVC, DAF PRESSURE TANK, T-501
5	V-517	4"	BUTTERFLY	BUV1	CPVC, PUMP P-501 DISCHARGE

Nevada Environmental Response Trust (NERT)
Perchlorate Treatment System
Henderson, NV

	Valve No.	Valve size (in.)	Valve Type	Valve Spec.	Comment
5	V-518	1/2"	BALL	BAV1	CPVC, P-501
5	V-519	1/2"	BALL	BAV1	CPVC, P-501
5	V-520	1/4"	BALL		COPLANAR FOR FE-502
5	V-521	3"	DIAPHRAGM	DIV5	CPVC, P-501 DISCHARGE TO T-501
5	PSV-501	1/2"	REGULATOR		PRESSURE TANK T-501
5	V-512	4"	CHECK	CHV1	CPVC, DAF PRESS. TANK, T-501DISCHARGE
5	V-504	2 1/2"	DIAPHRAGM	DIV5	CPVC, RETURN TO DAF TANK, D-501
5	V-527	1/2"	BALL	BAV2	STEEL, FI-501
5	V-528	1/2"	BALL	BAV2	STEEL, FI-501, THROTTLING
5	V-529	1/2"	NEEDLE	GLV2	STEEL, FI-501, THROTTLING
5	V-530	1/2"	CHECK	CHV4	STEEL, FI-501 DISCHARGE
5	V-522	1/2"	BALL	BAV1	CPVC, PRESS. TANK T-501, BLEED-OFF
5	V-523	1/2"	BALL	BAV1	CPVC, PRESSURE GAUGE
5	V-524	1/2"	BALL	BAV1	CPVC, PRESSURE GAUGE
5	V-509	2"	BALL	BAV1	CPVC, LEVEL INDICATOR LT-501
5	V-510	2"	BALL	BAV1	CPVC, LEVEL INDICATOR LT-501
5	V-511	1"	BALL	BAV1	CPVC, LEVEL INDICATOR DRAIN
5	PCV-501	1/2"	REGULATOR		STEEL, AIR TO PRESS. TANK T-501
5	V-526	1/2"	BALL	BAV2	STEEL, AIR TO PRESS. TANK T-501
5	V-505	10"	BUTTERFLY	BUV2	CPVC, DAF D-5011 EFFLUENT
5	V-531	1/2"	BALL	BAV2	STEEL, AIR TO PUMP P-502
5	PCV-504	1/2"	REGULATOR		STEEL, AIR TO PUMP P-502
5	LV-501	1/2"	SOLENOID		CPVC, T-501 BLEED-OFF
5	V-506	2"	DIAPHRAGM	DIV4	CPVC, PUMP SUCTION, P-502
5	V-507	2"	DIAPHRAGM	DIV4	CPVC, PUMP SUCTION, P-502
5	V-508	2"	DIAPHRAGM	DIV4	CPVC, PUMP DISCHARGE, P-502
5	V-550	1/4"	BALL		COPLANAR FOR FE-507
5	V-575	10"	BUTTERFLY	BUV2	CPVC, DAF D-551 BY-PASS
5	V-551	14"	BUTTERFLY	BUV2	CPVC, DAF D-502 INLET
5	V-552	4"	BUTTERFLY	BUV1	CPVC, SUCTION TO PUMP P-551
5	V-563	1/2"	BALL	BAV1	CPVC, SUCTION TO PUMP P-551
5	V-564	1/2"	BALL	BAV1	CPVC, PI-506
5	V-565	1/2"	BALL	BAV1	CPVC, PI-506
5	V-566	4"	CHECK	CHV1	CPVC, DAF PRESSURE TANK, T-551
5	V-567	4"	BUTTERFLY	BUV1	CPVC, PUMP P-551 DISCHARGE
5	V-568	1/2"	BALL	BAV1	CPVC, P-506
5	V-569	1/2"	BALL	BAV1	CPVC, P-506
5	V-570	1/4"	BALL		COPLANAR FOR FE-506
5	V-571	3"	DIAPHRAGM	DIV5	CPVC, P-506 DISCHARGE TO T-551
5	PSV-505	1/2"	REGULATOR		PRESSURE TANK T-505
5	V-562	4"	CHECK	CHV1	CPVC, DAF PRESSURE TANK, T-551
5	V-554	2 1/2"	DIAPHRAGM	DIV5	CPVC, RETURN TO DAF TANK, D-551
5	V-577	1/2"	BALL	BAV2	STEEL, FI-505
5	V-578	1/2"	BALL	BAV2	STEEL, FI-505
5	V-579	1/2"	NEEDLE	GLV2	STEEL, FI-505, THROTTLING
5	V-580	1/2"	CHECK	CHV4	STEEL, FI-505 DISCHARGE
5	V-572	1/2"	BALL	BAV1	CPVC, PRESS. TANK T-551, BLEED-OFF
5	V-573	1/2"	BALL	BAV1	CPVC, PRESSURE GAUGE
5	V-574	1/2"	BALL	BAV1	CPVC, PRESSURE GAUGE
5	V-559	2"	BALL	BAV1	CPVC, LEVEL INDICATOR LT-551
5	V-560	2"	BALL	BAV1	CPVC, LEVEL INDICATOR LT-551
5	V-561	1"	BALL	BAV1	CPVC, LEVEL INDICATOR DRAIN
5	PCV-505	1/2"	REGULATOR		STEEL, AIR TO PRESS. TANK T-551
5	V-576	1/2"	BALL	BAV2	STEEL, AIR TO PRESS. TANK T-551
5	V-555	10"	BUTTERFLY	BUV2	CPVC, DAF D-551 EFFLUENT
5	V-581	1/2"	BALL	BAV2	STEEL, AIR TO PUMP P-551
5	PCV-551	1/2"	REGULATOR		STEEL, AIR TO PUMP P-552
5	V-556	2"	DIAPHRAGM	DIV4	CPVC, PUMP SUCTION, P-552
5	V-557	2"	DIAPHRAGM	DIV4	CPVC, PUMP SUCTION, P-552
5	V-558	2"	DIAPHRAGM	DIV4	CPVC, PUMP DISCHARGE, P-502
5	LV-505	1/2"	SOLENOID		CPVC, T-551 BLEED-OFF
5	V-506	6"	BUTTERFLY	BUV1	CPVC, RETURN TO D-501
5	V-553	6"	BUTTERFLY	BUV1	CPVC, RETURN TO D-551
6	V-601	10"	BUTTERFLY	BUV2	CPVC, T-601 EFFLUENT TANK DISCH.
6	V-602	2"	BALL	BAV1	CPVC, T-601 EFFLUENT TANK DRAIN
6	V-603	8"	BUTTERFLY	BUV2	CPVC, EFFLUENT PUMP SUCTION

Nevada Environmental Response Trust (NERT)
Perchlorate Treatment System
Henderson, NV

	Valve No.	Valve size (in.)	Valve Type	Valve Spec.	Comment
6	V-604	8"	BUTTERFLY	BUV2	CPVC, EFFLUENT PUMP DISCH.
6	V-605	8"	BUTTERFLY	BUV2	CPVC, EFFLUENT PUMP SUCTION
6	V-606	8"	BUTTERFLY	BUV2	CPVC, EFFLUENT PUMP DISCH.
6	V-608	8"	CHECK	CHV1	CPVC, EFFLUENT PUMP DISCH.
6	V-609	2"	BALL	BAV1	CPVC, SERVICE WATER
6	V-610	1/2"	BALL	BAV1	CPVC, TURBIDITY SENSOR ISOLATION
6	V-629	2"	BALL	BAV1	CPVC, SERVICE WATER
6	V-611	8"	BUTTERFLY	BUV2	CPVC, SYSTEM RECYCLE
6	V-612	8"	CHECK	CHV1	CPVC, SYSTEM RECYCLE
6	V-613	8"	BUTTERFLY	BUV2	CPVC, UV SYSTEM
6	V-614	8"	BUTTERFLY	BUV2	CPVC, UV SYSTEM
6	V-626	8"	BUTTERFLY	BUV2	CPVC, UV SYSTEM
6	V-627	8"	BUTTERFLY	BUV2	CPVC, UV SYSTEM
6	V-615	2"	BALL	BAV1	CPVC, UV SYSTEM DRAIN
6	V-616	2"	DIAPHRAGM	DIV1	CPVC, EFFLUENT RECYCLE
6	V-617	1/2"	BALL	BAV2	STEEL, AIR ISOLATION
6	V-621	1/2"	BALL	BAV1	CPVC, PRESSURE GAUGE
6	V-618	1/2"	BALL	BAV1	CPVC, SAMPLE PORT
6	V-624	1"	BALL	BAV1	CPVC, SERVICE WATER FLUSH TO P-603
6	V-619	2"	BUTTERFLY	BUV1	CPVC, DAF UNDERFLOW AND FLOAT
6	V-620	2"	BUTTERFLY	BUV1	CPVC, EXCESS BIOMASS
6	V-622	4"	PLUG	PGV2	CPVC, P-603 PUMP SUCTION
6	V-623	3"	PLUG	PGV2	CPVC, P-603 PUMP DISCH.
6	V-625	3"	PLUG	PGV2	CPVC, P-603 PUMP DISCH.
6	V-628	2"	BACKFLOW		CPVC, SERVICE WATER
6	V-634	3/8"	BALL	BAV2	STEEL, AIR TO FCV-601
6	LCV-601	8"	ACTUATOR	BUV2	CPVC,PUMP DISCH.
6	V-633	3/8"	BALL	BAV2	STEEL, AIR TO FI-601
6	V-607	1/2"	BALL	BAV1	CPVC, PI-602
6	V-635	2"	CHECK	CHV2	CPVC, SERVICE WATER
6	V-631	1/2"	BALL	BAV1	CPVC, PRESSURE GAUGE
6	V-632	1/2"	BALL	BAV1	CPVC, PRESSURE GAUGE
6	V-630	1/4"	BALL		COPLANAR FOR FE-602
6	PCV-601	3/8"	REGULATOR		STEEL, AIR TO LCV-601
6	V-636	2"	BALL	BAV1	CPVC, SAFETY SHOWER
7A	V-701	2"	BALL	BAV1	PH TOTE
7A	V-701A	2"	BALL	BAV1	PH TOTE
7A	V-711A	1"	BALL	BAV1	PH PUMP SUCTION
7A	V-712A	1"	BALL	BAV1	PH PUMP SUCTION
7A	V-713A	1"	BALL	BAV1	PH PUMP SUCTION
7A	V-714A	1"	BALL	BAV1	PH PUMP SUCTION
7A	V-715A	1"	BALL	BAV1	PH PUMP SUCTION
7A	V-716A	1"	BALL	BAV1	PH PUMP SUCTION
7A	V-717A	1"	BALL	BAV1	PH PUMP SUCTION
7A	V-718A	1"	BALL	BAV1	PH PUMP SUCTION
7A	V-711B	3/8"	BALL	BAV1	PH PUMP SUCTION
7A	V-712B	3/8"	BALL	BAV1	PH PUMP SUCTION
7A	V-713B	3/8"	BALL	BAV1	PH PUMP SUCTION
7A	V-714B	3/8"	BALL	BAV1	PH PUMP SUCTION
7A	V-715B	3/8"	BALL	BAV1	PH PUMP SUCTION
7A	V-716B	3/8"	BALL	BAV1	PH PUMP SUCTION
7A	V-717B	3/8"	BALL	BAV1	PH PUMP SUCTION
7A	V-718B	3/8"	BALL	BAV1	PH PUMP SUCTION
7A	V-711C	1/2"	BALL	BAV1	CALIBRATION COLUMN
7A	V-712C	1/2"	BALL	BAV1	CALIBRATION COLUMN
7A	V-713C	1/2"	BALL	BAV1	CALIBRATION COLUMN
7A	V-714C	1/2"	BALL	BAV1	CALIBRATION COLUMN
7A	V-715C	1/2"	BALL	BAV1	CALIBRATION COLUMN
7A	V-716C	1/2"	BALL	BAV1	CALIBRATION COLUMN
7A	V-717C	1/2"	BALL	BAV1	CALIBRATION COLUMN
7A	V-718C	1/2"	BALL	BAV1	CALIBRATION COLUMN
7A	V-711D	3/8"	BALL	BAV1	PH PUMP DISCHARGE
7A	V-712D	3/8"	BALL	BAV1	PH PUMP DISCHARGE
7A	V-713D	3/8"	BALL	BAV1	PH PUMP DISCHARGE
7A	V-714D	3/8"	BALL	BAV1	PH PUMP DISCHARGE
7A	V-715D	3/8"	BALL	BAV1	PH PUMP DISCHARGE

Nevada Environmental Response Trust (NERT)
Perchlorate Treatment System
Henderson, NV

	Valve No.	Valve size (in.)	Valve Type	Valve Spec.	Comment	
	7A	V-716D	3/8"	BALL	BAV1	PH PUMP DISCHARGE
	7A	V-717D	3/8"	BALL	BAV1	PH PUMP DISCHARGE
	7A	V-718D	3/8"	BALL	BAV1	PH PUMP DISCHARGE
	T-702	V-702	2"	BALL	BAV1	NUTRIENT TOTE
	T-702	V-702A	1/2"	BALL	BAV1	NUTRIENT TOTE
	T-702	V-702B	3"	BALL	BAV1	NUTRIENT TOTE
	T-702	V-721A	1"	BALL	BAV1	NUTRIENT PUMP SUCTION
	T-702	V-722A	1"	BALL	BAV1	NUTRIENT PUMP SUCTION
	T-702	V-723A	1"	BALL	BAV1	NUTRIENT PUMP SUCTION
	T-702	V-724A	1"	BALL	BAV1	NUTRIENT PUMP SUCTION
	T-702	V-725A	1"	BALL	BAV1	NUTRIENT PUMP SUCTION
	T-702	V-726A	1"	BALL	BAV1	NUTRIENT PUMP SUCTION
	T-702	V-727A	1"	BALL	BAV1	NUTRIENT PUMP SUCTION
	T-702	V-728A	1"	BALL	BAV1	NUTRIENT PUMP SUCTION
	T-702	V-721B	3/8"	BALL	BAV1	NUTRIENT PUMP SUCTION
	T-702	V-722B	3/8"	BALL	BAV1	NUTRIENT PUMP SUCTION
	T-702	V-723B	3/8"	BALL	BAV1	NUTRIENT PUMP SUCTION
	T-702	V-724B	3/8"	BALL	BAV1	NUTRIENT PUMP SUCTION
	T-702	V-725B	3/8"	BALL	BAV1	NUTRIENT PUMP SUCTION
	T-702	V-726B	3/8"	BALL	BAV1	NUTRIENT PUMP SUCTION
	T-702	V-727B	3/8"	BALL	BAV1	NUTRIENT PUMP SUCTION
	T-702	V-728B	3/8"	BALL	BAV1	NUTRIENT PUMP SUCTION
	7B	V-732B	1/2"	BALL	BAV1	EDS CALIBRATION COLUMN
	7B	V-733B	1/2"	BALL	BAV1	EDS CALIBRATION COLUMN
	7B	V-734B	1/2"	BALL	BAV1	EDS CALIBRATION COLUMN
	7B	V-735B	1/2"	BALL	BAV1	EDS CALIBRATION COLUMN
	7B	V-736B	1/2"	BALL	BAV1	EDS CALIBRATION COLUMN
	7B	V-737B	1/2"	BALL	BAV1	EDS CALIBRATION COLUMN
	7B	V-738B	1/2"	BALL	BAV1	EDS CALIBRATION COLUMN
	7B	V-739B	1"	BALL	BAV1	EDS BOOSTER PUMP DISCH.
	7B	V-731C	1/2"	BALL	BAV1	ELECTRON DONOR METERING PUMP DISCH.
	7B	V-732C	1/2"	BALL	BAV1	ELECTRON DONOR METERING PUMP DISCH.
	7B	V-733C	1/2"	BALL	BAV1	ELECTRON DONOR METERING PUMP DISCH.
	7B	V-734C	1/2"	BALL	BAV1	ELECTRON DONOR METERING PUMP DISCH.
	7B	V-735C	1/2"	BALL	BAV1	ELECTRON DONOR METERING PUMP DISCH.
	7B	V-736C	1/2"	BALL	BAV1	ELECTRON DONOR METERING PUMP DISCH.

Nevada Environmental Response Trust (NERT)
Perchlorate Treatment System
Henderson, NV

	Valve No.	Valve size (in.)	Valve Type	Valve Spec.	Comment
7B	V-737C	1/2"	BALL	BAV1	ELECTRON DONOR METERING PUMP DISCH.
7B	V-738C	1/2"	BALL	BAV1	ELECTRON DONOR METERING PUMP DISCH.
7B	V-739C	1"	BALL	BAV1	ELECTRON DONOR BOOSTER PUMP DISCH.
7B	V-739D	1"	BALL	BAV1	ELECTRON DONOR BOOSTER PUMP DISCH.
7B	V-704	2"	BALL	BAV1	POLYMER FEED SYSTEM
7B	V-704A	2"	BALL	BAV1	POLYMER FEED SYSTEM
7B	V-705	2"	BALL	BAV1	POLYMER FEED SYSTEM
7B	V-705A	2"	BALL	BAV1	POLYMER FEED SYSTEM
7B	V-749	1/2"	BALL	BAV1	POLYMER FEED SYSTEM
7B	V-741A	3/8"	BALL	BAV1	POLYMER FEED SYSTEM
7B	V-742A	3/8"	BALL	BAV1	POLYMER FEED SYSTEM
7B	V-741B	1/2"	BALL	BAV1	POLYMER FEED SYSTEM
7B	V-742B	1/2"	BALL	BAV1	POLYMER FEED SYSTEM
7B	V-741C	3/8"	BALL	BAV1	POLYMER FEED SYSTEM
7B	V-742C	3/8"	BALL	BAV1	POLYMER FEED SYSTEM
7B	PCV-739	1"	REGULATOR		ELECTRON DONOR T-703
7B	FV-703	1"	SOLENOID		ELECTRON DONOR T-703
7B	V-751	3"	BALL	BAV1	ELECTRON DONOR T-703
7B	V-752	3"	CHECK	CHV1	ELECTRON DONOR T-703
7B	PSV-705		RELIEF		ELECTRON DONOR T-703
7B	PSV-704		RELIEF		ELECTRON DONOR T-703
7B	PSV-703		RELIEF		ELECTRON DONOR T-703
7C	V-751A	3"	BALL	BAV1	CPVC, FERRIC CHLORIDE FEED
7C	V-751B	2"	BALL	BAV1	CPVC, FERRIC CHLORIDE FEED
7C	V-751C	2"	BALL	BAV1	CPVC, FERRIC CHLORIDE FEED
7C	V-751D	1/2"	BALL	BAV1	CPVC, FERRIC CHLORIDE FEED
7C	FV-751E	1"	ACTUATED	BAV1	CPVC, AUTOMATED FERRIC CHLORIDE
7C	V-752	1/2"	BALL	BAV2	STEEL, INSTRUMENT AIR
7C	V-753	8"	KNIFE	KGV1	T-752
7C	V-754	2"	BALL	BAV1	CPVC, T-751 SECONDARY CONF. DRAIN
7C	V-55	2"	BALL	BAV1	CPVC, T-751 DRAIN
7C	V-756	1"	BALL	BAV1	CPVC, SAMPLE PORT
7C	V-757	1/2"	BALL	BAV1	CPVC, DRAIN
7C	PSV-751		RELIEF		T-752
8	V-801	2"	CHECK	CHV4	STEEL, COMPRESSED AIR LINE, P-801
8	V802	2"	BALL	BAV2	STEEL, COMPRESSED AIR LINE P-801
8	V-803	2"	BALL	BAV2	STEEL, COMPRESSED AIR LINE P-802
8	V-804	2"	CHECK	CHV4	STEEL, SERVICE AIR
8	V-805	3"	BALL	BAV2	STEEL, SERVICE AIR
8	V-806	1/4"	BALL	BAV2	STEEL, AIR COMP. TANK PRESS. GAUGE
8	V-807	1/2"	BALL	BAV2	STEEL, AIR COMP. TANK DRAIN LINE
8	V-808	1/2"	BALL	BAV2	STEEL, AIR COMP. TANK DRAIN LINE
8	V-809	1/2"	CHECK	CHV4	STEEL, AIR COMP. TANK DRAIN LINE
8	V-810	2"	BALL	BAV2	STEEL, SERVICE AIR
8	V-811	1 1/2"	BALL	BAV2	STEEL, SERVICE AIR
8	V-812	1 1/2"	CHECK	CHV4	STEEL, SERVICE AIR
8	PCV-8002	2"	REGULATOR		STEEL, SERVICE AIR
8	FCV-801	2"	SOLENOID		STEEL, SERVICE AIR
9	V-901	3"	PLUG	PGV2	SLUDGE FEED TO T-901
9	V-902	1"	BALL	BAV1	SERVICE WATER FEED
9	V-903	3"	PLUG	PGV2	T-901 DISCH
9	V-904	2"	DIAPHRAGM	DIV4	P-901 INTAKE
9	V-905	3"	PLUG	PGV2	P-901 DISCH
9	V-906	2"	DIAPHRAGM	DIV4	P-902INTAKE
9	V-907	3"	PLUG	PGV2	P-902 DISCH
9	V-908	3"	BALL	BAV1	T-901 RETURN
9	V-909	3"	BALL	BAV1	X-902 INTAKE
9	V-910	3"	BALL	BAV1	X-901 INTAKE
9	V-911	3"	BALL	BAV1	X-901 INTAKE
9	V-912	2"	BALL	BAV1	T-902 INLET
9	V-913	1/2"	BALL	BAV2	STEEL, SERVICE AIR FEED TO FILTER PRESS
9	V-914	2"	BALL	BAV1	T-902 OUTLET
9	V-915	2"	BALL	BAV1	T-902 INLET
9	V-916	2"	BALL	BAV1	X-901
9	V-917	2"	BALL	BAV1	X-901
9	V-918	2"	BALL	BAV1	X-902

Nevada Environmental Response Trust (NERT)
 Perchlorate Treatment System
 Henderson, NV

	Valve No.	Valve size (in.)	Valve Type	Valve Spec.	Comment
9	V-919	2"	BALL	BAV1	X-902
9	V-920	1/2"	BALL	BAV2	INST. AIR FEED TO PLATE SHIFTER
9	V-921	1/2"	BALL	BAV2	INST. AIR FEED TO PLATE SHIFTER
9	V-922	1/2"	BALL	BAV2	AIR BLOW DOWN TO X-901
9	V-923	1/2"	BALL	BAV2	AIR BLOW DOWN TO X-902
9	V-924	1/2"	BALL	BAV2	AIR FEED TO F-901
9	PCV-901	1/2"	REGULATOR		AIR TO P-901
9	FCV-901	1/2"	SOLENOID		AIR TO P-901
9	V-925	1/2"	BALL	BAV2	AIR FEED TO F-902
9	PCV-902	1/2"	REGULATOR		AIR TO P-902
9	FCV-902	1/2"	SOLENOID		AIR TO P-902
9	V-926	3"	PLUG	PGV2	CPVC, BY-PASS TO T-902
9	V-927	1"	BALL	BAV1	FILTRATE RECYCLE PMP DISCH.
9	V-928	1/2"	BALL	BAV2	SERVICE AIR FOR FILTER PRESS BLOW
9	V-929	1"	BALL	BAV1	FLUSH ON FILTRATE RECYCLE PUMP SUCTION
9	V-930	2"	BALL	BAV1	T-902 DRAIN
VALVES ADDED 2006					

LINE DESIGNATION TABLE

SYS	FULL LINE NO.	LINE NO.	PIPE SPEC.	MATERIAL	SIZE (inch)	LOCATION FROM	LOCATION TO	NORMAL OPERATING		DESIGN		INSULATION		TEST		VALVES	P&ID NO.
								PRESS psig	TEMP (deg.F)	PRESS psig	TEMP (deg.F)	TYPE	THK (inch)	TYPE	PRESS psig		
BA		0															
BA	2"-BA-S04P10-001-I	1.0		S04P10	2.00	B-401	2"-BA-CVCP80-002-N	13	140	150	90	FRP	1	HYD	20	V-411, V-412	4
BA	2"-BA-CVCP80-002-N	2.0		CPVC80	2.00	2"-BA-S04P10-001-I	4"-BA-CVCP80-002-N	13	100	145	90	NA	NA	HYD	20		4
BA	4"-BA-CVCP80-002-N	2.0		CPVC80	4.00	T-401	2"-BA-CVCP80-002-N & 1"-WW-CVCP80-097-HT&I	13	100	145	90	NA	NA	HYD	20		4
CA		0															
CA	2"-CA-CSTP40-001-N	1.0		CSTP40	2.00	P-801	T-801	NA	NA	NA	NA	NA	NA	NA	NA	V-801, V-802	8
CA	2"-CA-CSTP40-002-N	2.0		CSTP40	2.00	P-802	T-801	NA	NA	NA	NA	NA	NA	NA	NA	V-803, V-804	8
CA	1 1/2"-CA-CSTP40-003-N	3.0		CSTP40	1.50	T-801	T-802	NA	NA	NA	NA	NA	NA	NA	NA	V-811	8
CA	2"-CA-CSTP40-003-N	3.0		CSTP40	2.00	T-801	1"-CA-CSTP40-003-N	NA	NA	NA	NA	NA	NA	NA	NA	PCV-802, V-805, V-810	8
CA	1"-CA-CSTP40-003-N	3.0		CSTP40	1.00	2"-CA-CSTP40-003-N	1"-CA-CSTP40-003-N AND SERVICE AIR	110	100	150	90	NA	NA	PNEU	150		8, 9
ED		0															
ED	3"-ED-S04P80-001-N	1.0		S04P80	3.00	TRUCK FILL	T-703	NA	NA	NA	NA	NA	NA	NA	NA	LCV-703, V-750, V-751	7B
ED	1"-ED-S04P80-002-N	2.0		S04P80	1.00	P-739A & -B	1"-ED-S04P80-003-N	50	90	150	90	NA	NA	HYD	75	V-739B&C, V-753B&C	7B
ED	1"-ED-S04P80-003-N	3.0		S04P80	1.00	1"-ED-S04P80-002-N	P-731 THRU P-738	NA	NA	NA	NA	NA	NA	NA	NA		7B
ED	1/2"-ED-S04P80-004-N	4.0		S04P80	0.50	1"-ED-S04P80-003-N	P-731	NA	NA	NA	NA	NA	NA	NA	NA	V-731A	7B
ED	1/2"-ED-S04P80-005-N	5.0		S04P80	0.50	P-731	10"-WW-CVCP80-008-N	70	90	150	90	NA	NA	HYD	105	V-731C, V-1081, V-1091	1A, 7B
ED	1/2"-ED-S04P80-006-N	6.0		S04P80	0.50	1"-ED-S04P80-003-N	P-732	NA	NA	NA	NA	NA	NA	NA	NA	V-732A	7B
ED	1/2"-ED-S04P80-007-N	7.0		S04P80	0.50	P-732	10"-WW-CVCP80-010-N	70	90	150	90	NA	NA	HYD	105	V-732C, V-1092, V-1082	1A, 7B
ED	1/2"-ED-S04P80-008-N	8.0		S04P80	0.50	1"-ED-S04P80-003-N	P-733	NA	NA	NA	NA	NA	NA	NA	NA	V-733A	7B
ED	1/2"-ED-S04P80-009-N	9.0		S04P80	0.50	P-733	10"-WW-CVCP80-036-N	70	90	150	90	NA	NA	HYD	105	V-733C, V-1063, V-1073	1B, 7B
ED	1/2"-ED-S04P80-010-N	10.0		S04P80	0.50	1"-ED-S04P80-003-N	P-734	NA	NA	NA	NA	NA	NA	NA	NA	V-734A	7B
ED	1/2"-ED-S04P80-011-N	11.0		S04P80	0.50	P-734	10"-WW-CVCP80-038-N	70	90	150	90	NA	NA	HYD	105	V-734C, V-1084, V-1094	1B, 7B
ED	1/2"-ED-S04P80-012-N	12.0		S04P80	0.50	1"-ED-S04P80-003-N	P-735	NA	NA	NA	NA	NA	NA	NA	NA	V-735A	7B
ED	1/2"-ED-S04P80-013-N	13.0		S04P80	0.50	P-735	10"-WW-CVCP80-022-N	70	90	150	90	NA	NA	HYD	105	V-735C, V-3085, V-3095	3A, 7B
ED	1/2"-ED-S04P80-014-N	14.0		S04P80	0.50	1"-ED-S04P80-003-N	P-736	NA	NA	NA	NA	NA	NA	NA	NA	V-736A	7B
ED	1/2"-ED-S04P80-015-N	15.0		S04P80	0.50	P-736	10"-WW-CVCP80-023-N	70	90	150	90	NA	NA	HYD	105	V-736C, V-3086, V-3096	3A, 7B
ED	1/2"-ED-S04P80-016-N	16.0		S04P80	0.50	1"-ED-S04P80-003-N	P-737	NA	NA	NA	NA	NA	NA	NA	NA	V-737A	7B
ED	1/2"-ED-S04P80-017-N	17.0		S04P80	0.50	P-737	10"-WW-CVCP80-051-N	70	90	150	90	NA	NA	HYD	105	V-737C, V-3067, V-3077	3B, 7B
ED	1/2"-ED-S04P80-018-N	18.0		S04P80	0.50	1"-ED-S04P80-003-N	P-738	NA	NA	NA	NA	NA	NA	NA	NA	V-738A	7B
ED	1/2"-ED-S04P80-019-N	19.0		S04P80	0.50	P-738	10"-WW-CVCP80-052-N	70	90	70	90	NA	NA	HYD	105	V-738C, V-3088, V-3098	3B, 7B
ED	1"-ED-S04P80-020-N	20.0		S04P80	1.00	1"-ED-S04P80-002-N	T-703	10	90	60	90	NA	NA	HYD	15	PCV-739	7B
ED	1"-ED-S04P80-021-N	21.0		S04P80	1.00	ELECTRON DONOR CALIBRATION COLUMNS	T-703	ATMOS	90	60	90	NA	NA	HYD	15		7B

LINE DESIGNATION TABLE

SYS	FULL LINE NO.	LINE NO.	PIPE SPEC.	MATERIAL	SIZE (inch)	LOCATION FROM	LOCATION TO	NORMAL		DESIGN		INSULATION		TEST		VALVES	P&ID NO.
								OPERATING PRESS	TEMP	PRESS	TEMP	TYPE	THK	TYPE	PRESS		
								psig	(deg.F)	psig	(deg.F)		(inch)		psig		
FC		0															
FC	3"-FC-CVCP80-001-N	1.0		CPVC80	3.00	T-751	TRUCK FILL	20	90	145	90	NA	NA	HYD	30	V-751A	7C
FC	2"-FC-CVCP80-002-N	2.0		CPVC80	2.00	2"-FC-CVCP80-004-N	T-751	20	90	145	90	NA	NA	HYD	30	V-751B	7C
FC	1"-FC-CVCP80-003-N	3.0		CPVC80	1.00	2"-FC-CVCP80-003-N	P-758 & P-759	20	90	145	90	NA	NA	HYD	30	V-772, -774 & 756	7C
FC	2"-FC-CVCP80-003-N	3.0		CPVC80	2.00	T-751	P-751, 1"-FC-CVCP80-003-N	10	90	145	90	NA	NA	HYD	15	V-751C	7C
FC	1"-FC-CVCP80-004-N	4.0		CPVC80	1.00	2"-FC-CVCP80-004-N	T-901	20	90	145	90	NA	NA	HYD	30	FV-751E	7C, 9
FC	2"-FC-CVCP80-004-N	4.0		CPVC80	2.00	P-751	1"-FC-CVCP80-004-N	20	90	145	90	NA	NA	HYD	30		7C
FC	3/4"-FC-CVCP80-005-N	5.0		CPVC80	0.75	P-758	T-602	ATMOS	90	145	90	NA	NA	SERVICE	TEST	V-638, V-773	6, 7C
FC	1/2"-FC-CVCP80-006-N	0.5		CPVC80	0.50	P-759	T-401	20	90	145	90	NA	NA	HYD	30	V-413, -775	4, 7C
IA		0.0															
IA	1 1/2"-IA-CSTP-100-N	100.0		CSTP	1.50	T-802	INSTRUMENT AIR MAIN HEADER	100	90	150	90	NA	NA	PNEU	150	PCV-803, V-812, V-813	8, 12
NU		0															
NU	3"-NU-CVCP80-001-N	1.0		CPVC80	3.00	T-702	TRUCK FILL	10	90	145	73	NA	NA	HTD	15	V-702B	7A
NU	1"-NU-CVCP80-002-N	2.0		CPVC80	1.00	2"-NU-CVCP80-002-N	P-721 THRU P-728	NA	NA	NA	NA	NA	NA	NA	NA	V-721A THRU V-	7A
NU	2"-NU-CVCP80-002-N	2.0		CPVC80	2.00	T-702	1"-NU-CVCP80-002-N	10	90	145	73	NA	NA	HYD	15	V-702	7A
NU	1"-NU-CVCP80-004-N	4.0		CPVC80	1.00	2"-NU-CVCP80-004-N	(2) 3/8"-NU-POPT (P-753A & -B)					NA	NA			V-765	7C
NU	2"-NU-CVCP80-004-N	4.0		CPVC80	2.00	T-753	1"-NU-CVCP80-004-N					NA	NA			V-758	7C
NU	3/8"-NU-POPT-N			POPT	0.38	P-721	10"-WW-CVCP80-008-N	50	90	100	90	NA	NA	HYD	75	V-721D, V-1061, V-1071	1A, 7A
NU	3/8"-NU-POPT-N			POPT	0.38	P-722	10"-WW-CVCP80-010-N	50	90	100	90	NA	NA	HYD	75	V-722D, V-1062, V-1072	1A, 7A
NU	3/8"-NU-POPT-N			POPT	0.38	P-725	10"-WW-CVCP80-022-N	50	90	100	90	NA	NA	HYD	75	V-725D, V-3065, V-3075	3A, 7A
NU	3/8"-NU-POPT-N			POPT	0.38	P-726	10"-WW-CVCP80-023-N	50	90	100	90	NA	NA	HYD	75	V-726D, V-3066, V-3076	3A, 7A
NU	3/8"-NU-POPT-N			POPT	0.38	P-723	10"-WW-CVCP80-036-N	50	90	100	90	NA	NA	HYD	75	V-723D, V-1083, V-1093	1B, 7A
NU	3/8"-NU-POPT-N			POPT	0.38	P-724	10"-WW-CVCP80-038-N	50	90	100	90	NA	NA	HYD	75	V-724D, V-1064, V-1074	1B, 7A
NU	3/8"-NU-POPT-N			POPT	0.38	P-727	10"-WW-CVCP80-051-N	50	90	100	90	NA	NA	HYD	75	V-727D, V-3087, V-3097	3B, 7A
NU	3/8"-NU-POPT-N			POPT	0.38	P-728	10"-WW-CVCP80-052-N	50	90	100	90	NA	NA	HYD	75	V-728D, V-3068, V-3078	3B, 7A
NU	3/8"-NU-POPT-N			POPT	0.38	1"-NU-CVCP80-004-N	P-753A					NA	NA			V-760	7C
NU	3/8"-NU-POPT-N			POPT	0.38	1"-NU-CVCP80-004-N	P-753B					NA	NA			V-762	7C
NU	3/8"-NU-POPT-N			POPT	0.38	P-753A & -B	10"-WW-CVCP80-100-N					NA	NA			V-761, -4 & V-1555 & -6	1B, 7C
P		0															
P	2"-P-CVCP80-001-HT&I	1.0		CPVC80	2.00	T-704	P-741	3	90	145	73	FRP	1	HYD	5	V-704, V-741A	7B
P	1/2"-P-CVCP80-002-HT&I	2.0		CPVC80	0.50	P-741	T-602	30	90	145	73	FRP	1	HYD	45	V-741C	6, 7B
P	2"-P-CVCP80-003-HT&I	3.0		CPVC80	2.00	T-705	P-742	3	90	145	73	FRP	1	HYD	5	V-705, V-742A	7B
P	1/2"-P-CVCP80-004-HT&I	4.0			0.50	P-742	10"-WW-CVCP80-062-N	30	90	145	73	FRP	1	HYD	45	V-414, V-742C	4, 7B

LINE DESIGNATION TABLE

SYS	FULL LINE NO.	LINE NO.	PIPE SPEC.	MATERIAL	SIZE (inch)	LOCATION FROM	LOCATION TO	NORMAL		DESIGN		INSULATION		TEST		VALVES	P&ID NO.
								OPERATING	TEMP	PRESS	TEMP	TYPE	THK	TYPE	PRESS		
								psig	(deg.F)	psig	(deg.F)		(inch)		psig		
PA		0															
PA	6"-PA-CVCP80-001	1.0		CPVC80	6.00	T-401	B-402	ATMOS	90	230	73	NA	NA	PNEU	5		4
PA	8"-PA-CVCD-002	2.0		CPVC80	8.00	B-402	T-402A & T-402B	10' WC	100	230	73	NA	NA	PNEU	DEAD HEAD	V-404, V-405	4
PA	6"-PA-CVCP80-003	3.0		CPVC80	6.00	T-402A & T-402B	DISCHARGE TO ATMOSPHERE	ATMOS	100	230	73	NA	NA	SERVICE	TEST		4
SH		0															
SH	2"-SH-CVCP80-001-N	1.0		CPVC80	2.00	T-701	1"-SH-CVCP80-002-N	10	90	230	73	NA	NA	HYD	15	V-701, V-701A	7A
SH	1"-SH-CVCP80-002-N	2.0		CPVC80	1.00	2"-SH-CVCP80-001-N	P-711 THU P-718	NA	NA	NA	NA	NA	NA	NA	NA	V-711A THRU V-711D	
SH	3/8"-SH-POPT-N			POPT	0.38	P-711	6"-WW-CVCP80-001-N	50	90	100	90	NA	NA	HYD	75	V-1090, V-1110, V-711D	1A, 7A
SH	3/8"-SH-POPT-N			POPT	0.38	P-712	6"-WW-CVCP80-003-N	50	90	100	90	NA	NA	HYD	75	V-1100, V-1120, V-712D	1A, 7A
SH	3/8"-SH-POPT-N			POPT	0.38	P-715	6"-WW-CVCP80-017-N	50	90	100	90	NA	NA	HYD	75	V-3090, V-3110, V-715D	3A, 7A
SH	3/8"-SH-POPT-N			POPT	0.38	P-716	6"-WW-CVCP80-018-N	50	90	100	90	NA	NA	HYD	75	V-3100, V-3120, V-716D	3A, 7A
SH	3/8"-SH-POPT-N			POPT	0.38	P-713	6"-WW-CVCP80-029-N	50	90	100	90	NA	NA	HYD	75	V-1390, V-1410, V-713D	1B, 7A
SH	3/8"-SH-POPT-N			POPT	0.38	P-714	6"-WW-CVCP80-031-N	50	90	100	90	NA	NA	HYD	75	V-1400, V-1420, V-714D	1B, 7A
SH	3/8"-SH-POPT-N			POPT	0.38	P-717	6"-WW-CVCP80-046-N	50	90	100	90	NA	NA	HYD	75	V-3390, V-3410, V-717D	3B, 7A
SH	3/8"-SH-POPT-N			POPT	0.38	P-718	6"-WW-CVCP80-047-N	50	90	100	90	NA	NA	HYD	75	V-3400, V-3420, V-718D	3B, 7A
SL	(LINES 6, 11 & 36 NOT USED)	0															
SL	2"-SL-CVCP80-001-N	1.0		CPVC80	2.00	FBR-5, -6, -7 & -8	T-602	ATMOS	90	145	90	NA	NA	HYD	5	V-618, V-619	3A, 3B, 6
SL	2"-SL-CVCP80-002-N	2.0		CPVC80	2.00	FBR-5	2"-SL-CVCP80-001-N	ATMOS	90	145	90	NA	NA	HYD	5		3A
SL	2"-SL-CVCP80-003-N	3.0		CPVC80	2.00	FBR-6	2"-SL-CVCP80-001-N	ATMOS	90	145	90	NA	NA	HYD	5		3A
SL	2"-SL-CVCP80-004-N	4.0		CPVC80	2.00	FBR-6	2"-SL-CVCP80-003-N	ATMOS	90	145	90	NA	NA	HYD	5		3A
SL	4"-SL-CVCP80-005-N	5.0		CPVC80	4.00	T-602 WEIR TROUGH	T-401	ATMOS	90	145	90	NA	NA	SERVICE	TEST	V-415, -416B & -421	4, 6
SL	2"-SL-CVCP80-007-N	7.0		CPVC80	2.00	FBR-7	2"-SL-CVCP80-001-N	ATMOS	90	145	90	NA	NA	HYD	5		3B
SL	2"-SL-CVCP80-008-N	8.0		CPVC80	2.00	FBR-7	2"-SL-CVCP80-007-N	ATMOS	90	145	90	NA	NA	HYD	5		3B
SL	2"-SL-CVCP80-009-N	9.0		CPVC80	2.00	FBR-8	2"-SL-CVCP80-001-N	ATMOS	90	145	90	NA	NA	HYD	5		3B
SL	2"-SL-CVCP80-010-N	10.0		CPVC80	2.00	FBR-8	2"-SL-CVCP80-009-N	ATMOS	90	145	90	NA	NA	HYD	5		3B
SL	4"-SL-CVCP80-012-N	12.0		CPVC80	4.00	D-501	P-501	10	90	145	90	NA	NA	HYD	15	V-502	5
SL	4"-SL-CVCP80-013-N	13.0		CPVC80	4.00	P-501	T-501	60	90	145	90	NA	NA	HYD	90	V-516, V-517, V-521	5
SL	4"-SL-CVCP80-014-N	14.0		CPVC80	4.00	T-501	D-501	60	90	145	90	NA	NA	HYD	90	V-503, V-504, V-512	5
SL	3"-SL-CVCP80-015-N	15.0		CPVC80	3.00	D-501	P-502	10	90	145	90	NA	NA	HYD	15	V-507	5
SL	2"-SL-CVCP80-016-I	16.0		CPVC80	2.00	P-502	T-602	43	90	110	90	FRP	1	HYD	65	V-508, V-639	5, 6
SL	4"-SL-CVCP80-017-N	17.0		CPVC80	4.00	D-551	P-551	10	90	145	90	NA	NA	HTD	15	V-552	5
SL	4"-SL-CVCP80-018-N	18.0		CPVC80	4.00	P-551	T-551	60	90	145	90	NA	NA	HYD	90	V-566, V-567, V-571	5
SL	4"-SL-CVCP80-019-N	19.0		CPVC80	4.00	T-551	D-551	60	90	145	90	NA	NA	HYD	90	V-553, V-554, V-562	5

LINE DESIGNATION TABLE

SYS	FULL LINE NO.	LINE NO.	PIPE SPEC.	MATERIAL	SIZE (inch)	LOCATION FROM	LOCATION TO	NORMAL		DESIGN		INSULATION		TEST		VALVES	P&ID NO.
								OPERATING PRESS	TEMP	PRESS	TEMP	TYPE	THK	TYPE	PRESS		
								psig	(deg.F)	psig	(deg.F)		(inch)		psig		
SL	3"-SL-CVCP80-020-N	20.0		CPVC80	3.00	D-551	P-552	10	90	145	90	NA	NA	HYD	15	V-557	5
SL	2"-SL-CVCP80-021-I	21.0		CPVC80	2.00	P-552	2"-SL-CVCP80-016-I	43	90	110	90	FRP	1	HYD	55	V-558	5
SL	3"-SL-CVCP80-022-N	22.0		CPVC80	3.00	T-602	10"-WW-CVCP80-062-N & 4"-SL-CVCP80-005-N	ATMOS	90	145	90	NA	NA	HYD	15	V-416, V-416A	4, 6
SL	4"-SL-CVCP80-023-N	23.0		CPVC80	4.00	T-602	P-603	9	90	145	90	NA	NA	HYD	13	V-622	6
SL	3"-SL-CVCP80-024-N	24.0		CPVC80	3.00	P-603	T-901	43	90	110	90	NA	NA	HYD	FILL	V-623	6, 9
SL	3"-SL-CVCP80-025-N	25.0		CPVC80	3.00	3"-SL-CVCP80-024-N	TRUCK FILL	43	90	110	90	NA	NA	HYD	65	V-625	6
SL	3"-SL-CVCP80-026-N	26.0		CPVC80	3.00	T-901	P-901 & P-902	10	90	110	90	FRP	1.5	HYD	15	V-903, V-904, V-906	9
SL	3"-SL-CVCP80-027-N	27.0		CPVC80	3.00	P-901	X-901, 3"-SL-CVCP80-029-N	40	90	80	90	NA	NA	HYD	60	V-905, V-910, V-911	9
SL	3"-SL-CVCP80-028-N	28.0		CPVC80	3.00	X-902	T-902	ATMOS	90	110	90	NA	NA	HYD	15	V-932	9
SL	3"-SL-CVCP80-029-N	29.0		CPVC80	3.00	3"-SL-CVCP80-027-N	T-901	30	90	110	90	NA	NA	HYD	45	V-912	9
SL	3"-SL-CVCP80-030-N	30.0		CPVC80	3.00	3"-SL-CVCP80-029-N	3"-SL-CVCP80-032-N	ATMOS	90	110	90	NA	NA	HYD	15	V-913	9
SL	3"-SL-CVCP80-031-N	31.0		CPVC80	3.00	3"-SL-CVCP80-028-N	3"-SL-CVCP80-035-N	ATMOS	90	110	90	NA	NA	HYD	15	V-932	9
SL	3"-SL-CVCP80-032-N	32.0		CPVC80	3.00	X-901 DISCHARGE MANIFOLD	T-902	ATMOS	90	110	90	NA	NA	HYD	15		9
SL	2"-SL-CVCP80-033-N	33.0		CPVC80	2.00	X-901 DRIP TRAYS	3"-SL-CVCP80-032-N	ATMOS	90	110	90	NA	NA	HYD	15		9
SL	3"-SL-CVCP80-034-N	34.0		CPVC80	3.00	P-902	X-902 & 3"-SL-CVCP80-035-N	40	90	80	90	NA	NA	HYD	60	V-907, V-933, V-934	9
SL	3"-SL-CVCP80-035-N	35.0		CPVC80	3.00	3"-SL-CVCP80-034-N	3"-SL-CVCP80-029-N	40	90	80	90	NA	NA	HYD	60	V-935	9
SL	3"-SL-CVCP80-037-N	37.0		CPVC80	3.00	X-902 DISCHARGE MANIFOLD	3"-SL-CVCP80-028-N	ATMOS	90	110	90	NA	NA	HYD	15		9
SL	2"-SL-CVCP80-038-N	38.0		CPVC80	2.00	X-902 DRIP TRAYS	2"-SL-CVCP80-028-N	ATMOS	90	110	90	NA	NA	HYD	15		9
SL	3"-SL-CVCP80-039-N	39.0		CPVC80	3.00	D-501	3"-SL-CVCP80-015-N	10	90	110	90	NA	NA	HYD	15	V-506	5
SL	3"-SL-CVCP80-040-N	40.0		CPVC80	3.00	D-551	3"-SL-CVCP80-020-N	10	90	110	90	NA	NA	HYD	15	V-556	5
SL	3"-SL-CVCP80-041-N	41.0		CPVC80	3.00	T-902	END	ATMOS	90	NA	NA	NA	NA	NA			9
SLM		0															
SLM	2"-SLM-CVCP80-001-N	1.0		CPVC80	2.00	2"-SLM-CVCP80-001-N	SLM HEADER DROPS	85	90	110	90	NA	NA	HYD	148	V-1207	12
SLM	2"-SLM-CVCP80-001-N	1.0		CPVC80	2.00	STABILIZED LAKE MEAD WATER	2"-SW-CVCP80-002-N	85	90	110	90	NA	NA	HYD	148		6, 12
SLM	1 1/2" & 1/2"-SLM-CVCP80-001-HT&I	1.0		CPVC80	1.5&0.5	2"-SLM-CVCP80-001-N	SS-1202 THROUGH SS-1206	85	90	110	90	FRP	1	HYD	148	V-1202 TO -06	12
SLM	1/2"-SLM-CVCP80-001-HT&I	1.0		CPVC80	0.50	2"-SLM-CVCP80-001-N	BIOFILTER STRAINER S-401	85	90	110	90	FRP	1	HYD	148	V-401	4
SW		0															
SW	2", 1 1/2", 1" & 1/2"-SW-CVCP80-001-N	1.0		CPVC80	2, 1.5, 1, 0.5	8"-WW-CVCP80-072-N	SERVICE WATER MAIN HEADER & BRANCHES	18	90	110	90	NA	NA	HYD	27	V-609, V-635	6
SW	2"-SW-CVCP80-002-N	2.0		CPVC80	2.00	2"-SLM-CVCP80-001-N	2"-SW-CVCP80-001-N	18	90	110	90	NA	NA	HYD	27	V-629	6
SW	1"-SW-CVCP80-003-N	2.0		CPVC80	1.00	2"-SW-CVCP80-001-N	4"-SL-CVCP80-023-N	18	90	110	90	NA	NA	HYD	27	V-624	6
TW		0															
TW	8"-TW-CVCP80-001-N	1.0		CPVC80	8.00	X-621	TW-8-03009 (EXISTING)	38	90	110	90	NA	NA	HYD	57	V-627	6, 10C

LINE DESIGNATION TABLE

SYS	FULL LINE NO.	LINE NO.	PIPE SPEC.	MATERIAL	SIZE (inch)	LOCATION FROM	LOCATION TO	NORMAL		DESIGN		INSULATION		TEST		VALVES	P&ID NO.
								OPERATING PRESS	TEMP	PRESS	TEMP	TYPE	THK	TYPE	PRESS		
								psig	(deg.F)	psig	(deg.F)		(inch)		psig		
WW		0															
WW	6"-WW-CVCP80-001-N	1.0		CPVC80	6.00	10"-WW-CVCP80-100-N	6"-WW-CVCP80-002-N	60	90	110	90	NA	NA	HYD	90	FCV-1010, V-1020	1A
WW	6"-WW-CVCP80-002-N	2.0		CPVC80	6.00	6"-WW-CVCP80-001-N	12"-WW-CVCP40-005-N & -006-N	NA	NA	NA	NA	NA	NA	NA	NA	V-1170, V-1190	1A
WW	6"-WW-CVCP80-003-N	3.0		CPVC80	6.00	10"-WW-CVCP80-100-N	6"-WW-CVCP80-004-N	60	90	110	90	NA	NA	HYD	90	FCV-1020, V-1030	1A
WW	6"-WW-CVCP80-004-N	4.0		CPVC80	6.00	6"-WW-CVCP80-003-N	12"-WW-CVCP40-006-N & -007-N	NA	NA	NA	NA	NA	NA	NA	NA	V-1180, V-1200	1A
WW	12"-WW-CVCP40-005-N	5.0		CPVC40	12.00	20"-WW-FRPP-013-N	P-1011	NA	NA	NA	NA	NA	NA	NA	NA	V-1011	1A
WW	12"-WW-CVCP40-006-N	6.0		CPVC40	12.00	20"-WW-FRPP-013-N	P-101A	NA	NA	NA	NA	NA	NA	NA	NA	V-101A	1A
WW	12"-WW-CVCP40-007-N	7.0		CPVC40	12.00	20"-WW-FRPP-013-N	P-1012	NA	NA	NA	NA	NA	NA	NA	NA	V-1012	1A
WW	10"-WW-CVCP80-008-N	8.0		CPVC80	10.00	12"-WW-CVCP40-008-N	FBR-1	18	90	110	90	NA	NA	HYD	27	FV-1011, V-1131	1A
WW	12"-WW-CVCP40-008-N	8.0		CPVC40	12.00	P-1011	10"-WW-CVCP80-008-N	18	90	110	90	NA	NA	HYD	27	V-1041, V-1051	1A
WW	12"-WW-CVCP40-009-N	9.0		CPVC40	12.00	P-101A	12"-WW-CVCP40-028-N	NA	NA	NA	NA	NA	NA	NA	NA	V-104A, V-105A	1A
WW	10"-WW-CVCP80-010-N	10.0		CPVC80	10.00	12"-WW-CVCP40-010-N	FBR-2	18	90	110	90	NA	NA	HYD	27	FV-1012, V-1132	1A
WW	12"-WW-CVCP40-010-N	10.0		CPVC40	12.00	P-1012	10"-WW-CVCP80-010-N	18	90	110	90	NA	NA	HYD	27	V-1042, V-1052	1A
WW	16"-WW-FRPP-011-N	11.0		FRP	16.00	FBR-1	T-2011	10	90	50	90	NA	NA	HYD	15		1A, 2A
WW	16"-WW-FRPP-012-N	12.0		FRP	16.00	FBR-2	T-2011	10	90	50	90	NA	NA	HYD	15		1A, 2A
WW	20"-WW-FRPP-013-N	13.0		FRP	20.00	T-2011	12"-WW-CVCP40-005-N, -006-N & -007-N	10	90	50	90	NA	NA	HYD	15		1A, 2A
WW	10"-WW-CVCP80-014-N	14.0		CPVC80	10.00	T-2011	10"-WW-CVCP80-015-N	10	90	110	90	NA	NA	HYD	15	LCV-2011, V-3000	2A, 3A
WW	10"-WW-CVCP80-015-N	15.0		CPVC80	10.00	10"-WW-CVCP80-014-N & -043-N	10"-WW-CVCP80-016-N	18	90	110	90	NA	NA	HYD	27		3A
WW	10"-WW-CVCP80-016-N	16.0		CPVC80	10.00	10"-WW-CVCP80-015-N	6"-WW-CVCP80-017-N, -018-N, -046-N & -047-N	18	90	110	90	NA	NA	HYD	27	V-3300	3A, 3B
WW	6"-WW-CVCP80-017-N	17.0		CPVC80	6.00	10"-WW-CVCP80-016-N	6"-WW-CVCP80-044-N	18	90	110	90	NA	NA	HYD	27	FCV-3010, V-3030	3A
WW	6"-WW-CVCP80-018-N	18.0		CPVC80	6.00	10"-WW-CVCP80-016-N	6"-WW-CVCP80-045-N	18	90	110	90	NA	NA	HYD	27	FCV-3020, V-3040	3A
WW	12"-WW-CVCP40-019-N	19.0		CPVC40	12.00	20"-WW-FRPP-075-N	P-3015	NA	NA	NA	NA	NA	NA	NA	NA	V-3015	3A
WW	12"-WW-CVCP40-020-N	20.0		CPVC40	12.00	20"-WW-FRPP-075-N	P-3016	NA	NA	NA	NA	NA	NA	NA	NA	V-3016	3A
WW	12"-WW-CVCP40-021-N	21.0		CPVC40	12.00	20"-WW-FRPP-075-N	P-301A	NA	NA	NA	NA	NA	NA	NA	NA	V-301A	3A
WW	10"-WW-CVCP80-022-N	22.0		CPVC80	10.00	12"-WW-CVCP40-022-N	FBR-5	18	90	110	90	NA	NA	HYD	27	FV-3015, V-3135	3A
WW	12"-WW-CVCP40-022-N	22.0		CPVC40	12.00	P-3015	10"-WW-CVCP80-022-N	18	90	110	90	NA	NA	HYD	27	V-3045, V-3055	3A
WW	10"-WW-CVCP80-023-N	23.0		CPVC80	10.00	12"-WW-CVCP40-023-N	FBR-6	18	90	110	90	NA	NA	HYD	27	FV-3016, V-3136	3A
WW	12"-WW-CVCP40-023-N	23.0		CPVC40	12.00	P-3016	10"-WW-CVCP80-023-N	18	90	110	90	NA	NA	HYD	27	V-3046, V-3056	3A
WW	12"-WW-CVCP40-024-N	24.0		CPVC40	12.00	P-301A	12"-WW-CVCP40-025-N	18	90	110	90	NA	NA	HYD	27	V-304A, V-305A	3A
WW	12"-WW-CVCP40-025-N	25.0		CPVC40	12.00	12"-WW-CVCP40-024-N	12"-WW-CVCP80-022-N & -023-N	NA	NA	NA	NA	NA	NA	NA	NA	V-306A, V-307A	3A
WW	16"-WW-FRPP-026-N	26.0		FRP	16.00	FBR-5	T-3011	10	90	50	90	NA	NA	HYD	15		3A, 3C
WW	16"-WW-FRPP-027-N	27.0		FRP	16.00	FBR-6	T-3011	10	90	50	90	NA	NA	HYD	15		3A, 3C
WW	12"-WW-CVCP40-028-N	28.0		CPVC40	12.00	12"-WW-CVCP40-009-N	12"-WW-CVCP80-008-N & -010-N	NA	NA	NA	NA	NA	NA	NA	NA	V-106A, V-107A	1A

LINE DESIGNATION TABLE

SYS	FULL LINE NO.	LINE NO.	PIPE SPEC.	MATERIAL	SIZE (inch)	LOCATION FROM	LOCATION TO	NORMAL		DESIGN		INSULATION		TEST		VALVES	P&ID NO.
								OPERATING PRESS	TEMP	PRESS	TEMP	TYPE	THK	TYPE	PRESS		
								psig	(deg.F)	psig	(deg.F)		(inch)		psig		
WW	6"-WW-CVCP80-029-N	29.0		CPVC80	6.00	10"-WW-CVCP80-100-N	6"-WW-CVCP80-030-N	60	90	110	90	NA	NA	HYD	90	FCV-1110, V-1330	1B
WW	6"-WW-CVCP80-030-N	30.0		CPVC80	6.00	6"-WW-CVCP80-029-N	12"-WW-CVCP40-033-N & -034-N	NA	NA	NA	NA	NA	NA	NA	NA	V-1470, V-1490	1B
WW	6"-WW-CVCP80-031-N	31.0		CPVC80	6.00	10"-WW-CVCP80-100-N	6"-WW-CVCP80-032-N	60	90	110	90	NA	NA	HYD	90	FCV-1120, V-1340	1B
WW	6"-WW-CVCP80-032-N	32.0		CPVC80	6.00	6"-WW-CVCP80-031-N	12"-WW-CVCP40-034-N & -035-N	NA	NA	NA	NA	NA	NA	NA	NA	V-1480, V-1500	1B
WW	12"-WW-CVCP40-033-N	33.0		CPVC40	12.00	20"-WW-FRPP-042-N	P-1013	NA	NA	NA	NA	NA	NA	NA	NA	V-1013	1B
WW	12"-WW-CVCP40-034-N	34.0		CPVC40	12.00	20"-WW-FRPP-042-N	P-102A	NA	NA	NA	NA	NA	NA	NA	NA	V-111A	1B
WW	12"-WW-CVCP40-035-N	35.0		CPVC40	12.00	20"-WW-FRPP-042-N	P-1014	NA	NA	NA	NA	NA	NA	NA	NA	NA	1B
WW	10"-WW-CVCP80-036-N	36.0		CPVC80	10.00	12"-WW-CVCP40-036-N	FBR-3	18	90	110	90	NA	NA	HYD	27	FV-1013, V-1133	1B
WW	12"-WW-CVCP40-036-N	36.0		CPVC40	12.00	P-1013	10"-WW-CVCP80-036-N	18	90	110	90	NA	NA	HYD	27	V-1043, V-1053	1B
WW	12"-WW-CVCP40-037-N	37.0		CPVC40	12.00	P-102A	12"-WW-CVCP40-039-N	18	90	110	90	NA	NA	HYD	27	V-114A, V-115A	1B
WW	10"-WW-CVCP80-038-N	38.0		CPVC80	10.00	12"-WW-CVCP40-038-N	FBR-4	18	90	110	90	NA	NA	HYD	27	FV-1014, V-1134	1B
WW	12"-WW-CVCP40-038-N	38.0		CPVC40	12.00	P-1014	10"-WW-CVCP80-038-N	18	90	110	90	NA	NA	HYD	27	V-1044, V-1054	1B
WW	12"-WW-CVCP40-039-N	39.0		CPVC40	12.00	12"-WW-CVCP40-037-N	12"-WW-CVCP80-036-N & -038-N	NA	NA	NA	NA	NA	NA	NA	NA	V-116A, V-1530	1B
WW	16"-WW-FRPP-040-N	40.0		FRP	16.00	FBR-3	T-2012	10	90	110	90	NA	NA	HYD	15		1B, 2B
WW	16"-WW-FRPP-041-N	41.0		FRP	16.00	FBR-4	T-2012	10	90	110	90	NA	NA	HYD	15		1B, 2B
WW	20"-WW-FRPP-042-N	42.0		FRP	20.00	T-2012	12"-WW-CVCP40-033-N, -034-N & -035-N	10	90	50	90	NA	NA	HYD	15	15	1B, 2B
WW	10"-WW-CVCP80-043-N	43.0		CPVC80	10.00	T-2012	10"-WW-CVCP80-015-N	10	90	110	90	NA	NA	HYD	15	LCV-2012, V-3010	2B, 3A
WW	6"-WW-CVCP80-044-N	44.0		CPVC80	6.00	6"-WW-CVCP80-017-N	12"-WW-CVCP40-019-N & -021-N	NA	NA	NA	NA	NA	NA	NA	NA	V-3190, V-3170	3A
WW	6"-WW-CVCP80-045-N	45.0		CPVC80	6.00	6"-WW-CVCP80-018-N	12"-WW-CVCP40-020-N & -021-N	NA	NA	NA	NA	NA	NA	NA	NA	V-3180, V-3200	3A
WW	6"-WW-CVCP80-046-N	46.0		CPVC80	6.00	10"-WW-CVCP80-016-N	6"-WW-CVCP80-057-N	18	90	110	90	NA	NA	HYD	27	FCV-3030, V-3330	3B
WW	6"-WW-CVCP80-047-N	47.0		CPVC80	6.00	10"-WW-CVCP80-016-N	6"-WW-CVCP80-058-N	18	90	110	90	NA	NA	HYD	27	FCV-3040, V-3340	3B
WW	12"-WW-CVCP40-048-N	48.0		CPVC40	12.00	20"-WW-FRPP-059-N	P-3017	NA	NA	NA	NA	NA	NA	NA	NA	V-3017	3B
WW	12"-WW-CVCP40-049-N	49.0		CPVC40	12.00	20"-WW-FRPP-059-N	P-3018	NA	NA	NA	NA	NA	NA	NA	NA	V-3018	3B
WW	12"-WW-CVCP40-050-N	50.0		CPVC40	12.00	P-302A	12"-WW-CVCP80-119-N	NA	NA	NA	NA	NA	NA	NA	NA	V-314A, V-315A	3B
WW	10"-WW-CVCP80-051-N	51.0		CPVC80	10.00	12"-WW-CVCP40-051-N	FBR-7	18	90	110	90	NA	NA	HYD	27	FV-3017, V-3137	3B
WW	12"-WW-CVCP40-051-N	51.0		CPVC40	12.00	P-3017	10"-WW-CVCP80-051-N	18	90	110	90	NA	NA	HYD	27	V-3047, V-3057	3B
WW	10"-WW-CVCP80-052-N	52.0		CPVC80	10.00	12"-WW-CVCP40-052-N	FBR-8	18	90	110	90	NA	NA	HYD	27	FV-3018, V-3138	3B
WW	12"-WW-CVCP40-052-N	52.0		CPVC40	12.00	P-3018	10"-WW-CVCP80-052-N	18	90	110	90	NA	NA	HYD	27	V-3048, V-3058	3B
WW	12"-WW-CVCP40-053-N	53.0		CPVC40	12.00	20"-WW-FRPP-059-N	P-302A	NA	NA	NA	NA	NA	NA	NA	NA	V-311A	3B
WW	16"-WW-FRPP-055-N	55.0		FRP	16.00	FBR-7	T-3012	10	90	50	90	NA	NA	HYD	15		3B, 3D
WW	16"-WW-FRPP-056-N	56.0		FRP	16.00	FBR-8	T-3012	10	90	50	90	NA	NA	HYD	15		3B, 3D
WW	6"-WW-CVCP80-057-N	57.0		CPVC80	6.00	6"-WW-CVCP80-046-N	12"-WW-CVCP40-048-N & -053-N	NA	NA	NA	NA	NA	NA	NA	NA	V-3470, V-3490	3B
WW	6"-WW-CVCP80-058-N	58.0		CPVC80	6.00	6"-WW-CVCP80-047-N	12"-WW-CVCP40-049-N & -053-N	NA	NA	NA	NA	NA	NA	NA	NA	V-3480, V-3500	3B

LINE DESIGNATION TABLE

SYS	FULL LINE NO.	LINE NO.	PIPE SPEC.	MATERIAL	SIZE (inch)	LOCATION FROM	LOCATION TO	NORMAL		DESIGN		INSULATION		TEST		VALVES	P&ID NO.
								OPERATING	TEMP	PRESS	TEMP	TYPE	THK	TYPE	PRESS		
								psig	(deg.F)	psig	(deg.F)		(inch)		psig		
WW	20"-WW-FRPP-059-N	59.0		FRP	20.00	T-3012	12"-WW-CVCP40-048-N, -049-N & -053-N	10	90	50	90	NA	NA	HYD	15		3B, 3D
WW	10"-WW-CVCP80-060-N	60.0		CPVC80	10.00	T-3011	T-401	10	90	110	90	NA	NA	HYD	15	LCV-3011, V-417	3C, 4
WW	10"-WW-CVCP80-061-N	61.0		CPVC80	10.00	10"-WW-CVCP80-015-N	T-401	18	90	110	90	NA	NA	HYD	27	V-3020	3A, 4
WW	10"-WW-CVCP80-062-N	62.0		CPVC80	10.00	T-401	10"-WW-CVCP40-063-N & -066-N	ATMOS	90	110	90	NA	NA	HYD	15		4, 5
WW	10"-WW-CVCP80-063-N	63.0		CPVC80	10.00	10"-WW-CVCP80-062-N	14"-WW-CVCP80-063-N	10	90	110	90	NA	NA	HYD	15		5
WW	14"-WW-CVCP40-063-N	63.0		CPVC40	14.00	10"-WW-CVCP80-063-N	D-501 & 10"-WW-CVCP80-064-N	10	90	110	90	NA	NA	HYD	15	V-501	5
WW	10"-WW-CVCP80-064-N	64.0		CPVC80	10.00	14"-WW-CVCP40-063-N	10"-WW-CVCP80-065-N	10	90	110	90	NA	NA	HYD	15	V-525	5, 6
WW	10"-WW-CVCP80-065-N	65.0		CPVC80	10.00	D-501	T-601	10	90	110	90	NA	NA	HYD	15	V-505	5, 6
WW	10"-WW-CVCP80-066-N	66.0		CPVC80	10.00	10"-WW-CVCP80-062-N	14"-WW-CVCP80-066-N	10	90	110	90	NA	NA	HYD	15		5
WW	14"-WW-CVCP40-066-N	66.0		CPVC40	14.00	10"-WW-CVCP80-066-N	D-551 & 10"-WW-CVCP80-067-N	10	90	110	90	NA	NA	HYD	15	V-551	5
WW	10"-WW-CVCP80-067-N	67.0		CPVC80	10.00	14"-WW-CVCP40-066-N	10"-WW-CVCP80-065-N	10	90	110	90	NA	NA	HYD	15	V-575	5
WW	10"-WW-CVCP80-068-N	68.0		CPVC80	10.00	D-551	10"-WW-CVCP80-065-N	10	90	110	90	NA	NA	HYD	15	V-555	5
WW	8"-WW-CVCP80-069-N	69.0		CPVC80	8.00	10"-WW-CVCP80-069-N	P-602	NA	NA	NA	NA	NA	NA	NA	V-603	6	
WW	10"-WW-CVCP80-069-N	69.0		CPVC80	10.00	T-601	8"-WW-CVCP80-069-N & -070-N	10	90	110	90	NA	NA	HYD	15	V-601	6
WW	8"-WW-CVCP80-070-N	70.0		CPVC80	8.00	10"-WW-CVCP80-069-N	P-601	NA	NA	NA	NA	NA	NA	NA	V-605	6	
WW	8"-WW-CVCP80-071-N	71.0		CPVC80	8.00	P-602	8"-WW-CVCP80-072-N	40	90	110	90	NA	NA	HYD	60	V-604	6
WW	8"-WW-CVCP80-072-N	72.0		CPVC80	8.00	P-601	X-621	40	90	110	90	NA	NA	HYD	60	LCV-601, V-606, V-608, V-611, V-612, V-1320	1B, 6
WW	8"-WW-CVCP80-073-N	73.0		CPVC80	8.00	8"-WW-CVCP80-072-N	10"-WW-CVCP80-100-N	40	90	110	90	NA	NA	HYD	60		
WW	20"-WW-FRPP-075-N	75.0		FRP	20.00	T-3011	12"-WW-CVCP40-019-N, -020-N & -021-N	10	90	50	90	NA	NA	HYD	15		3A, 3C
WW	10"-WW-CVCP80-076-N	76.0		CPVC80	10.00	T-3012	N	ATMOS	90	110	90	NA	NA	HYD		LCV-3012	3D, 4
WW	1"-WW-CVCP80-077-I	77.0		CPVC80	1.00	16"-WW-FRPP-011-N	6"-WW-CVCP80-001-N	10	90	110	90	FRP	1	HYD	15	V-1221, V-1231, V-1241	1A
WW	1"-WW-CVCP80-078-I	78.0		CPVC80	1.00	16"-WW-FRPP-012-N	6"-WW-CVCP80-003-N	10	90	110	90	FRP	1	HYD	15	V-1222, V-1232, V-1242	1A
WW	1 1/2"-WW-CVCP80-079-N	79.0		CPVC80	1.50	T-2011	P-2011	12	90	110	90	NA	NA	HYD	18	FV-2011, FV-2031, V-2061, V-2071	2A
WW	1 1/2"-WW-CVCP80-080-N	80.0		CPVC80	1.50	P-2011	V-2061 & V-2071	30	90	90	90	NA	NA	HYD	45		2A
WW	1 1/2"-WW-CVCP80-081-N	81.0		CPVC80	1.50	V-2061	FBR-1	30	90	90	90	NA	NA	SERVICE	TEST		1A, 2A
WW	1"-WW-CVCP80-082-I	82.0		CPVC80	1.00	16"-WW-FRPP-026-N	6"-WW-CVCP80-017-N	10	90	90	90	FRP	1	HYD	15	V-3175, V-3185, V-3195	3A
WW	1"-WW-CVCP80-083-I	83.0		CPVC80	1.00	16"-WW-FRPP-027-N	6"-WW-CVCP80-018-N	10	90	90	90	FRP	1	HYD	15	V-3176, V-3186, V-3196	3A
WW	1 1/2"-WW-CVCP80-084-N	84.0		CPVC80	1.50	T-3011	P-3011	12	90	90	90	NA	NA	HYD	18	FV-3011, FV-3031, V-3631	3C
WW	1 1/2"-WW-CVCP80-085-N	85.0		CPVC80	1.50	P-3011	V-3661 & V-3671	30	90	90	90	NA	NA	HYD	45	V-3661, V-3671	3C
WW	1 1/2"-WW-CVCP80-086-N	86.0		CPVC80	1.50	V-3661	FBR-5	30	90	90	90	NA	NA	SERVICE	TEST		3A, 3C
WW	1"-WW-CVCP80-087-I	87.0		CPVC80	1.00	16"-WW-FRPP-040-N	6"-WW-CVCP80-029-N	10	90	90	90	FRP	1	HYD	15	V-1223, V-1233, V-1243	1B
WW	1"-WW-CVCP80-088-I	88.0		CPVC80	1.00	16"-WW-FRPP-041-N	6"-WW-CVCP80-031-N	10	90	90	90	FRP	1	HYD	15	V-1224, V-1234, V-1244	1B
WW	1 1/2"-WW-CVCP80-080-N	90.0		CPVC80	1.50	T-2012	P-2012	12	90	90	90	NA	NA	HYD	27	FV-2012, FV-2033, V-2032	2B

LINE DESIGNATION TABLE

SYS	FULL LINE NO.	LINE NO.	PIPE SPEC.	MATERIAL	SIZE (inch)	LOCATION FROM	LOCATION TO	NORMAL		DESIGN		INSULATION		TEST		VALVES	P&ID NO.
								OPERATING	TEMP	PRESS	TEMP	TYPE	THK	TYPE	PRESS		
								psig	(deg.F)	psig	(deg.F)		(inch)		psig		
WW	1 1/2"-WW-CVCP80-091-N	91.0		CPVC80	1.50	V-2062	FBR-3	30	90	90	90	NA	NA	SERVICE	TEST		1B, 2B
WW	1"-WW-CVCP80-092-I	92.0		CPVC80	1.00	16"-WW-FRPP-055-N	6"-WW-CVCP80-046-N	10	90	90	90	FRP	1	HYD	15	V-3177, V-3187, V-3197	3B
WW	1"-WW-CVCP80-093-I	93.0		CPVC80	1.00	16"-WW-FRPP-056-N	6"-WW-CVCP80-047-N	10	90	90	90	FRP	1	HYD	15	V-3178, V-3188, V-3198	3B
WW	1 1/2"-WW-CVCP80-094-N	94.0		CPVC80	1.50	T-3012	P-3012	12	90	90	90	NA	NA	HYD	27	FV-3012, FV-3032, V-3632	3D
WW	1 1/2"-WW-CVCP80-095-N	95.0		CPVC80	1.50	P-3012	V-3662 & V-3672	30	90	90	90	NA	NA	HYD	45		3D
WW	1 1/2"-WW-CVCP80-096-N	96.0		CPVC80	1.50	V-3662	FBR-7	30	90	90	90	NA	NA	SERVICE	TEST		3B, 3D
WW	1"-WW-CVCP80-097-HT&I	97.0		CPVC80	1.00	4"-BA-CVCP80-002-N	T-401	13	100	90	90	FRP	1	HYD	20	V-419	4
WW	2"-WW-CVCP80-098-N	98.0		CPVC80	2.00	T-902	P-903	10	90	90	90	NA	NA	HYD	15	V-914	9
WW	1"-WW-CVCP80-099-N	99.0		CPVC80	1.00	P-903	2"-WW-CVCP80-099-N	20	90	30	90	NA	NA	HYD	30	V-927, V-931	4, 9
WW	2"-WW-CVCP80-099-I	99.0		CPVC80	2.00	1"-WW-CVCP80-099-N	10"-WW-CVCP80-062-N	20	90	30	90	FRP	1	HYD	30		4
WW	8"-WW-CVCP80-100-N	100.0		CPVC80	8.00	EQUALIZED FEED	10"-WW-CVCP80-100-N	60	90	110	90	NA	NA	HYD	90	HV-216, PCV-1015	1B
WW	10"-WW-CVCP80-100-N	100.0		CPVC80	10.00	8"-WW-CVCP80-100-N	6"-WW-CVCP80-001-N, 003-N, 029-N & 0	60	90	110	90	NA	NA	HYD	90	HV-216, PCV-1015, V-1300, V-1543	1A, 1B
WW	1/2"-WW-CSTP40-101-N	101.0		CSTP40	0.50	P-801	AIR COMPRESSOR SKID DRAIN FUNNEL	ATMOS	90	NA	NA	NA	NA	NA	NA		8
WW	1/2"-WW-CSTP40-102-N	102.0		CSTP40	0.50	P-802	AIR COMPRESSOR SKID DRAIN FUNNEL	ATMOS	90	NA	NA	NA	NA	NA	NA		8
WW	1/2"-WW-CSTP40-104-N	104.0		CSTP40	0.50	T-801	AIR COMPRESSOR SKID DRAIN FUNNEL	ATMOS	90	NA	NA	NA	NA	NA	NA	V-807	8
WW	2"-WW-CVCP80-103-N	103.0		CPVC80	2.00	AIR COMPRESSOR SKID DRAIN FUNNEL	FLOOR DRAIN	ATMOS	90	NA	NA	NA	NA	NA	NA		8
WW	1/2"-WW-CSTP40-105-N	105.0		CSTP40	0.50	F-802	AIR COMPRESSOR SKID DRAIN FUNNEL	ATMOS	90	NA	NA	NA	NA	NA	NA		8
WW	1/2"-WW-CSTP40-106-N	106.0		CSTP40	0.50	F-803	AIR COMPRESSOR SKID DRAIN FUNNEL	ATMOS	90	NA	NA	NA	NA	NA	NA		8
WW	3"-WW-CVCP80-107-N	107.0		CPVC80	3.00	P-1101	3"-WW-CVCP80-108-N & -109-N	15	90	110	90	NA	NA	HYD	23	V-1101, V-1102	11
WW	3"-WW-CVCP80-108-N	108.0		CPVC80	3.00	P-1102	3"-WW-CVCP80-107-N & -109-N	15	90	110	90	NA	NA	HYD	23	V-1103, V-1104	11
WW	3"-WW-CVCP80-109-N	109.0		CPVC80	3.00	3"-WW-CVCP80-107-N & -108N	P-1202	15	90	110	90	NA	NA	HYD	23	V-1105	11
WW	1 1/2"-WW-CVCP80-110-N	110.0		CPVC80	1.50	V-2071	FBR-2	30	90	90	90	NA	NA	SERVICE	TEST		1A, 2A
WW	1 1/2"-WW-CVCP80-111-N	111.0		CPVC80	1.50	V-2072	FBR-4	30	90	90	90	NA	NA	SERVICE	TEST		1B, 2B
WW	1 1/2"-WW-CVCP80-112-N	112.0		CPVC80	1.50	V-3671	FBR-6	30	90	90	90	NA	NA	SERVICE	TEST		3A, 3C
WW	1 1/2"-WW-CVCP80-113-N	113.0		CPVC80	1.50	V-3672	FBR-8	30	90	90	90	NA	NA	SERVICE	TEST		3B, 3D
WW	2"-WW-CVCP80-114-N	114.0		CPVC80	2.00	T-402A & T-402B	T-404	9	90	110	90	NA	NA	HYD	FILL		4
WW	2"-WW-CVCP80-115-N	115.0		CPVC80	2.00	1"-WW-CVCP80-115-N	10"-WW-CVCP80-062-N	15	90	110	90	NA	NA	HYD	23		4
WW	1"-WW-CVCP80-115-N	115.0		CPVC80	1.00	P-402	2"-WW-CVCP80-115-N	15	90	110	90	NA	NA	HYD	23	V-412A	4
WW	1 1/2"-WW-CVCP80-116-N	116.0		CPVC80	1.50	P-2012	V-2062 & V-2072	30	90	110	90	NA	NA	HYD	45	V-2062, V-2072	2B
WW	2"-WW-CVCP80-117-N	117.0		CPVC80	2.00	8"-WW-CVCP80-072-N	T-601	18	90	110	90	NA	NA	HYD	27	V-616	6
WW	1/2"-WW-CVCP80-118-N	118.0		CPVC80	0.50	8"-WW-CVCP80-072-N	T-601	18	90	110	90	NA	NA	HYD	27	V-610	6
WW	12"-WW-CVCP80-119-N	119.0		CPVC80	12.00	12"-WW-CVCP80-050-N	12"-WW-CVCP80-051-N & -052-N	NA	NA	NA	NA	NA	NA	NA	NA	V-316A, V-317A	3B

LINE DESIGNATION TABLE

SYS	FULL LINE NO.	LINE NO.	PIPE SPEC.	MATERIAL	SIZE (inch)	LOCATION FROM	LOCATION TO	NORMAL		DESIGN		INSULATION		TEST		VALVES	P&ID NO.
								OPERATING	TEMP	PRESS	TEMP	TYPE	THK	TYPE	PRESS		
								psig	(deg.F)	psig	(deg.F)		(inch)		psig		
WW	1"-WW-CVCP80-120-N	120.0		CPVC80	1.00	8"-WW-CVCP80-100-N	10"-WW-CVCP80-100-N	60	90	110	90	NA	NA	HYD	90	V-1544, V-1547	18
WW	10"-WW-CVCP80-121-N	121.0		CPVC80	10.00	T-601	END	ATMOS	90	NA	NA	NA	NA	NA	NA		6
WW	4"-WW-CVCP80-122-N	122.0		CPVC80	4.00	T-901	END	ATMOS	90	NA	NA	NA	NA	NA	NA		9

Fluid Abbr.	Service
BA	Blower Air
ED	Electron Donor
FC	Ferric Chloride
IA	Instrument Air
NU	Nutrient
P	Polymer
PHA	Phosphoric Acid
POP	
PA	Process Air
SL	Sludge
SO4	
SH	Sodium Hydroxide (Caustic)
SLM	Stabilized Lake Mead Water
SW	Service Water
CA	Service Air
TW	Treated Water
WW	Wastewater

LEGEND:

HYD	=HYDROSTATIC LEAK TEST- For details on Testing Methods use Division 15
PNEU	= PNEUMATIC LEAK TEST
SER	= SERVICE LEAK TEST
VT	= VISUAL EXAMINATION
N	= NO INSULATION
H	= HEAT RETENTION
I	= PERSONEL PROTECTION INSULATION/PERSONEL PROTECTION
HT&I	= HEAT TRACE AND INSULATE FOR FREEZE PROTECTION
*	= INSULATE WITH CELLULAR GLASS INSULATION MATERIALS (SEE NOTE 1)
NA	= NOT APPLICABLE
ATMOS	= ATMOSPHERE

NOTES:

NERT
LINE DESIGNATION TABLE

SYS	FULL LINE NO.	LINE NO.	PIPE SPEC.	MATERIAL	SIZE (inch)	LOCATION FROM	LOCATION TO	NORMAL OPERATING		DESIGN		INSULATION		TEST		VALVES	Piping Drawing NO.	P&ID NO.
								PRESS psig	TEMP (deg.F)	PRESS psig	TEMP (deg.F)	TYPE	THK (inch)	TYPE	PRESS psig			
BA																		
CA																		
CA	2"-CA-CSTP40-470-N	470		CSTP40	2	AIR COMPRESSOR SKID	OXYGEN AIR TREATMENT SKID	110	100	150	90	NA	NA	PNEU	150	-	M-17, 67	8, 16
ED																		
ED	1/2"-ED-SO4P80-449-N	449		S04P80	1/2	P-73A	10"-WW-CVCP80-431-N	70	90	150	90	NA	NA	HYD	105	V-4492, 4493, 4494	M-10, 65	7B, 14
FC																		
IA																		
	1/2"-IA-CSTP40-100-N	100		CSTP40	1/2	INSTR AIR HEADER	X-621 (UV), FI-621 (@T-621)	100	90	150	90	NA	NA	PNEU	150	V-5191, 5190, FI-621	M-67, PID-10C	12, 10C
	1/2"-IA-CSTP40-443-N	443		CSTP40	1/2	INSTR AIR HEADER	FBR-A FLUIDIZATION PUMP SKID, FV-1401, BIOMASS SEP PNL	100	90	150	90	NA	NA	PNEU	150	V-4431, 4090, PCV-4430, SV-1401	M-10, 65, PID-14	12, 14
	3/4"-IA-CSTP40-486-N	486		CSTP40	3/4	INSTR AIR HEADER	T-1702 (SAND FILTER), FILTER REJECT PUMP SKID	100	90	150	90	NA	NA	PNEU	150	V-4860	M-68	12, 17
	3/8"-IA-POPT-493-N	493		POPT	3/8	FILTER REJECT PUMP SKID	T-1701	30	90	50	90	NA	NA	PNEU	VT		PID-17	17
NU																		
	3/8"-NU-POPT-448-N	448		POPT	3/8	P-72A	FBR-A FLUIDIZATION PUMP SKID	50	90	100	90	NA	NA	HYD	75	V-4484, 4485	M-16, 65 PID-7A, 14	7A, 14
O2																		
	3/4"-O2-SO4P80-475-N	475		S04P80	3/4	OXYGEN/AIR TREATMENT SKID	E-1302	40	90	50	90	NA	NA	PNEU	75	FV-1601, FI-1601, V-4751, 4752	M-67, 71PID-10C	16, 10C
	3/4"-O2-SO4P80-476-N	476		S04P80	3/4	3/4"-O2-SO4P80-475-N	E-1603	40	90	50	90	NA	NA	PNEU	75	V-4760, 4761, 4762, FV-1602, FI-1602	M-71, PID-16	16
P																		
	2"-P-CVCP80-530-N	530		CVCP80	2	POLYMER APPLICATION SKID P-930	T-901	30	90	30	90	NA	NA	HYD	45	-	M-67, 17, 18, 70	9
PA																		
PHA																		
PHA	3/8"-PHA-S16T-415-N	415		316 SS TUBE	3/8	P-1521	3/8"-NU-POPT-N @ FBR-1	50	90	100	90	NA	NA	HYD	75	V-4153, 4154	M-66,-125	15,1A
PHA	3/8"-PHA-S16T-526-N	526		316 SS TUBE	3/8	P-1522	3/8"-NU-POPT-N @ FBR-2	50	90	100	90	NA	NA	HYD	75	V-5262, 5263	M-66,-125	15,1A
PHA	3/8"-PHA-S16T-534-N	534		316 SS TUBE	3/8	P-1523	3/8"-NU-POPT-N @ FBR-3	50	90	100	90	NA	NA	HYD	75	V-5343, 5344	M-66,-125	15,1B
PHA	3/8"-PHA-S16T-536-N	536		316 SS TUBE	3/8	P-1524	3/8"-NU-POPT-N @ FBR-4	50	90	100	90	NA	NA	HYD	75	V-5362, 5363	M-66,-125	15,1B
PHA	3/8"-PHA-S16T-538-N	538		316 SS TUBE	3/8	P-1520A	10"-WW-CVCP80-431-N	50	90	100	90	NA	NA	HYD	75	V-5382, 5383	M-65,-125	15,14

NERT
LINE DESIGNATION TABLE

SYS	FULL LINE NO.	LINE NO.	PIPE SPEC.	MATERIAL	SIZE (inch)	LOCATION FROM	LOCATION TO	NORMAL OPERATING		DESIGN		INSULATION		TEST		VALVES	Piping Drawing NO.	P&ID NO.
								PRESS psig	TEMP (deg.F)	PRESS psig	TEMP (deg.F)	TYPE	THK (inch)	TYPE	PRESS psig			
SH																		
SH	2"-SH-CVCP80-002-N	2		CPVC80	2	T-701	EXIST CAUSTIC SKID	10	90	145	90	NA	NA	HYD	15	V-5165, 5160	M-16, 66	7A
SH	3"-SH-CVCP80-515-N	515		CPVC80	3	TRUCK FILL	T-701	20	90	145	90	NA	NA	HYD	30	V-5150, 5151	M-66	7A
SH	3/8"-SH-POPT-445-N	445		POPT	3/8	P-71A	FBR-A FLUIDIZATION PUMP SKID	50	90	100	90	NA	NA	HYD	75		M-16, 65, 105	7A, 14
SL																		
SL	4"-SL-CVCP80-491-N	491		CPVC80	4	P-603	T-1603	43	90	110	90	NA	NA	HYD	FILL	V-4910, V-4820	M-70, 18, 17, 67, 71	6.16
SL	4"-SL-CVCP80-477-N	477		CPVC80	4	T-1603	P-1601	10	90	145	90	NA	NA	HYD	VT	V-4770, 4771, 4776	M-71	16
SL	4"-SL-CVCP80-477A-N	477A		CPVC80	4	P-1601	T-1603 (MIXING MANIFOLD)	60	90	145	90	NA	NA	HYD	90	V-4774, 4775, 4791, 4790, 4800, 4810, E-1603	M-71	16
SL	4"-SL-CVCP80-478-N	478		CPVC80	4	4"-SL-477A	T-901	60	90	145	90	NA	NA	HYD	90	V-4780	M-71, 67, 17, 18, 70	16.9
SL	2"-SL-CVCP80-428-N	428		CPVC80	2	2"-SL-CVCP80-016-I	4"-SL-CVCP80-491-N	60	90	145	90	NA	NA	HYD	90	V-4280, 4281	M-70	6
SLM	AT AP-5 POND																	
SLM	3"-SLM-GCSP40-402-N	402		GCSP40	3	OLD D-1 FOUNDATION	3"-SLM-HDPEP11-402-N	120	90	120	90	NA	NA	HYD	180	V-4022, 4023, RPZ-4100 PCV-4100	M-69, 3-1	13
SLM	3"-SLM-HDPEP11-402-N	402		HDPEP11	3	3"-SLM-GCSP40-402-N	AP-5 PUMP SKID	85	90	110	90	NA	NA	HYD	148		M-3-1	13
SLM	2"-SLM-HDPEP11-402-N	402		HDPEP11	2	3"-SLM-HDPEP11-402-N	1/2"-SLM-CVCP80-483/484/485-HT&I	85	90	110	90	NA	NA	HYD	148	V-4830, 4840, 4850	M-3-1	13
SLM	3"-SLM-CVCP80-541-N	541		CPVCP80	3	AP-5 PUMP SKID	AP-5 POND SPRAY HEADER	85	90	110	90	NA	NA	HYD	148		M-3-2	13
SLM	AT EQUIPMENT AREA																	
SLM	1 1/2"-SLM-CVCP80-001-N	001		CPVC80	1 1/2	PRE EXIST SLM HDR (BLDG D-1)	SS-1210	85	90	110	90	NA	NA	HYD	148	V-1210	FIELD RUN	12
SLM	1 1/2"-SLM-CVCP80-001-N	001		CPVC80	1 1/2	PRE EXIST SLM HDR (BLDG D-1)	SS-1211	85	90	110	90	NA	NA	HYD	148	V-1211	FIELD RUN	12
SLM	1"-SLM-CVCP80-402A-N	402		CPVC80	1	1"-SLM-CVCP80-527-N	P-1601	85	90	110	90	NA	NA	HYD	148	V-4026, FI-4027	FIELD RUN	12, 16
SLM	1 1/2"-SLM-CVCP80-487-N	487		CPVC80	1 1/2	PRE EXIST SLM HDR (BLDG D-1)	P-1701A/B	85	90	110	90	NA	NA	HYD	148		M-68, 17	12, 17
SLM	1"-SLM-CVCP80-527-N	527		CPVC80	1	3"-SLM-CVCP80-001-N	DRY POLYMER FEED SKID	85	90	110	90	NA	NA	HYD	148	V-5271	M-67	12, 9
SLM	3"-SLM-CVCP80-540-N	540		CPVC80	3	LW-3-02504	BW-8-02005	85	90	110	90	NA	NA	HYD	148	V-5401	M-31	10B
SLM	2"-SLM-CVCP80-546-N	546		CPVC80	2	2"-SLM-CVCP80-001-N	SS-1208 (HT&I @ SHOWER)	85	90	110	90	NA	NA	HYD	148	V-4000	M-11, 10, 65	12
SLM	2"-SLM-CVCP80-539-N	539		CPVC80	1	2"-SLM-CVCP80-544-N	PHOSPHORIC ACID PUMP SKID	85	90	110	90	NA	NA	HYD	148		M-16, 66	12, 15
SLM	2"-SLM-CVCP80-544-N	544		CPVC80	1	2"-SLM-CVCP80-001-N	NUTRIENT FEED SKID	85	90	110	90	NA	NA	HYD	148	V-5440	M-16	12, 7A
SW																		
SW	1 1/2"-SW-CVCP80-440-N	440		CPVC80	1 1/2	1 1/2"-SW-CVCP80-001-N	1 1/2"-VW-CVCP80-438-N	85	90	110	90	NA	NA	HYD	148	V-4403, 4401, 4402	M-10, 65	2A, 14
SW	1 1/2"-SW-CVCP80-441-N	441		CPVC80	1 1/2	1 1/2"-SW-CVCP80-440-N	FLUIDIZATION PUMP SKID	85	90	110	90	NA	NA	HYD	148	V-4411	M-65, 105	14
SW	1 1/2"-SW-CVCP80-461-N	461		CPVC80	1 1/2	1 1/2"-SW-CVCP80-441-N	FBR-A	85	90	110	90	NA	NA	HYD	148	V-4610, 4612	M-65, 103	14
SW	1 1/2"-SW-CVCP80-545-N	545		CPVC80	1 1/2	1 1/2"-SW-CVCP80-001-N	FBR CATWALK	85	90	110	90	NA	NA	HYD	148	V-5404, 5406, 5405	FIELD RUN	2A
SW	1"-SW-CVCP80-540-N	540		CPVC80	1	2"-SW-CVCP80-001-N	2"-SL-CVCP80-428-N	85	90	110	90	NA	NA	HYD	148	V-5390, 5400	M-70	6
TW																		

NERT
LINE DESIGNATION TABLE

SYS	FULL LINE NO.	LINE NO.	PIPE SPEC.	MATERIAL	SIZE (inch)	LOCATION FROM	LOCATION TO	NORMAL OPERATING		DESIGN		INSULATION		TEST		VALVES	Piping Drawing NO.	P&ID NO.
								PRESS psig	TEMP (deg.F)	PRESS psig	TEMP (deg.F)	TYPE	THK (inch)	TYPE	PRESS psig			
WW	AT AP-5 POND TO GW-11 POND																	
WW	4"-WW-EPDMH-406-N (AND SPARE)	406		EPDM CHEM DUTY SUCTION	4	AP-5 POND	AP-5 PUMP SKID	VAC	90	30	90	NA	NA	HYD	NA	S-1302	M-3-2	13
WW	3"-WW-CVCP80-426-N	426		CPVC80	3	AP-5 PUMP SKID	AP-5 POND SPRAY HEADER	50	90	110	90	NA	NA	HYD	75		M-3-2	13
WW	6"-WW-HDPEP11-407-N	407		HDPEP11	6	AP-5 PUMP SKID	6"-WW-CVCP80-407-N	50	90	110	90	NA	NA	HYD	75		M-3-1, 69-1	13, 10A
WW	6"-WW-CVCP80-407-N	407		CPVC80	6	6"-WW-HDPEP11-407-N	GWTP EFFLUENT	50	90	110	90	NA	NA	HYD	75	V-4074, 4075, 4076, FE-AP-5	M-69 SHT 2	10A
WW	6"-WW-HDPEP11-408-N	408		HDPEP11	6	RW-6-01001	GW-11 SPRAY HEADER	50	90	110	90	NA	NA	HYD	75	V-4078, V-4081	M-69	10A
WW	2"-WW-HDPEP11-405-N	405		HDPEP11	2	AP-5 SPRAY HEADER	POND (TYP 3 PLCS)	50	90	110	90	NA	NA	HYD	75	V-EXIST	M-3	13
WW	AT FBR-A																	
WW	6"-WW-CVCP80-417-N	417		CPVC80	6	10"WW-CVCP80-100-N	FBR-A FLUIDIZATION SKID	60	90	110	90	NA	NA	HYD	90	V-4174, FE-1440	M-10, 65, 105	1A, 14
WW	12"-WW-CVCP80-429-N	429		CPVC80	12	T-1401	FBR-A FLUIDIZATION SKID	10	90	50	90	NA	NA	HYD	15		M-65, 105	14
WW	10"-WW-CVCP80-431-N	431		CPVC80	10	FBR-A FLUIDIZATION SKID	FBR-A	18	90	110	90	NA	NA	HYD	27	FE-1401, FV-1401, V-4319	M-65, 105	14
WW	14"-WW-FRPP-434-N	434		FRP	14	FBR-A (16" CONNS)	T-1401	10	90	50	90	NA	NA	HYD	15		M-65	14
WW	6"-WW-CVCP80-452-N	452		CPVC80	6	T-1401	10" WW-CVCP80-015-N	10	90	110	90	NA	NA	HYD	15	V-4520	M-65, 10	14, 3A
WW	1 1/2"-WW-CVCP80-438-N	438		CPVC80	1 1/2	T-1401	P-1410	12	90	110	90	NA	NA	HYD	18	V-4381, 4382, 4383	M-65	14
WW	1 1/2"-WW-CVCP80-439-N	439		CPVC80	1 1/2	P-1410	FBR-A	30	90	90	90	NA	NA	HYD	SERVICE	V-4390, 4391	M-65	14
WW	1"-WW-CVCP80-444-I	444		CPVC80	1	14"-WW-FRPP-434-N	FBR-A FLUIDIZATION SKID	10	90	110	90	FRP	1	HYD	15	V-4440	M-65	14
WW	AT PLANT EFFLUENT																	
WW	10"-WW-CVCP80-489-N	489		CPVC80	10	T-1702 (SAND FILTER EFFLUENT)	T-621 (EFFLUENT TANK)	40	90	110	90	NA	NA	HYD	60	V-4890, 4891, 4892, 4893, X-621	M17, -68, 67, 71	17, 10C
WW	4"-WW-CVCP80-495-N	495		CPVC80	4	T-1702 (SAND FILTER REJECT)	T-1701	ATMOS	90	50	90	NA	NA	HYD	SER		M-68	17
WW	8"-WW-CVCP80-502-N	502		CPVC80	8	8"-WW-CVCP80-001-N	T-1702 (SAND FILTER INLET)	38	90	110	90	NA	NA	HYD	57	V-5020	M-17, 68	6, 17
WW	10"-WW-CVCP80-520-N	520		CPVC80	10	T-621	P-1302A	38	90	50	90	NA	NA	HYD	57	V-5201, 5200	M-71	10C
WW	10"-WW-CVCP80-521-N	521		CPVC80	10	10"-WW-CVCP80-520-N	P-1302B	38	90	50	90	NA	NA	HYD	57	V-5210	M-71	10C
WW	10"-WW-CVCP80-522-N	522		CPVC80	10	8"-TW-CVCP80-001-N	10"-WW-CVCP80-489-N	38	90	110	90	NA	NA	HYD	57	V-5220	M-71, 67	10C
WW	3"-WW-CVCP80-409-N	409		CPVC80	3	3"-WW-CVCP80-490-N	10"-WW-CVCP80-162-N	30	90	110	90	NA	NA	HYD	45	V-4090	M-70, 15, 14, 27	17, 4
WW	3"-WW-CVCP80-490-N	490		CPVC80	3	FILTER REJECT PUMP SKID	T-602	30	90	110	90	NA	NA	HYD	45	V-4902, 4903	M-68, 17, 18, 70	17, 6
WW	3"-WW-CVCP80-498-N	498		CPVC80	3	T-1701	FILTER REJECT PUMP SKID	10	90	50	90	NA	NA	HYD	15	V-4983, 4981	M-68	17
WW	1"-WW-CVCP80-547-N	547		CPVC80	1	TW-8-11001	10"-WW-CVCP80-520-N	85	90	110	90	NA	NA	HYD	148	V-5470, 5471, E-1302	M-71	10C
WW	1/2"-WW-POPT-489-N	489		CPVC/POPT	1/2	10"-WW-CVCP80-489-N	D-I SUMP TRENCH	ATMOS	90	50	90	NA	NA	HYD	VT	V-4894, 4895, AE-1702	M-71	10C, 11
WW	1"-WW-CVCP80-501-N	501		CPVC80	1	FILTER REJECT PUMP SKID	4"-WW-CVCP80-495-N	60	90	110	90	NA	NA	HYD	90	-	M-68	17

NERT
LINE DESIGNATION TABLE

SYS	FULL LINE NO.	LINE NO.	PIPE SPEC.	MATERIAL	SIZE (inch)	LOCATION FROM	LOCATION TO	NORMAL OPERATING		DESIGN		INSULATION		TEST		VALVES	Piping Drawing NO.	P&ID NO.
								PRESS psig	TEMP (deg.F)	PRESS psig	TEMP (deg.F)	TYPE	THK (inch)	TYPE	PRESS psig			

<u>Fluid</u>	<u>Service</u>	<u>LEGEND:</u>
<u>Abbr.</u>		
BA	Blower Air	HYD =HYDROSTATIC LEAK TEST- For details on Testing Methods use Division 15orate Removal Syst
ED	Electron Donor	PNEU = PNEUMATIC LEAK TEST
FC	Ferric Chloride	SER = SERVICE LEAK TEST
IA	Instrument Air	VT = VISUAL EXAMINATION
NU	Nutrient	N = NO INSULATION
O2	Oxygen	H = HEAT RETENTION
P	Polymer	I = PERSONEL PROTECTION INSULATION/PERSONEL PROTECTION
PHA	Phosphoric Acid	HT&I = HEAT TRACE AND INSULATE FOR FREEZE PROTECTION
PA	Process Air	* = INSULATE WITH CELLULAR GLASS INSULATION MATERIALS (SEE NOTE 1)
SL	Sludge	NA = NOT APPLICABLE
SH	Sodium Hydroxide (Caustic)	ATMOS = ATMOSPHERE
SLM	Stabilized Lake Mead Water	
SW	Service Water	
CA	Service Air	
TW	Treated Water	
WW	Wastewater	

- NOTES:**
1. ALL OTHER INSULATION TO BE MANVILLE MICRO-LOK OR EQUAL FIBERGLASS WITH AN ALL PURPOSE JACKET.
 2. CONTRACTOR SHALL INSTALL MULTIFUNCTION VALVES FOR METERING PUMPS. VALVES WILL BE SUPPLIED BY SHAW.
 3. CONSERVATION VALVE, CONTROL VALVES AND VALVES THAT ARE NOT NUMBERED WILL BE SUPPLIED BY SHAW.

INSTRUMENT LIST

Customer: Nevada Environmental Response Trust (NERT)
 Location: Henderson, NV
 Project No.: 1373-101
 Date Issued: 04/28/14

Project Mgr: M. DelVecchio
 Project Eng: D. Watt
 Project Eng:
 Revision: 4
 Date Revision Issued: 04/28/14

Items modified or added

ITEM NO.	TAG NO.	DESCRIPTION	SIZE/TYPE	Range	MANUFACTURER	NOTES	P&ID NO.
FLOW INSTRUMENTS							
1	FIT/FE-1010	P-1011 Feedwater Flow Meter	6" / Orifice Plate	0-350 gpm	Fisher Rosemount		1A
2	FIT/FE-1020	P-1012 Feedwater Flow Meter	6" / Orifice Plate	0-350 gpm	Fisher Rosemount		1A
3	FIT/FE-1011	FBR-1 Influent Flow Meter	10" / Orifice Plate	0-3400 gpm	Fisher Rosemount		1A
4	FIT/FE-1012	FBR-2 Influent Flow Meter	10" / Orifice Plate	0-3400 gpm	Fisher Rosemount		1A
5	FIT/FE-1110	P-1013 Feedwater Flow Meter	6" / Orifice Plate	0-350 gpm	Fisher Rosemount		1B
6	FIT/FE-1120	P-1014 Feedwater Flow Meter	6" / Orifice Plate	0-350 gpm	Fisher Rosemount		1B
7	FIT/FE-1013	FBR-3 Influent Flow Meter	10" / Orifice Plate	0-3400 gpm	Fisher Rosemount		1B
8	FIT/FE-1014	FBR-4 Influent Flow Meter	10" / Orifice Plate	0-3400 gpm	Fisher Rosemount		1B
9	FI-2011	Instrument Air Flow Indicator	3/8" / Variable Area	0 - 1 SCFH	Wallace & Tiernan		2A
10	FI-2012	Instrument Air Flow Indicator	3/8" / Variable Area	0 - 1 SCFH	Wallace & Tiernan		2B
11	FIT/FE-3010	P-3015 Feedwater Flow Meter	6" / Orifice Plate	0-350 gpm	Fisher Rosemount		3A
12	FIT/FE-3020	P-3016 Feedwater Flow Meter	6" / Orifice Plate	0-350 gpm	Fisher Rosemount		3A
13	FIT/FE-3015	FBR-5 Influent Flow Meter	10" / Orifice Plate	0-3400 gpm	Fisher Rosemount		3A
14	FIT/FE-3016	FBR-6 Influent Flow Meter	10" / Orifice Plate	0-3400 gpm	Fisher Rosemount		3A
15	FI-3015	FBR-5 Biomass Separator instrument air flow indicator	1/4" / Variable Area	0 - 100 SCFH	Wallace & Tiernan		3A
16	FI-3025	FBR-5 Biomass Separator instrument air flow indicator	1/4" / Variable Area	0 - 100 SCFH	Wallace & Tiernan		3A
17	FI-3016	FBR-6 Biomass Separator instrument air flow indicator	1/4" / Variable Area	0 - 100 SCFH	Wallace & Tiernan		3A
18	FI-3026	FBR-6 Biomass Separator instrument air flow indicator	1/4" / Variable Area	0 - 100 SCFH	Wallace & Tiernan		3A
19	FIT/FE-3030	P-3017 Feedwater Flow Meter	6" / Orifice Plate	0-350 gpm	Fisher Rosemount		3B
20	FIT/FE-3040	P-3018 Feedwater Flow Meter	6" / Orifice Plate	0-350 gpm	Fisher Rosemount		3B
21	FIT/FE-3017	FBR-7 Influent Flow Meter	10" / Orifice Plate	0-3400 gpm	Fisher Rosemount		3B
22	FIT/FE-3018	FBR-8 Influent Flow Meter	10" / Orifice Plate	0-3400 gpm	Fisher Rosemount		3B
23	FI-3017	FBR-7 Biomass Separator instrument air flow indicator	1/4" / Variable Area	0 - 100 SCFH	Wallace & Tiernan		3B
24	FI-3027	FBR-7 Biomass Separator instrument air flow indicator	1/4" / Variable Area	0 - 100 SCFH	Wallace & Tiernan		3B
25	FI-3018	FBR-8 Biomass Separator instrument air flow indicator	1/4" / Variable Area	0 - 100 SCFH	Wallace & Tiernan		3B
26	FI-3028	FBR-8 Biomass Separator instrument air flow indicator	1/4" / Variable Area	0 - 100 SCFH	Wallace & Tiernan		3B
27	FI-3011	Instrument Air Flow Indicator	3/8" / Variable Area	0 - 1 SCFH	Wallace & Tiernan		3C
28	FI-3012	Instrument Air Flow Indicator	3/8" / Variable Area	0 - 1 SCFH	Wallace & Tiernan		3D
29	FI- 501	DAF Pressure Tank T-501 Instrument Air Flow Indicator	3/8" / Variable Area	0 - 5 SCFM	Wallace & Tiernan		5
30	FE/FIT-502	DAF Recycle Flow Meter	4" / Orifice Plate	0 - 144 gpm	Fisher Rosemount		5
31	FE/FIT-503	DAF D-501 Bypass Flow Meter	14" / Orifice Plate		Fisher Rosemount		5
32	FI- 505	DAF Pressure Tank T-505 Instrument Air Flow Indicator	3/8" / Variable Area	0 - 5 SCFM	Wallace & Tiernan		5
33	FE/FIT-506	DAF Recycle Flow Meter	4" / Orifice Plate	0 - 144 gpm	Fisher Rosemount		5
34	FE/FIT-507	DAF D-505 Bypass Flow Meter	14" / Orifice Plate		Fisher Rosemount		5
35	FI-601	Effluent tank T-601 bubbler system air flow indicator	3/8" / Variable Area	0 - 1 SCFH	Wallace & Tiernan		6
36	FIT/FE-602	UV Disinfection Effluent Flow Meter DELETED	8" / Orifice Plate		Fisher Rosemount		6
37	FS-721	Nutrient feed metering pump P-721 discharge flow switch			pump manufacturer		7A
38	FS-722	Nutrient feed metering pump P-722 discharge flow switch			pump manufacturer		7A
39	FS-723	Nutrient feed metering pump P-723 discharge flow switch			pump manufacturer		7A
40	FS-724	Nutrient feed metering pump P-724 discharge flow switch			pump manufacturer		7A

INSTRUMENT LIST

Customer: Nevada Environmental Response Trust (NERT)
 Location: Henderson, NV
 Project No.: 1373-101
 Date Issued: 04/28/14

Project Mgr: M. DelVecchio
 Project Eng: D. Watt
 Project Eng:
 Revision: 4
 Date Revision Issued: 04/28/14

Items modified or added

ITEM NO.	TAG NO.	DESCRIPTION	SIZE/TYPE	Range	MANUFACTURER	NOTES	P&ID NO.
41	FS-725	Nutrient feed metering pump P-725 discharge flow switch			pump manufacturer		7A
42	FS-726	Nutrient feed metering pump P-726 discharge flow switch			pump manufacturer		7A
43	FS-727	Nutrient feed metering pump P-727 discharge flow switch			pump manufacturer		7A
44	FS-728	Nutrient feed metering pump P-728 discharge flow switch			pump manufacturer		7A
45	FE/FIT-739	Electron donor booster pump P-739 discharge flow meter	1" vortex flow meter	0 - 17 gpm	Fisher Rosemount		7B
46	FS-901	Filter Press feed pumps P-901 inlet air flow switch	1/2"				9
47	FS-902	Filter Press feed pumps P-902 inlet air flow switch	1/2"				9
LEVEL INSTRUMENTS							
48	LIT-2011	Separator Tank T-2011 Level Indicating Transmitter	pressure	0-120" W.C.	Fisher Rosemount		2A
49	LIT-2012	Separator Tank T-2012 Level Indicating Transmitter	pressure	0-120" W.C.	Fisher Rosemount		2B
50	LIT-3011	Separator Tank T-3011 Level Indicating Transmitter	pressure	0-120" W.C.	Fisher Rosemount		3C
51	LIT-3012	Separator Tank T-3012 Level Indicating Transmitter	pressure	0-120" W.C.	Fisher Rosemount		3D
52	LSH-401	Aeration Tank T-401 High Level Switch	2" Flange / tuning fork		Endress + Hauser		4
53	LT/LE-501	DAF Pressure Tank T-501 Level	2" Flange / capacitance		Endress + Hauser		5
54	LSH-502	DAF Vessel Float Tank D-501 High Level Float Switch	3" Flange / tuning fork		Endress + Hauser		5
55	LT/LE-551	DAF Pressure Tank T-551 Level	2" Flange / capacitance		Endress + Hauser		5
56	LSH-505	DAF Vessel Float Tank D-551 High Level Float Switch	2" Flange / tuning fork		Endress + Hauser		5
57	LT-601	Effluent Tank T-601 Level Transmitter	Pressure		Fisher Rosemount		6
58	LI/LSL-701	pH tank T-701 level indicator with low level switch	2" / Site Gauge		GEMS		7A
59	LI/LSL-717	Nutrient tank T-702 level indicator with low level switch	2" / Site Gauge		GEMS		7A
60	LE/LIT-703	Electron Donor Tank T-703 level transmitter	magnetostrictive probe		OMNTEC		7B
61	LS-703A	Electron Donor Tank T-703 leak detection level switch	optic		OMNTEC		7B
62	LS-703B	Electron Donor Tank T-703 leak detection level switch	optic		OMNTEC		7B
63	LI/LSL-704	Polymer feed tank T-704 level indicator with low level switch	2" / Site Gauge		GEMS		7B
64	LI/LSL-705	Polymer feed tank T-705 level indicator with low level switch	2" / Site Gauge		GEMS		7B
65	LE/LIT-751	Ferric chloride storage tank T-751 level transmitter.	ultrasonic		Endress + Hauser		7C
66	LS-751	Ferric chloride storage tank T-751 leak detection level switch.	2" Flange / tuning fork		Endress + Hauser		7C
67	LSH-752	Lime Silo T-752 high level switch	2" Flange / tuning fork		Endress + Hauser		7C
68	LSL-752	Lime Silo T-752 low level switch	2" Flange / tuning fork		Endress + Hauser		7C
69	LSH-755	Lime Silo T-752 Hopper high level switch	2" Flange / tuning fork		Endress + Hauser		7C
70	LSL-755	Lime Silo T-752 hopper low level switch	2" Flange / tuning fork		Endress + Hauser		7C
71	LSH-901	Sludge conditioning Tank T-901 high level switch	2" Flange / tuning fork		Endress + Hauser		9
72	LSL-901	Sludge conditioning Tank T-901 low level switch	2" Flange / tuning fork		Endress + Hauser		9
73	LSLL-901	Sludge conditioning Tank T-901 low level switch	2" Flange / tuning fork		Endress + Hauser		9
74	LSHH-902	Filtrate tank T-902 high level switch	1-1/2" Flange / tuning fork		Endress + Hauser		9
75	LSH-902	Filtrate tank T-902 high level switch	1-1/2" Flange / tuning fork		Endress + Hauser		9
76	LSL-902	Filtrate tank T-902 low level switch	1-1/2" Flange / tuning fork		Endress + Hauser		9
PRESSURE INSTRUMENTS							

INSTRUMENT LIST

Customer: Nevada Environmental Response Trust (NERT)
 Location: Henderson, NV
 Project No.: 1373-101
 Date Issued: 04/28/14

Project Mgr: M. DelVecchio
 Project Eng: D. Watt
 Project Eng:
 Revision: 4
 Date Revision Issued: 04/28/14

Items modified or added

ITEM NO.	TAG NO.	DESCRIPTION	SIZE/TYPE	Range	MANUFACTURER	NOTES	P&ID NO.
63	PCV-1010	FCV-1010 air regulator		0-160 psi	control valve manufacturer		1A
64	PI-1020	FCV-1010 air regulator Pressure Gauge		0-160 psi	control valve manufacturer		1A
65	PCV-1020	FCV-1020 air regulator		0-160 psi	control valve manufacturer		1A
66	PI-1030	FCV-1020 air regulator Pressure Gauge		0-160 psi	control valve manufacturer		1A
67	PI-1040	P-1011 suction pressure	3-1/2" / Bourdon tube	0-30 psi	Ashcroft 1009		1A
68	PI-1050	P-1012 suction pressure	3-1/2" / Bourdon tube	0-30 psi	Ashcroft 1009		1A
69	PI-1011	P-1011 discharge pressure	3-1/2" / Bourdon tube	0-30 psi	Ashcroft 1009		1A
70	PI-1012	P-1012 discharge pressure	3-1/2" / Bourdon tube	0-30 psi	Ashcroft 1009		1A
71	PI-101A	P-101A discharge pressure	3-1/2" / Bourdon tube	0-30 psi	Ashcroft 1009		1A
72	PS-1011	FBR-1 influent pressure switch		0-30 psi	Ashcroft		1A
73	PS-1012	FBR-2 influent pressure switch		0-30 psi	Ashcroft		1A
74	PI-1021	FBR-1 influent pressure gauge	3-1/2" / Bourdon tube	0-30 psi	Ashcroft 1009		1A
75	PI-1022	FBR-2 influent pressure gauge	3-1/2" / Bourdon tube	0-30 psi	Ashcroft 1009		1A
76	PI-1031	P-1021 discharge pressure gauge	3-1/2" / Bourdon tube	0-30 psi	Ashcroft 1009		1A
77	PI-1032	P-1022 discharge pressure gauge	3-1/2" / Bourdon tube	0-30 psi	Ashcroft 1009		1A
78	PCV-1110	FCV-1110 air regulator		0-160 psi	control valve manufacturer		1B
79	PI-1120	FCV-1110 air regulator Pressure Gauge		0-160 psi	control valve manufacturer		1B
80	PCV-1120	FCV-1120 air regulator		0-160 psi	control valve manufacturer		1B
81	PI-1130	FCV-1020 air regulator Pressure Gauge		0-160 psi	control valve manufacturer		1B
82	PI-1140	P-1013 suction pressure	3-1/2" / Bourdon tube	0-30 psi	Ashcroft 1009		1B
83	PI-1150	P-1014 suction pressure	3-1/2" / Bourdon tube	0-30 psi	Ashcroft 1009		1B
84	PI-1013	P-1013 discharge pressure	3-1/2" / Bourdon tube	0-30 psi	Ashcroft 1009		1B
85	PI-1014	P-1014 discharge pressure	3-1/2" / Bourdon tube	0-30 psi	Ashcroft 1009		1B
86	PI-102A	P-102A discharge pressure	3-1/2" / Bourdon tube	0-30 psi	Ashcroft 1009		1B
87	PS-1013	FBR-3 influent pressure switch		0-30 psi	Ashcroft		1B
88	PS-1014	FBR-4 influent pressure switch		0-30 psi	Ashcroft		1B
89	PI-1023	FBR-3 influent pressure gauge	3-1/2" / Bourdon tube	0-30 psi	Ashcroft 1009		1B
90	PI-1024	FBR-4 influent pressure gauge	3-1/2" / Bourdon tube	0-30 psi	Ashcroft 1009		1B
91	PI-1033	P-1023 discharge pressure gauge	3-1/2" / Bourdon tube	0-30 psi	Ashcroft 1009		1B
92	PI-1034	P-1024 discharge pressure gauge	3-1/2" / Bourdon tube	0-30 psi	Ashcroft 1009		1B
93	PCV-2011	LCV-2011 inlet air regulator		0-160 psi	control valve manufacturer		2A
94	PI-2011	LCV-2011 air regulator Pressure Gauge		0-160 psi	control valve manufacturer		2A
95	PCV-2012	LCV-2012 inlet air regulator		0-160 psi	control valve manufacturer		2B
96	PI-2012	LCV-2012 air regulator Pressure Gauge		0-160 psi	control valve manufacturer		2B
97	PCV-3010	FCV-3010 air regulator		0-160 psi	control valve manufacturer		3A
98	PI-3030	FCV-3010 air regulator Pressure Gauge		0-160 psi	control valve manufacturer		3A
99	PCV-3020	FCV-3020 air regulator		0-160 psi	control valve manufacturer		3A
100	PI-3040	FCV-3020 air regulator Pressure Gauge		0-160 psi	control valve manufacturer		3A
101	PI-3010	P-3015 suction pressure gauge	3-1/2" / Bourdon tube	0-30 psi	Ashcroft 1009		3A
102	PI-3020	P-3016 suction pressure gauge	3-1/2" / Bourdon tube	0-30 psi	Ashcroft 1009		3A
103	PI-3015	P-3015 discharge pressure gauge	3-1/2" / Bourdon tube	0-30 psi	Ashcroft 1009		3A
104	PI-3016	P-3016 discharge pressure gauge	3-1/2" / Bourdon tube	0-30 psi	Ashcroft 1009		3A

INSTRUMENT LIST

Customer: Nevada Environmental Response Trust (NERT)
 Location: Henderson, NV
 Project No.: 1373-101
 Date Issued: 04/28/14

Project Mgr: M. DelVecchio
 Project Eng: D. Watt
 Project Eng:
 Revision: 4
 Date Revision Issued: 04/28/14

Items modified or added

ITEM NO.	TAG NO.	DESCRIPTION	SIZE/TYPE	Range	MANUFACTURER	NOTES	P&ID NO.
105	PI-301A	P-301A discharge pressure gauge	3-1/2" / Bourdon tube	0-30 psi	Ashcroft 1009		3A
106	PS-3015	FBR-5 influent pressure switch		0-30 psi	Ashcroft		3A
107	PS-3016	FBR-6 influent pressure switch		0-30 psi	Ashcroft		3A
108	PI-3025	FBR-5 influent pressure gauge	3-1/2" / Bourdon tube	0-30 psi	Ashcroft 1009		3A
109	PI-3026	FBR-6 influent pressure gauge	3-1/2" / Bourdon tube	0-30 psi	Ashcroft 1009		3A
110	PI-3035	FBR-5 service water pressure gauge	3-1/2" / Bourdon tube	0-60 psi	Ashcroft 1009		3A
111	PI-3036	FBR-6 service water pressure gauge	3-1/2" / Bourdon tube	0-60 psi	Ashcroft 1009		3A
112	PCV-3015	FBR-5 biomass separator air regulator		0-160 psi			3A
113	PI-3045	FBR-5 biomass separator air regulator pressure gauge		0-160 psi			3A
114	PCV-3025	FBR-5 biomass separator air regulator		0-160 psi			3A
115	PI-3055	FBR-5 biomass separator air regulator pressure gauge		0-160 psi			3A
116	PCV-3016	FBR-6 biomass separator air regulator		0-160 psi			3A
117	PI-3046	FBR-6 biomass separator air regulator pressure gauge		0-160 psi			3A
118	PCV-3026	FBR-6 biomass separator air regulator		0-160 psi			3A
119	PI-3056	FBR-6 biomass separator air regulator pressure gauge		0-160 psi			3A
120	PCV-3110	FCV-3030 air regulator		0-160 psi	control valve manufacturer		3B
121	PI-3130	FCV-3030 air regulator Pressure Gauge		0-160 psi	control valve manufacturer		3B
122	PCV-3120	FCV-3040 air regulator		0-160 psi	control valve manufacturer		3B
123	PI-3140	FCV-3040 air regulator Pressure Gauge		0-160 psi	control valve manufacturer		3B
124	PI-3110	P-3017 suction pressure gauge	3-1/2" / Bourdon tube	0-30 psi	Ashcroft 1009		3B
125	PI-3120	P-3018 suction pressure gauge	3-1/2" / Bourdon tube	0-30 psi	Ashcroft 1009		3B
126	PI-3017	P-3017 discharge pressure gauge	3-1/2" / Bourdon tube	0-30 psi	Ashcroft 1009		3B
127	PI-3018	P-3018 discharge pressure gauge	3-1/2" / Bourdon tube	0-30 psi	Ashcroft 1009		3B
128	PI-302A	P-302A discharge pressure gauge	3-1/2" / Bourdon tube	0-30 psi	Ashcroft 1009		3B
129	PS-3017	FBR-7 influent pressure switch		0-30 psi	Ashcroft		3B
130	PS-3018	FBR-8 influent pressure switch		0-30 psi	Ashcroft		3B
131	PI-3027	FBR-7 influent pressure gauge	3-1/2" / Bourdon tube	0-30 psi	Ashcroft 1009		3B
132	PI-3028	FBR-8 influent pressure gauge	3-1/2" / Bourdon tube	0-30 psi	Ashcroft 1009		3B
133	PI-3037	FBR-7 service water pressure gauge	3-1/2" / Bourdon tube	0-60 psi	Ashcroft 1009		3B
134	PI-3038	FBR-8 service water pressure gauge	3-1/2" / Bourdon tube	0-60 psi	Ashcroft 1009		3B
135	PCV-3017	FBR-7 biomass separator air regulator		0-160 psi			3B
136	PI-3047	FBR-7 biomass separator air regulator pressure gauge		0-160 psi			3B
137	PCV-3027	FBR-7 biomass separator air regulator		0-160 psi			3B
138	PI-3057	FBR-7 biomass separator air regulator pressure gauge		0-160 psi			3B
139	PCV-3018	FBR-8 biomass separator air regulator		0-160 psi			3B
140	PI-3048	FBR-8 biomass separator air regulator pressure gauge		0-160 psi			3B
141	PCV-3028	FBR-8 biomass separator air regulator		0-160 psi			3B
142	PI-3058	FBR-8 biomass separator air regulator pressure gauge		0-160 psi			3B
143	PCV-3011	LCV-3011 inlet air regulator		0-160 psi	control valve manufacturer		3C
144	PI-3011	LCV-3011 air regulator Pressure Gauge		0-160 psi	control valve manufacturer		3C
145	PCV-3012	LCV-3012 inlet air regulator		0-160 psi	control valve manufacturer		3D
146	PI-3012	LCV-3012 air regulator Pressure Gauge		0-160 psi	control valve manufacturer		3D

INSTRUMENT LIST

Customer: Nevada Environmental Response Trust (NERT)
 Location: Henderson, NV
 Project No.: 1373-101
 Date Issued: 04/28/14

Project Mgr: M. DelVecchio
 Project Eng: D. Watt
 Project Eng:
 Revision: 4
 Date Revision Issued: 04/28/14

Items modified or added

ITEM NO.	TAG NO.	DESCRIPTION	SIZE/TYPE	Range	MANUFACTURER	NOTES	P&ID NO.
147	PSV-401	Air Blower B-401 relief valve		set @ 15psi			4
148	PSL-401	Blower B-401 discharge line pressure switch (low)			Ashcroft		4
149	PSV-402	Aeration Tank T-401 pressure relief valve					4
150	PI-501	DAF Pressure Tank T-501 Vent pressure gauge	3-1/2" / Bourdon tube	0-100 psi	Ashcroft 1009		5
151	PSV-501	DAF Pressure Tank T-501 relief valve	1" Flange	60 psi	Farris		5
152	PI-502	DAF Pressure Pump P-501 discharge pressure gauge	3-1/2" / Bourdon tube	0-100 psi	Ashcroft 1009		5
153	PCV-501	DAF Pressure Tank T-501 air regulator w/ filter		0-160 psi			5
154	PI-510	DAF Pressure Pump P-501 suction pressure gauge	3-1/2" / Bourdon tube	0-15 psi	Ashcroft 1009		5
155	PI-503	DAF pressure tank T-501 air regulator pressure gauge	3-1/2" / Bourdon tube	0-160 psi	Ashcroft 1009		5
156	PCV-504	DAF Float pump P-502 air regulator w/ filter		0-160 psi	By pump manufacturer		5
157	PI-504	DAF float pump P-502 air regulator pressure gauge		0-160 psi	By pump manufacturer		5
158	PI-505	DAF Pressure Tank T-551 Vent pressure gauge	3-1/2" / Bourdon tube	0-100 psi	Ashcroft 1009		5
159	PSV-505	DAF Pressure Tank T-551 relief valve	1" Flange	60 psi	Farris		5
160	PI-506	DAF Pressure Pump P-551 discharge pressure gauge	3-1/2" / Bourdon tube	0-100 psi	Ashcroft 1009		5
161	PCV-505	DAF Pressure Tank T-551 air regulator w/ filter		0-160 psi			5
162	PI-508	DAF Pressure Pump P-551 suction pressure gauge	3-1/2" / Bourdon tube	0-15 psi	Ashcroft 1009		5
163	PI-507	DAF pressure tank T-551 air regulator pressure gauge	3-1/2" / Bourdon tube	0-160 psi	Ashcroft 1009		5
164	PCV-551	DAF Float pump P-552 air regulator w/ filter		0-160 psi	By pump manufacturer		5
165	PI-551	DAF float pump P-552 air regulator pressure gauge		0-160 psi	By pump manufacturer		5
166	PI-602	Effluent Pumps P-601/602 discharge pressure gauge	3-1/2" / Bourdon tube	0-50 psi	Ashcroft 1009		6
167	PCV-601	Effluent control valve LCV-601 actuator air regulator		0-160 psi	control valve manufacturer		6
168	PI-601	Effluent control valve LCV-601 air regulator pressure gauge		0-160 psi	control valve manufacturer		6
169	PI-603	Effluent Pressure Gauge		0-60 psi	Ashcroft 1009		6
170	PCV-739	Electron donor booster pump P-739 backpressure/safety valve					7B
171	PI-739	PCV-739 backpressure valve pressure gauge					7B
172	PSV-703	Electron donor tank T-703 conservation vent with flame arrester					7B
173	PSV-704	Electron donor tank T-703 safety relief valve					7B
174	PSV-705	Electron donor tank T-703 safety relief valve					7B
175	PI-751	Ferric Chloride feed pump P-751 discharge pressure gauge	3-1/2" / Bourdon tube	0-30 psi	Ashcroft 1009		7C
176	PSV-751	Lime Silo T-752 pressure relief valve					7C
177	PSV-803	Compressed Air Receiver tank T-801 pressure relief valve		150 psi			8
178	PI-801	Compressed Air Receiver tank T-801 pressure gauge		0-160 psi			8
179	PCV-802	Compressed Air Receiver tank T-801 discharge air regulator		set @ 110 psi			8
180	PI-802	Compressed Air Receiver tank T-801 discharge air regulator pressure gauge		0-160 psi			8
181	PCV-803	Compressed Air separator filter T-802 discharge air regulator		set @ 110 psi			8
182	PI-803	Compressed Air separator filter T-802 discharge air regulator pressure gauge	3-1/2" / Bourdon tube	0-160 psi	Ashcroft 1009		8
183	PSL-802	Compressed Air separator filter T-802 discharge air low pressure switch		80 psi	Ashcroft		8
184	PCV-901	Filter press feed pump P-901 inlet air regulator/filter		100 psi			9
185	PI-901	Filter press feed pump P-901 inlet air regulator/filter pressure gauge		0-160 psi			9

INSTRUMENT LIST

Customer: Nevada Environmental Response Trust (NERT)
 Location: Henderson, NV
 Project No.: 1373-101
 Date Issued: 04/28/14

Project Mgr: M. DelVecchio
 Project Eng: D. Watt
 Project Eng:
 Revision: 4
 Date Revision Issued: 04/28/14

Items modified or added

ITEM NO.	TAG NO.	DESCRIPTION	SIZE/TYPE	Range	MANUFACTURER	NOTES	P&ID NO.
186	PCV-902	Filter press feed pump P-902 inlet air regulator/filter		100 psi			9
187	PI-902	Filter press feed pump P-902 inlet air regulator/filter pressure gauge		0-160 psi			9
188		ANALYTICAL					
189	AE/AIT-1021	FBR-1 Recycle Water ORP sensor/analyzer	1" line / Inline Sensor		Fisher Rosemount		1A
190	AE/AIT-1022	FBR-2 Recycle Water ORP sensor/analyzer	1" line / Inline Sensor		Fisher Rosemount		1A
191	AE/AIT-1011	FBR-1 Influent pH sensor/analyzer	10" line / 1-1/2" insertion		Fisher Rosemount		1A
192	AE/AIT-1012	FBR-2 Influent pH sensor/analyzer	10" line / 1-1/2" insertion		Fisher Rosemount		1A
193	AE/AIT-1023	FBR-3 Recycle Water ORP sensor/analyzer	1" line / Inline Sensor		Fisher Rosemount		1B
194	AE/AIT-1024	FBR-4 Recycle Water ORP sensor/analyzer	1" line / Inline Sensor		Fisher Rosemount		1B
195	AE/AIT-1013	FBR-3 Influent pH sensor/analyzer	10" line / 1-1/2" insertion		Fisher Rosemount		1B
196	AE/AIT-1014	FBR-4 Influent pH sensor/analyzer	10" line / 1-1/2" insertion		Fisher Rosemount		1B
197	AE/AIT-3025	FBR-5 Recycle Water ORP sensor/analyzer	12" line / 1-1/2" insertion		Fisher Rosemount		3A
198	AE/AIT-3026	FBR-6 Recycle Water ORP sensor/analyzer	12" line / 1-1/2" insertion		Fisher Rosemount		3A
199	AE/AIT-3015	FBR-5 Influent pH sensor/analyzer	10" line / 1-1/2" insertion		Fisher Rosemount		3A
200	AE/AIT-3016	FBR-6 Influent pH sensor/analyzer	10" line / 1-1/2" insertion		Fisher Rosemount		3A
201	AE/AIT-3027	FBR-7 Recycle Water ORP sensor/analyzer	12" line / 1-1/2" insertion		Fisher Rosemount		3B
202	AE/AIT-3028	FBR-8 Recycle Water ORP sensor/analyzer	12" line / 1-1/2" insertion		Fisher Rosemount		3B
203	AE/AIT-3017	FBR-7 Influent pH sensor/analyzer	10" line / 1-1/2" insertion		Fisher Rosemount		3B
204	AE/AIT-3018	FBR-8 Influent pH sensor/analyzer	10" line / 1-1/2" insertion		Fisher Rosemount		3B
205	AE/AIT-601	Effluent turbidimeter	8" line / 1/2" flow-thru		Hach / GLI International		6
206	AE-703	LEL Meter			MSA		7B
		TEMPERATURE					
207	TI-401	Blower Discharge Temperature	insertion		Ashcroft		4
208		MISCELLANEOUS					

INSTRUMENT LIST

Customer: Nevada Environmental Response Trust (NERT)
 Location: Henderson, NV
 Project No.: 1373-101
 Date Issued: 04/28/14

Project Mgr: M. DelVecchio
 Project Eng: D. Watt
 Project Eng:
 Revision: 4
 Date Revision Issued: 04/28/14

Items modified or added

ITEM NO.	TAG NO.	DESCRIPTION	SIZE/TYPE	Range	MANUFACTURER	NOTES	P&ID NO.
----------	---------	-------------	-----------	-------	--------------	-------	----------

INSTRUMENT LIST

Customer: Nevada Environmental Response Trust (NERT)
 Location: Henderson, NV
 Project No.: 1373-101
 Date Issued: 04/28/14

Project Mgr: M. DelVecchio
 Project Eng: D. Watt
 Project Eng:
 Revision: 4
 Date Revision Issued: 04/28/14

Items modified or added

ITEM NO.	TAG NO.	DESCRIPTION	SIZE/TYPE	Range	MANUFACTURER	NOTES	P&ID NO.
----------	---------	-------------	-----------	-------	--------------	-------	----------

Items Added With 2006 Modifications

209	AE-1401	pH Sensor w/ Integral Pre-amplifier			Emerson/Rosemount		14
	AE-1440	ORP Sensor			Emerson/Rosemount		14
210	AIT-1401	pH Transmitter			Emerson/Rosemount		14
	AIT-1440	ORP Transmitter			Emerson/Rosemount		14
	FE-1401	10" Orifice Plate			Emerson/Rosemount		14
	FE-1440	6" Orifice Plate			Emerson/Rosemount		14
	FI/FT-1440 FI/FT-1401	Differential Pressure Transmitter w/ Integral Manifold			Emerson/Rosemount		14
	FI-1420 FI-1430	Flow indicator w/ needle valve Range: 10-100 scfh		10-100 scfh	Dwyer		14
	FI-4413 FI-4423	Rotameter w/Needle Valve Flow: 0 to 1 gpm		0 to 1 gpm	Dwyer		14
	PI-1401 PI-1402 PI-1403 PI-1450	Pressure Gauge 0-30 psi Range: 0 to 30 psig		0 to 30 psig	Ashcroft		14
	PI-1426	Pressure Gauge 0-60 psi Range: 0 to 60 psig		0 to 60 psig	Ashcroft		14
	PCV-4430/PI-4430 PCV-1420/PI-1420 PCV-1440/PI-1440	Pressure Regulator, Relieving Adjustment Range: 0-125 psig		0-125 psig	Wilkerson		14
	PS-1401	Pressure Switch, 30psi rating setpoint: 15 psi (falling pressure)			Ashcroft		14
	FI-4103	Flow Meter Range: 2-20 gpm		2-20 gpm	Blue & White		13
	FS-4023	Flow Switch setpoint: 12.9 gpm (actuation) and 8.9 gpm (deactuation)			Dwyer		13
	FS-4073	Flow Switch set point: 21.1 gpm (actuation) and 13.8 gpm (deactuate)			Dwyer		13

INSTRUMENT LIST

Customer: Nevada Environmental Response Trust (NERT)
 Location: Henderson, NV
 Project No.: 1373-101
 Date Issued: 04/28/14

Project Mgr: M. DelVecchio
 Project Eng: D. Watt
 Project Eng:
 Revision: 4
 Date Revision Issued: 04/28/14

Items modified or added

ITEM NO.	TAG NO.	DESCRIPTION	SIZE/TYPE	Range	MANUFACTURER	NOTES	P&ID NO.
	FS-4103	Flow Switch setpoint: 10.8 gpm (actuate) and 9.1 (gpm) deactuate			Dwyer		13
	LE-AP-5	Ultrasonic Transducer			Siemens/Milltronics		13
	LIT- AP-5	Ultrasonic Level Controller			Siemens/Milltronics		13
	PI-1301	Pressure Gauge 0-60 psi Range: 0 to 60 psig		0 to 60 psig	Ashcroft		13
	FI/FT-AP-5	Magnetic Flowmeter(EXISTING)			Emerson/Rosemount		10-A
	FI-1701	Flowmeter with integral metering valve Range: 0-1 scfh		0-1 scfh	Dwyer		17
	FI-1703 FI-1704	Rotameter w/Needle Valve Flow: 0 to 1 gpm		0 to 1 gpm	Dwyer		17
	LIT-1701	Differential Pressure Transmitter Pressure Range: -250 to 250 in H2O calibrated range: 0 to +120 in H2O		0 to +120 in H2C	Emerson/Rosemount		17
	PI-1701	Pressure Gauge 0-60 psi Range: 0 to 60 psig		0 to 60 psig	Ashcroft		17
	FE-622	8" Orifice Plate			Emerson/Rosemount		10-C
	FI/FT-622	Differential Pressure Transmitter w/ Integral Manifold			Emerson/Rosemount		10-C
	AE/AIT-1702	Turbidity Meter w/ Controller Range: 0.001 to 100 NTU		0.001 to 100 NTU	Hach		10-C
	LE-901	Ultrasonic Transducer			Siemens/Milltronics		9
	LIT- 901	Ultrasonic Level Controller			Siemens/Milltronics		9
	FI-1602	Flow indicator w/ needle valve Range: 100-1000 scfh		100-1000 scfh	Dwyer		16
	FI-4027	Rotameter w/Needle Valve Flow: 0-1 gpm		0-1 gpm	Dwyer		16
	PI-1603 PI-1605	Pressure Gauge 0-60 psi Range: 0 to 60 psig		0 to 60 psig	Ashcroft		16
	PT-1603	Level Controller/Transmitter (EXISTING) Range: 0-125 to 0-750 in H2O, calibrated range: 0 to +200 in H2O		0 to +200 in H2C	Emerson/Rosemount		16
	FS-1520A FS-1521 FS-1522 FS-1523 FS-1524	Flow Indicator/Flow Switch Range: 3.0/500 cc/min (0.048 - 8.0 GPH)		0.048 - 8.0 GPH	Cole Parmer		15
	FS/FI-72A	Flow Switch Range 0.006 to 0.05 GPM (72 GPD)		0.006 to 0.05 GPN	Kobold		7-A

INSTRUMENT LIST

Customer: Nevada Environmental Response Trust (NERT)
 Location: Henderson, NV
 Project No.: 1373-101
 Date Issued: 04/28/14

Project Mgr: M. DelVecchio
 Project Eng: D. Watt
 Project Eng:
 Revision: 4
 Date Revision Issued: 04/28/14

Items modified or added

ITEM NO.	TAG NO.	DESCRIPTION	SIZE/TYPE	Range	MANUFACTURER	NOTES	P&ID NO.
	LE-701	Ultrasonic Transducer			Siemens/Milltronics		7-A
	LIT-701	Ultrasonic Level Controller			Siemens/Milltronics		7-A
	LS-701	Leak Sensor			Endress & Hauser		7-A

APPENDIX J

PUMP LUBRICATION CHART

Pump Tag No	Make/Mfg of Pump	Lubrication for Pump	Lubrication Qty	Lube Frequency	Make/Mfg of Motor	Lubricant for Motor	Lube Frequency
P-1021, P-1022, P-1023, P-1024, P-502, P-522	Penn Valley 3" Double Disc Electric Diaphragm Pump	Not Required	N/A	N/A	Baldor ECP3664T	Polyrex EM (Exxon Mobil)	18,000 hrs
P-2011, P-2012, P-3011, P-3012	Penn Valley 2" Double Disc Electric Diaphragm Pump	Not Required	N/A	N/A	Baldor ECP3582T	Polyrex EM (Exxon Mobil)	18,000 hrs
P-603	Penn Valley 3" Double Disc Electric Diaphragm Pump	Not Required	N/A	N/A	Baldor ECP3770T	Polyrex EM (Exxon Mobil)	9,500 hrs
P-731, P-732, P-733, P-734	LMI E-741-37 Electric Diaphragm Metering Pump	Not Required	N/A	N/A	N/A	N/A	N/A
P-735, P-736, P-737, P-738	LMI E-731-27 Electric Diaphragm Metering Pump	Not Required	N/A	N/A	N/A	N/A	N/A
P-739A, P-739B	Viking GG-895-MD-4 Magnetic Drive/Internal Gear Pump	#2 ball bearing grease	N/A	< 500 hrs	Baldor VM7006A	Polyrex EM (Exxon Mobil)	12,000 hrs
P-751, P-903	Fybroc Series 1500 1X1.5X8 Centrifugal Pump	Oil of 300 SSU viscosity at 100 deg F (approx SAE-20)	3/4 pint of oil	Oil change every 6 mos. Regrease bearings every 10,000 hrs	GE 5KS145SAB209	grease (Polyrex EM)	26,000 hrs
P-901, P-902	Warren Rupp S30B2K1KQAS200 Air Diaphragm Pump	SAE 10 non- detergent oil	1 drop/20 scfm	continuous	N/A	N/A	N/A

ITEMS ADDED 2006

Pump Tag No	Make/Mfg of Pump	Lubrication for Pump	Lubrication Qty	Lube Frequency	Make/Mfg of Motor	Lubricant for Motor	Lube Frequency
P-1410	Penn Valley 2" Double Disc Electric Diaphragm Pump	Not Required	N/A	N/A	Baldor ECP3582T	Polyrex EM (Exxon Mobil)	18,000 hrs
P-1401A P-1401B	Fybroc Series 1500 10X8X15, Centrifugal Pump	Oil of 300 SSU viscosity at 100 deg F (approx SAE-20)	6 pints of oil	Oil change every 6 mos. Regrease bearings every 10,000 hrs	GE Ultra, Severe Duty, Premium eff.	GE grease D6A2C23 or any polyurea thickened grease	13,000 hrs
P-1420	Webster S-16, immersible pump	Not Required	N/A	N/A	Baldor	N/A	N/A
P-1520A P-1521, P-1522, P-1523, P-1524	Masterflex peristaltic pumps, 975-3000	Not Required	N/A	N/A	N/A	N/A	N/A
P-1601	Discflo 403-12-2HHD, centrifugal pump	Not Required	N/A	N/A	GE X4D Ultra, Severe Duty, Premium eff.	GE grease D6A2C23 or any polyurea thickened grease	35,000 hrs
P-71A, P-711, P-712, P-713, P-714	Masterflex peristaltic pumps, 975-3000	Not Required	N/A	N/A	N/A	N/A	N/A
P-1701A P-1701B	Fybroc Series 1500 1X1.5X8 Centrifugal Pump	Oil of 300 SSU viscosity at 100 deg F (approx SAE-20)	3/4 pint of oil	Oil change every 6 mos. Regrease bearings every 10,000 hrs	GE Ultra, Severe Duty, Premium eff.	GE grease D6A2C23 or any polyurea thickened grease	35,000 hrs

APPENDIX K SPARE PARTS

Shelf Spares (Pumps / Blower / UV)	Quantity
Media Return Pump	1
DAF Float Pump	1
Sand FBR Ethanol Pump	1
GAC FBR Ethanol Pump	1
Ferric Chloride Pump	1
Press Feed Pump	1
Nutrient Pump	2
Polymer Dosing Pump (DAF)	1
Polymer Dosing Pump (Thickener)	1
Blower	1
Set of Lamps for UV Disinfection Unit	1
Pump Rebuild Kits	Quantity
First Stage Fluidization Pump	1
Second Stage Fluidization Pump	1
DAF Pressure Pump	1
Bed Height Control Pump	1
Thickener Underflow Pump	1
Electron Donor Booster Pump	1
Filtrate Recycle Pump	1
Other Miscellaneous Spares	Quantity
FBR Nozzles	24
GAC Media	10,000 lbs.
16 Point Digital Input Card	1
16 Point Digital Output Card	1
16 Point Analog Input Card	1
16 Point Analog Output Card	1
24 volt PLC Power Supply	1
Profibus Communications Module	1

BIOPLANT EFFLUENT CLARITY AND AP-5 TREATMENT
SPARE PARTS

Shelf Spares (Pumps)	Quantity
pH feed pump with drive	1
Phosphoric acid pump head	1
Sludge pump	1
Polymer transfer pump	1
Polymer feed pump	1
Other Miscellaneous Spares	Quantity
Siemens S7-414-3 CPU with Flash memory	1
Polymer Agitator	1
AP-5 pump suction hose and strainer	1



APPENDIX L FBR VALVE LIST

VALVE POSITION CHART
FBR-1

Valve Tag Number	1st Stage FBR Equalized Feed Valve	P-011 Equalized Feed Valve	P-01A Equalized Feed Valve	FBR-1 Flow Control Valve	FBR-1 Flow Control Valve	Bed Height Control Suction Valve	Bed Height Control Discharge Valve	FBR Unscreened Drain Valve	FBR Screened Drain Valve	Electron Donor Supply Valve	Nubiant Solution Supply Valve	PH Solution Supply Valve							
	V-1020	V-1170	V-1180	V-1011	V-1041	S-011 Drain/Vent Valve	FBR-1 Alternating Pump Suction Valve	P-101A to PBR-1 Valve	S-01A Drain/Vent Valve	FBR-1 Manual Fluidization Flow Control Valve	FBR-1 Flow Control Valve	Bed Height Control Suction Valve	Bed Height Control Discharge Valve	FBR Unscreened Drain Valve	FBR Screened Drain Valve	Electron Donor Supply Valve	Nubiant Solution Supply Valve	PH Solution Supply Valve	
PROCESS OPERATION																			
FBR RUNNING Mode (Feed + Recycle)	O	O	■	O	O	■	■	■	■	adjustable	O	U	U	■	■	■	O	O	O
RECYCLE Mode (Fluidization Only)	■	■	■	O	O	■	■	■	■	adjustable	O	U	U	■	■	■	O	O	O
Lower Bed Height Control	U	U	U	U	U	U	U	U	U	U	U	O	O	■	■	U	U	U	U
Upper Bed Height Control	U	U	U	U	U	U	U	U	U	U	U	O	O	■	■	U	U	U	U
Alternate Fluidization Pumps w/ Feed	O	O	O	■	■	■	O	O	■	adjustable	O	U	U	■	■	O	O	O	O
FBR SHUTDOWN Mode	U	■	■	■	■	■	■	■	■	U	■	U	U	■	■	U	U	U	U

Legend:
 O - Valve Open
 ■ - Valve Closed
 U - Valve not applicable to specified operation. Valve position should not change from last specified position.

Notes:
 1. P-1011 is used for fluidizer during normal FBR RUNNING Mode. Alternate Fluidization Pump P-101A is Off.
 2. Manual Valve requires operator adjustment to set fluidization flow.
 3. Refer to Controls Description for operation of automatic valves.
 4. The offline fluidization pump trainer can be vented, drained and cleaned. After cleaning the drain valve should be closed, and lid secured and made ready for service.

Miscellaneous Valves:
 5. V-1181 closed except when draining the fluid and media for FBR maintenance.
 6. V-1181 closed except when draining the fluid only for FBR maintenance.
 7. All instrument isolation valves will be open except when servicing instruments (sensors, gauges, switches, etc.).
 8. All manual instrument air valves will be open.

VALVE POSITION CHART
FBR-2

Valve Tag Number	V-1090	FCV-1020	P-1012 Equalized Feed Valve	P-1020 Equalized Feed Valve	P-1022 Equalized Feed Valve	P-1024 FBR-2 Fluidization Pump Discharge Valve	S-1012 Drain/Vent Valve	FBR-2 Alternate Fluidization Pump Suction Valve	FBR-2 Alternate Fluidization Pump Discharge Valve	P-102A to FBR-2 Valve	V-108A Drain/Vent Valve	FBR-2 Manual Fluidization Flow Control Valve	FCV-1012 FBR-2 Flow Control Valve	Bed Height Control Suction Valve	V-1172 Bed Height Control Suction Valve	V-1102 Bed Height Control Suction Valve	V-1212 Bed Height Control Discharge Valve	FBR Unscreamed Drain Valve	V-1152 FBR Unscreamed Drain Valve	Electron Doser Supply Valve	V-1082 Electron Doser Supply Valve	Nutrient Solution Supply Valve	V-1082 Nutrient Solution Supply Valve	FH Solution Supply Valve	V-1120 FH Solution Supply Valve
PROCESS OPERATION																									
FBR RUNNING Mode (Feed + Recycle)	O	O	■	■	■	■	■	■	■	■	■	adjustably	O	U	U	U	U	■	■	■	■	■	■	■	■
RECYCLE Mode (Fluidization Only)	U	U	U	U	U	U	U	U	U	U	U	adjustably	O	U	U	U	U	■	■	■	■	■	■	■	
Lower Bed Height Control	U	U	U	U	U	U	U	U	U	U	U	U	U	■	■	■	■	■	■	■	■	■	■	■	
Upper Bed Height Control	O	O	■	■	■	■	■	■	■	■	■	adjustably	O	U	U	U	U	■	■	■	■	■	■	■	
Alternate Fluidization Pump w/ Feed	U	■	■	■	■	■	■	■	■	■	■	U	■	U	U	U	U	■	■	■	■	■	■	■	
FBR SHUTDOWN Mode																									

Legend:

- O - Valve Open
- - Valve Closed

U - Valve not applicable to specified operation. Valve position should not change from last specified position.

Notes:

1. P-1012 is used for fluidization during normal FBR RUNNING Mode. Alternate Fluidization Pump P-101A is OFF.
2. Manual Valve requires operator adjustment to set fluidization flow.
3. Refer to Controls Description for operation of alternate valves.
4. The offline fluidization pump strainer can be vented, drained and cleaned. After cleaning the drain valve should be closed, and lid secured and made ready for service.

Miscellaneous Valves:

5. V-1102 to remain closed except when draining the fluid and media for FBR maintenance.
6. V-1102 to remain closed except when draining the fluid only for FBR maintenance.
7. All instrument isolation valves will be open except when servicing instruments (sensors, gauges, switches, etc.).
8. All manual instrument air valves will be open.

VALVE POSITION CHART SEPARATOR T-2011 AND MEDIA RETURN

Valve Tag Number:	Separator Level Control Valve ³	Separator Tank Suction Valve	Separator Tank Flow Valve	Service Water Isolation Valve	Service Water Flow Valve	Media Return Backflush Valve	Media Return Clean out Valve	Separator Tank Drain Valve	FBR-2 Media Return Valve	FBR-1 Media Return Valve
LCV-2011		V-2031	FV-2011	V-2041	FV-2021	FV-2031	V-2011	V-2021	V-2061	V-2071
PROCESS OPERATION										
Normal ¹ Separator Operation	O	O	■	C	■	■	■	■	U	U
Separator Media Return Cycle	O	O	O	C	■	O	■	■	adjustable ²	adjustable ²
Service Water Backflush	O	O	O	C	O	■	■	■	U	U

Legend:

- O - Valve Open
- - Valve Closed
- U - Valve not applicable to specified operation, Valve position should not change from last specified position

Notes:

1. During Normal Separator Operation the effluent/recycle stream enters the separator allowing media entrained in the stream to settle. Water is recycled to FBRs 1 & 2 and sent to the 2nd stage FBRs(5, 6, 7, & 8) depending on the level in the separator tank.
2. Manual Valve requires operator adjustment to set media return location based on bed height measurement and the FBR media replenishment requirements.
3. Refer to Controls Description for operation of automatic valves.
4. All 1/2" and 3/8" ball valves on instrument air supply lines are open during normal operation except for V-2171 which is at the end of a line.

**VALVE POSITION CHART
SEPARATOR T-2012 AND MEDIA RETURN**

Valve Tag Number:	Separator Level Control Valve ³	Separator Tank Suction Valve	Separator Tank Flow Valve	Service Water Isolation Valve	Service Water Flow Valve	Media Return Backflush Valve	Media Return Clean out Valve	Separator Tank Drain Valve	FBR-4 Media Return Valve	FBR-3 Media Return Valve
	LCV-2012	V-2032	FV-2012	V-2042	FV-2022	FV-2032	V-2012	V-2022	V-2072	V-2062
PROCESS OPERATION										
Normal ¹ Separator Operation	O	O	■	O	■	■	■	■	U	U
Separator Media Return Cycle	O	O	O	O	■	O	■	■	adjustable ²	adjustable ²
Service Water Backflush	O	O	O	O	O	■	■	■	U	U

Legend:

- O - Valve Open
- - Valve Closed
- U - Valve not applicable to specified operation, Valve position should not change from last specified position

Notes:

1. During Normal Separator Operation the effluent/recycle stream enters the separator allowing media entrained in the stream to settle. Water is recycled to FBRs 3 & 4 and sent to the 2nd stage FBRs(5,6, 7, & 8) depending on the level in the separator tank.
2. Manual Valve requires operator adjustment to set media return location based on bed height measurement and the FBR media replenishment requirements.
3. Refer to Controls Description for operation of automatic valves.
4. All 1/2" and 3/8" ball valves on instrument air supply lines are open during normal operation except for V-2172 which is at the end of a line.
5. Separator Tank Drain Valve will be used during media wash to remove fines from the system and for maintenance on the separator.

**VALVE POSITION CHART
SEPARATOR T-3011 AND MEDIA RETURN**

	Separator Level Control Valve ³	Separator Tank Suction Valve	Separator Tank Flow Valve	Service Water Isolation Valve	Service Water Flow Valve	Media Return Backflush Valve	Media Return Clean out Valve	Separator Tank Drain Valve	FBR-5 Media Return Valve	FBR-6 Media Return Valve
Valve Tag Number:	LC/3011	V-3631	FV-3011	V-3641	FV-3021	FV-3031	V-3611	V-3621	V-3661	V-3671
PROCESS OPERATION										
Normal ¹ Separator Operation	O	O	■	O	■	■	■	■	U	U
Separator Media Return Cycle	O	O	O	O	■	O	■	■	adjustable ²	adjustable ¹
Service Water Backflush	O	O	O	O	O	■	■	■	U	U

Legend:

- O - Valve Open
- - Valve Closed
- U - Valve not applicable to specified operation, Valve position should not change from last specified position

Notes:

1. During Normal Separator Operation the effluent/recycle stream enters the separator allowing media entrained in the stream to settle. Water is recycled to FBRs 5 & 6 and sent as effluent to the aeration tank depending on the level in the separator tank.
2. Manual Valve requires operator adjustment to set media return location based on bed height measurement and the FBR media replenishment requirements.
3. Refer to Controls Description for operation of automatic valves.
4. All 1/2" and 3/8" ball valves on instrument air supply lines are open during normal operation except for V-3771 which is at the end of a line.
5. Separator Tank Drain Valve will be used during media wash to remove fines from the system and for maintenance on the separator.

**VALVE POSITION CHART
SEPARATOR T-3012 AND MEDIA RETURN**

Valve Tag Number:	Separator Level/Control Valve ³	Separator Tank Suction Valve	Separator Tank Flow Valve	Service Water Isolation Valve	Service Water Flow Valve	Media Return Backflush Valve	Media Return Clean out Valve	Separator Tank Drain Valve	FBR-7 Media Return Valve	FBR-8 Media Return Valve
	LCV-3012	V-3632	FV-3012	V-3642	FV-3022	FV-3032	V-3612	V-3621	V-3662	V-3672
PROCESS OPERATION										
Normal ¹ Separator Operation	O	O	■	O	■	■	■	■	U	U
Separator Media Return Cycle	O	O	O	O	■	O	■	■	adjustable ²	adjustable ²
Service Water Backflush	O	O	O	O	O	■	■	■	U	U

Legend:

- O - Valve Open
- - Valve Closed
- U - Valve not applicable to specified operation, Valve position should not change from last specified position

Notes:

1. During Normal Separator Operation the effluent/recycle stream enters the separator allowing media entrained in the stream to settle. Water is recycled to FBRs 7 & 8 and sent as effluent to the aeration tank depending on the level in the separator tank.
2. Manual Valve requires operator adjustment to set media return location based on bed height measurement and the FBR media replenishment requirements.
3. Refer to Controls Description for operation of automatic valves.
4. All 1/2" and 3/8" ball valves on instrument air supply lines are open during normal operation except for V-3772 which is at the end of a line.
5. Separator Tank Drain Valve will be used during media wash to remove fines from the system and for maintenance on the separator.



APPENDIX M

FBR LOADING EQUATION

FBR Loading Equation

Stream	FLOW ¹ gpm	Perchlorate ² ; ClO ₄ ⁻ mg/l	Chlorate ² ; ClO ₃ ⁻ mg/l	Nitrate (as N) ² ; NO ₃ ⁻ -N mg/l	Check Effluent Composition from GWTP (Not Used in Spreadsheet)
Athen's Road (LS#3) - A	250	360	629	40	
Seep/Wash Area (LS#1) - B	690	17	25	6.2	
Interceptor Wells Feed to GWTP (Chrome System)	58				
GW-11 (Pond) Flow to GWTP	12	1,537	3,651	55	
Total Flow from GWTP to FBRs	60				
Portion of Interceptor Wells Flow to FBRs - C	49.7	1,400	3,200	42	
Portion of GW-11 Flow to FBRs - D	10.3	2,200	7,000	120	
Total Flow to FBRs (A+E+C+D)	1,000	194	403	17.6	

$$\text{Loading Equation (lbs/day)} = (0.9 \cdot \text{NO}_3\text{-N} + 0.17 \cdot \text{ClO}_4\text{-} + 0.18 \cdot \text{ClO}_3\text{-}) \cdot \text{FLOW} \cdot 1,440 \cdot 8.34 / 10^6$$

Limits	Calculated	Within Limits?	Operating Load % of Full
Loading (lbs/day) = 1,514	1,438	Yes	95%
NO ₃ -N (mg/l) = 50	18	Yes	
ClO ₃ ⁻ (mg/l) = 500	406	Yes	
ClO ₄ ⁻ (mg/l) = 400	194	Yes	

- Flow values input by operator.
- Source feed stream concentrations are password protected. Input by authorized personnel only! To password protect this spreadsheet, go to "Tools/Protection/Protect Sheet" and input a password. Then click "O.K.".
- The above spreadsheet is an example calculation for a specific process condition. The operator should use the electronic model contained in the SCADA and input the actual values. The model will calculate the loading to the plant and the required "K" values.

APPENDIX N

FBR SYSTEM STARTUP

FBR SYSTEM INITIAL STARTUP PROCEDURES

The startup procedures were developed for activation of the newsystem. These procedures will only be required if the sand or gac media must be removed from the system or there is a complete loss of biomass. Normal startup and shutdown procedures, i.e. startup after loss of power, are presented in Chapter 14.

General Startup

Review individual component manufacturer's documentation for additional specifications. Some general guidelines are listed below and should be performed prior to media addition:

1. Stroke all valves prior to flooding system to verify operation.
2. Lubricate and oil all rotating components per manufacturers' recommendations.
3. Energize system. Close disconnect switches. Verify 3-phase motor rotation by momentarily "bumping" the motors.
4. Verify instrument calibrations.
5. Confirm communication and correct operation with control system.
6. Refer to overall system startup procedures for the order in which all equipment should be started.
7. Fill reactor vessel and piping with clean water. Bleed all air pockets from system.
8. Check for leaks and tighten loose connections.

Conditioning Sand for Startup

In order to minimize startup time, it is imperative that the sand in FBRs 1 – 4 be “conditioned” for microbial attachment and growth prior to loading the inoculum into the FBRs or prior to introducing feed water to the system. Sand is a smooth surface. Experience has shown that startup times using unconditioned sand are 50 to 150 percent longer than when conditioned sand is used. Conditioned sand for microbial attachment cannot be obtained by simply scratching/abrading the sand or soaking the sand in a chemical (i.e., acid) for a short period of time.

A portion of the sand used in FBRs 1 – 4 (5 to 10 percent) will already be fully conditioned, as it will be obtained from an operating denitrifying FBR system in Sparks, NV. Load this sand into FBRs 1 – 4 according to Section 2.1.4.

The remaining 90 to 95 percent of virgin sand will be conditioned along with the fully conditioned sand noted above for approximately two weeks prior to introducing contaminated feed water to the system. Load the virgin sand into FBRs 1 – 4 according to Sections 2.1.4 and 2.1.6. Operate FBRs 1 – 4 and the two sand separators in recycle mode. Inoculate FBRs 1 – 4 according to Section 2.1.7. Feed batches of nitric acid, ethanol and phosphoric acid to the FBRs to promote growth of denitrifying films on the sand. The batch addition of chemicals to EACH sand FBR should include 10 gallons of nitric acid (HNO₃), 10 gallons of ethanol, and 0.3 gallons of 85% phosphoric acid. The water source will be stabilized lake water. At the start of each batch run, the pH of the water in the FBRs should be adjusted to 6.2 to 6.5 using 20% caustic soda. The nitrate reduction process will increase the alkalinity of the water. The pH may need to be manually adjusted to maintain the pH no higher than 7.5, or precipitation of hardness may occur. It is preferable to operate as close to pH 7.5 as possible to encourage formation of “sticky/filamentous” films. **Provisions may be needed to periodically remove denitrified water from the FBRs and replace the water with stabilized lake water to control temperature (due to sustained operation in recycle mode).** This water will need to be stored (i.e., in either the Aeration Tank or DAFs) until the UV system is operational and has been accepted by the client. Water that contains microorganisms must be passed through the UV system prior to discharge. **Also, the provision must be made to allow temporary control of the sand FBRs at a fluid bed height of approximately 2 feet above the level of hydraulic fluidization (i.e., 18.5 feet for an initial settled bed height of 13 feet and an initial expanded bed height of**

16.5 feet). Monitor the concentrations of nitrate-N and soluble TOC in the water during each batch run. When the nitrate-N drops below 5 mg/L from an approximate starting concentration of 100 mg/L per batch, add an additional batch of chemicals. Once the contents of two 55-gallon drums of nitric acid have been added to EACH FBR, operate the FBRs in recycle without further chemical addition.

The following items are assumed to be in place prior to sand conditioning:

1. FBRs 1 – 4 and the two sand separators are fully assembled and full of stabilized lake water.
2. The sand FBRs and sand separators have been fully tested mechanically and have been accepted by the client for startup.

Since the PLC may not be functioning during the sand conditioning period, the temperature alarms will not be available. Therefore, the operators will need to monitor the temperature gauges directly on the FBRs in order to track temperature.

Sand Media Loading (FBRs 1 – 4)

The sand FBRs will be loaded via pneumatic transfer from trucks. Care must be taken to minimize/avoid spillage of sand into the reactor collection systems. Follow the steps below for adding sand to the individual FBRs:

1. Empty the water (assumed to be stabilized lake water from hydro-testing) within the FBRs to the pad sumps; however, see Item #4 below to determine how much water should be emptied.
2. Temporarily cover the top of the collection and effluent system openings and the perforation in the collection header pipes.
3. Isolate all tank valves to the FBRs.
4. The FBRs should be one-third or one-half filled with stabilized lake water.
5. Set up a temporary hose to unload sand from the trucks. This hose should go from ground level, over the top of each reactor and extend just below the collector system. NOTE: When loading the pre-conditioned sand from Sparks, NV, special trucks and/or sand removal techniques may be required, as the sand may form a hard mass in the trucks during transport.

6. One by one empty the trucks of sand into each reactor. As sand is added, fluid levels within each reactor should increase. Add additional water as needed to ensure the sand is covered.
7. Approximately 2,000 cubic feet of sand should be loaded into each FBR to the settled bed height of 13'-0". This is approximately (5) 40,000-pound truckloads of dry sand. Care must be taken to load or distribute the sand evenly across each FBR, or uneven fluidization may occur when the fluidization pumps are turned on (i.e., only the shortest portion of the uneven bed will fluidize). It may be necessary to "bump" the fluidization pumps periodically to re-distribute the sand in each FBR.
8. As the sand is being loaded, the settled bed height in each FBR should be monitored by dropping a weighted probe down through the liquid at the top of each reactor until the probe reaches the top of the settled bed.
9. Remove temporary covers and plugs from the collection boxes and pipes.

Repeat Items 1 – 9 above with remaining first stage FBRs until all four (4) are complete.

Carbon Media Loading (FBRs 5 – 8)

The following items are assumed to be in place prior to loading FBRs 5 – 8 with carbon media:

1. FBRs 5 – 8 and the two carbon separators are fully assembled and full of stabilized lake water.
2. The GAC FBRs and carbon separators have been fully tested mechanically and have been accepted by the client for startup.

The GAC FBRs will be loaded from super sacks. Care must be taken to minimize/avoid spillage of GAC into the reactor collection systems. Follow the steps below for adding GAC to the individual FBRs:

1. Empty the water (assumed to be stabilized lake water from hydro-testing) within the FBRs to the pad sumps; however, see Item #4 below to determine how much water should be emptied.

2. Temporarily cover the top of the collection and effluent system openings and the perforation in the collection header pipes.
3. Isolate all tank valves to the FBRs.
4. The FBRs should be one-third or one-half filled with stabilized lake water.
5. One by one, hoist the super sacks above the top of each vessel and open the bags. Slowly add the carbon to each reactor. As carbon is added, fluid levels within each reactor should increase. Add additional water as needed to ensure the GAC is covered. The GAC will require 24 hours to completely saturate and settle.
6. Approximately 1,730 cubic feet of carbon should be loaded into each FBR to the settled bed height of 11'-3". This is approximately forty-seven (47) 500-kilogram super sacks of carbon. Initially, load only 46 super sacks (50,700 pounds) into each reactor. If necessary, additional carbon can be loaded later. Care must be taken to load or distribute the GAC evenly across each FBR, or uneven fluidization may occur when the fluidization pumps are turned on (i.e., only the shortest portion of the uneven bed will fluidize). It may be necessary to "bump" the fluidization pumps periodically to re-distribute the GAC in each FBR.
7. As the carbon is being loaded, the settled bed height in each FBR should be monitored by dropping a weighted probe down through the liquid at the top of each reactor until the probe reaches the top of the settled bed.
8. Remove temporary covers and plugs from the collection boxes and pipes.

Repeat Items 1 – 8 above with remaining second stage FBRs until all four (4) are complete.

Wash Media and Establish Fluidization Loading for each FBR

It is important to wash out the media fines prior to putting the FBR systems into operation. Fill each fluid bed reactor with stabilized lake water up to the effluent collection pipe. Place a hose in each reactor and continue to add water, allowing the water to overflow the reactor from the effluent pipe. Establish media fluidization to each FBR 1 through 8 sequentially in recycle operating mode. Open the valves around the fluidization pump P-1011. Make sure that FBR-1 is filled with water up to the effluent recycle nozzle; otherwise, loss of FBR fluidization pump prime and pump damage may result. Start the fluidization pump. Set the initial fluidization flow at 800 gpm and increase the fluidization flow in increments of 200 gpm up to approximately 2,000 gpm. The fluidization recycle will cause water to discharge from the reactor to the separator tank where media fines will be removed. These media fines will be collected in the separator tank. Monitor the recycle for fines. Continue washing out fines until a clear visual line of sight can be made through a 6" deep sample. Once the effluent is clear, remove the fines from the separator by letting them settle into the cone and discharging them to the pad sump. Add water to the separator to refill discharged water.

Repeat the procedure above for FBRs 2 – 8.

After the fines are removed, allow the beds to settle for at least 1 hour and record the settled bed heights using weighted probes. For the first stage sand FBRs, the settled bed height should be 13'-1" \pm 2". For the second stage GAC FBRs, the settled bed height should be 11'-3" \pm 2". Adjust bed height by adding or removing media as necessary. When adding media, pre-wetted media should be used. Add media as described in Section 2.2.4.

Establish the fluidization loading on each FBR bed. Start the fluidization pumps at a recycle flow of 2,000 gpm. Next, monitor bed heights. Record the bed heights, FBR fluidization flows, and water temperatures. Establish the "**normal system fluidization flow**" for each FBR. This is the fluidization flow that results in a clean expanded bed height of 16'-7" to 17'-0" for the first stage FBRs and 14'-2" to 14'-8" for the second stage FBRs (or 1.28 times the clean settled bed heights) when operating at the normal treatment temperature. Increased water temperature requires a higher flow to achieve a given level of media fluidization. The FBR fluidization flow rates should always be maintained at the established "**normal**

system fluidization flows.” It is recommended that a mark be placed to indicate the fluidization flow control valve position necessary to achieve this rate for each FBR.

Once the beds are fluidized, the pH of the GAC reactors will likely be greater than 9.0, and will therefore require adjustment. Obtain a media sample and water sample from each GAC FBR vessel and perform titration experiments to determine the required equivalents of sulfuric acid needed to adjust the pH to 7.5 (i.e., the approximate pH of the IX system feed water). Use a total GAC volume of 1,730 cubic feet of GAC (settled) per reactor and a total liquid volume of 75,000 gallons per FBR/separator combination (i.e., FBRs-5&6 and separator T-3011; FBRs-7&8 and separator T-3012). Add 93% sulfuric acid through the nutrient pumps P-725 and P-726 for FBRs-5&6 and nutrient pumps P-727 and P-728 for FBRs-7&8 until the required amount of acid has been added. Break the 3/8” plastic feed lines prior to the pumps and insert the lines into a 55-gallon drum of the acid. After adding the acid, insert the feed lines into water to flush the lines of acid for at least 6 hours prior to reinstalling the lines. Monitor the pH and run the FBRs in recycle for at least one hour to thoroughly mix the acid.

Process Feed Startup Plan

The following items are assumed in place prior to initiating startup:

- a. All separators (first & second stage), the aeration vessel, both DAFs, and the effluent tank with all associated piping are assembled and full of stabilized lake water.
- b. All FBRs (first & second stage) are full of media and stabilized lake water.
- c. The flow through system, including the UV system, has been fully tested mechanically and has been accepted by the client for startup.

General Information

NOTE: It is assumed that the ethanol addition, pH control, and nutrient addition systems are set up, primed, and functioning properly.

During this time, microbial growth should be monitored via feed and effluent groundwater quality testing, substrate utilization, and field analytical testing. Adjustments should be made to the initial settings of the biomass separation devices

as needed. Monitor the FBRs as per Table 4-1 and add ethanol and nutrient to the vessels as per our guide in Appendix C.

Inoculation

To expedite start-up, the sand FBRs will be inoculated twice -- once to condition the sand, and then again with the same perchlorate-reducing culture to provide additional microorganisms just prior to startup. The inoculation procedure is the same in both cases, except that prior to introducing the microbial seed to the FBRs the second time, the stabilized lake water in the FBRs should be replaced with contaminated water (i.e., the current feed to the IX system).

To replace the stabilized lake water with IX feed water (TO BE DONE PRIOR TO START_UP ONLY; NOT TO BE DONE PRIOR TO SAND PREPARATION), perform the following:

1. With FBRs 1 – 4 fluidization pumps running, the FBRs will recycle in place. Set the valves so that the effluents from the sand separators T-2011 and T-2012 bypass the GAC FBRs 5 – 8 and go directly to the DAFs.
2. Transfer the water (assumed to be stabilized lake water from hydro-testing) in the DAFs and effluent tank to the thickener, solids conditioning tank, and filtrate tank (to be used for the solids system checkout). After those solids vessels are full, the remaining water (if any) should be dumped to the pad sumps if this water contains no microorganisms. If the water contains microorganisms (i.e., because water from the conditioning step had to be transferred to control temperature), then the water must be discharged through the UV system.
3. With all the FBRs running in recycle (fluidization pumps running), open the valves for the system feed from the current IX system. Set the system to run at 1,000 gpm.
4. The chemical feed systems should also be running and adding chemicals to the feed water.
5. The recommended initial dosage of nutrients is 2 gallons of the 39% urea/diammonium phosphate mix (from Nutrient Tank T-702) PER SAND FBR; the recommended initial dosage of ethanol is 10 gallons (from Ethanol

Substrate Tank T-703) PER SAND FBR. The recommended initial dosage of the trace elements mixture is 0.1 to 0.5 gallons.

6. Run the system with feed until the DAFs and effluent tank are full. Shut down system feed and set valves to run FBRs 1 – 4 in recycle when DAFs and effluent tank are full (i.e., the only equipment in operation is FBRs 1 – 4 and sand separators T-2011 and T-2012).

Perform the following steps to properly seed the sand FBR vessels.

1. Shut off the system feed. The system should be operating in recycle mode.
2. Pump the seed (microorganisms and nutrients) into the top of the separator vessels. The recommended microbial seed is 6,000 gallons of concentrated biological solids from the Aerojet FBR system for each FBR/separator combination (i.e., FBRs-1&2 and separator T-2011; FBRs-3&4 and separator T-2012). The biological solids will need to be screened (1/4" or less recommended) prior to adding the material to the separator. It is easier to screen the sludge as it is being withdrawn from its source into the trucks rather than screen it as it is being added to the FBRs.
3. Allow the system to run in the recycle mode according to Section 2.1.3 if preparing the sand or Section 2.1.7.3 (Phase 1) if initiating startup. This will give the microbes a chance to adhere to the media.

Phase 1

With FBRs 1 – 4 fluidization pumps running, the FBRs will recycle in place. Monitor the FBRs as per Table 4-1 and add ethanol and nutrients as per our guide in Appendix C. It is likely that no additional nutrients or ethanol will be required above those added during inoculation. During this phase, the only equipment in operation is FBRs 1 – 4 and sand separators T-2011 and T-2012.

Continue monitoring for one week. When the nitrate and chlorate are fully degraded, and the perchlorate is almost fully degraded, proceed to Phase 2. This is expected to occur within one week.

Phase 2

Prior to beginning Phase 2, the loading and washing of carbon media in the second stage FBRs 5 – 8 must be complete (see Sections 2.1.5 and 2.1.6).

Set the valves so that the water effluents from the sand separators T-2011 and T-2012 pass through FBRs 5 – 8. Set up the bypass from the effluent pumps to discharge water to the outfall (through the UV system) if 99 percent destruction of perchlorate occurred during Phase 1; otherwise, set up the bypass to send water to GW-11 (i.e., “the pond”).

With all the FBRs 1 – 8 running in recycle (fluidization pumps running), open the valves for the system feed from the temporary IX system and prepare to add water from GW-11 (i.e., “pond water”). Set the system to run at 940 gpm of temporary IX water feed and 60 gpm of pond water. With the system running in recycle at 1,000 gpm, open the valves to the bypass to allow water to be discharged to either the outfall or the pond (see paragraph above). Turn on the chemical feed systems (nutrient, trace elements, and ethanol). Open the valves for the system feed from the temporary IX system and start the GW-11 pump. Feed the system approximately 375,000 gallons of IX water and 25,000 gallons of pond water over approximately 7 hours. The chemical feed systems should also be running and adding chemicals to the feed water according to the guide in Appendix C. **DO NOT OPERATE THE AERATION TANK OR DAFs.**

After approximately 400,000 gallons have flowed through the complete system, shut down the system feed and set the valves to run all eight FBRs such that the water in the effluent tank is recycled back to the feed to the sand FBRs 1 – 4 (i.e., system recycle). Also shut down the nutrient, trace element, and ethanol chemical feeds (continue to operate the pH control chemical feeds).

Continue to run the system in recycle at 1,000 gpm.

Monitor the FBRs as per Table 4-1 and add ethanol and nutrients manually as needed to maintain residual ammonia-N, phosphate-P and ethanol (as measured by soluble TOC) as per Table 4-1. It is estimated, based on previous analyses of IX and pond water water parameters, that a total of 200 gallons of ethanol and 40 gallons of the 39% urea/di-ammonium phosphate mix will be required to reduce all the oxygen, nitrate, chlorate and perchlorate present in the water within the complete system during Phase 2. A small amount of the trace elements mixture may need to be manually added if perchlorate removal stalls.

Continue monitoring for one week. When the nitrate and chlorate are fully degraded in the first stage sand FBRs and the perchlorate concentration is less than 500 ug/L

in the effluent from the GAC FBRs, continue to Phase 3. This is expected to occur within one week.

Phase 3

Prior to beginning Phase 3, set up the bypass from the effluent pumps to discharge water to the outfall (through the UV system) if 99 percent destruction of perchlorate occurred during Phase 2; otherwise, set up the bypass to send water to the pond. **DO NOT OPERATE THE AERATION TANK OR DAFs.**

With the system running in recycle, open the valves for the system feed from the temporary IX system and prepare to add water from GW-11 (i.e., “pond water”). Set the system to run at 940 gpm of temporary IX water feed and 60 gpm of pond water. With the system running in recycle at 1,000 gpm, open the valves to the bypass to allow water to be discharged to either the outfall or the pond (see paragraph above). Turn on the chemical feed systems (nutrient, trace element, and ethanol pumps). Open the valves for the system feed from the temporary IX system and start the GW-11 pump. Feed the system approximately 375,000 gallons of IX water and 25,000 gallons of pond water over approximately 7 hours. The chemical feed systems should also be running and adding chemicals to the feed water according to the guide in Appendix C.

Shut down the bypass to the pond discharge line and the system feed. Set the valves to run the system in recycle (i.e., system recycle). Run in system recycle at 1,000 gpm. Also shut down the nutrient, trace element, and ethanol chemical feeds (continue to operate the pH control chemical feeds).

Monitor the FBRs as per Table 4-1 and add ethanol and nutrients manually as needed to maintain residual ammonia-N, phosphate-P and ethanol (as measured by soluble TOC) as per Table 4-1. A small amount of the trace elements mixture may also need to be manually added if performance stalls. When the nitrate and chlorate are fully degraded in the first stage sand FBRs and the perchlorate concentration is less than 100 ug/L in the effluent from the GAC FBRs, continue to Phase 4. This is expected to occur within 6 days.

Phase 4

Prior to beginning Phase 4, if the water cannot be sent to the outfall (i.e., 99 percent destruction of perchlorate during Phase 3), set up the bypass from the effluent

pumps to the sump discharge line to send water to the pond. DO NOT OPERATE THE AERATION TANK OR DAFs.

With the system running in recycle, open the valves for the system feed from the temporary IX system and prepare to add water from GW-11 (i.e., “pond water”). Set the system to run at 940 gpm of temporary IX water feed and 60 gpm of pond water. With the system running in recycle at 1,000 gpm, open the valves to the bypass to allow water to go to either the outfall or the pond (see paragraph above).. Turn on the chemical feed systems (nutrient, trace element, and ethanol pumps). Open the valves for the system feed from the temporary IX system and start the GW-11 pump. Feed the system approximately 375,000 gallons of IX water and 25,000 gallons of pond water over approximately 7 hours. The chemical feed systems should also be running and adding chemicals to the feed water according to the guide in Appendix C.

Shut down the bypass to the pond discharge line (if using) and the system feed. Set the valves to run the system in recycle (i.e., system recycle). Run in system recycle at 1,000 gpm. Also shut down the nutrient, trace element, and ethanol chemical feeds (continue to operate the pH control chemical feeds).

Monitor the FBRs as per Table 4-1 and add ethanol and nutrients manually as needed to maintain residual ammonia-N, phosphate-P and ethanol (as measured by soluble TOC) as per Table 4-1. A small amount of the trace elements mixture may also need to be manually added if performance stalls. After 3 days, the nitrate and chlorate are expected to be fully degraded in the first stage sand FBRs and the perchlorate is expected to be less than 50 ug/L in the effluent from the GAC FBRs.

Phase 5

It is anticipated that prior to beginning Phase 5, levels of perchlorate in the effluent water from the GAC FBRs will be low enough to discharge the water to the outfall on a continuous basis. At this time, the aeration tank and DAFs will be put into service. Therefore, the mechanical checkout of the solids Treatment System must be completed and the solids Treatment System must be accepted by the client for startup.

Reduce the recycle flow from 1,000 gpm to 200 gpm. With the system running in recycle at 200 gpm, open the valves to the discharge to allow water to go to the

outfall. Turn on the chemical feed systems (nutrient, trace element, and ethanol pumps). Open the valves for the system feed from the temporary IX system. Feed the system at 200 gpm. The chemical feed systems should also be running and adding chemicals to the feed water according to the guide in Appendix C.

Monitor the FBRs as per Table 4-1 for 7 days and adjust ethanol and nutrient dosages as needed to maintain residual ammonia-N, phosphate-P and ethanol (as measured by soluble TOC) as per Table 4-1. Increase the dosage of trace elements as needed if performance stalls. The nitrate and chlorate are expected to be fully degraded in the first stage sand FBRs and the perchlorate is expected to be less than 2 mg/L in the effluent from the GAC FBRs. Flow may be increased daily to the system by no more than 10 percent provided less than 2 mg/L of perchlorate is being maintained at the discharge from the FBR system (i.e., overall 99% destruction of perchlorate in the discharge from the combined FBR system and temporary IX system).

Phase 6

With the system running in flow-through mode and meeting less than 2 mg/L of perchlorate on the discharge, increase the flow to 400 gpm.

Monitor the FBRs as per Table 4-1 for 7 days and adjust ethanol and nutrient dosages as needed to maintain residual ammonia-N, phosphate-P and ethanol (as measured by soluble TOC) as per Table 4-1. Increase the dosage of trace elements as needed if performance stalls. The nitrate and chlorate are expected to be fully degraded in the first stage sand FBRs and the perchlorate is expected to be less than 1 mg/L in the effluent from the GAC FBRs. Flow may be increased daily to the system by no more than 10 percent provided less than 1 mg/L of perchlorate is being maintained at the discharge from the FBR system (i.e., overall 99% destruction of perchlorate in the discharge from the combined FBR system and temporary IX system).

Phase 7

With the system running in flow-through mode and meeting less than 1 mg/L of perchlorate on the discharge, increase the flow to 700 gpm.

Monitor the FBRs as per Table 4-1 for 7 days and adjust ethanol and nutrient dosages as needed to maintain residual ammonia-N, phosphate-P and ethanol (as

measured by soluble TOC) as per Table 4-1. Increase the dosage of trace elements as needed if performance stalls. The nitrate and chlorate are expected to be fully degraded in the first stage sand FBRs and the perchlorate is expected to be less than 1 mg/L in the effluent from the GAC FBRs. Flow may be increased daily to the system by no more than 10 percent provided less than 1 mg/L of perchlorate is being maintained at the discharge from the FBR system (i.e., overall 99% destruction of perchlorate in the discharge from the combined FBR system and temporary IX system).

Phase 8

With the system running in flow-through mode and meeting less 1 mg/L of perchlorate on the discharge, increase the flow to 1,000 gpm. This should result in all the flow through the temporary IX system now being processed through the FBRs.

Monitor the FBRs as per Table 4-1 for 7 days and adjust ethanol and nutrient dosages as needed to maintain residual ammonia-N, phosphate-P and ethanol (as measured by soluble TOC) as per Table 4-1. Increase the dosage of trace elements as needed if performance stalls. The nitrate and chlorate are expected to be fully degraded in the first stage sand FBRs and the perchlorate is expected to be less than 50 ug/L in the effluent from the GAC FBRs.

Phase 9

With the system running in flow-through mode at 1,000 gpm, add up to 10 gpm of GW-11 water (i.e., "Pond water") to the feed water to increase the nitrate-N, chlorate, and perchlorate load to the system. Reduce the flow of pond water if the combined load of nitrate-N, chlorate, and perchlorate exceeds the design load, or if the maximum design concentration of any water quality parameter is exceeded. (

Monitor the FBRs as per Table 4-1 for 7 days and adjust ethanol and nutrient dosages as needed to maintain residual ammonia-N, phosphate-P and ethanol (as measured by soluble TOC) as per Table 4-1. Adjust the dosage of trace elements as needed. The nitrate and chlorate are expected to be fully degraded in the first stage sand FBRs and the perchlorate is expected to be less than 20 ug/L in the effluent from the GAC FBRs.

Phase 10

With the system running in flow-through mode at 1,000 gpm, add up to 30 gpm of GW-11 water (i.e., “Pond water”) to the feed water to increase the nitrate-N, chlorate, and perchlorate load to the system. Reduce the flow of pond water if the combined load of nitrate-N, chlorate, and perchlorate exceeds the design load, or if the maximum design concentration of any water quality parameter is exceeded.

Monitor the FBRs as per Table 4-1 for 7 days and adjust ethanol and nutrient dosages as needed to maintain residual ammonia-N, phosphate-P and ethanol (as measured by soluble TOC) as per Table 4-1. Adjust the dosage of trace elements as needed. The nitrate and chlorate are expected to be fully degraded in the first stage sand FBRs and the perchlorate is expected to be less than 4 ug/L in the effluent from the GAC FBRs.

Phase 11

With the system running in flow-through mode at 1,000 gpm, add up to 60 gpm of GW-11 water (i.e., “Pond water”) to the feed water to increase the nitrate-N, chlorate, and perchlorate load to the system. Reduce the flow of pond water if the combined load of nitrate-N, chlorate, and perchlorate exceeds the design load, or if the maximum design concentration of any water quality parameter is exceeded.

Monitor the FBRs as per Table 4-1 for 7 days and adjust ethanol and nutrient dosages as needed to maintain residual ammonia-N, phosphate-P and ethanol (as measured by soluble TOC) as per Table 4-1. Adjust the dosage of trace elements as needed. The nitrate and chlorate are expected to be fully degraded in the first stage sand FBRs and the perchlorate is expected to be less than 4 ug/L in the effluent from the GAC FBRs.

Process Certification Testing

Startup Equipment, Test Kits, and Chemicals

A number of on-site analyses will be required using simple field test kits. Less routine analyses of alkalinity (EPA 310.1), total hardness (EPA 130.2), total dissolved solids (TDS) (EPA 160.1), and cations (EPA 300.0) will also be periodically required (once every two weeks or after changing the feed water composition). These less frequent analyses should be performed by a certified laboratory. The use

of Hach methods requiring a spectrophotometer is recommended for the on-site analyses rather than the use of simple visual field test kits. The spectrophotometer methods produce much more reliable and quantitative measurements than simple visual “color wheel” test kits. In addition, once the spectrophotometer (and heater block COD reactor for digestions) are purchased, it is relatively inexpensive and simple to purchase reagents for other analyses if they are required in the future.

Hach Equipment and Reagents

Below is a list of recommended equipment and reagents which can be purchased directly from Hach (Loveland, CO) in order to perform the recommended analyses. Additional reagents can be purchased from Hach as needed. In addition to the equipment listed below, a few 250-ml beakers, 5-ml and 10-ml transfer pipets, 100-ml graduated cylinders, and disposable 0.45 mm filters and syringes etc. will also be required.

Equipment

- Pocket Thermometer
- Cat. No. 26763-00 (2003 Catalog, p. 10-66)
- ORP Pocket Pal™ Tester
- Cat. No. 27273-00 (2003 Catalog, p. 4-29)
- Lights Solution Ampules - 20 Count (for checking ORP electrode response)
- Cat No. 26125-20 (2003 Catalog, p. 11-26)
- DR/2500 Spectrophotometer
- Cat. No. 59000-00 (2003 Catalog, p. 3-11)
- COD Reactor
- Cat. No. 45600-00 (2003 Catalog, p. 1-20)
- Laboratory Bench Safety Shield
- Cat No. 50030-00 (2003 Catalog, p. 1-20)
- Test Tube Rack (for cooling)
- Cat. No. 18641-00 (2003 Catalog, p. 1-20)
- Thermometer, dial, 0 to 200 °C
- Cat. No. 45655-00 (2003 Catalog, p. 1-20)
- SensION156 Portable pH/Dissolved Oxygen Meter with Platinum (or Conventional)

- pH and DO Probes
- Cat. Nos. 54650-12 or 54650-13 (2003 Catalog, p. 4-15)

Reagents

Parameter	Analytical Method	DR/2500 2003 Cat. No. and Page #	Range	Approximate Price
Ammonia-N	Hach Method 8038 Colorimetric (Nessler) *	24582-00 p. 3-6	0 – 2.500 mg/l	\$36.70 per 100 analyses
Chloride	Hach Method (Mercuric Thiocyanate)	23198-00 p. 3-4	0 – 25.0 mg/l	\$36.85 per 100 analyses
Nitrate-N	Hach Method (Cadmium Reduction)	21061-69 p. 3-6	0 – 5.0 mg/l	\$25.45 per 100 analyses
Nitrite-N	Hach Method 8507 (Diazotization) *	21071-69 p. 3-6	0 – 0.300 mg/l	\$22.55 per 100 analyses
Ortho- phosphate	Hach Method 8048 (Ascorbic Acid) *	21060-69 p. 3-6	0 – 2.500 mg/L	\$20.00 per 100 analyses
Sulfate	Hach Method 8051 (SulfaVer® 4) *	12065-99 p. 3-7	0 – 70.0 mg/l	\$20.20 analyses per 100

Parameter	Analytical Method	DR/2500 2003 Cat. No. and Page #	Range	Approximate Price
Sulfide	Hach Method 8131 (Methylene Blue) *	22445-00 p. 3-7	0 – 800 ug/l	\$42.90 analyses per 100
Total Kjeldahl Nitrogen (TKN)	Hach Method (Nessler)	24953-00 p. 3-6	0 – 150.0 mg/l	\$88.65 analyses per 100
Total Organic Carbon (TOC)	Hach Method (Digestion, Persulfate, Sulfuric Acid)	27603-45 p. 11-39 28159-45 p. 11-39	0.3 – 20.0 mg/l 15 – 150 mg/l	\$260.05 per 50 analyses \$260.05 per 50 analyses

* USEPA-Accepted or USEPA-Approved HACH Methods Used for Wastewater Reporting

Cole-Parmer Equipment and Reagents

Below is a recommended perchlorate probe, sulfide probe, and meter which can be purchased directly from Cole Parmer (Vernon Hills, IL).

- Oakton® Acorn™ Ion 5 Meter
- Cat. No. A-35613-21 (2003/04 Catalog, p. 1179)
- Perchlorate Probe
- Cat. No. A-27504-24 (2003/04 Catalog, p. 1178)
- Perchlorate Standards and Fill Solution Kit
- Cat. No. A-27502-85 (2003/04 Catalog, p. 1179)

- Perchlorate Ion Strength Adjustors/Standard Kit
- Cat. No. A-27503-60 (2003/04 Catalog, p. 1179)
- Silver/Sulfide Probe
- Cat. No. 27504-28 (2003/04 Catalog, p. 1178)
- Silver/Sulfide Standards and Fill Solution Kit
- Cat. No. A-27502-91 (2003/04 Catalog, p. 1179)
- Silver/Sulfide Ion Strength Adjustors/Standard Kit
- Cat. No. A-27503-51 (2003/04 Catalog, p. 1179)

Chemicals

Below are the recommended chemicals and quantities required for FBR startup. The anticipated usage of chemicals will be dictated by the perchlorate loading to the FBRs.

- 20,000 gallons of ethanol
- 4,000 gallons of 39% liquid urea/di-ammonium phosphate nutrient mixture
- Eight (8) 55-gallon drums of nitric acid; for sand media preparation – only need if replacing sand (see above)
- 15 gallons of 85% phosphoric acid; for sand media preparation
- Two (2) 55-gallon drums of 93% sulfuric acid; for GAC neutralization – Only need if replacing GAG
- One (1) 550-gallon tote of 20% caustic soda; for pH control
- One (1) 550-gallon tote of trace elements
- One (1) 550-gallon tote of polymer for thickening (TBD)
- One (1) 550-gallon tote of polymer for the DAF units (TBD)
- 4,000 gallons of 30% ferric chloride
- 1,500 cubic feet of water treatment grade hydrated lime 93% Ca(OH)_2

FBR-A Process Feed Start-up Plan

The following items are assumed to be in place prior to initiating start-up:

- a. Separator T-1401, the continuous sand filter, and all other additional system components are fully operational.
- b. FBR-A is full of media and stabilized lake water.
- c. The 39% urea/DAP mix has been replaced with 52% urea and the phosphoric acid system is operating properly.

NOTE: It is assumed that the ethanol addition, pH control, and nutrient (urea and phosphoric acid) addition systems are set up, calibrated, primed, and functioning properly.

Pre-inoculation

Prior to inoculating FBR A, the sand in FBRs 1 through 4 will be evened out using the settled bed height data obtained during the system shutdown required for mechanical tie-in and controls upgrade (see Section 3). The transfer of media will be accomplished using an eductor assembly that uses the motive force in the pressurized stabilized lake water. It is anticipated that this assembly will use approximately 30 to 35 gpm of stabilized lake water and will be capable of transferring approximately 15 to 20 gpm of fluidized sand bed. Using these assumptions, the device should be capable of transferring 1 ton of sand (1.5 inches of settled sand; 2.5 inches of expanded sand in FBRs 1 through 4) in 15 to 20 minutes. Assuming no more than 3 feet of expanded bed needs to be exchanged, this process should take 4 to 6 hours to complete.

Inoculation

The inoculation procedure will involve first transferring virgin sand from FBR A to each of FBRs 1 through 4, and then transferring conditioned and inoculated sand from each of FBRs 1 through 4 to FBR A as follows. Before beginning transfers of sand, the bed height control pumps for FBRs 1 through 4 should be turned off. 1. With FBRs 1 through 4 running in normal operating mode, and FBR A running in recycle, record bed heights, fluidization flows, fluidization pressures and fluidization flow valve positions for all FBRs. Begin recording perchlorate concentrations in separators T-2011 and T-2012 at an increased frequency (i.e., every 30 minutes). 2.

With the FBR A fluidization pump running, transfer 1'-8" of expanded FBR A sand (1'-3" of settled FBR A bed) to each of FBRs 1 through 4 (approximately 20,000 lbs or 10 tons of dry sand transferred per reactor) in the following order: FBR 1, 3, 2 and 4. It is suggested that for each FBR, the transfer occur in two stages (i.e., 10,000 lbs per stage) with a 30 to 60 minute waiting period between transfers to make sure everything is stable. Measure perchlorate concentrations, bed heights, fluidization flows and fluidization pressures during and after each transfer. Maintain the "normal system fluidization flow" for FBR A during the transfer process. If perchlorate concentrations begin to increase dramatically (i.e., at a rate that could result in loss of control), stop transfer operations temporarily. This procedure is anticipated to take 3 to 4.5 hours per reactor, and will therefore likely take 1 to 2 days to complete. It is anticipated that the fluidization flow for each of FBRs 1 through 4 will drop by approximately 100 gpm when the full 10-ton amount of sand has been transferred. This will decrease the fluidization flow from 1,650 gpm (as of 3/10/06) to 1,550 gpm, and lower the fluidization velocity from 11 gpm/ft² to 10 gpm/ft² (acceptable).

3. With the FBR A fluidization pump running, transfer sand from the TOP of each of FBRs 1 through 4 to FBR A so as to return the expanded bed heights of FBRs 1 through 4 to the values recorded before the initial transfer of sand from FBR A. Perform the transfer in the following order: FBR 1, 3, 2 and 4. Again, it is suggested that for each FBR, the transfer occur in two stages (i.e., 10,000 lbs per stage) with a 30 to 60 minute waiting period between transfers to make sure everything is stable. Measure perchlorate concentrations, bed heights, fluidization flows and fluidization pressures during and after each transfer. Maintain the "normal system fluidization flow" for FBR A during the transfer process. If perchlorate concentrations begin to increase dramatically (i.e., at a rate that could result in loss of control), stop transfer operations temporarily. This procedure is also anticipated to take 3 to 4.5 hours per reactor, and will therefore likely take 1 to 2 days to complete. Since residual ethanol, perchlorate and nutrients will be transferred to FBR A from the operating FBRs along with the sand, no additional ethanol or nutrients should be added to FBR A during the transfer.

Establish Operation at Existing Load

With FBR A running in recycle, and all other first stage FBRs operating normally, reduce the feed flow to FBRs 1 through 4 each by approximately 8% (or 20 gpm each) and re-direct this flow to FBR A (total flow re-directed approximately 80 gpm). Monitor perchlorate concentrations in separator T-1401 every hour (initially) and adjust ethanol and nutrient dosages to FBR A accordingly to maintain target perchlorate concentrations. Monitor ammonia-N (or total-N, if appropriate) and orthophosphate-P concentrations in separator T-1401 (filtered samples) every 4 to 6 hours (initially). The revised “Electron Donor, Trace Elements and Nutrients Addition Spreadsheet” in Appendix C should be used as a guideline for nutrients addition and pump settings to the FBRs.

When performance stabilizes, re-direct additional flow from FBRs 1 through 4 to FBR A in increasing increments until the feed flow to each FBR is equalized at 200 gpm:

1st increment – re-direct 5 gpm from each FBR (i.e., 20 gpm total flow re-directed to FBR A) for a total flow of 100 gpm total feed to FBR A;

2nd increment – re-direct 7.5 gpm from each FBR (i.e., 30 gpm total flow re-directed to FBR A) for a total flow of 130 gpm total feed to FBR A;

3rd increment – re-direct 7.5 gpm from each FBR (i.e., 30 gpm total flow re-directed to FBR A) for a total flow of 160 gpm total feed to FBR A;

4th increment – re-direct 10 gpm from each FBR (i.e., 40 gpm total flow re-directed to FBR A) for a total flow of 200 gpm total feed to FBR A.

Between each change, monitor the system and wait until performance stabilizes until making the next change. It is anticipated that equalizing flow among the FBRs and ramping up FBR A will take approximately 10 days.

Ramp Up to Design Load

NOTE: Prior to ramping up the load, analyses of the water sources for perchlorate, chlorate and nitrate-N is required. The water sources are: (1) Lift Station #1, (2) Lift Station #3, (3) GW-11, and (4) the combined interceptor wells (NOT the GWTP influent tank and NOT the GWTP effluent tank TK-6).

Once the system is operating at the existing load and the flows to the FBRs have been equalized, begin ramping up the load by increasing the amount of GW-11 added to the system. It is recommended that changes in load be made in increments no greater than 5%. The revised “Electron Donor, Trace Elements and Nutrients Addition Spreadsheet” in Appendix C can be used as a guideline to estimate the required changes in GW-11 flow. At some point, it is expected that the alkalinity of the water will become exhausted, and the caustic usage will begin to increase rapidly. The system effluent alkalinity should be monitored daily while ramping up the load in order to estimate when this increase in caustic usage will occur. Monitor caustic usage closely, and when the usage begins to increase rapidly, maintain this loading until the pH and the caustic usage stabilize until the next incremental change. Increase the flow of GW-11 until the combined load of nitrate-N, chlorate, and perchlorate reaches the design load.

It is anticipated that ramping the system up to the new design load will take no longer than 20 days.

FBR A Process Certification Testing

After FBR A has been started up and the Perchlorate Treatment System has been ramped up to the new design load, process certification testing will be performed.

FBR A MONITORING

Monitor FBR A in accordance with the same parameters and monitoring schedule as for the other first stage FBRs. Using the EXCEL spreadsheet in Appendix C, the necessary trace element, electron donor (i.e., ethanol), phosphoric acid (i.e., 75% phosphoric acid) and urea (i.e., 52% urea) dosages can be calculated for various feed flow rate and composition [i.e., the concentrations of dissolved oxygen (DO), nitrate-nitrogen (NO₃--N), chlorate (ClO₃-), and perchlorate (ClO₄-)] conditions. The nutrient and ethanol dosages should be used as a guideline only; actual requirements will be dictated by the concentrations of the target parameters (i.e., nitrate, chlorate, and perchlorate) in the sand and GAC FBR effluents, as well as the residual ammonia-N, TKN (or total-N, if appropriate), and ortho-phosphate in the effluents.

APPENDIX O

SLUDGE CONDITIONING

Sludge Conditioning Standard Operating Procedure (SOP)

- Turn on the Sludge Conditioning Tank Agitator and thoroughly mix the contents of the Sludge Conditioning Tank for at least 5-minutes.
- Collect a sample from the Sludge Conditioning Tank.
- Pour out a 100 ml portion of the sludge sample into a plastic beaker and add a magnetic stir bar to the beaker.
- Place the beaker onto the stir plate, begin to agitate the contents of the beaker, and insert the pH Probe into the beaker for pH monitoring.
- Add concentrated 39% ferric chloride solution in small increments of 0.25 ml to the beaker. Add increments of ferric chloride solution until the pH of the mixture is at 2.5 Standard Units. (Note: there will be a distinct color change of the sludge from black to tan as the pH drops below 3.0). Total the sum of the individual increments of ferric chloride to determine a dosing rate per 100 ml of sample. Multiply this value 10 to the milliliters of ferric chloride dose for a one-liter volume of sludge. $(\text{mL of ferric chloride}) \times 10 = \text{mL of ferric/L of sludge}$
- Continue to agitate the contents of the beaker.
- The next step is to add dry lime to raise the pH of the mixture up to 11.5 standard units. Partially fill a container with about 15 grams of the dry powered lime and weigh the container with lime to the nearest milligram. Add portions of the dry lime to the -pH 2.5 mixture in the beaker. Continue to add dry lime until the pH reaches a value of .11.5 Standard Units. Weigh the lime container again to the nearest milligram and calculate the amount of lime in grams added to the 100 ml sample by the difference in the weights before and after dosing with lime to pH
- 11.5 Standard Units. Multiply this value by 10 to get the grams of dry lime dose for a one-liter volume of sludge. $(\text{grams of lime}) \times 10 = (\text{grams of lime/L of sludge})$.
- Prepare the vacuum filter apparatus consisting of a vacuum pump with gauges, a filter flask, a buchner filter funnel and either a 7 cm Whatman 4 filter paper media or a piece of actual filter cloth cut to a 7 cm circle. After sealing the inlet to the vacuum pump, adjust the vacuum by turning the bleed valve to 15 inches of mercury. Open the inlet of the sealing restriction.
- Using a stopwatch to measure the filtering time, pour the 100 ml treated mixed sample into the filter apparatus with a vacuum pump running and start the stopwatch. Note how quickly the sludge dewateres and forms a dry cake. If the sludge has been properly

conditioned in the beaker, this should happen in less than 60 seconds and produce a relatively clear filtrate in the flask below.

- The goal with this test is to determine a chemical feed dosage that will enable the filter press to rapidly dewater the treated sludge.
- Once the dosage of each treatment chemical has been determined for the 100 mL sample, the Conditioning Tank must be treated with the same chemical dosages in full scale.
- The Sludge Conditioning Tank has a tank capacity of approximately 13,200 gallons. The cone of the tank hold 4500 gallons and each additional foot above the cone is an additional 1100 gallons of sludge.
- For the 39% ferric chloride dosage, calculate the volume of ferric chloride needed per volume of the Conditioning Tank and the necessary run time to achieve that dosage by using the formulas provided below. (Note: the Ferric Pump has a capacity of approximately 4.4 GPM).

$$\frac{\text{Sludge, gallons}}{\text{Batch}} \times \frac{\text{ml Ferric sol'n}}{\text{Liter}} \times \frac{1 \text{ Liter}}{1,000 \text{ ml}} = \frac{\text{gallons of Ferric sol'n}}{\text{Batch}}$$

$$\frac{\text{gallons of Ferric sol'n}}{\text{Batch}} \times \frac{\text{minute}}{4.4 \text{ gallons}} = \frac{\text{minutes to pump Ferric sol'n}}{\text{Batch}}$$

- For the lime dosage, calculate the run time for the dry lime feeder to equal the quantity of lime required to treat the volume of sludge in the Conditioning Tank by using the formulas provided below. (Note: The Dry Lime Feeder has a feed rate of approximately 1,500 lbs/hour).

$$\frac{\text{Sludge, gallons}}{\text{Batch}} \times \frac{\text{grams lime}}{\text{Liter}} \times \frac{3.785 \text{ liters}}{\text{gallon}} \times \frac{\text{pound}}{454 \text{ g}} = \frac{\text{lbs lime}}{\text{Batch}}$$

$$\frac{\text{lbs lime}}{\text{Batch}} \times \frac{60 \text{ minutes}}{1,500 \text{ lbs Lime}} = \frac{\text{minutes to feed lime}}{\text{Batch}}$$

- Use the actual Conditioning Tank sludge volume as the batch size to be treated with first the ferric chloride and then the dry lime. The total manufacturer rated volume of the Conditioning Tank is 13,500 gallons and it has a 14-foot diameter. On the straight wall side area of the Conditioning Tank 1.0 foot of depth is equivalent to 1,150 gallons. The cone section of the Conditioning Tank contains 4,500 gallons. The straight sidewall of the Conditioning Tank above the cone section is 9.5 feet. Take a measurement of the height of empty tank above the sludge level and subtract this from 9.5 feet. The resulting number is the feet of sludge in the tank above the cone line. Multiply this value by 1,150 gallons per foot of straight wall tank and add the 4,500 gallons of the cone section of the Conditioning Tank to get the total volume of sludge in the Conditioning Tank.

- Add the calculated ferric chloride dose to the Conditioning Tank as determined above, mix sufficiently, and determine a pH value for the mixed contents. It should be very close to the 2.5 Standard Units determined through jar testing. If it is not the desired value, add slightly more ferric chloride, mix thoroughly and again determine the pH value. Continue additions of ferric chloride until the desired pH value is reached.
- Add the dry lime to the Conditioning Tank using the dry lime feeder run time determined in the formula above. Following a thorough mixing, collect a portion of the treated mixture and determine the pH value. If the pH is not the desired value, continue additions of dry lime until the desired pH value is reached. (Note: The target pH is 11.5 S.U.).
- After a thorough mix of the Conditioning Tank following both ferric chloride and dry additions, stop the Conditioning Tank Agitator. Leaving the Agitator on could potentially break down the conditioned sludge and result in a "bad" Filter Press run.
- Run the Filter Press using the chemically treated sludge in the Conditioning Tank.



APPENDIX P EQUIPMENT INSPECTION SHEET

Sub-System	P&ID	Description	Status ¹	Checked	Criticality ²	Notes
		Main Plant Equipment				
1		Seep Wells and Lift Station 1				
1.01		Seep Well Field, 9 wells	Running			
1.02		Lift Station 1 Lift Pump A	Standby			
1.03		Lift Station 1 Lift Pump B	Running			
1.04		Area in and around Lift Station 1	Running			
2		Athens Road Wells and Lift Station 3				
2.01		Athens Road Well Field, 9 wells	Running			
2.02		Lift Station 3 Lift Pump A	Standby			
2.03		Lift Station 3 Lift Pump B	Running			
2.04		Area in and around Lift Station 3	Running			
3		Lift Station 2 and Transmission Pipelines				
3.01		Influent Pipeline	In operation			
3.02		Effluent Pipeline	Running			
3.03		Lift Station 2 Lift Pump A	Running			
3.04		Lift Station 2 Lift Pump B	Standby			
3.05		Area in and around Lift Station 2	Running			
4		Interceptor Wells and Cr Treatment Plant				
4.01		IWF Well Field, 30 wells	Running			
4.02		Ferrous Sulfate Feed System	Running			
4.03		Polymer Feed System	Running			
4.04		Clarifier	In operation			
4.05		Filter Press	Running			
4.06		GWTP Effluent Tank	In operation			
4.07		Interceptor Booster Pump A	Maintenance			
4.08		Interceptor Booster Pump B	Running			
4.09		Area In And Around GWTP	Running			

¹Status Codes

Running - Unit is in operation

Standby - Spare or duplicate, not currently in operation

Maintenance - Out of service for maintenance

Off - Not currently needed for use, but can be placed in service

Sub-System	P&ID	Description	Status ¹	Checked	Criticality ²	Notes
5		Equalization Area and GW-11 Pond				
5.01	PID10A	Pond GW-11	In operation			
5.02	PID10A	Pond Water Pump - P101A	Running			
5.03	PID10A	Pond Water Pump - P101B	Running			
5.04	PID10A	Equalization Tanks	In operation			
5.05	PID10A	Area in and Around EQ	In operation			
5.06	PID10A	Raw Water Feed Pump - P102A	Running			
5.07	PID10A	Raw Water Feed Pump - P102B	Maintenance			
5.08	PID10B	Carbon Absorber - LGAC 201A	Running			
5.09	PID10B	Carbon Absorber - LGAC 201B	Running			
5.10	PID10B	Carbon Absorber - LGAC 201C	Running			
6		First Stage FBRs A, 1 & 2				
6.01	PID14	FBR A	Running			
6.02	PID14	Separator Tank - 1401	Running			
6.03	PID14	Media Return Pump - P 1401	Running			
6.04	PID14	P1401A	Standby			
6.05	PID01A	P1401B	Running			
6.06	PID01A	FBR 1	Running			
6.07	PID02A	FBR 2	Running			
6.08	PID01A	First Stage Separator Tank - T2011	Running			
6.09	PID01A	Media Return Pump - P2011	Running			
6.10	PID01A	First Stage FBR Pump - P1011	Standby			
6.11	PID01A	First Stage FBR Pump - P1012	Running			
6.12	PID01A	First Stage FRB Pump - P101A	Running			
6.13	PID07A	FBR A pH Feed Pump - P71A	Standby			
6.14	PID07A	FBR 1 pH Feed Pump - P711	Standby			
6.15	PID07A	FBR 2 pH Feed Pump - P712	Standby			
6.16	PID07A	FBR A Nutrient (Urea) Feed Pump - P72A	Off			
6.17	PID07A	FBR 1 Nutrient (Urea) Feed Pump - P721	Off			
6.18	PID07A	FBR 2 Nutrient (Urea) Feed Pump - P722	Off			
6.19	PID15	FBR A Nutrient (Phos Acid) Feed Pump - P1520A	Running			
6.20	PID15	FBR 1 Nutrient (Phos Acid) Feed Pump - P1521	Running			
6.21	PID15	FBR 2 Nutrient (Phos Acid) Feed Pump - P1522	Running			
6.22	PID07B	FBR A Electron Donor Assembly Pump - P73A	Running			
6.23	PID07B	FBR 1 Electron Donor Assembly Pump - P731	Running			
6.24	PID07B	FBR 2 Electron Donor Assembly Pump - P732	Running			

¹Status Codes

Running - Unit is in operation

Standby - Spare or duplicate, not currently in operation

Maintenance - Out of service for maintenance

Off - Not currently needed for use, but can be placed in service

Sub-System	P&ID	Description	Status ¹	Checked	Criticality ²	Notes
7		First Stage FBRs 3 & 4				
7.01	PID01B	FBR 3	Off			
7.02	PID01B	FBR 4	Off			
7.03	PID02B	First Stage Separator Tank - T2012	Off			
7.04	PID01B	Media Return Pump - P2012	Off			
7.05	PID01B	First Stage FBR Pump - P1013	Off			
7.06	PID01B	First Stage FRB Pump - P1014	Off			
7.07	PID01B	First Stage FBR Pump - P102A	Off			
7.08	PID07A	FBR 3 pH Feed Pump - P713	Off			
7.09	PID07A	FBR 4 pH Feed Pump - P714	Off			
7.10	PID07A	FBR 3 Nutrient (Urea) Feed Pump - P723	Off			
7.11	PID07A	FBR 4 Nutrient (Urea) Feed Pump - P 724	Off			
7.12	PID15	FBR 3 Nutrient (Phos Acid) Feed Pump - P1523	Off			
7.13	PID15	FBR 4 Nutrient (Phos Acid) Feed Pump - P1524	Off			
7.14	PID07B	FBR 3 Electron Donor Assembly Pump - P733	Off			
7.15	PID07B	FBR 4 Electron Donor Assembly Pump - P734	Off			
8		Second Stage FBRs 5 & 6				
8.01	PID03A	FBR 5	Off			
8.02	PID03A	FBR 6	Off			
8.03	PID03C	Second Stage Separator Tank - T3011	Off			
8.04	PID03A	Media Return Pump - P3011	Off			
8.05	PID03A	Second Stage FBR Pump - P3015	Off			
8.06	PID03A	Second Stage FBR Pump - P3016	Off			
8.07	PID03A	Second Stage FBR Pump - P301A	Off			
8.08	PID07A	FBR 5 pH Feed Pump - P715	Off			
8.09	PID07A	FBR 6 pH Feed Pump - P716	Off			
8.1	PID07A	FBR 5 Nutrient (Urea) Feed Pump - P725	Off			
8.11	PID07A	FBR 6 Nutrient (Urea) Feed Pump - P726	Off			
8.12	PID07B	FBR 5 Electron Donor Assembly Pump - P735	Off			
8.13	PID07B	FBR 6 Electron Donor Assembly Pump - P736	Off			

¹Status Codes

- Running - Unit is in operation
- Standby - Spare or duplicate, not currently in operation
- Maintenance - Out of service for maintenance
- Off - Not currently needed for use, but can be placed in service

Sub-System	P&ID	Description	Status ¹	Checked	Criticality ²	Notes
9		Second Stage FBRs 7 & 8				
9.01	PID03B	FBR 7	Running			
9.02	PID03B	FBR 8	Running			
9.03	PID03D	Second Stage Separator Tank - T3012	Running			
9.04	PID03B	Media Return Pump - P3012	Running			
9.05	PID03B	Second Stage FBR Pump - P3017	Standby			
9.06	PID03B	Second Stage FBR Pump - P3018	Running			
9.07	PID03B	Second Stage FBR Pump - P302A	Running			
9.08	PID07A	FBR 7 pH Feed Pump - P717	Standby			
9.09	PID07A	FBR 8 pH Feed Pump - P718	Standby			
9.10	PID07A	FBR 7 Nutrient (Urea) Feed Pump - P727	Off			
9.11	PID07A	FBR 8 Nutrient (Urea) Feed Pump - P728	Off			
9.12	PID07B	FBR 7 Electron Donor Assembly Pump - P737	Running			
9.13	PID07B	FBR 8 Electron Donor Assembly Pump - P738	Running			
10		Aeration and DAF System				
10.01	PID04	Aeration Tank	In operation			
10.02	PID04	Aeration Blower - B401	Running			
10.03	PID04	Biofilter	In operation			
10.04	PID04	Nutrient Solution	Running			
10.05	PID04	Biofilter Sump	Running			
10.06	PID04	Nutrient Pump - P401	Running			
10.07	PID04	Biofilter Sump Pump - P402A	Standby			
10.09	PID04	Biofilter Blower	Running			
10.10	PID05	DAF Pressure Tanks	In operation			
10.11	PID05	DAF Vessel - D501	Running			
10.12	PID05	DAF Pressure Pump - P501	Running			
10.13	PID05	DAF Float Pump - P502	Running			
10.14	PID05	DAF Vessel - D551	Maintenance			
10.15	PID05	DAF Pressure Pump - P551	Off			
10.16	PID05	DAF Float Pump - P552	Maintenance			
10.17	PID05	Screw Conveyer Drive	Standby			
10.18	PID05	Skimmer Drive	Running			

¹Status Codes

Running - Unit is in operation

Standby - Spare or duplicate, not currently in operation

Maintenance - Out of service for maintenance

Off - Not currently needed for use, but can be placed in service

Sub-System	P&ID	Description	Status ¹	Checked	Criticality ²	Notes
11		Pumping System (Old Effluent)				
11.01	PID06	Effluent Tank 601	In operation			
11.02	PID06	Effluent Pump - P601	Running			
11.03	PID06	Effluent Pump - P602	Running			
12		Sand Filter System				
12.01	PID17	Sand Filter	Running			
12.02	PID17	Filter Reject Tank	In operation			
12.03	PID17	Filter Reject Pump - P1701A	Running			
12.04	PID17	Filter Reject Pump - P1701B	Standby			
13		Effluent Tank and Pumping				
13.01	PID10C	UV Effluent Tank	Running			
13.02	PID10C	Effluent Booster Pump - P1302A	Running			
13.03	PID10C	Effluent Booster Pump - P1302B	Running			
13.04	PID10C	Area Around Effluent and North D-1	Running			
14		Solids Collection and Pressing System				
14.01	PID16	Sludge Storage Tank	In operation			
14.02	PID16	Solids Storage Effluent Pump - P1601	Running			
14.03	PID16	Solids Cond. Tank	In operation			
14.04	PID09	Sludge Mixer	Running			
14.05	PID09	Filter Press Pump - P901	Running			
14.06	PID09	Filter Press Pump - P902	Running			
14.07	PID09	West Press	Running			
14.08	PID09	East Press	Standby			
14.09	PID09	Filtrate Tank	In operation			
14.10	PID09	Filtrate Tank Effluent (recycle) Pump - P903	Running			

¹Status Codes

Running - Unit is in operation

Standby - Spare or duplicate, not currently in operation

Maintenance - Out of service for maintenance

Off - Not currently needed for use, but can be placed in service

Sub-System	P&ID	Description	Status ¹	Checked	Criticality ²	Notes
Chemical Systems						
15		Electron Donor System				
15.01	PID07B	<i>Electron Donor Tank</i>	In operation			
15.02	PID07B	<i>Booster Pump P739A</i>	Standby			
15.03	PID07B	<i>Booster Pump P739B</i>	Running			
17	PID07C	Micro Nutrient System	In operation			
18	PID07C	Hydrogen Peroxide System	In operation			
19	PID07C	De-Foam System	In operation			
20	PID15	Nutrient (Phosphoric Acid) System (Tank only - pumps included in FBRs)	In operation			
21	PID07A	Nutrient (Urea) System (Tank only - pumps included in FBRs)	In operation			
22	PID07A	pH System (Tank and effluent pH feed pump only - other pumps included in FBRs)	In operation			
23	PID07C	Ferric Chloride System	In operation			
24	PID07B	Polymer Systems - DAF	In operation			
25	PID09	Polymer System - Solids Dewatering (2 tanks, 2 centrifugal pumps, mixer, volumetric feeder)	In operation			
Utility Systems						
26		Compressed Air System				
26.01	PID08	<i>West Compressor</i>	Running			
26.02	PID08	<i>East Compressor</i>	Running			
26.03	PID08	<i>O2 Compressor</i>	Running			
26.04	PID08	<i>Compressed Air Receiver Tank</i>	In operation			
26.05	PID08	<i>Air Dryer</i>	Running			
26.06	PID08	<i>Oil Removal Filter</i>	In operation			
26.07	PID08	<i>Particulate Filter</i>	In operation			
27	PID16	Oxygen System	In operation			
28		GWETS Plant Controls/ Siemens Controls	In operation			
29		Well Control System/ Allen Bradley Controls	In operation			
30		MCC FBR Pad	In operation			
31		MCC in D-1	In operation			
32		MCC in EQ area	In operation			

¹Status Codes

Running - Unit is in operation

Standby - Spare or duplicate, not currently in operation

Maintenance - Out of service for maintenance

Off - Not currently needed for use, but can be placed in service

Sub-System	P&ID	Description	Status ¹	Checked	Criticality ²	Notes
Miscellaneous Systems						
33		Operations Office/Network	In operation			
34		Laboratory Analyzers	In operation			
35		Security Systems	In operation			
Shelf Spares						
		Media Return Pump Rebuild Kit	In stock			
		pH Feed Pump	In stock			
		Nutrient Feed Pump	In stock			
		Electron Donor Feed Pump	In stock			
		Phosphoric Acid Feed Pump	In stock			
		Interceptor Well Pumps (4 each)	In stock			
		Seep Well Pump (1 each, same as Athens so total of 2)	In stock			
		Athens Road Well Pump (1 each, same as Seep so total of 2)	In stock			

¹ Status Codes

Equipment

Running Unit is in operation
 Standby Duplicate or installed spare, not currently operating
 Maintenance Out for repairs or maintenance
 Off Not currently needed, but available

¹ Criticality Codes

1 = Critical Cannot continue with operation until repairs made
 2 = Important Can still operate safely and in compliance with permits, but risks are increased
 3 = Moderate Work needs to be performed, but plant can still operate with redundancy that is in place
 - Tasks performed to either improve the existing equipment (i.e., testing new options)
 4 = Low - Minor repairs that in no way alter the performance of the plant

Tanks, Pipelines, Ponds

In operation
 Out of service

Spares

In stock

¹ Status Codes

Running - Unit is in operation
 Standby - Spare or duplicate, not currently in operation
 Maintenance - Out of service for maintenance
 Off - Not currently needed for use, but can be placed in service



APPENDIX Q

ALARM TEST LOGSHEET

Autodialer & Alarm Test Sheet

Tag number		Tag Description				
Weekly			1st W	2nd W	3rd W	4th W
1	LAH_621	T_621 High Level Alarm				
2	LAH_1701	Filter Reject Tank High Level				
3	FIT_101	LS 1 Low Flow Alarm				
4	FIT_201	LS 2 Low Flow Alarm				
5	FIT_301	LS 3 Low Flow Alarm				
6	LAH-1202	D-1 Sump High Level				
7	Camera					
8	LAH_1101	Sump pump High Level				
9	LAH_1102	Sump pump High Level				
10	LAH-TK-6	GWTP Holding Tank Alarms				
11	LAH-1203	PDM Sump High Level				
12	LAH-1201	Equalization Sump High Level				
Monthly						
11	LOW INFLUENT FLOW	Low Influent Feed to FBR				
12	FBR A_FEED_SHUTDOWN					
13	FBR 1_FEED_SHUTDOWN					
14	FBR 2_FEED_SHUTDOWN					
15	FBR 3_FEED_SHUTDOWN					
16	FBR 4_FEED_SHUTDOWN					
17	FBR 5_FEED_SHUTDOWN					
18	FBR 6_FEED_SHUTDOWN					
19	FBR 7_FEED_SHUTDOWN					
20	FBR 8_FEED_SHUTDOWN					
21	FBR A_RECYCLE					
22	FBR 1_RECYCLE					
23	FBR 2_RECYCLE					
24	FBR 3_RECYCLE					
25	FBR 4_RECYCLE					
26	FBR 5_RECYCLE					
27	FBR 6_RECYCLE					
28	FBR 7_RECYCLE					
29	FBR 8_RECYCLE					
30	AAH_3027	FBR 7 High ORP				
31	AAH_3028	FBR 8 High ORP				
32	E10_LAL_11	EQ Tank Low Level Alarm				
Quarterly						
33	LAH_707	Ethanol Tank Leaking Alarm				
34						



APPENDIX R
GWETS EMERGENCY RESPONSE PLAN

Revision 1, dated October 7, 2014

Approved by NDEP BCA

Emergency Response Plan GWETS Plume Containment Nevada Environmental Response Trust (NERT)

133-20192-14009
October 7, 2014 (Revision 1)

PREPARED FOR

Nevada Environmental Response Trust
35 E Wacker Drive, Suite 1550
Chicago, IL 60601

PREPARED BY


Tetra Tech, Inc.
1576 Sherman St., Suite 100
Denver, CO 80238

Prepared by:


Tracy Delaney
Senior Geochemist

10-7-2014
Date

Reviewed by:

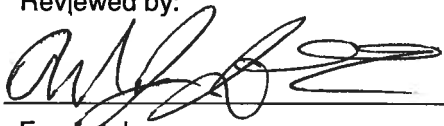
Frank Johns
Senior Project Manager


10-7-2014
Date

Reviewed and Concurrence by:


Todd Webster
Envirogen Technologies, Inc.

10/7/2014
Date

Authorized by:

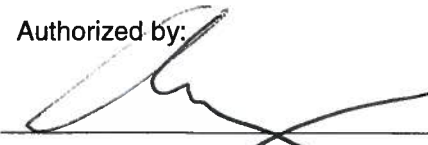
Andrew Steinberg, not individually,
But solely as Agent of the Nevada
Environmental Response Trust

10-8-14
Date

TABLE OF CONTENTS

1.0 INTRODUCTION	1
2.0 ROLES AND RESPONSIBILITIES	2
3.0 ACTIVATION OF THE EMERGENCY ACTION PLAN	2
4.0 GENERAL EMERGENCY RESPONSE ACTIVITIES.....	3
5.0 PROCEDURES FOR MINIMIZING IMPACT OF EMERGENCIES.....	4
6.0 EMERGENCY RESPONSE EQUIPMENT	5
7.0 EMERGENCY RESPONSE TRAINING	6

LIST OF TABLES

Table 1	Contact List
Table 2	Potential Emergencies
Table 3	Emergency Response Activities

LIST OF FIGURES

Figure 1	Groundwater Extraction and Treatment System Map
----------	---

ACRONYMS/ABBREVIATIONS

Acronyms/Abbreviations	Definition
AWF	Athens Road Well Field
ERP	Emergency Response Plan
FBR	Fluidized Bed Reactor
GWETS	Groundwater Extraction and Treatment System
HASP	Health and Safety Plan
IWF	Interceptor Well Field
IX	Ion Exchange
SWF	Seep Well Field

1.0 INTRODUCTION

This emergency response plan (ERP) describes potential emergencies specifically related to the Groundwater Extraction and Treatment System (GWETS) at the Nevada Environmental Response Trust (Trust) site in Henderson, Nevada (Site). General health and safety and emergency response issues such as evacuation routes, medical treatment and first aid, and decontamination procedures are addressed in the site-specific Health and Safety Plan (HASP) established and maintained by the current GWETS operator, Envirogen Technologies, Inc. (Envirogen). Users should refer to the HASP for emergency response procedures not specifically related to potential emergencies impacting the operation of the GWETS.

This ERP describes the scenarios that could impact the operation of the GWETS in regard to plume containment, and the procedures for responding to those emergencies, roles and responsibilities during emergency response, and training that workers must receive to follow emergency procedures.

This emergency response plan provides the following site-specific information related to GWETS:

- Pre-emergency planning
- Contacts
- Roles and responsibilities
- Emergency alerting and response procedures.

GWETS Plume Containment System

The GWETS has been in place in essentially its current configuration since 2006. The GWETS operates by capturing groundwater from three extraction well fields and treating the captured groundwater via aboveground treatment facilities for subsequent discharge to the Las Vegas Wash. Perchlorate in extracted groundwater is treated in the on-site fluidized bed reactor (FBR) process using ethanol as a carbon source. Chromium in extracted groundwater is treated via chemical reduction and precipitation using ferrous sulfate. A map covering the area from the Site to the Las Vegas Wash showing the primary components of the GWETS is included as Figure 1.

Groundwater is captured using a system of extraction wells installed into the shallow water-bearing zone of the alluvium at three strategic locations: (1) on-site at the IWF; (2) approximately 8,200 feet downgradient of the IWF at the AWF; and (3) approximately 4,500 feet beyond the AWF near the Las Vegas Wash at the SWF. The locations of the three well fields are shown on Figure 1 in relation to other GWETS features.

The IWF consists of 30 active extraction wells. The main purpose of this well field is mass removal of contaminants. The AWF has 9 extraction wells which serve to contain the contaminant plume. The SWF has 9 wells which contain the plume and keep it from reaching Las Vegas Wash. If for any reason all of the IWF and AWF cease operation, there will be minimal intermediate interception of the plume by the slurry wall before the plume reaches the SWF.

If the SWF ceases operation, plume water will migrate toward Las Vegas Wash. The groundwater velocity in the vicinity of the SWF ranges from 20 to 85 feet per day (based on a tracer study done by J.M. Montgomery in 2000). The approximate distance from the SWF to the Las Vegas Wash likely ranges from 600 feet to 3,000 feet when considering the total width of the stream at all times. Until more information is available and the velocity and distance are confirmed, a groundwater velocity of 60 feet per day and distance of 1,500 feet will be used to calculate a travel time of 25 days. The critical objective of this ERP is to limit the downtime of SWF extraction to 25 days in the event of an emergency impacting the operation of the GWETS. Please note that this value does not account for the time required for the water table to re-equilibrate after the SWF were to be shut down, which would increase the allowable downtime.

In the event that this downtime objective cannot be met, this ERP establishes alternate treatment of the SWF using an IX plant installed at Lift Station #1.

2.0 ROLES AND RESPONSIBILITIES

The GWETS Plant Manager will have the responsibility to notify the Trust’s Emergency Response Leader of any situation as described in Section 3.0 of the ERP. These individuals will be available by phone at all times, or will designate an alternate and inform all operational personnel. The Emergency Response Leader will assess the emergency, inform the Trust, and direct the response, including contacting off-site emergency personnel, if necessary. Additional contacts are those of suppliers of equipment that may be required to respond to emergencies (see Section 6). Contacts are listed in Table 1. Alternate contacts are provided for key positions in case the primary is not available

It is the obligation of the Emergency Response Leader to ensure that all compliance, notification and reporting obligations are satisfied for all applicable permitting associated with the GWETS operation.

Table 1 Contact List

Title	Primary Contact (Telephone)	Alternate Contact (Telephone)
GWETS Plant Manager	Wendy Prescott (702-371-9037)	Jeff Lambeth (702-236-1740) Mike Delvecchio (908-963-0651)
Emergency Response Leader	Frank Johns (303-810-0132)	Steven Bradley (619-961-8349)
Emergency Services	911	
NDEP Bureau of Water Pollution Control	Joe Maez (775-687-9435)	Nikita Lingenfelter (702-286-4850 x246)
NDEP Bureau of Corrective Actions	Weiquan Dong (702-486-2850 x252)	James (JD) Dotchin (702-486-2850 x235)
Temporary Power Supply	Curtis Mercurio (702-429-8487) Power Plus 3131 Olive Street Las Vegas, NV 89104	
Pipelines	Alan Nish (702-561-0193) Rafael Construction 5870 Construction Ave. Las Vegas, NV 89122	
Ion Exchange Supplier	Envirogen Technologies, Inc. (877-312-8950)	

3.0 ACTIVATION OF THE EMERGENCY ACTION PLAN

The Emergency Response Leader or their designee will be available at all times during field activities and will serve the emergency coordinator. The Emergency Response Leader activates the ERP based upon information

provided by the GWETS Plant Manager. The Emergency Response Leader implements the ERP when at least one of the following trigger conditions is met:

1. Any cause that could potentially require extraction at the SWF to be discontinued for a period of 24 hours or more for a reason other than scheduled maintenance;
2. Any cause that could potentially require the diversion of GWETS influent or effluent to GW-11 for a period of time that would cause levels to exceed 85% of permitted capacity; or
3. Any catastrophic failure that creates an immediate loss of GWETS operations.

Through consultation with the Trust, the Emergency Response Leader shall have the authority to direct GWETS operations until it has been determined that operations have returned to normal. Upon activation of the ERP, the Emergency Response Leader shall provide regular updates to NDEP BWPC and BCA until it has been determined that operations have returned to normal.

Certain incidents may not trigger activation of the ERP, but may trigger reporting under the Site Management Plan (SMP). Refer to the current version of the SMP for those reporting requirements.

4.0 GENERAL EMERGENCY RESPONSE ACTIVITIES

The following steps are common to all emergency response activities:

Notification—The person discovering the incident immediately reports the incident to their respective field supervisor, who will notify the GWETS Plant Manager. The GWETS Plant Manager notifies the Emergency Response Leader and the Emergency Response Leader notifies the Trust and the NDEP, as required, and notifies the on-site personnel, as necessary. The GWETS Plant Manager, in coordination with the Emergency Response Leader, will ensure that responding agencies (fire, police or medical (911) or regulatory agencies are notified, as required based on the respective emergency.

Assess the Nature and Extent of Incident—The GWETS Plant Manager determines the nature and extent of the incident and reports their findings to the Emergency Response Leader. Each incident has specific factors requiring action to effectively mitigate the incident. This plan discusses several types of anticipated incidents.

Identify Immediate Response Activities—The Emergency Response Leader, through communication with the GWETS Plant Manager, ensures that immediate response activities are initiated. Immediate response activities include:

- ETI will implement any required emergency response actions per their HASP to remove or rescue injured or exposed employees and ensuring appropriate medical treatment is provided;
- Stopping all repair activities until a determination can be made regarding current conditions;
- Implementing measures to identify and address any hazardous condition; and
- Assess the issue that triggered the ERP.

Coordinate Activities— At the direction of the Emergency Response Leader, the GWETS Plant Manager will coordinate all on-site activities. The Emergency Response Leader ensures the use of appropriate technical procedures to mitigate the incident and to minimize environmental impacts.

Maintain Site Security—The GWETS Plant Manager ensures control of all personnel entering and leaving the site during an emergency. The GWETS Plant Manager may direct other employees to assist with securing the site.

Follow-up Activities—The Emergency Response Leader ensures that all required notifications, especially to regulatory agencies are made. The Emergency Response Leader ensures the preparation of documentation and other reports regarding the incident are completed. The Emergency Response Leader conducts a post incident

review to ensure completion of all requirements, to evaluate the incident, to plan and prevent future reoccurrence, and to ensure appropriate start-up procedures.

5.0 PROCEDURES FOR MINIMIZING IMPACT OF EMERGENCIES

The GWETS has been evaluated for potential emergency occurrences that could prevent containment of the plume at the Las Vegas Wash. The potential reasons that SWF would be down are presented in Table 2.

Table 2 Potential Emergencies

<u>Source of Emergency</u>	<u>Location of Source</u>	<u>Type of Emergency</u>
Well field down	SWF	Extraction well down, pump down, power loss
Lift stations down	Lift Station #1 or #2	Pump down, power loss
Pipeline break	Pipelines from SWF to Lift Station #1, from Lift Station #1 to Lift Station #2, or from Lift Station #2 to WTP	Minor leak, major break
FBR (or biological treatment)	Plant Site	Multiple at Plant Site
Plant down		

The response to each type of emergency and the steps that need to be taken to prepare for these emergencies are provided in Table 3.

Table 3 Emergency Response Activities

<u>Type of Emergency</u>	<u>Response</u>	<u>Preparation</u>
Extraction well(s) down	Repair or replace well(s)	None
Extraction pump(s) down	Repair or replace pump(s)	Shelf spares are maintained on site
SWF loses power	Emergency generator	Vendor for temporary power supply identified in Section 2, above
Lift Stations #1 or # 2 pump down	Use standby pump	Ensure standby pump is available
Lift Stations #1 or # 2 power failure	Emergency generator	Vendor for temporary power supply identified in Section 2, above
Pipeline down - minor	Re-route with temporary pipeline	Vendor for temporary pipeline installation identified in Section 2, above
Pipeline down - major	Treat SWF with ion exchange	Install IX plant
WTP down	Divert to GW-11	Maintain adequate storage volume in GW-11
WTP down and GW-11 out of service	Treat SWF with ion exchange	Install IX plant

The sections below describe the activities that will be undertaken in the case of each emergency listed in Table 3.

Extraction Well(s) Down

If any of the SWF extraction wells get plugged or for some other reason stop producing water, the system will continue to operate using the remaining wells. Attempts will be made to repair the broken well. If these fail, a replacement well will be drilled and connected to the extraction system.

If a catastrophe impacts all of the extraction wells and the plume water is no longer intercepted, water will continue toward Las Vegas Wash until new extraction wells can be installed and the system repaired.

Problems with Extraction Pumps

If a pump at any of the well fields breaks down, that pump will be repaired or replaced as soon as possible.

If a catastrophe impacts all of the pumps, all pumps will be repaired or replaced as soon as possible. During this time, the plume will not be contained until some of the pumps can be reinstated.

Power Failure at SWF

In case of a power failure at SWF, a generator will provide the required power until the system can be repaired.

Lift Station Pump Down

Lift Stations #1 and #2 are critical to operation of the SWF and plume containment. If a pump is down in either of these lift stations, there are standby pumps installed that can be operated. If it is not possible to operate either pump for a period of more than 25 days, the Emergency Response Leader shall have the authority to procure, install, and begin the treatment of the SWF using an IX plant installed at Lift Station #1.

Power Failure at Lift Station

In case of a power failure at Lift Stations #1 and #2, a generator or generators will provide the required power until the system can be repaired.

Pipe Leak or Break

In case of a small break or leak in the pipeline that transports the impacted water from the SWF to the WTP, the spill will be contained as soon as possible. Operation of the SWF will stop while the pipe is repaired, if the repair can be completed within 24 hours. Once the repair is complete, the system will be restarted.

In case of a major break in the pipeline, the leaked water will be contained as soon as possible. New pipe will be ordered, attached to the existing pipe around the break and impacted water conducted to the WTP through this temporary pipeline. Once the system is running using the temporary pipeline, the main pipeline will be repaired and the system returned to normal operations.

If a catastrophe impacts a large length of the pipeline that would discontinue extraction for a period of more than 25 days, the Emergency Response Leader shall have the authority to procure, install, and begin the treatment of the SWF using an IX plant installed at Lift Station #1.

Shut down of FBR Plant

If the FBR (or biological) plant ceases to operate because of equipment failure or catastrophe, impacted water will be pumped to and stored in GW-11 until it can be treated. Once the volume remaining in GW-11 falls below 15% without a viable plan to return the system to operation, the Emergency Response Leader shall have the authority to procure, install, and begin the treatment of the SWF using an IX plant installed at Lift Station #1.

6.0 EMERGENCY RESPONSE EQUIPMENT

The lift stations are equipped with redundant, standby pumps that can be placed into service should one pump go down. Spare pumps for the extraction wells will be kept on site in case a pump in an extraction well goes down. The types of pumps in each of the extraction wells will be determined and one spare of each type of pump will be stored on site.

Two companies in the Henderson / Las Vegas area that rent generators adequate to meet the power requirements are listed in the contacts in Table 1. The emergency generation equipment can be rented in case of a long-term power outage impacting the SWF, Lift Station #1, or Lift Station #2.


In the event the Emergency Response Leader orders the deployment of an IX plant at Lift Station #1, NERT has established terms with ETI for the delivery, installation and operation of related equipment.

7.0 EMERGENCY RESPONSE TRAINING

All personnel working on the site will undergo training to respond to an emergency related to the GWETS. This training will be in addition to any health and safety training required under ETI's HASP. The training specific to the ERP will include:

- Knowledge of the ERP plan;
- ERP roles and responsibilities;
- Location of spare pumps and their use; and
- Contact information for vendors for temporary power, temporary pipeline, and IX system.

6/24/2014 8:48:14 AM - P:\201921\33-20192-14009\CAD\SHEETFILES\AP-5 POND SED SAMPLE.DWG - STOREY, MICHAEL

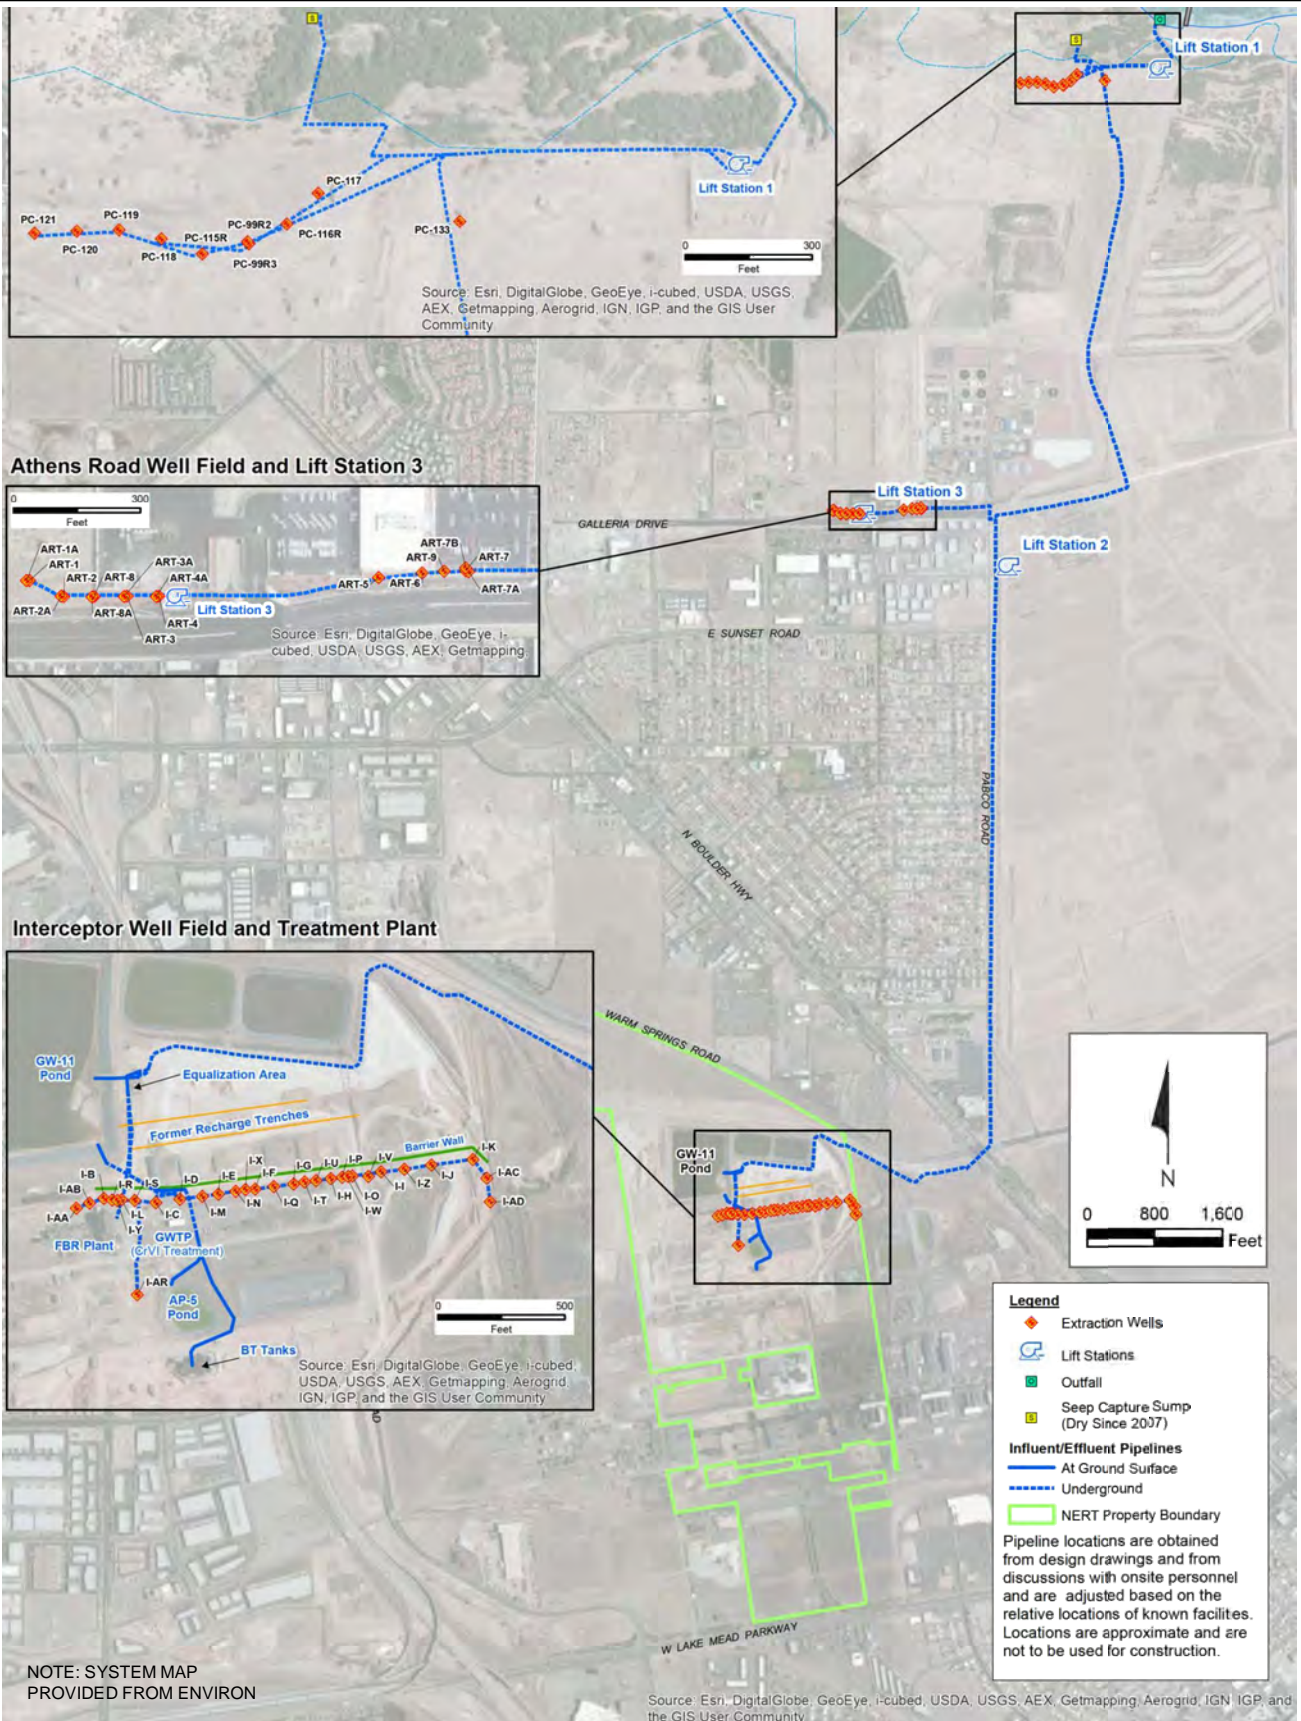

TETRA TECH

www.tetrattech.com
 1576 Sherman St.
 Denver, CO 80203
 Phone: 303-825-5999

NEVADA ENVIRONMENTAL RESPONSE TRUST

GROUNDWATER EXTRACTION AND TREATMENT MAP

Project No.: 133-20192-14009

Date: 06-20-2014

Designed By: TD

FIGURE
1

Bar Measures 1 inch

Copyright: Tetra Tech



EMERGENCY VENDOR LIST

THIS LIST CONTAINS VENDORS THAT CAN RESPOND TO SPECIFIC EMERGENCY REPAIRS OR SERVICES WHICH MAY BE REQUIRED BY THE GWETS PLANT DUE TO AN EMERGENCY SITUATION. THESE VENDORS HAVE BEEN APPROVED BY ENVIROGEN PURCHASING BUT WILL REQUIRE A SPECIFIC WORK ORDER OR PURCHASE ORDER AT THE TIME WORK IS REQUESTED..

Vendor List

Vendor Work Specialty	Primary or Alternate	Vendor	Contact and Telephone #
Pipeline, Above Ground	Primary	Rafael Construction 5870 Construction Ave. Las Vegas, NV 89122	Alan Nish 702-561-0193
Pipeline, Below Ground	Primary	Rafael Construction 5870 Construction Ave. Las Vegas, NV 89122	Alan Nish 702-561-0193
High Voltage Electrical/MCC	Primary	Hampton Tedder Technical Services 4113 Wagon Trail Ave. Las Vegas, NV 89118	Roger Cates 702-234-8177
Instrumentation & Controls/PLC	Primary	Matrix Technologies 1760 Indian Wood Circle Maumee, OH 43537	Nicole Hughes 303-466-5800
Electrical Contracting	Primary	Rosedin Electrical 7470 Dean Marin Drive suite 112 Las Vegas, NV 89139	Shawn McClone 705-208-4371
Temporary Power Supply	Primary	Power Plus 3131 Olive Street Las Vegas, NV 89104	Curtis Mercurio 702-429-8487
Spill Clean Up	Primary	Logistical Solutions 4560 Werdco Ct. Las Vegas, Nv 89115	Ty Salazar 702-376-2344
Wells	Primary	Eagle Drilling 7150 Placid Street Las Vegas, NV 89119	Shawn Sears 702-341-5873



APPENDIX S

SAMPLE SPILL REPORT



XXXXX YY, 20ZZ

Compliance Coordinator

Nevada Division of Environmental Protection
Bureau of Water Pollution Control
901 South Stewart Street, Suite 4001
Carson City, Nevada 89701-5249

RE: Report of Spill of XXXXXX
NPDES Permit NV0023060
Incident No. xxxxxxxx

Dear Compliance Coordinator:

The Nevada Environmental Response Trust (“NERT” or the “Trust”) maintains a National Pollutant Discharge Elimination System (NPDES) Permit NV0023060 for discharge of treated water to the Las Vegas Wash as part of their on-going effort to capture and treat groundwater containing perchlorate and other contaminants of concern at the NERT site in Henderson, Nevada (the “Site”). ETI is submitting this letter on behalf of the Trust to provide written documentation of a spill from XXXXXXXX.

A written paragraph describing the spill

Tetra Tech reported this incident via telephone at approximately xx:xx PM PST on XXXX YYth, 201Z, to the NDEP Spill Notification Line. This incident was assigned Spill Incident No. xxxxxxxx. The Bureau of Corrective Actions was notified by email immediately following the call to the Spill Notification Line.

Per Section II.A.3.b. of the NPDES permit, a written report shall be submitted within 5 days of the spill and include the following information.

i. Time and date of discharge

Fill in

ii. Exact location and estimated amount of discharge

Fill in

iii. Flow path and any bodies of water which the discharge reached

Fill in

iv. The specific cause of the discharge

The root cause of this incident was attributable to the following:

1) Fill in

v. The preventive and/or corrective actions taken

In response to this spill and to minimize their reoccurrence, preventive measures that will be undertaken include:

1. Fill in.

Please let me know if you have any questions. I can be reached at xxxxxxxx or via email at xxxxxxxxxxxxxx.

Envirogen Technologies
700 Rockmead Drive, Suite 105
Kingwood, TX 77339
Tel (877) 312-8950 Fax (909) 980-4732

Sincerely,

Copies: Regional Administrator, USEPA Region 9

Copies: Cliff Lawson, Bureau of Water Pollution Control, NDEP
(electronic) Joe Maez, Bureau of Water Pollution Control, NDEP
Greg Lovato, Bureau of Corrective Actions, NDEP
James Dotchin, Bureau of Corrective Actions, NDEP
Weiquan Dong, Bureau of Corrective Actions, NDEP
Jay Steinberg, Nevada Environmental Response Trust
Andrew Steinberg, Nevada Environmental Response Trust
Tanya O'Neill, Foley and Lardner LLP
Michael Delvecchio, Envirogen Technologies, Inc.
Todd Webster, Envirogen Technologies, Inc.
Allan DeLorme, ENVIRON International Corporation